



- AFD Accordion fire door
ALS All glass entrance (structural glass door) -1/2" glass min.
ALS Aluminum storefront door and frame
ASD Aluminum sliding door
HM Hollow metal
HM Consolidated door, frame, and hardware
LLF Lead lined door, match partition lead thickness
LLF Lead lined door, match partition lead thickness, plastic laminated faced
LLF Consolidated door, frame, and hardware, match partition lead thickness
OCC Overhead roll up counter grille
OCC Overhead roll up counter shutter
OCC Overhead ceiling door grille
OFS Overhead fire door, vertical cooling
OFS Overhead fire shutter
OPP Operable partition
WDP Wood door, plastic laminated faced
WDP Wood door, plastic laminated faced, sound rated
SS Stainless Steel (kitchen duct swing)
RF SHIELDED DOOR AND FRAME - Differed Approval
RFW SHIELDED GLASS AND FRAME - Differed Approval

U0 Non-rated, resist passage of smoke, door to receive "S" label.
U1 "Class C" 1 hour rating (45 minute) 1296 sq. in. maximum glass lite.
Also provide "S" label.
U1X "Class C" 1 hour rating (60 minute) 100 sq. in. maximum glass lite.
Also provide "S" label.
U2 "Class B" 1 1/2 hour rating (90 minute) 100 sq. in. maximum glass lite.
Also provide "S" label.



1. Glaze opening with X' tempered safety glass.
2. Not used.
3. Glaze opening with spandrel glazing.
4. Glaze opening with X' impact safety glass **tempered glass**.
5. Glaze opening with fire rated/safety rated ceramic glass.
6. Glaze opening with X' laminated glass with custom air film infill.
7. Glaze opening with leaded glass with lead ead to adjacent partition.
8. Glaze opening with laminated glass with custom air film infill.
9. Aluminum frame to have clear modified finish.
10. Cook hood on room side of door.
11. See exterior elevations for additional information and detail references.
12. For Accordion partition details, see 34/ B5/ B4/A11.4.1.
13. For Motorized security grille to fire alarm, grille attracts during alarm mode.
14. For movable partition details, see A5/ B6/ A11.4.1.
15. Lead lined door and frame with lead ead to adjacent partition.
16. Glaze partition with $1/2"$ laminated glass, with custom air film infill.
17. Glaze opening with laminated glass with custom air film infill.
18. Magnetic hold open device, automatic closing by smoke detection, see hardware set.
19.  Sound seats (108BA by National Guard) and automatic door bottom, 423N by National Guard
20. Conform pocket door height with ceiling panel detail.
21. Active leaf 4'-0" wide; inactive leaf 2'-0" wide.
22. Closed opening.
23. Door actuated by smoke detector.
24. RF shielded door and frame package by vendor.- Deferred approval.
25. RF shielded glass and frame package by vendor.- Deferred approval.
26. Provide impact for low impact (accessible) door operator, see detail B5/11.4.1.
27. Motorized security grille. Refer to floor plans and referenced elevation for size, auto reset.
28. Motorized calling fire door or shutter. Refer to schedule for size, auto reset. Tie to fire alarm, via smoke detector, with auto reset device.
29. Automatic entry sliding door package with breakaway feature.
30. See elevations in 11 for details of smoke alarm / smoke / smoke detectors.
31. 44'-4" clear opening, self-closing, positive latching, smoke-rated with break-out feature aluminum sliding door.

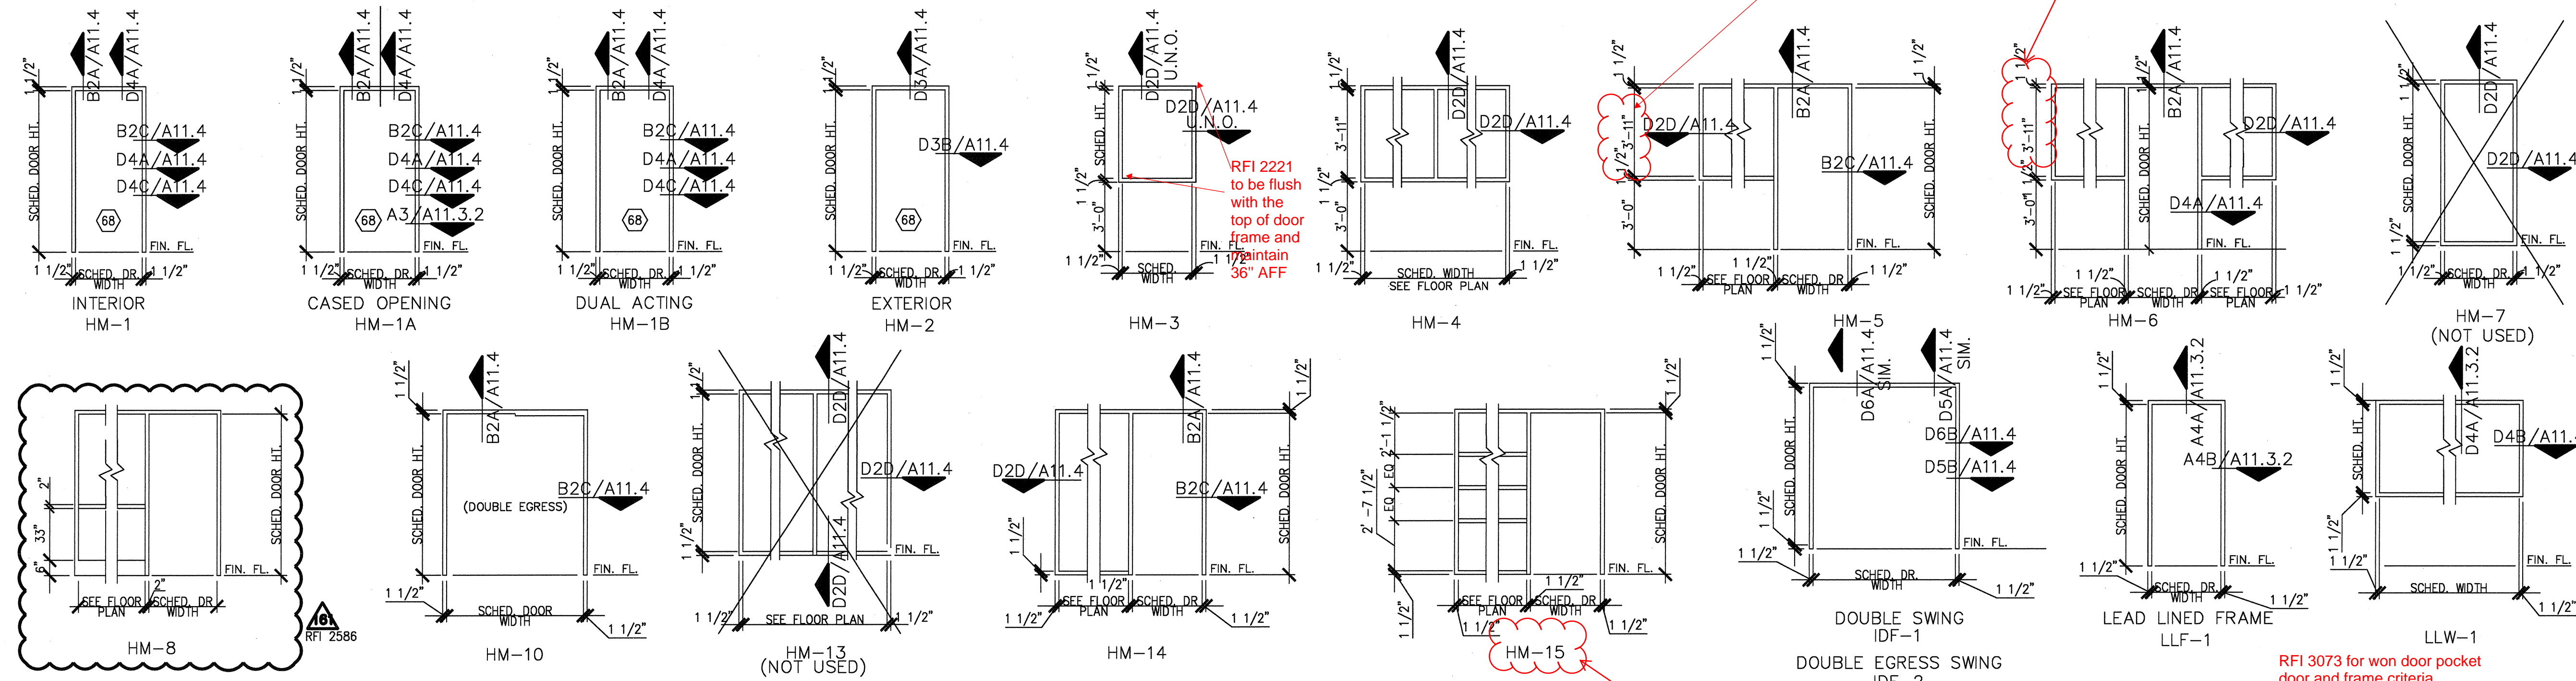