

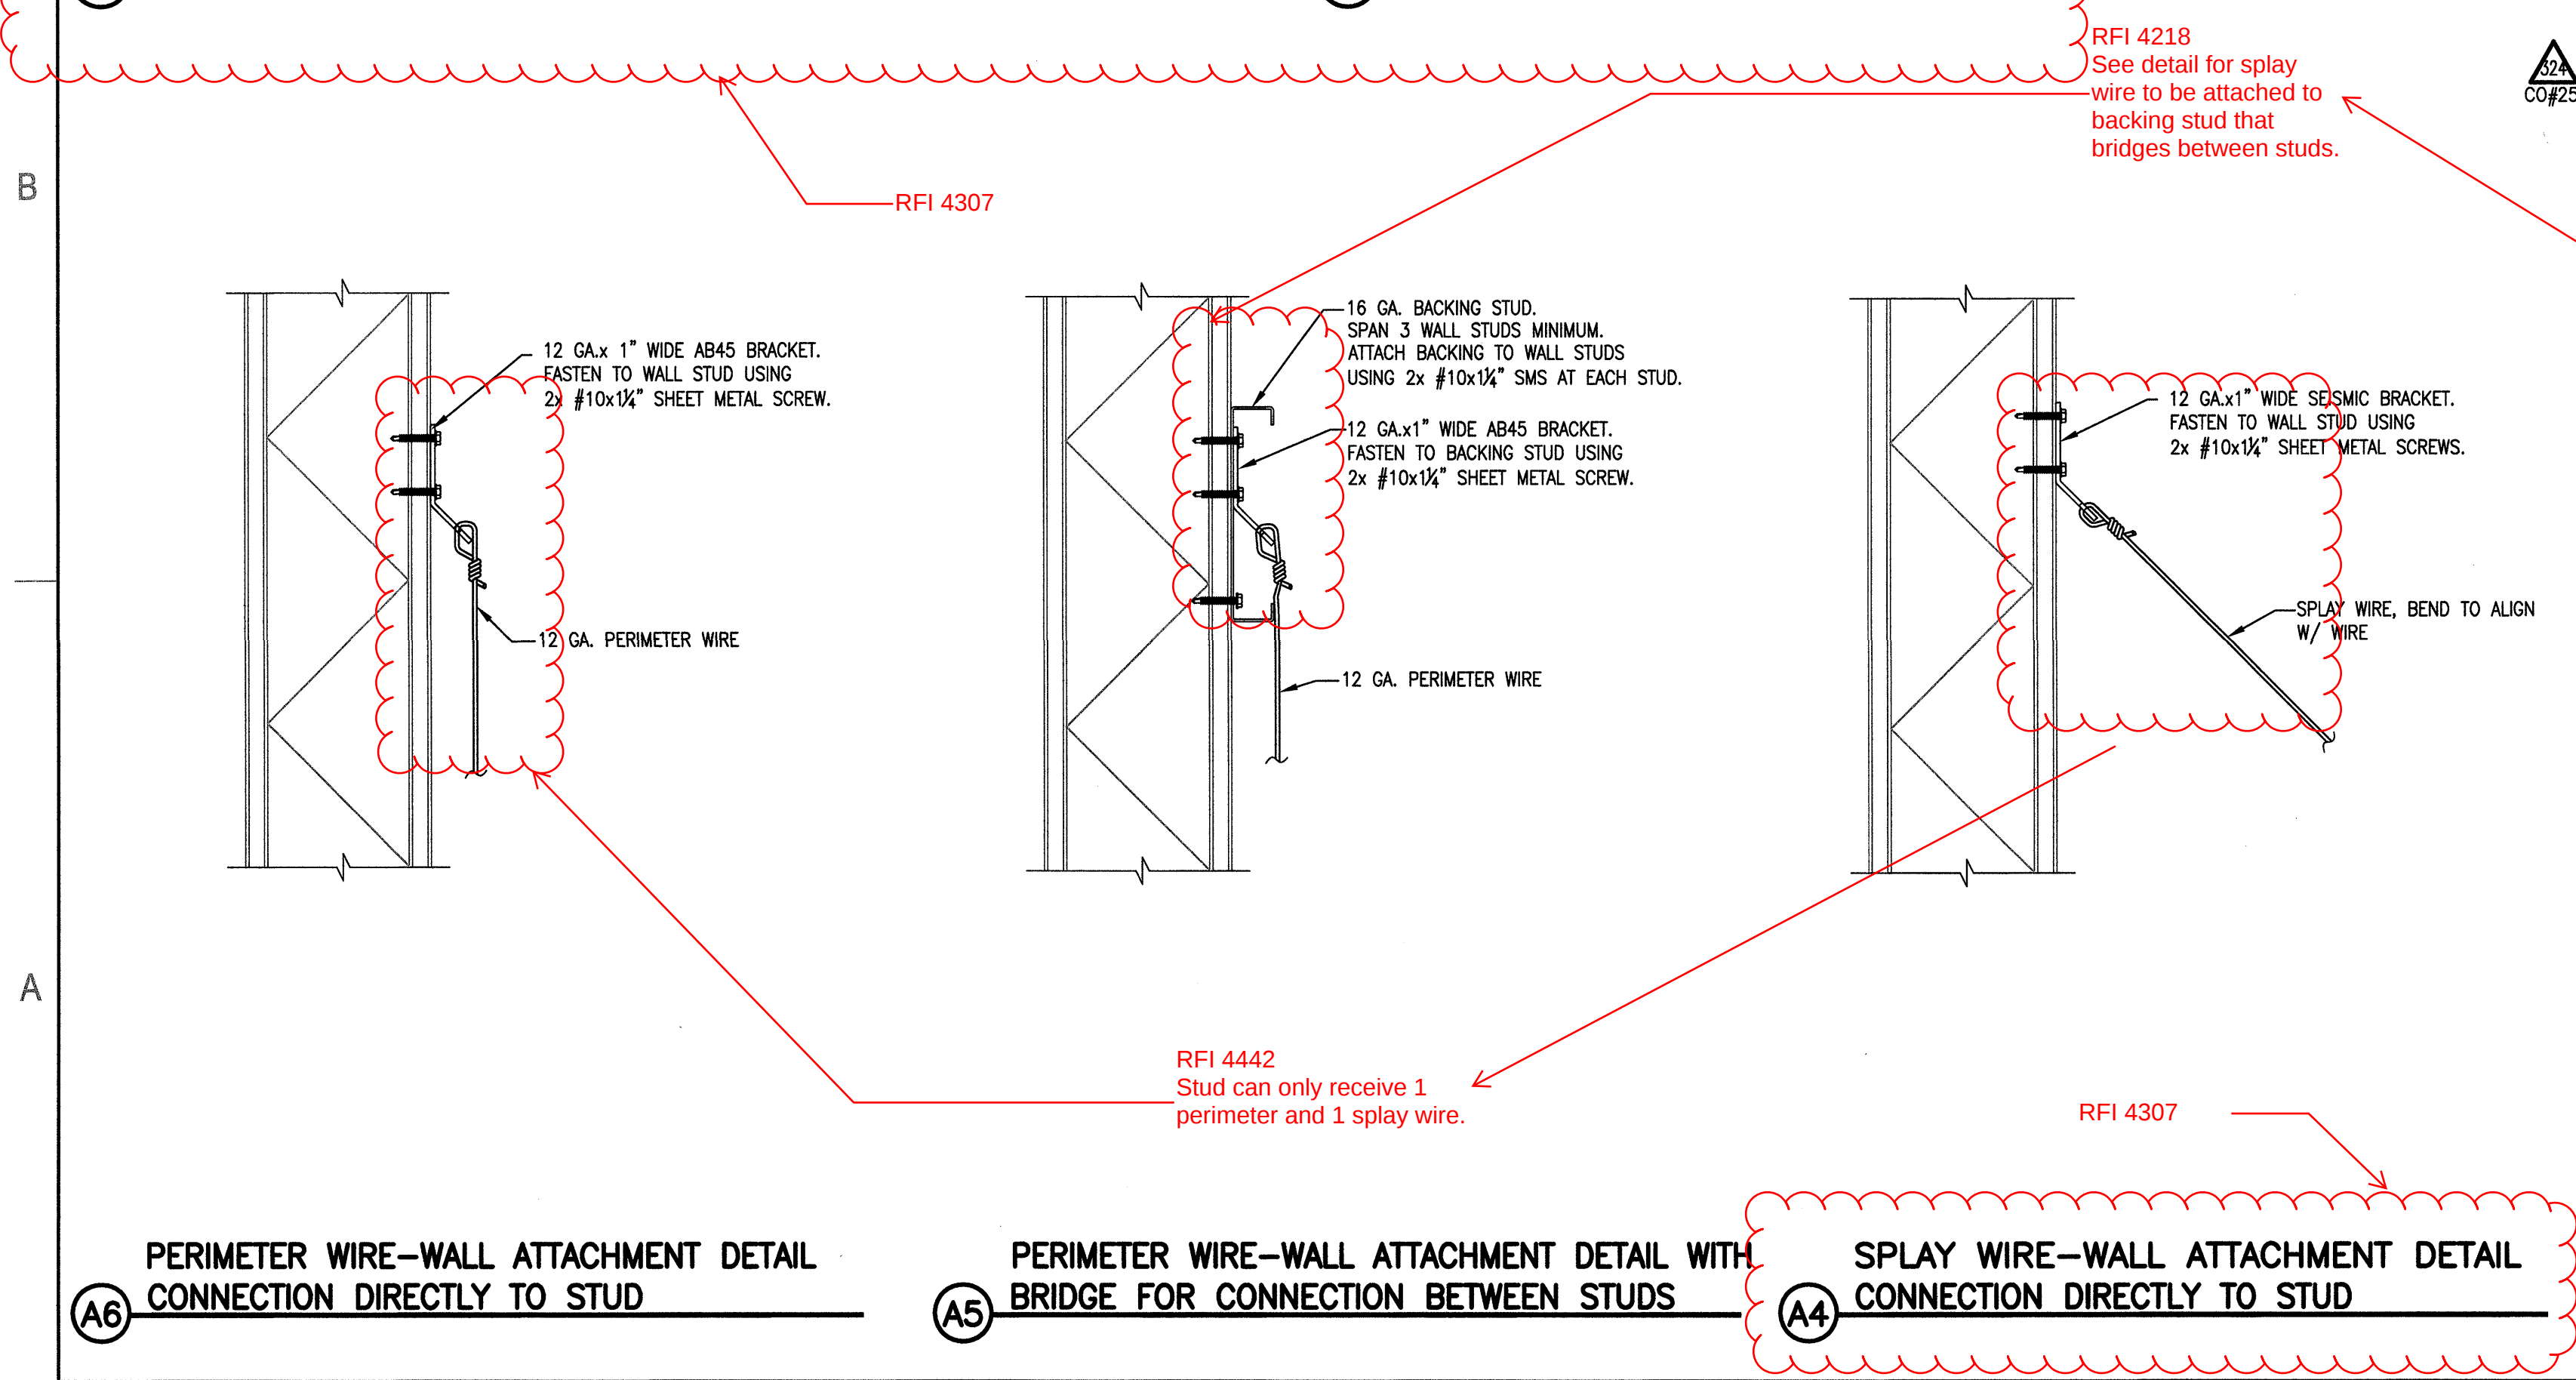
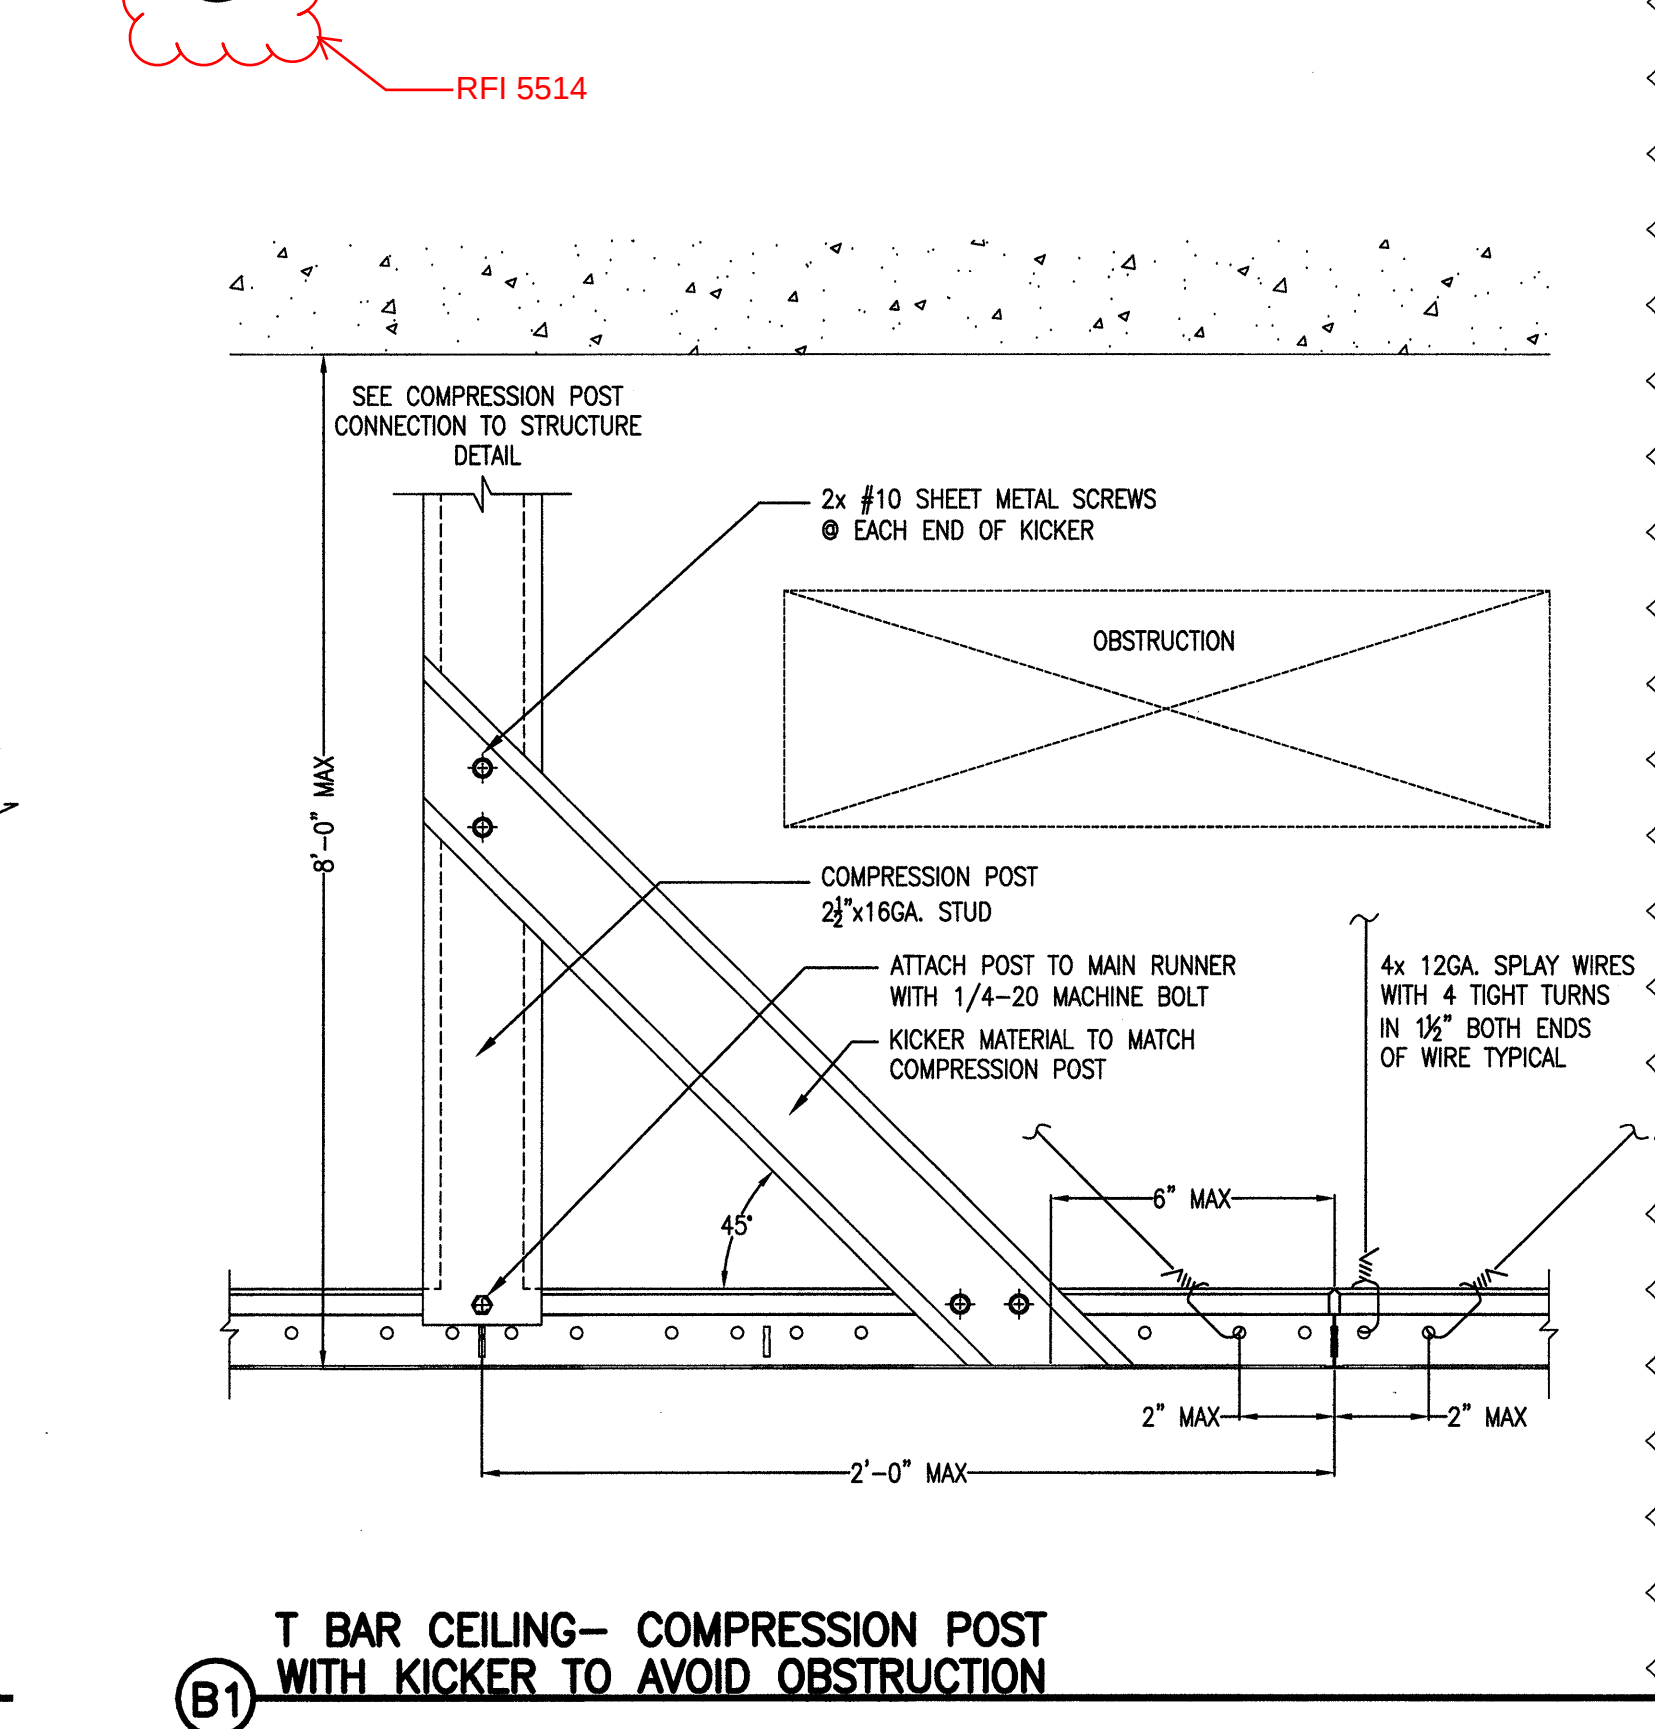
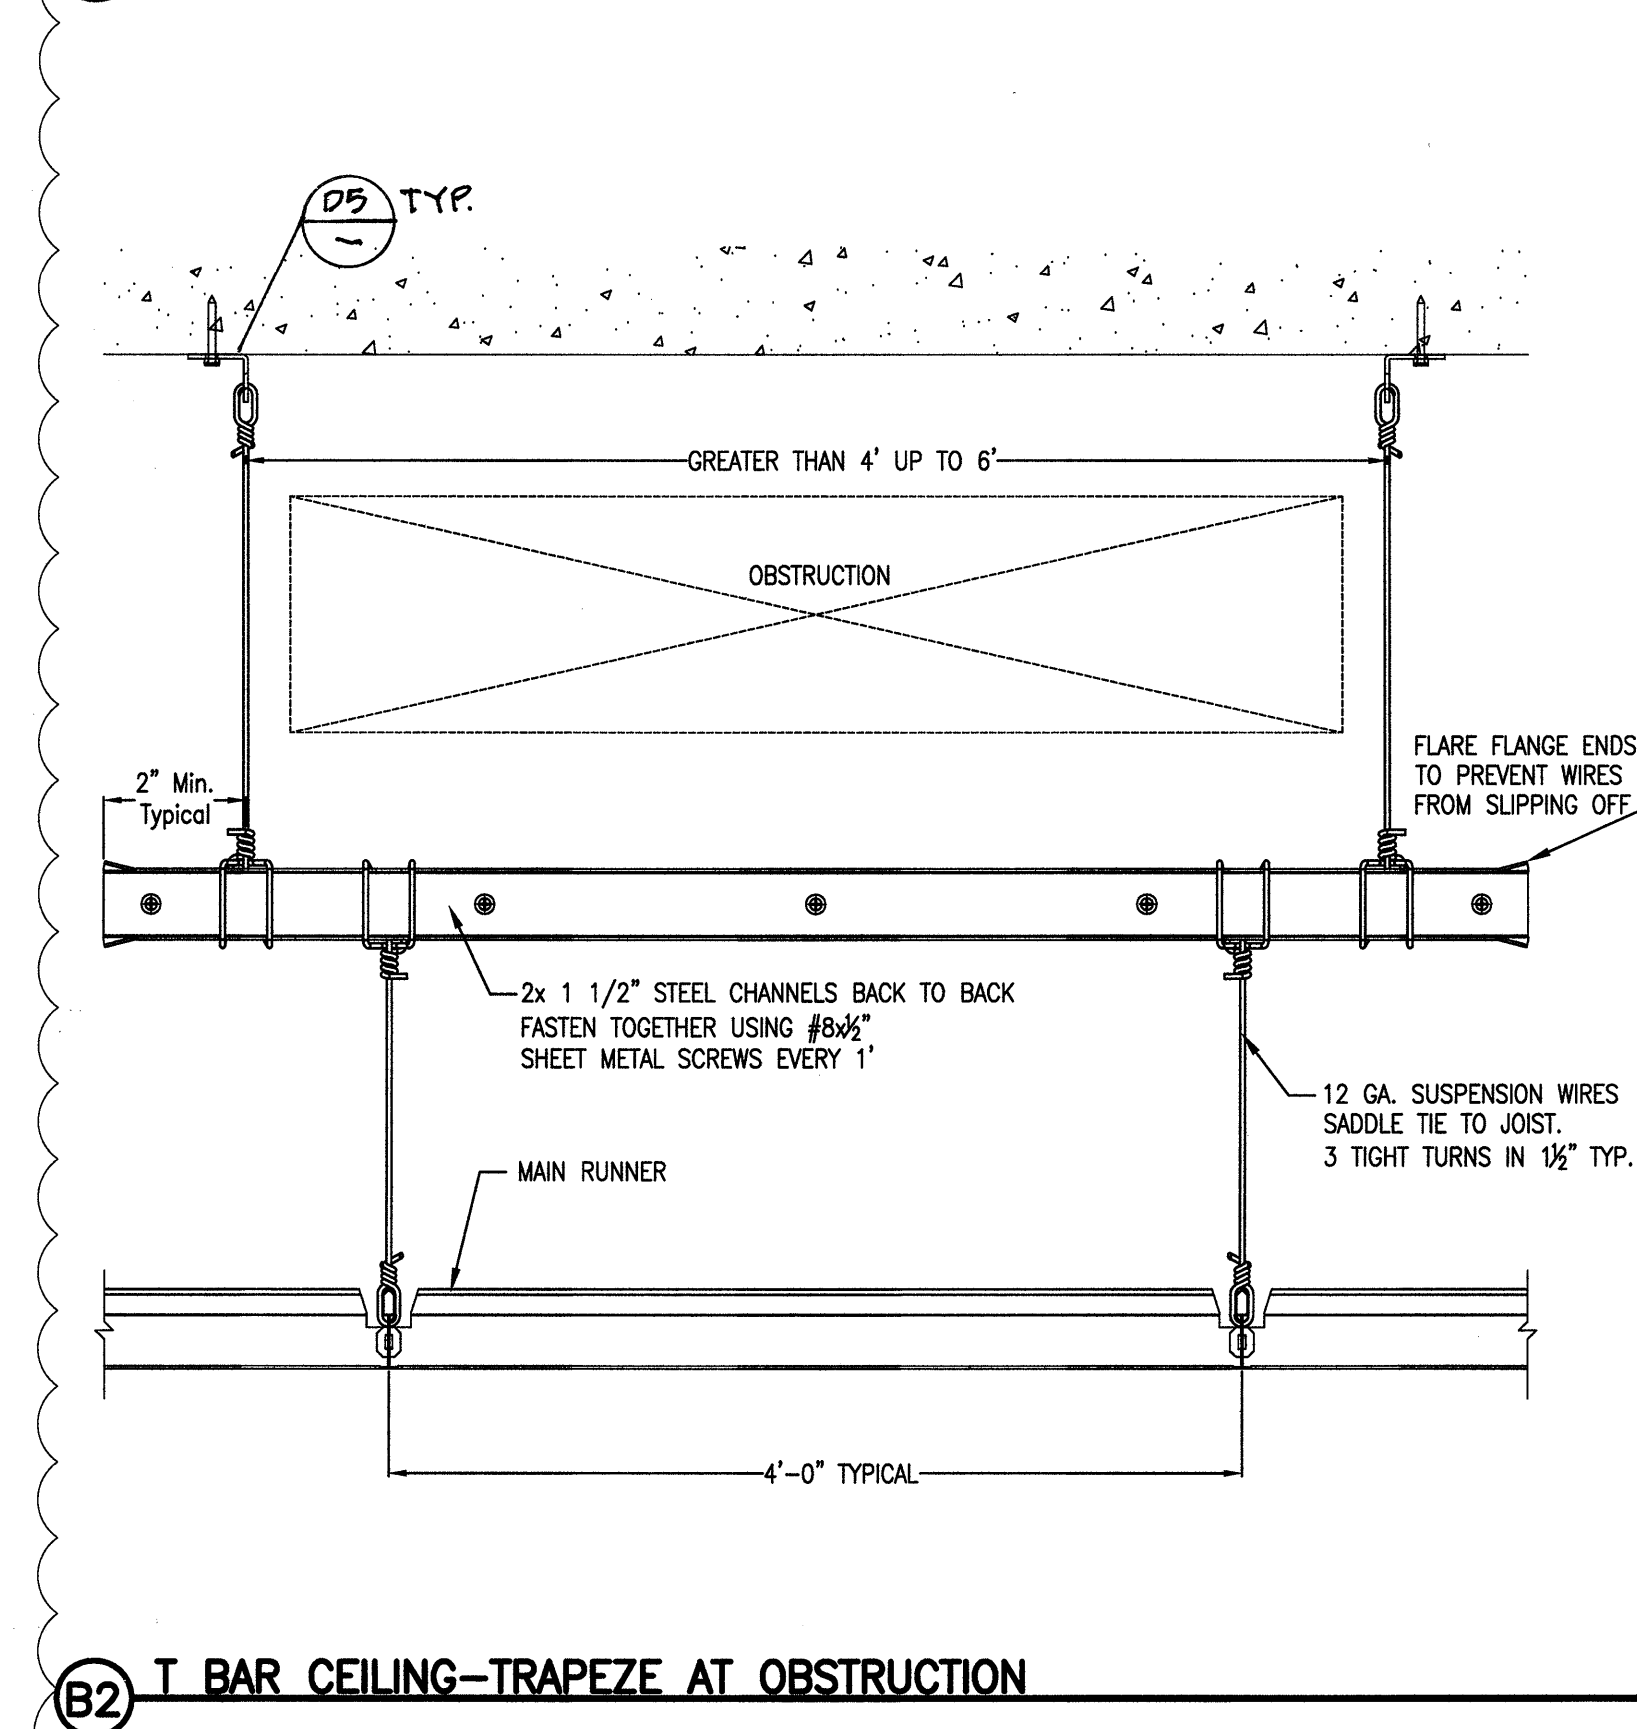
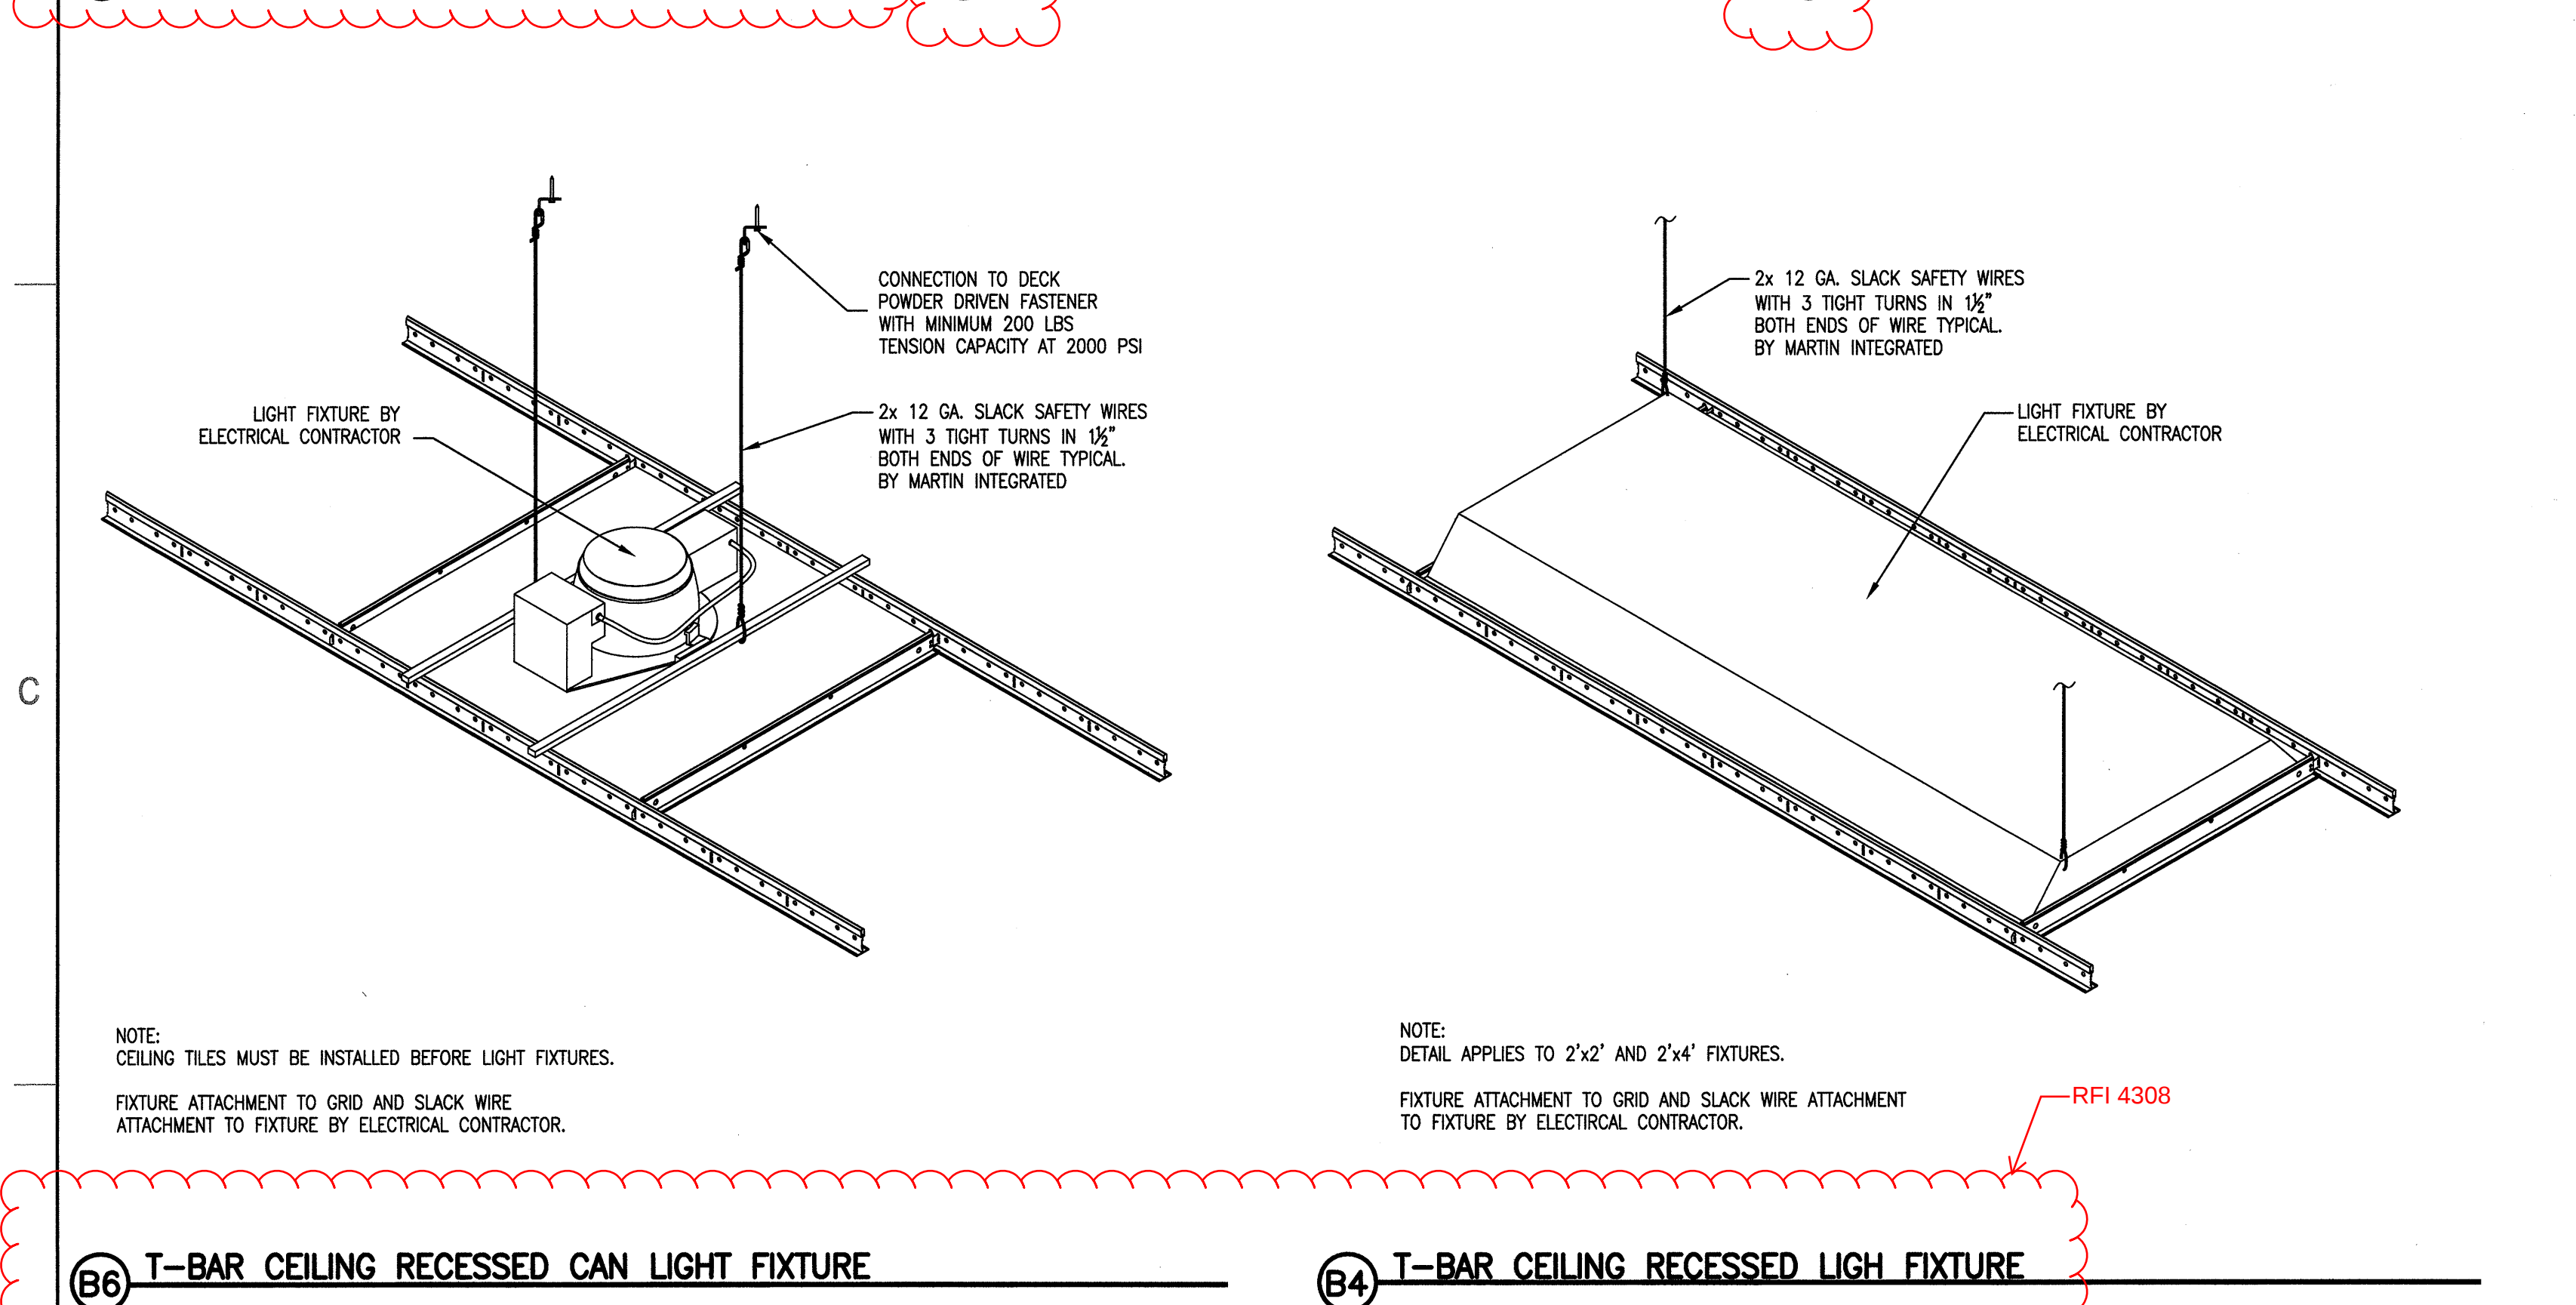
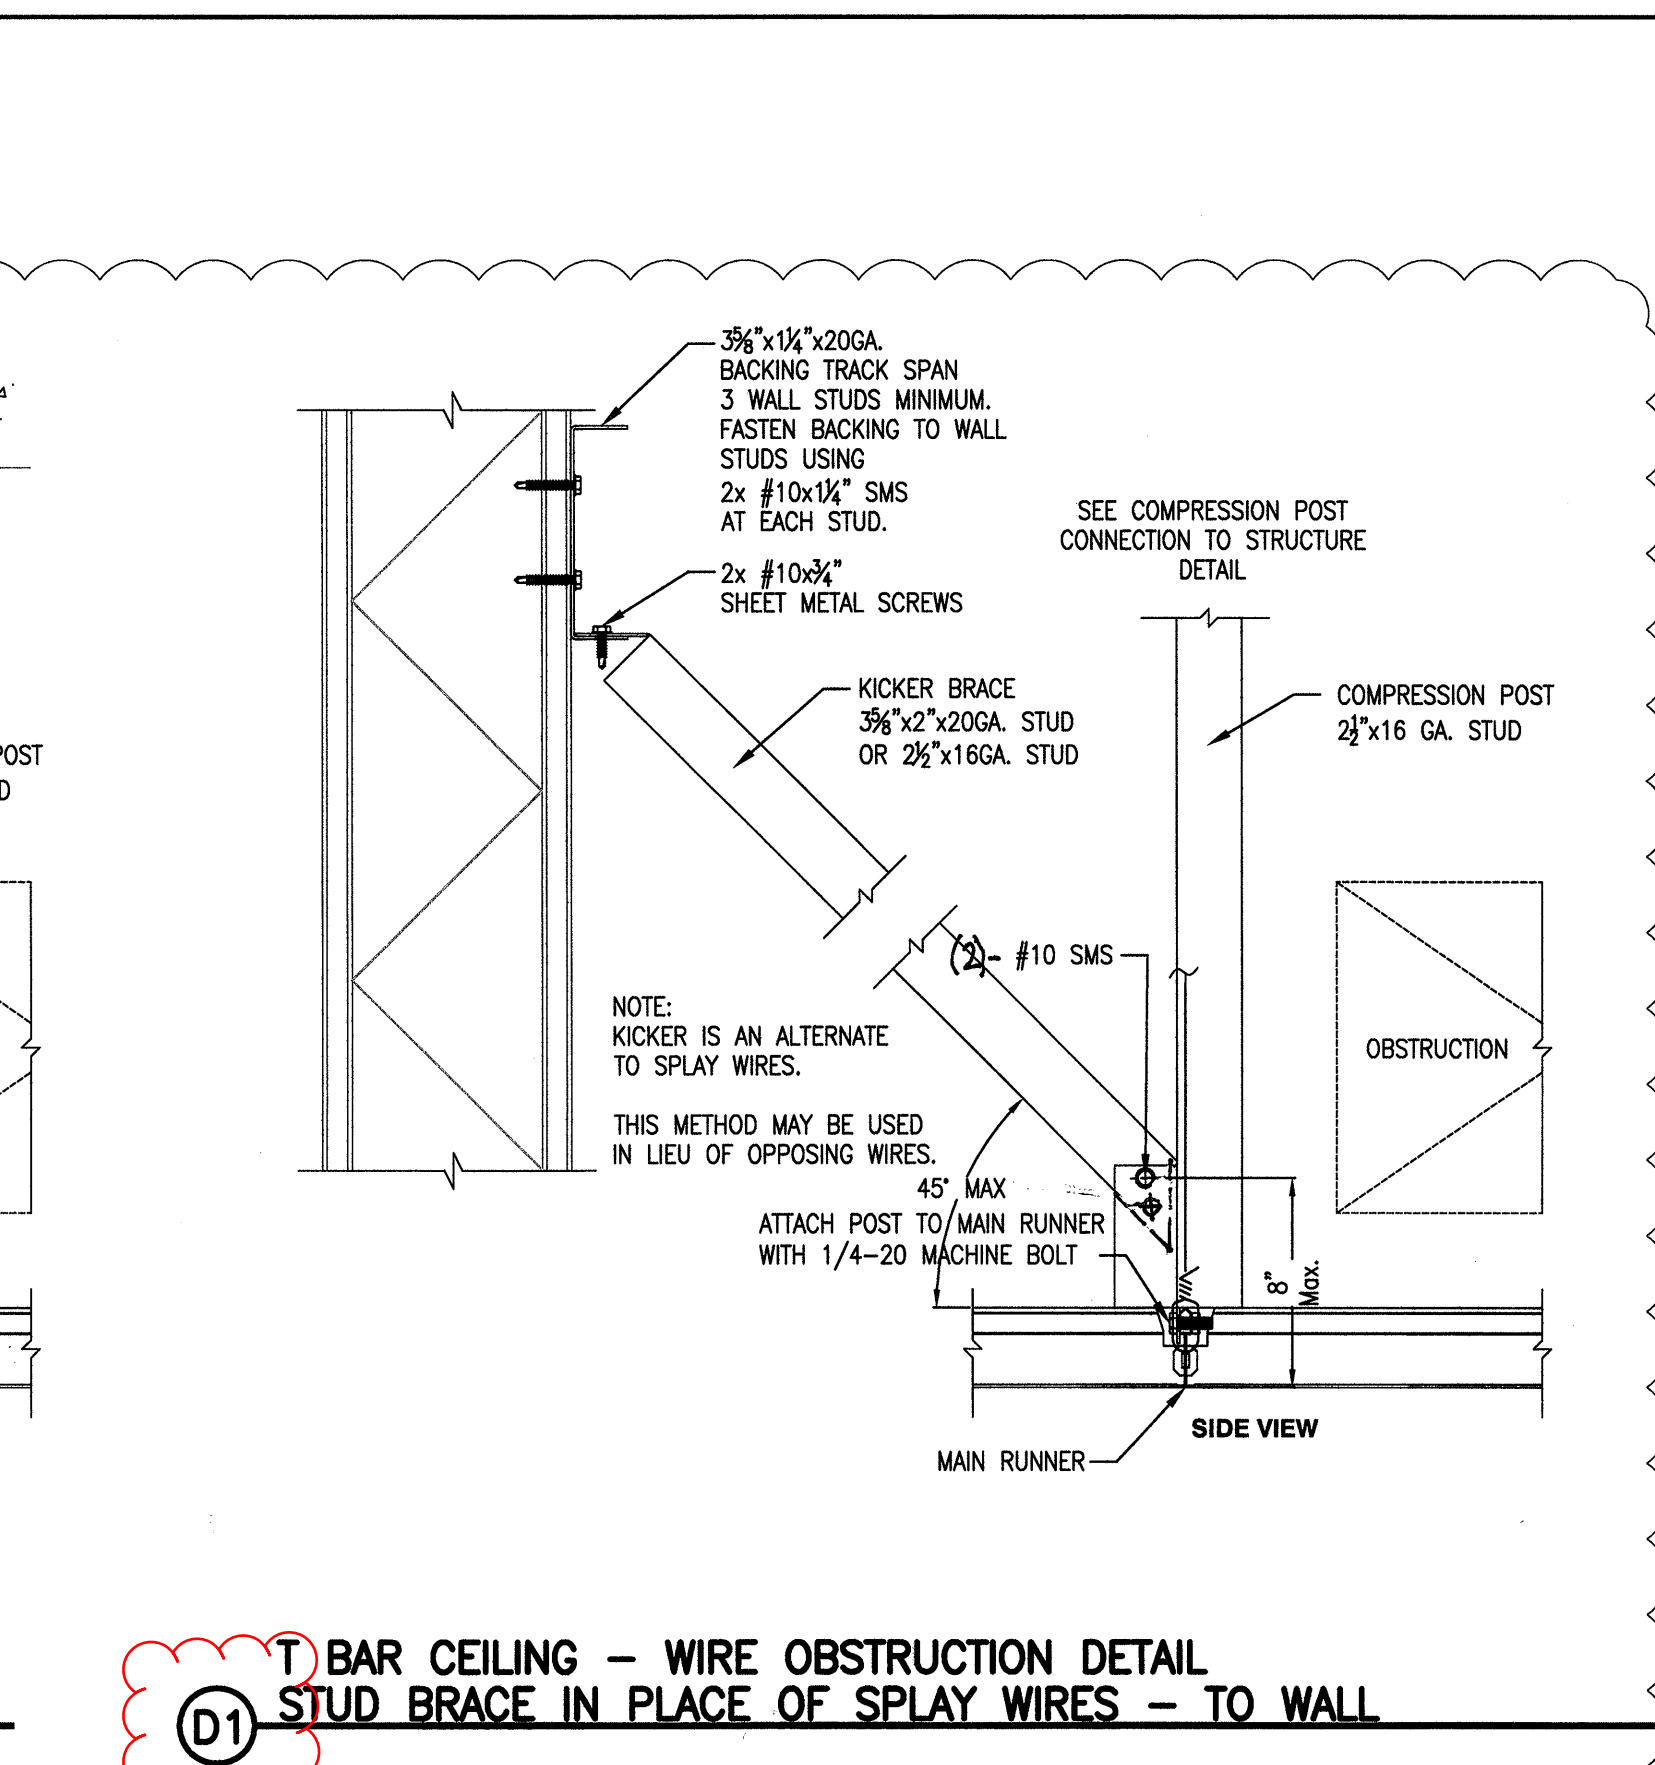
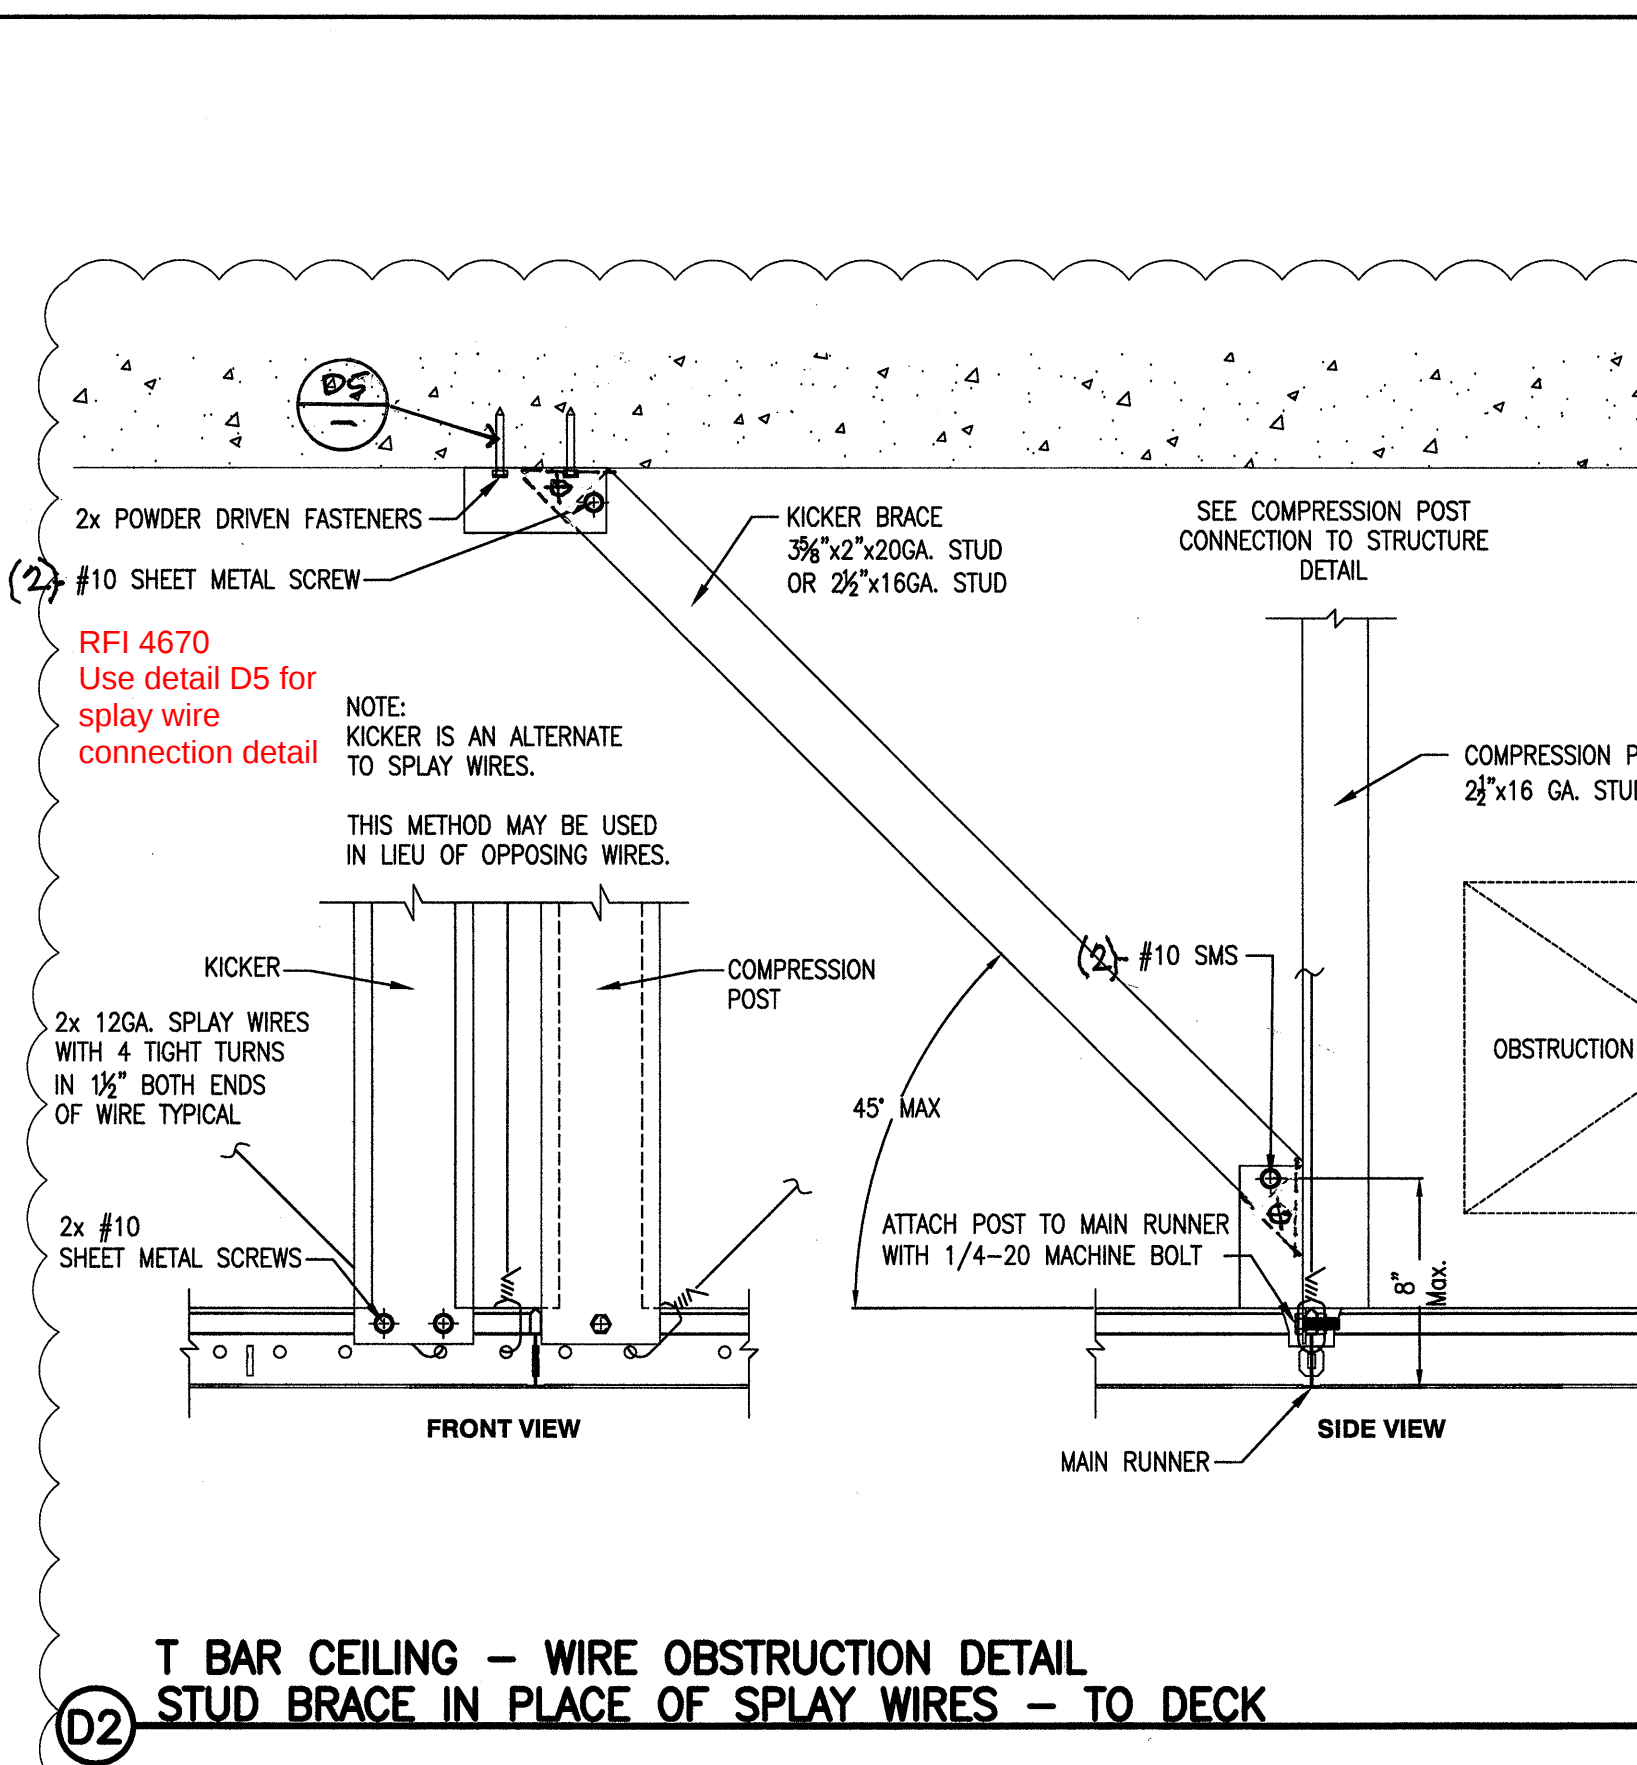


RFI 5897

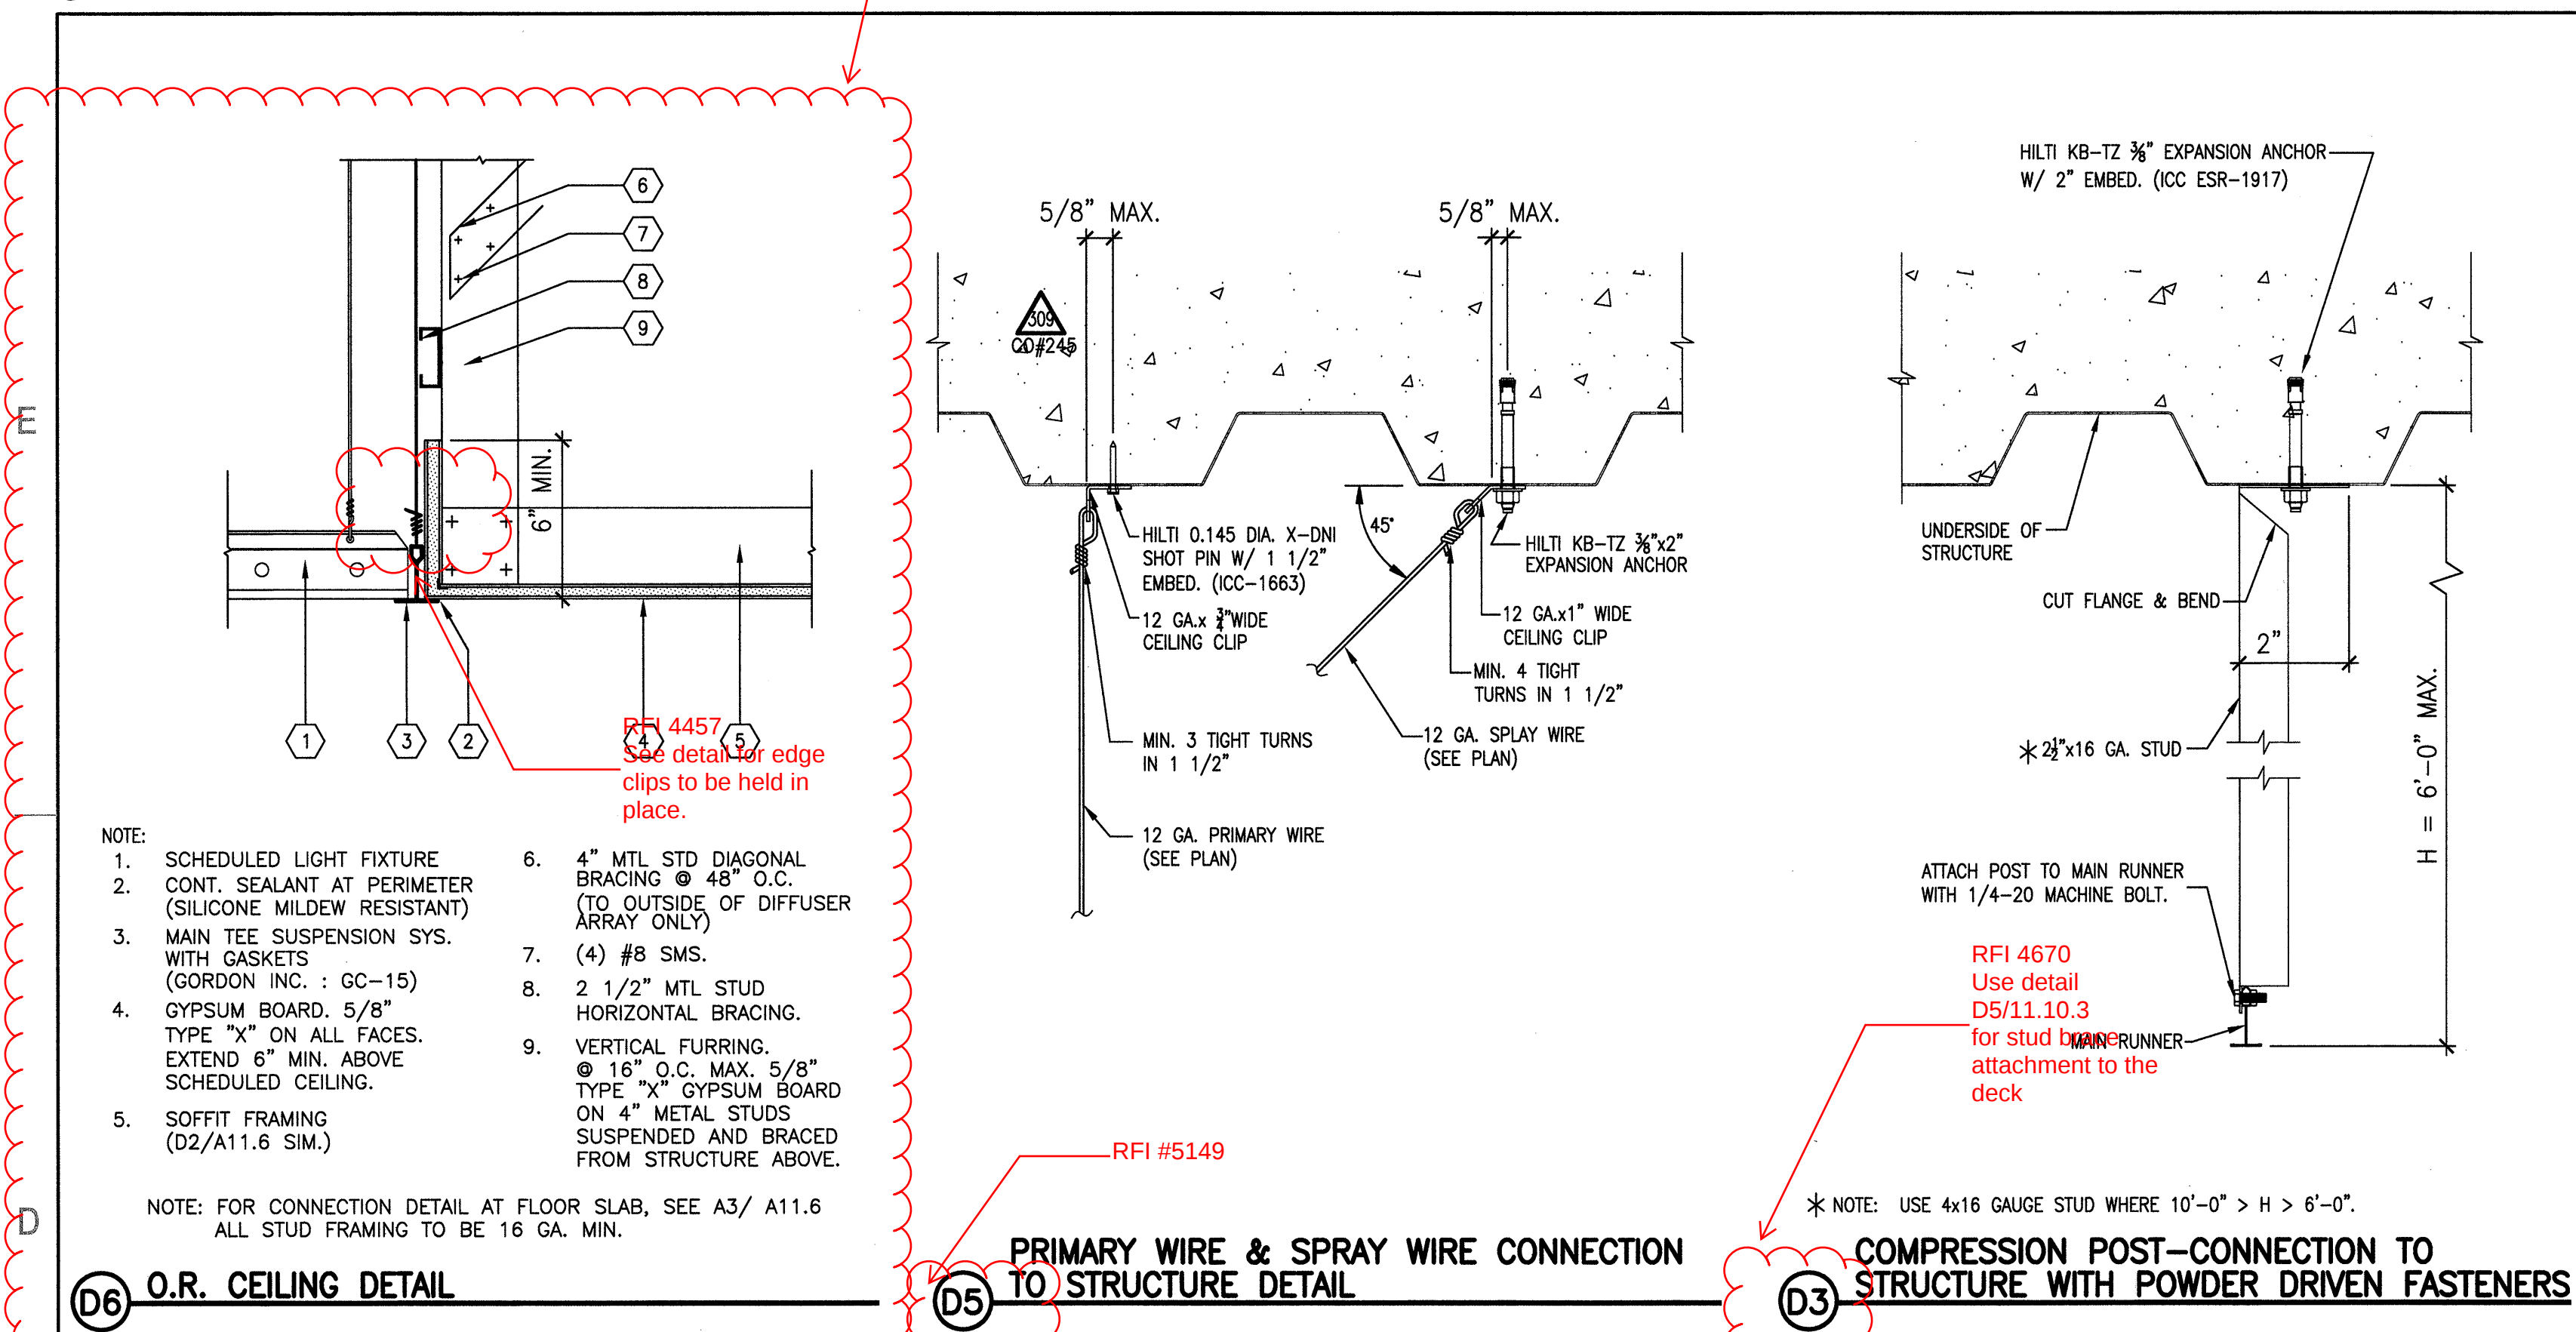

ARCHITECT OF RECORD
Paul C. Gloriot

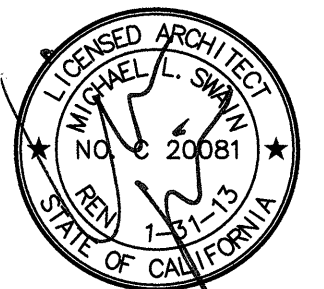

Changes on these drawings do not consist of materially altered changes to approved drawings and don't require a change order.
OSHPO review ACO
OSHPO review FLSO
OSHPO review DSE

REVISIONS			
17A	02/23/11	CO#147	
20A	07/24/11	CO #245	
22A	08/22/11	CO#253	

OSHPO/FDD-Field Review Tracking					
Project:	ACD	X	Refer		
Architect:	ACD	X	Refer		
Mechanical:	ACD	X	Refer		
Electrical:	ACD	X	Refer		
DSE:	ACD	X	Refer		
Structural:	ACD	X	Refer		
FLSO:	ACD	X	Refer		
Fire Life Safety:	ACD	X	Refer		

APPROVAL
Office of Statewide Health Planning & Development
REVIEWED IN ACCORDANCE WITH THE REQUIREMENTS OF T24, CCR 4000-10-01

CHANGE ORDER
INSTRUCTION BULLETIN
DEFERRED APPROVAL
JOURNAL

PROJECT NAME
CHILDREN'S HOSPITAL OF ORANGE COUNTY
455 S. Main St.
Orange, CA 92668-3874

RECEIVED
TOWER II August 29 2011 McCARTHY



PROJECT NUMBER
12011.00 Increment #7

OSHPO - PROJECT NUMBER
IL 072072-30

ISSUE
OSHPO PERMIT

DATE
01/27/2010

SCALE

N.T.S.
DRAWING TITLE

CEILING DETAILS

DRAWING NUMBER

A11.10.3

N:\0600\A\06102 CHOC TOWER 2 SHELL BUILDING\TYP CONTRACTED PROJECTS\PROJECT INCREMENTS\WCR #07_TENANT IMPROVEMENT\OSHPO PERMIT (CONSTRUCTION DOCUMENTS)\060602_C04_A11.10.3.DWG
8/18/2011
RONALD