

FKP Architects


ARCHITECT OF RECORD
Paul C. Gloriod



REVISIONS

173 02/23/11 CO #147

APPROVAL

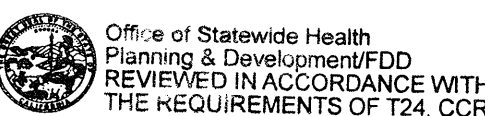

MAR 02 2011
CHANGE ORDER: CO #147
INSTRUCTION BULLETIN
DEFERRED APPROVAL #
ADDENDUM

PROJECT NAME
**CHILDREN'S HOSPITAL
OF ORANGE COUNTY**
455 S. Main St.
Orange, CA 92668-3874

TOWER II



PROJECT NUMBER

12011.00
Increment #7

OSHPD - PROJECT NUMBER

IL 072072-30

ISSUE

OSHPD PERMIT

DATE

01/27/2010

SCALE

N.T.S.

DRAWING TITLE

CEILING DETAILS





DRAWING NUMBER

A11.10.5

D06 T-BAR CEILING WITH TEGULAR TILE CORRIDOR INSTALLATION - SEISMIC BRACE

D03 NOT USED

D02 T-BAR CEILING WITH TEGULAR TILE SLIP JOINT

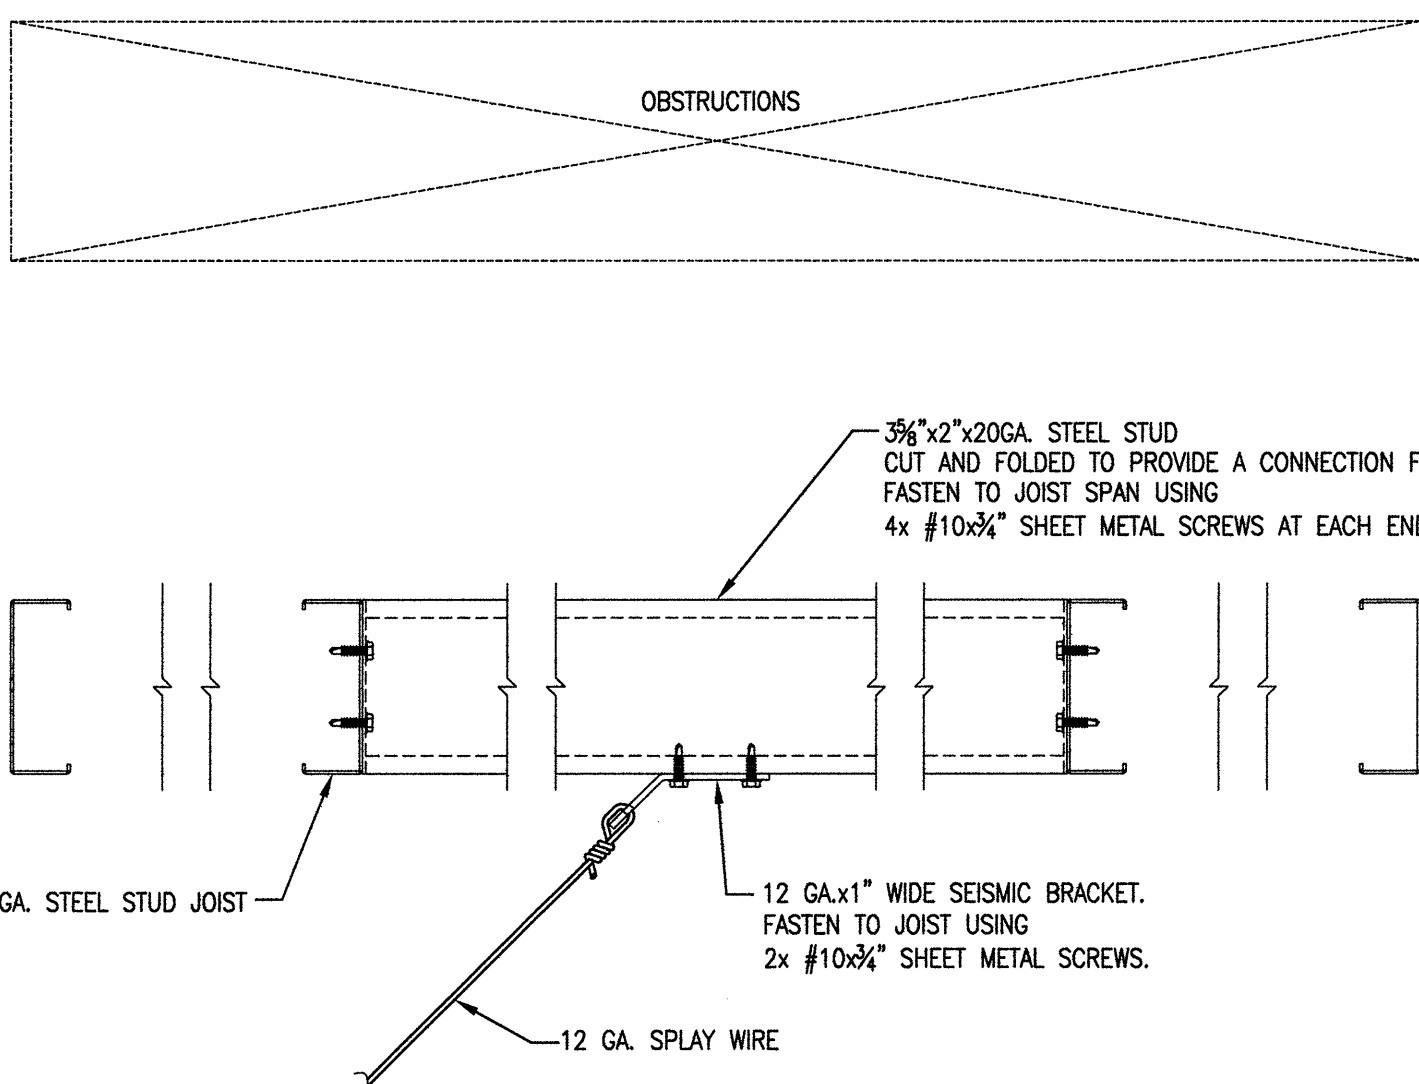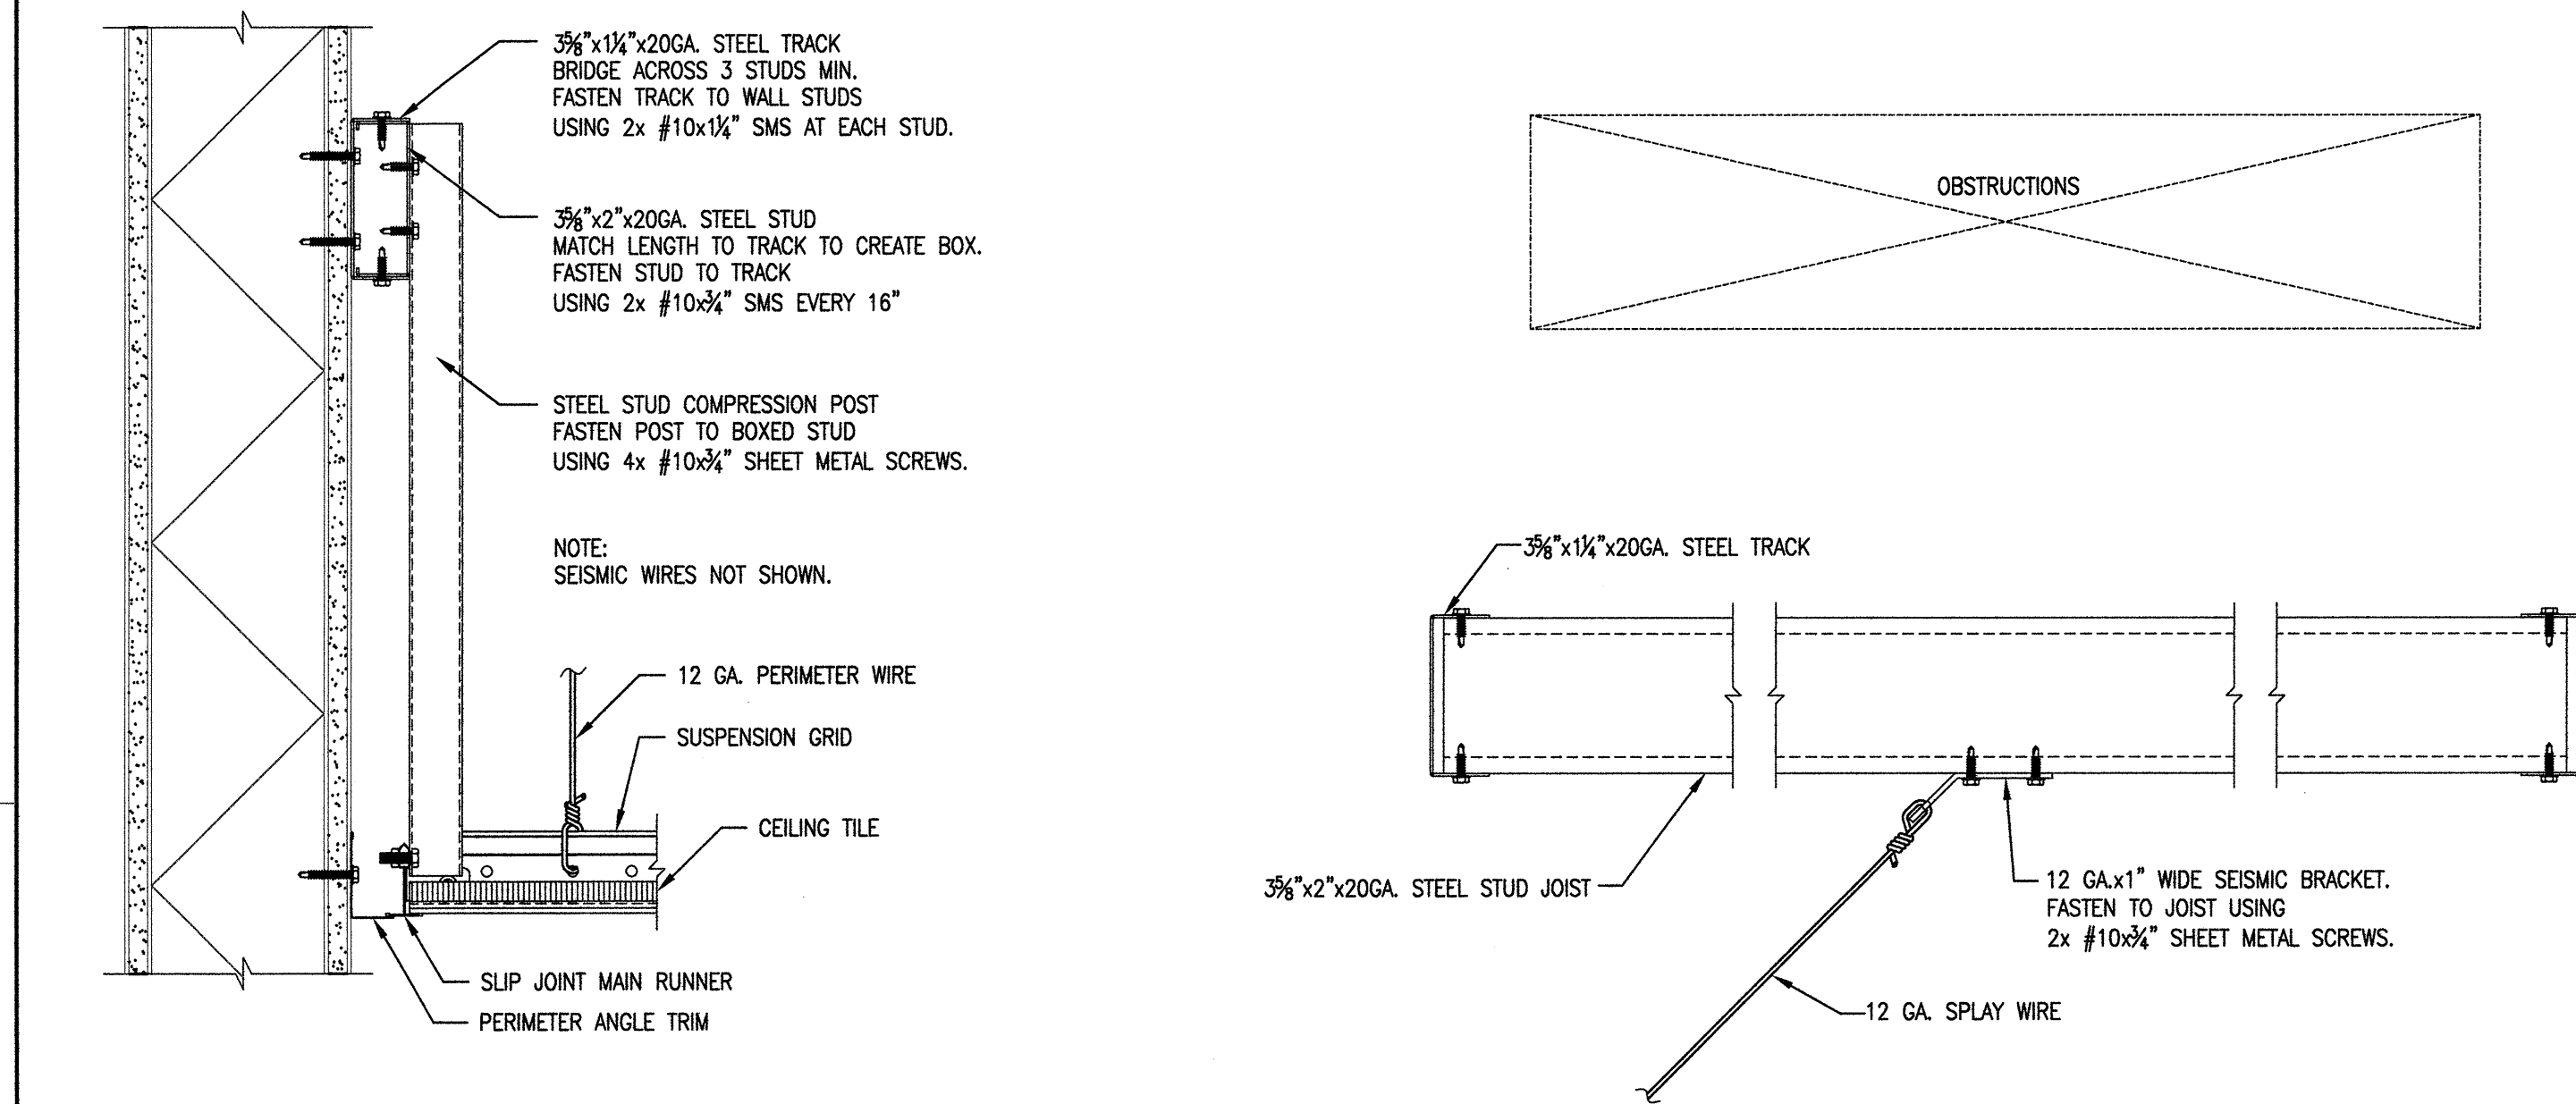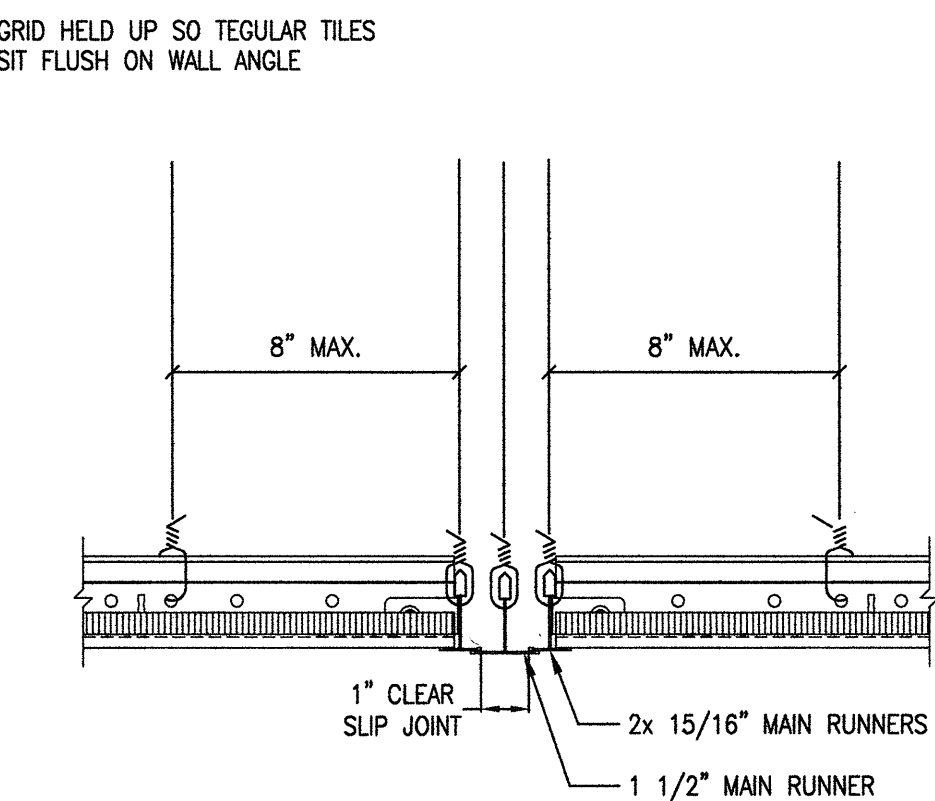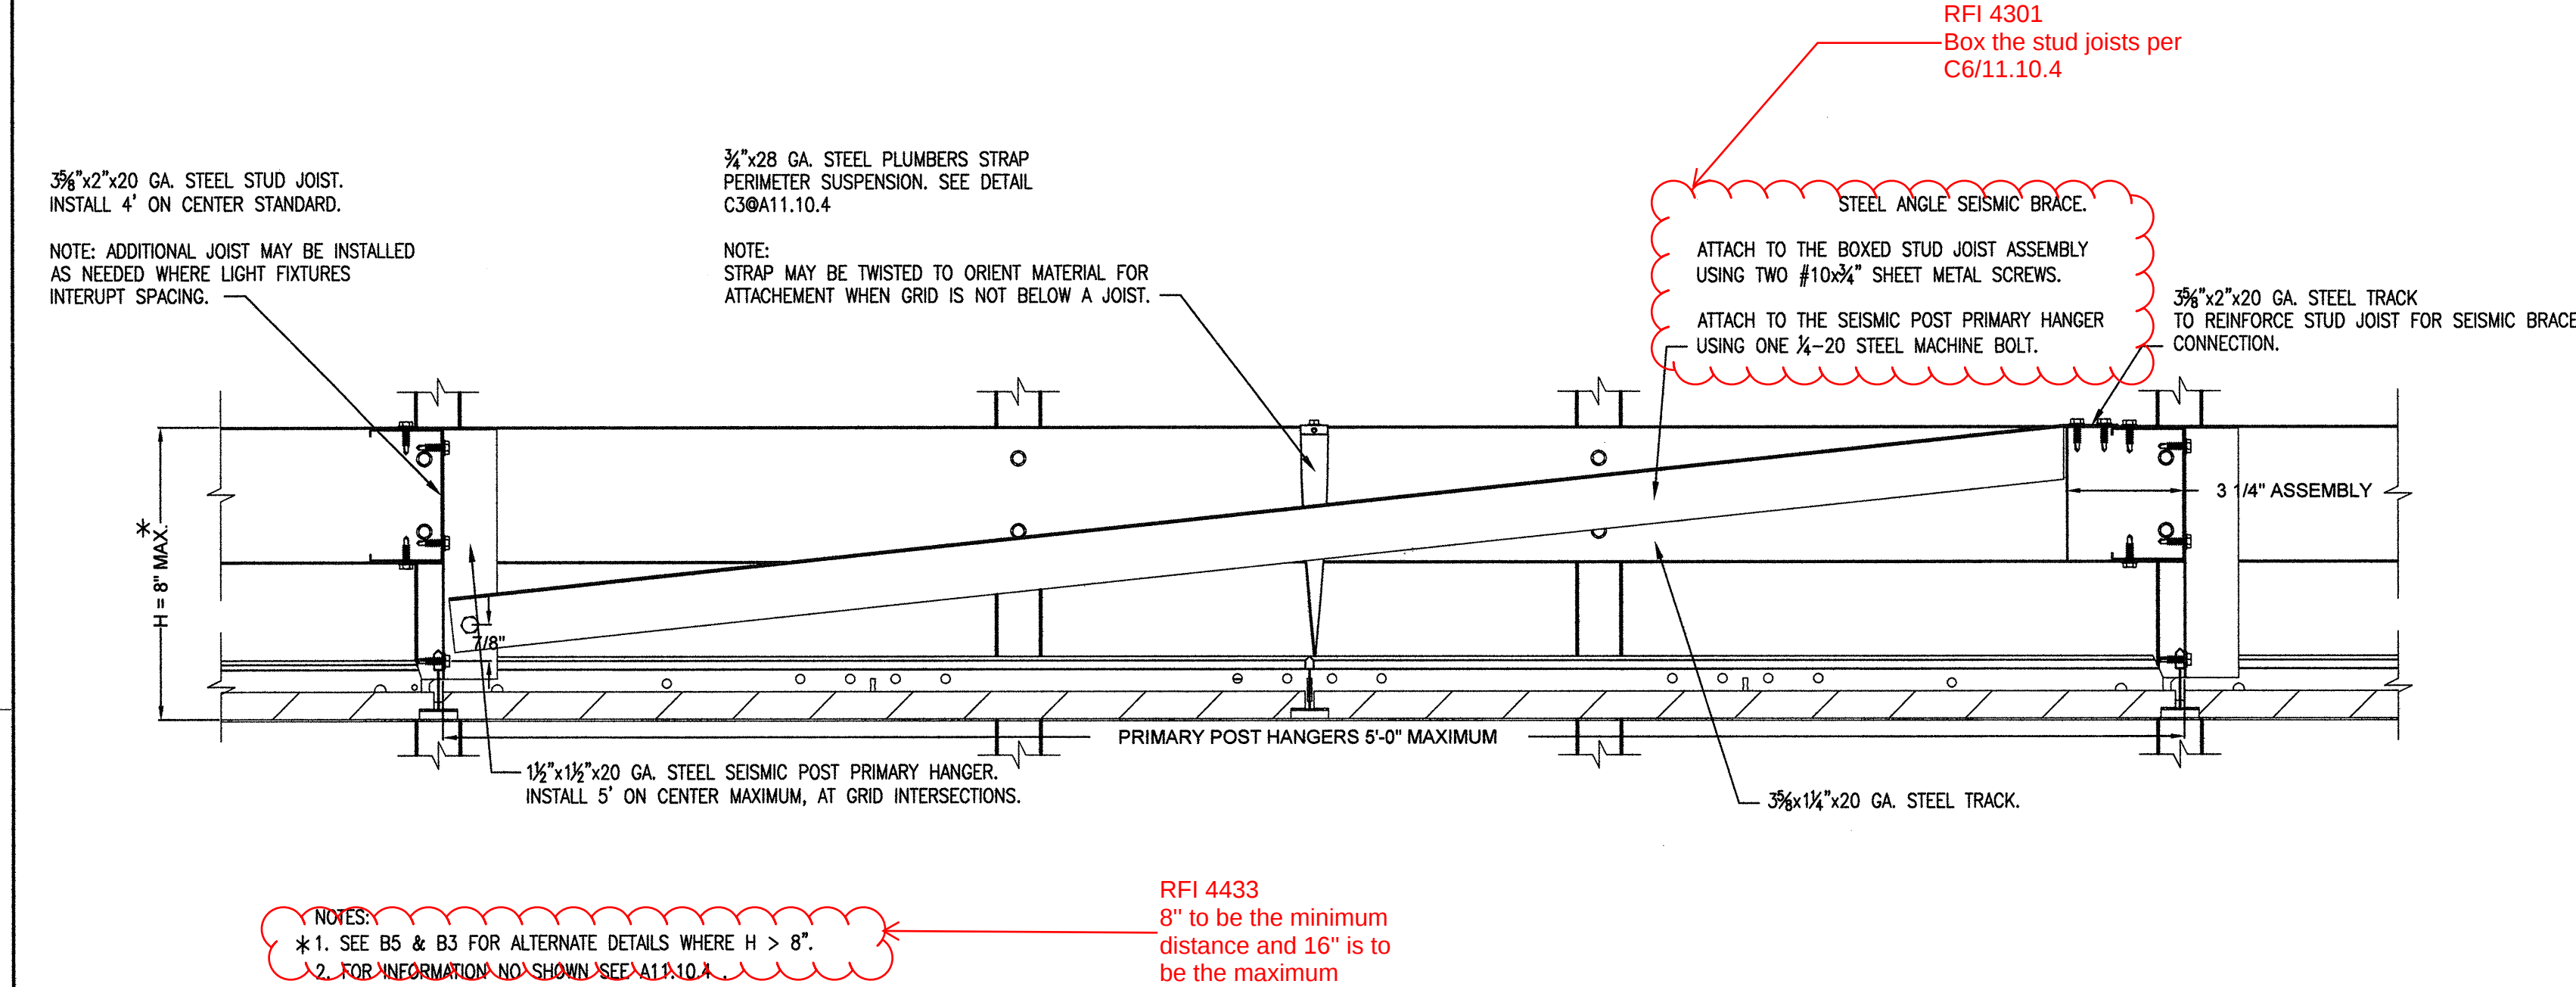

B06 COMPRESSION POST-CONNECTION TO WALL OBSTRUCTION CEILING DETAIL

B05 SPLAY WIRE ATTACHMENT TO CEILING JOIST

B03 SPLAY WIRE ATTACHMENT PERPENDICULAR TO CEILING JOIST

A02 GENERAL NOTES