


FKP Architects

ARCHITECT OF RECORD
Paul C. Gloriot

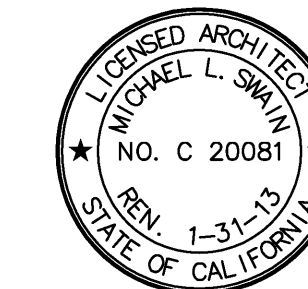

Changes on these drawings do not consist of
materially altered changes to approved drawings
and do not require a change order.
OSHPD review ACO
OSHPD review FLSO
OSHPD review DSE

REVISIONS

NO.	DATE	DESCRIPTION
11	03/11/10	CHANGE ORDER #17
14	05/27/10	CHANGE ORDER #14
388	11/17/11	ASH#136

APPROVAL



CHANGE ORDER#
INSTRUCTION BULLETIN#
DEFERRED APPROVAL#
DATE

PROJECT NAME

CHILDREN'S HOSPITAL
OF ORANGE COUNTY

455 S. Main St.
Orange, CA 92668-3874

TOWER II



PROJECT NUMBER

12011.00
Increment #7

OSHPD - PROJECT NUMBER
IL 072072-30

ISSUE
OSHPD PERMIT

DATE
01/27/2010

SCALE

N.T.S.

DRAWING TITLE

TYPICAL PARTITION
DETAILS

DRAWING NUMBER

A11.3.1

