


FKP Architects

ARCHITECT OF RECORD
Paul C. Gloriot

FOR INFORMATION ONLY

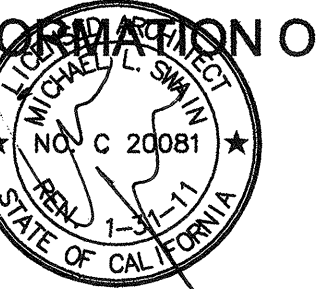


RFI 694
All power driven
fasteners size is
1/2" dia HILTI
1" long

REVISIONS

02/05/10 INFORMATION BULLETIN #5
03/11/10 CHANGE ORDER #17

RFI 2385
Type 7 pacu headwall

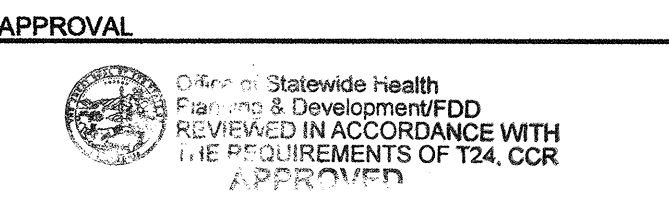

PROJECT NAME
**CHILDREN'S HOSPITAL
OF ORANGE COUNTY**
455 S. Main St.
Orange, CA 92668-3874

TOWER II



PROJECT NUMBER

12011.00
Increment #7

OSHPD - PROJECT NUMBER

IL 072072-30

ISSUE

OSHPD PERMIT

DATE

01/27/2010

SCALE

N.T.S.

DRAWING TITLE

TYPICAL PARTITION
TYPES

DRAWING NUMBER

A11.3

