


FKP Architects

ARCHITECT OF RECORD

Paul C. Glorid

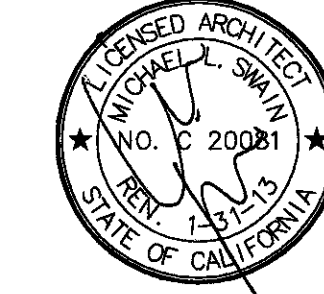

Changes on these drawings do not consist of material changes to approved drawings and don't require a change order.
OSHPD review FSD
OSHPD review DSE

REVISIONS

02	07/28/10	AS#16
93	11/08/10	AS#28
100	02/18/11	AS#56
541	06/30/11	ASI #112
592A	02/13/11	CO #300

APPROVAL



INSTRUCTION BULLETIN
REVIEWED IN ACCORDANCE WITH
THE REQUIREMENTS OF 24 CCR
ADDITIONAL

CHANGE ORDER #200
INSTRUCTION BULLETIN
DEFERRED APPROVAL
ADDENDUM

PROJECT NAME **PAP 2012-0239B**

**CHILDREN'S HOSPITAL
OF ORANGE COUNTY**

455 S. Main St.
Orange, CA 92668-3874

TOWER II

Received
June 05 2012
McCarthy



PROJECT NUMBER

**12011.00
Increment #7**

OSHPD - PROJECT NUMBER
IL 072072-30

ISSUE
OSHPD PERMIT

DATE
01/27/2010

SCALE

N.T.S.
DRAWING TITLE

**DOOR- OPENING
SCHEDULE LEVEL 4**

DRAWING NUMBER

A11.0.6

Opening Schedule_12-06-2011

Room Name	Opening Number	Opening			Frame	Hardware	Fire Rating	Remarks	Security	Electrical	Revisions
		Size	Type	Material	Type						
PUBLIC ELEVATOR LOBBY	4.000.00 La	W 8'-0" X H 7'-0"	2B	WDP	HM-10	100	U2S	5.18	--	X	2
PUBLIC ELEVATOR LOBBY	4.000.00 Lb	W 1'-10" X H 8'-0"	A	WDP	HM-1	121	U2S	12	--	--	--
PUBLIC ELEVATOR LOBBY	4.000.00 Lc	W 28'-0" X H 9'-0"	U	--	--	--	U2S	12,28.46	--	--	--
SHELL	4.002.A	W 3'-0" X H 7'-0"	A	WDP	HM-1	126	U1S	--	--	--	--
SHELL	4.002.B	W 6'-0" X H 7'-0"	2A	WDP	HM-1	102	U1S	--	--	--	--
CONSULT RM	4.004.01	W 3'-0" X H 7'-0"	A	WDP	HM-1	140	--	--	--	--	--
ALCOVE-SHELVE	4.004.01A	W 3'-6" X H 7'-0"	A	WDP	HM-1	140	--	--	--	--	2
CORRIDOR	4.013.00.C	W 8'-0" X H 7'-0"	2B	WDP	HM-10	100	--	5.18	--	X	2
NURSE STATION	4.017.00.A	W 3'-6" X H 7'-0"	B	WDP	HM-1	161	--	62	X	X	1
ALCOVE-NOURISHMENT	4.018.02A	W 7'-5" X H 8'-0"	W	OFD	--	149	U1S	26.78	--	X	--
CONFERENCE ROOM	4.019.03a	W 5'-0" X H 7'-0"	A	WDP	HM-1	117	--	--	--	--	2
CONFERENCE ROOM	4.019.03b	W 3'-0" X H 7'-0"	A	WDP	HM-1	140	U1S	--	--	--	--
OFFICE MULTI-PURPOSE	4.019.04	W 3'-0" X H 7'-0"	A	WDP	HM-1	117	--	--	--	--	--
OFFICE CHARGE NURSE	4.019.05	W 3'-0" X H 7'-0"	A	WDP	HM-1	117	--	--	--	--	--
OFFICE NURSE MANAGER	4.019.06	W 3'-0" X H 7'-0"	A	WDP	HM-1	117	--	--	--	--	--
SHELL	4.026.00.C	W 8'-0" X H 7'-0"	2B	WDP	HM-10	100	U1S	5.18	--	X	2
ALCOVE-NOURISHMENT	4.043.00A	W 7'-4 1/2" X H 8'-0"	W	OFD	--	140	U1S	26.78	--	--	--
TOILET STAFF FEMALE	4.040.01	W 3'-0" X H 7'-0"	A	WDP	HM-1	122A	--	--	--	--	--
STORAGE GENERAL	4.052.01	W 3'-0" X H 7'-0"	A	WDP	HM-1	142	--	--	--	--	2
HOUSE KEEPING	4.052.02	W 3'-0" X H 7'-0"	A	WDP	HM-1	144	--	--	--	--	--
VESTIBULE	4.052.03	W 4'-0" X H 7'-0"	A	WDP	HM-1	147	U2S	--	--	--	--
ALCOVE-NOURISHMENT	4.057.00A	W 11'-0" X H 8'-0"	W	OFD	--	149	U1S	46	--	X	--
SHELL	4.057.00.Ca	W 8'-0" X H 7'-0"	2B	WDP	HM-10	100	U1S	5.18	--	X	2
CORRIDOR	4.057.00.C	W 8'-0" X H 7'-0"	2B	WDP	HM-10	100	--	5.18	--	X	2
MEDICATION STATION	4.067.01	W 3'-0" X H 7'-0"	B	WDP	HM-1	160	U1S	5.62	X	X	2
NURSE STATION	4.069.00A	W 3'-0" X H 7'-0"	A	WDP	HM-1	161	--	62	X	X	2
SOILED WORKROOM	4.069.01	W 3'-0" X H 7'-0"	B	WDP	HM-1	145	U1S	5.62	--	--	--
TOILET STAFF MALE	4.069.02	W 3'-0" X H 7'-0"	A	WDP	HM-1	122A	--	--	--	--	--
ON-CALL RM	4.071.02	W 3'-0" X H 7'-0"	A	WDP	HM-1	117A	--	--	--	--	--
ON-CALL RM	4.071.03	W 3'-0" X H 7'-0"	A	WDP	HM-1	117A	--	--	--	--	--
TOILET ON CALL UNISEX	4.071.04	W 3'-0" X H 7'-0"	A	WDP	HM-1	122A	--	--	--	--	--
AIRBORNE INFECTION ISOLATION ROOM	4.072.01	W 4'-0" X H 7'-0"	C	WDP	HM-6	159A	--	1.8	--	--	--
AIRBORNE INFECTION ISOLATION ROOM	4.074.01	W 4'-0" X H 7'-0"	C	WDP	HM-6	159A	--	1.8	--	--	--
AIRBORNE INFECTION ISOLATION ROOM	4.076.01	W 4'-0" X H 7'-0"	C	WDP	HM-6	159A	--	1.8	--	--	--
AIRBORNE INFECTION ISOLATION ROOM	4.078.01	W 4'-0" X H 7'-0"	C	WDP	HM-6	159A	--	1.8	--	--	--
CORRIDOR	4.079.00.Ca	W 8'-0" X H 7'-0"	2B	WDP	HM-10	100	--	2.18	--	X	2
CORRIDOR	4.079.00.Cb	W 3'-0" X H 7'-0"	A	WDP	HM-1	147	U1S	--	--	--	--
BLOOD GAS LAB	4.079.01	W 3'-0" X H 7'-0"	A	WDP	HM-1	116A	--	62	X	X	--
TOILET STAFF UNISEX	4.079.02	W 3'-0" X H 7'-0"	A	WDP	HM-1	138	--	--	--	--	--
TOILET PUBLIC UNISEX	4.079.03	W 3'-0" X H 7'-0"	A	WDP	HM-1	138	--	--	--	--	--
STAFF PATIENT ELEVATOR LOBBY	4.081.00.La	W 8'-0" X H 7'-0"	2B	WDP	HM-1	181A	U2S	5.61.79	--	--	1
STAFF PATIENT ELEVATOR LOBBY	4.081.00.Lb	W 8'-0" X H 7'-0"	2B	WDP	HM-1	181A	U1S	5.18,61.79	--	X	--
STORAGE EQUIPMENT	4.083.01	W 4'-0" X H 7'-0"	A	WDP	HM-1	126	U1S	--	--	--	--
SIBLING WAIT/ACTIVITY ROOM	4.002	W 3'-0" X H 7'-0"	E	WDP	HM-5	121	--	1.8.18	--	--	--
HOUSE KEEPING	4.005	W 3'-0" X H 7'-0"	A	WDP	HM-1	144	--	--	--	--	--
LACTATION ROOM	4.007	W 3'-0" X H 7'-0"	A	WDP	HM-1	125	--	--	--	--	--
NCU PATIENT ROOM	4.008a	W 4'-0" X H 7'-0"	C	WDP	HM-1	174	--	1	--	--	--
NCU PATIENT ROOM	4.008b	W 3'-0" X H 7'-0"	A	WDP	HM-1	125	--	--	--	--	--
NCU PATIENT ROOM	4.008c	W 2'-6" X H 3'-11"	--	--	AL-8	--	--	1.8,37	--	--	--
NCU PATIENT ROOM	4.008d	W 2'-0" X H 3'-11"	--	--	AL-8	--	--	1.8,37	--	--	--
SOILED WORKROOM	4.009	W 3'-0" X H 7'-0"	B	WDP	HM-1	145	U1S	5.62	--	--	--
NCU PATIENT ROOM	4.010a	W 8'-6" X H 7'-2 1/2"	AL-5	ASD	AL-5	143	U0	1.33	3791	--	2
NCU PATIENT ROOM	4.010b	W 2'-4" X H 3'-11"	--	--	AL-8	--	--	1.8,37	--	--	--
NCU PATIENT ROOM	4.010c	W 2'-4" X H 3'-11"	--	--	AL-8	--	--	1.8,37	--	--	--
NCU PATIENT ROOM ACCESSIBLE	4.010d	W 8'-6" X H 7'-2 1/2"	AL-5	ASD	AL-5	143	U0	1.33	--	--	2
NCU PATIENT ROOM ACCESSIBLE	4.010e	W 2'-6" X H 3'-11"	--	--	AL-8	--	--	1.8,37	--	--	--
NCU PATIENT ROOM ACCESSIBLE	4.010f	W 2'-4" X H 3'-11"	--	--	AL-8	--	--	1.8,37	--	--	--
CLEAN UTILITY LINEN	4.010g	W 3'-0" X H 7'-0"	B	WDP	HM-1	145	U1S	5	--	--	--
CLEAN UTILITY LINEN	4.010h	W 3'-0" X H 7'-0"	B	WDP	HM-1	145	U1S	5.62	X	X	--
NCU PATIENT ROOM	4.010i	W 8'-6" X H 7'-2 1/2"	AL-5	ASD	AL-5	143	U0	1.33	--	--	2
NCU PATIENT ROOM	4.010j	W 2'-6" X H 3'-11"	--	--	AL-8	--	--	1.8,37	--	--	--
NCU PATIENT ROOM	4.010k	W 2'-4" X H 3'-11"	--	--	AL-8	--	--	1.8,37	--	--	--
NCU PATIENT ROOM	4.010l	W 8'-6" X H 7'-2 1/2"	AL-5	ASD	AL-5	143	U0	1.33	--	--	2
NCU PATIENT ROOM	4.010m	W 2'-6" X H 3'-11"	--	--	AL-8	--	--	1.8,37	--	--	--
NCU PATIENT ROOM	4.010n	W 2'-4" X H 3'-11"	--	--	AL-8	--	--	1.8,37	--	--	--
NCU PATIENT ROOM	4.010o	W 8'-6" X H 7'-2 1/2"	AL-5	ASD	AL-5	143	U0	1.33	--	--	2
NCU PATIENT ROOM	4.010p	W 2'-6" X H 3'-11"	--	--	AL-8	--	--	1.8,37	--	--	--
NCU PATIENT ROOM	4.010q	W 2'-4" X H 3'-11"	--	--	AL-8	--	--	1.8,37	--	--	--
HALL	4.010r	W 3'-0" X H 7'-0"	A	WDP	HM-1	121	U1S	--	--	--	--
HALL	4.010s	W 3'-0" X H 7'-0"	A	WDP	HM-1	121	U1S	--	--	--	--
NCU PATIENT ROOM	4.020a	W 8'-6" X H 7'-2 1/2"	AL-5	ASD	AL-5	143	U0	1.33	--	--	2
NCU PATIENT ROOM	4.020b	W 2'-6" X H 3'-11"	--	--	AL-8	--	--	1.8,37	--	--	--
NCU PATIENT ROOM	4.020c	W 2'-4" X H 3'-11"	--	--	AL-8	--	--	1.8,37	--	--	--
TOILET/SHOWER PUBLIC UNISEX	4.021	W 3'-0" X H 7'-0"	A	WDP	HM-1	130	--	--	--	--	--
NCU PATIENT ROOM	4.020d	W 8'-6" X H 7'-2 1/2"	AL-5	ASD	AL-5	143	U0	1.33	--	--	2
NCU PATIENT ROOM	4.020e	W 2'-4" X H 3'-11"	--	--	AL-8	--	--	1.8,37	--	--	--
NCU PATIENT ROOM	4.020f	W 2'-4" X H 3'-11"	--	--	AL-8	--	--	1.8,37	--	--	--
STORAGE EQUIPMENT	4.023	W 3'-0" X H 7'-0"	A	WDP	HM-1	142	U0	--	--	--	2
