


FKP Architects

ARCHITECT OF RECORD
Paul C. Gloriot

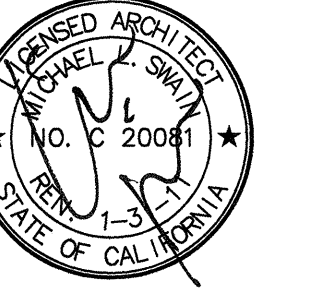

REVISIONS

49 06/09/10 CHANGE ORDER #44

APPROVAL

Office of Statewide Health
Planning & Development (FDD)
REVIEWED IN ACCORDANCE WITH
THE REQUIREMENTS OF 124, CCR
17, 2009

CHANGE ORDER #44

INSTRUCTIONS FOR THE
PREPARED BY

PROJECT NAME

CHILDREN'S HOSPITAL
OF ORANGE COUNTY

455 S. Main St.
Orange, CA 92668-3874

TOWER II

CHOCSM
HOSPITAL

PROJECT NUMBER

12011.00
Increment #7

OSHPD - PROJECT NUMBER

IL 072072-30

ISSUE
OSHPD PERMIT

DATE

01/27/2010

SCALE

N.T.S.


DRAWING TITLE

MISC. DETAILS

DRAWING NUMBER


A11.8.1

49

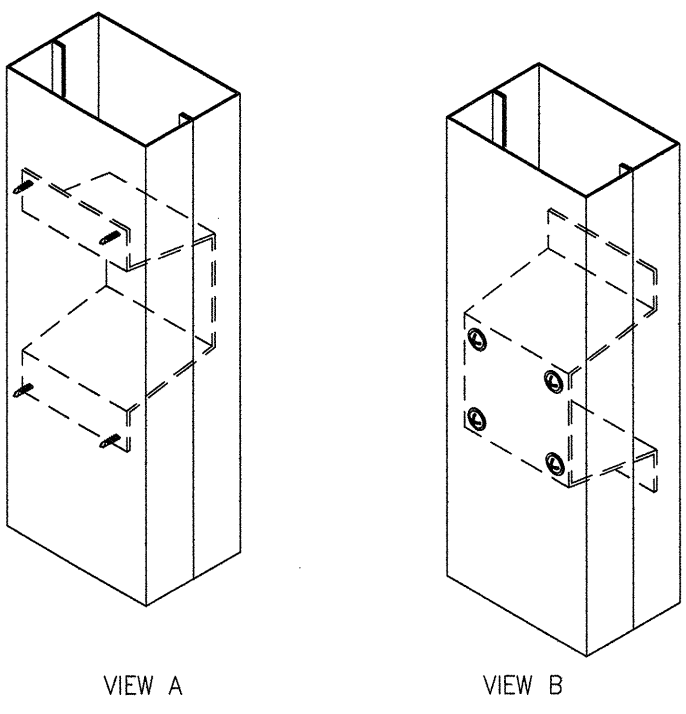

NOTE: HEADER AND CLIP REMOVED FOR CLARITY

C5 TYP. INTERIOR JAMB CONNECTOR CLIP (JCC)
ISOMETRIC VIEW OF INSTALLED CLIP

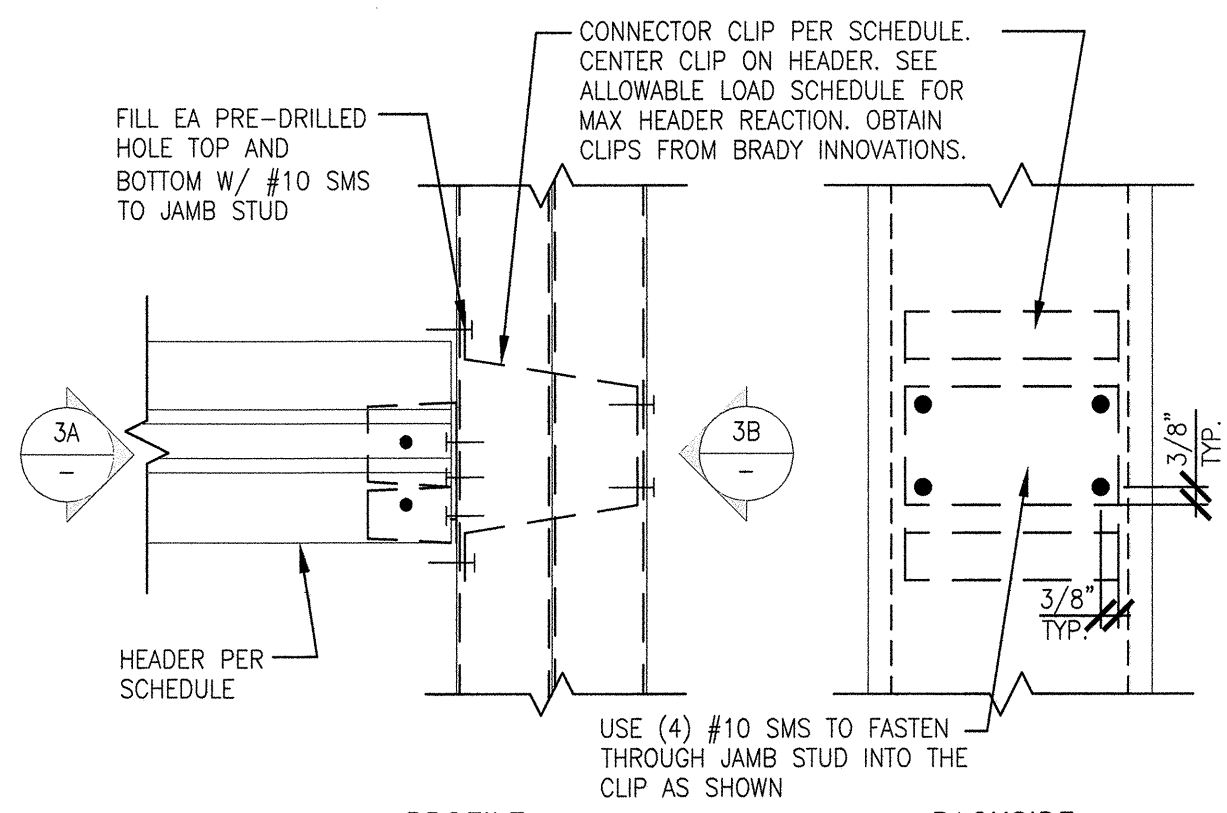

B5 TYP. INTERIOR JAMB CONNECTOR CLIP (JCC) DETAIL


STUD ORIENTATION -	ALLOWABLE LATERAL HEADER REACTION
3 5/8" AND 4" STUDS	
JAMB FLANGE WIDTH CLIP DESIGNATION	MAX LOAD JAMB STUD GAUGE
1 5/8" 362JCC162-68	375# 54 MIL
2" 362JCC200-68	490# 68 MIL MIN.
2 1/2" 362JCC250-68	
3" 362JCC300-68	
6" STUDS	
JAMB FLANGE WIDTH CLIP DESIGNATION	MAX LOAD JAMB STUD GAUGE
1 5/8" 600JCC162-68	775# 54 MIL
2" 600JCC200-68	1000# 68 MIL MIN.
2 1/2" 600JCC250-68	
3" 600JCC300-68	
8" STUDS	
JAMB FLANGE WIDTH CLIP DESIGNATION	MAX LOAD JAMB STUD GAUGE
1 5/8" 800JCC162-68	1025# 54 MIL
2" 800JCC200-68	1350# 68 MIL MIN.
2 1/2" 800JCC250-68	
3" 800JCC300-68	

B6 JAMB FLANGE WIDTH -
CLIP DESIGNATION


B5 ALLOWABLE LATERAL
HEAD REACTION

- NOTES
- (1). ENGINEER SHALL SPECIFY GAUGE AND SIZE OF PRO-X PRODUCTS USING THE PROJECT LOADS AND SPANS ALONG WITH THE SECTION PROPERTIES PROVIDED IN THE ICC ESR-1765 REPORT.
 - (2). FOR 3 5/8", 4", 6", 8" STUDS.
 - (3). TOTAL WALL HEIGHT DOES NOT EXCEED 18'-0".
 - (4). THE HOLES ARE DRILLED USING A HOLE SAW, NOT BURNED WITH A CUTTING TORCH.
 - (5). THE HOLE(S) DO NOT EXCEED 1 1/4" IN DIAMETER.
 - (6). THE HOLE(S) ARE NOT PERMITTED TO BE WITHIN 12 INCHES OF THE END OF THE PRO-X HEADER.
 - (7). THE HOLE(S) ARE NOT PERMITTED WITHIN 1/2" OF THE OUTER (BOTTOM) CORNERS OF THE PRO-X HEADER.
 - (8). FOR PROJECT SPECIFIC CONDITIONS, CONTACT E.O.R.


C4 GENERAL NOTES FOR PRO-X HEADER
ICC ESR-1765

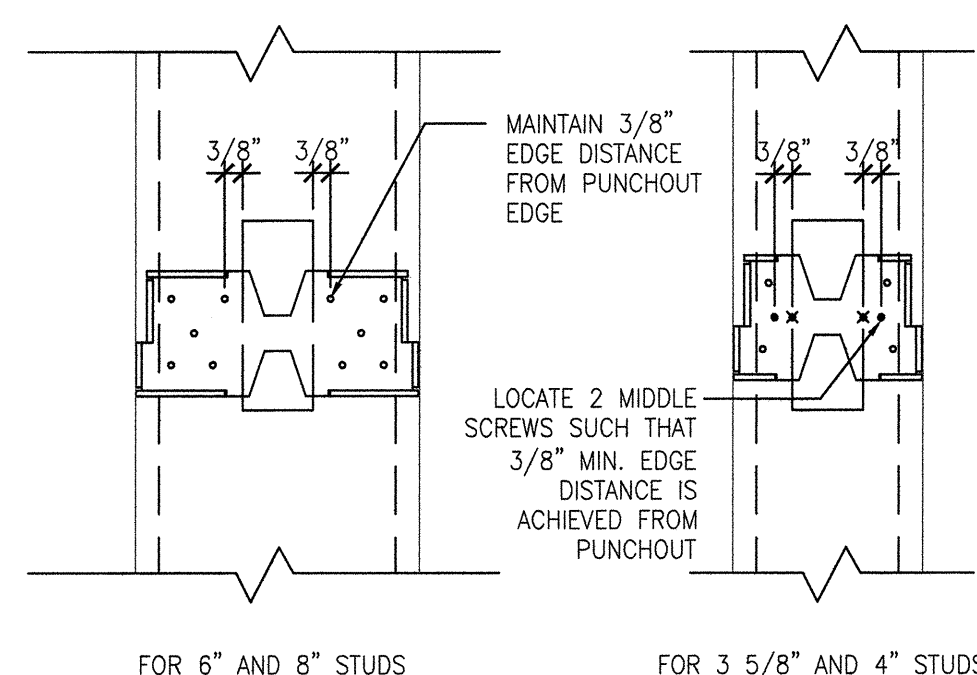


B4 FIX FOR PRO-X CLIP INSTALLED OVER STUD
PUNCHOUT

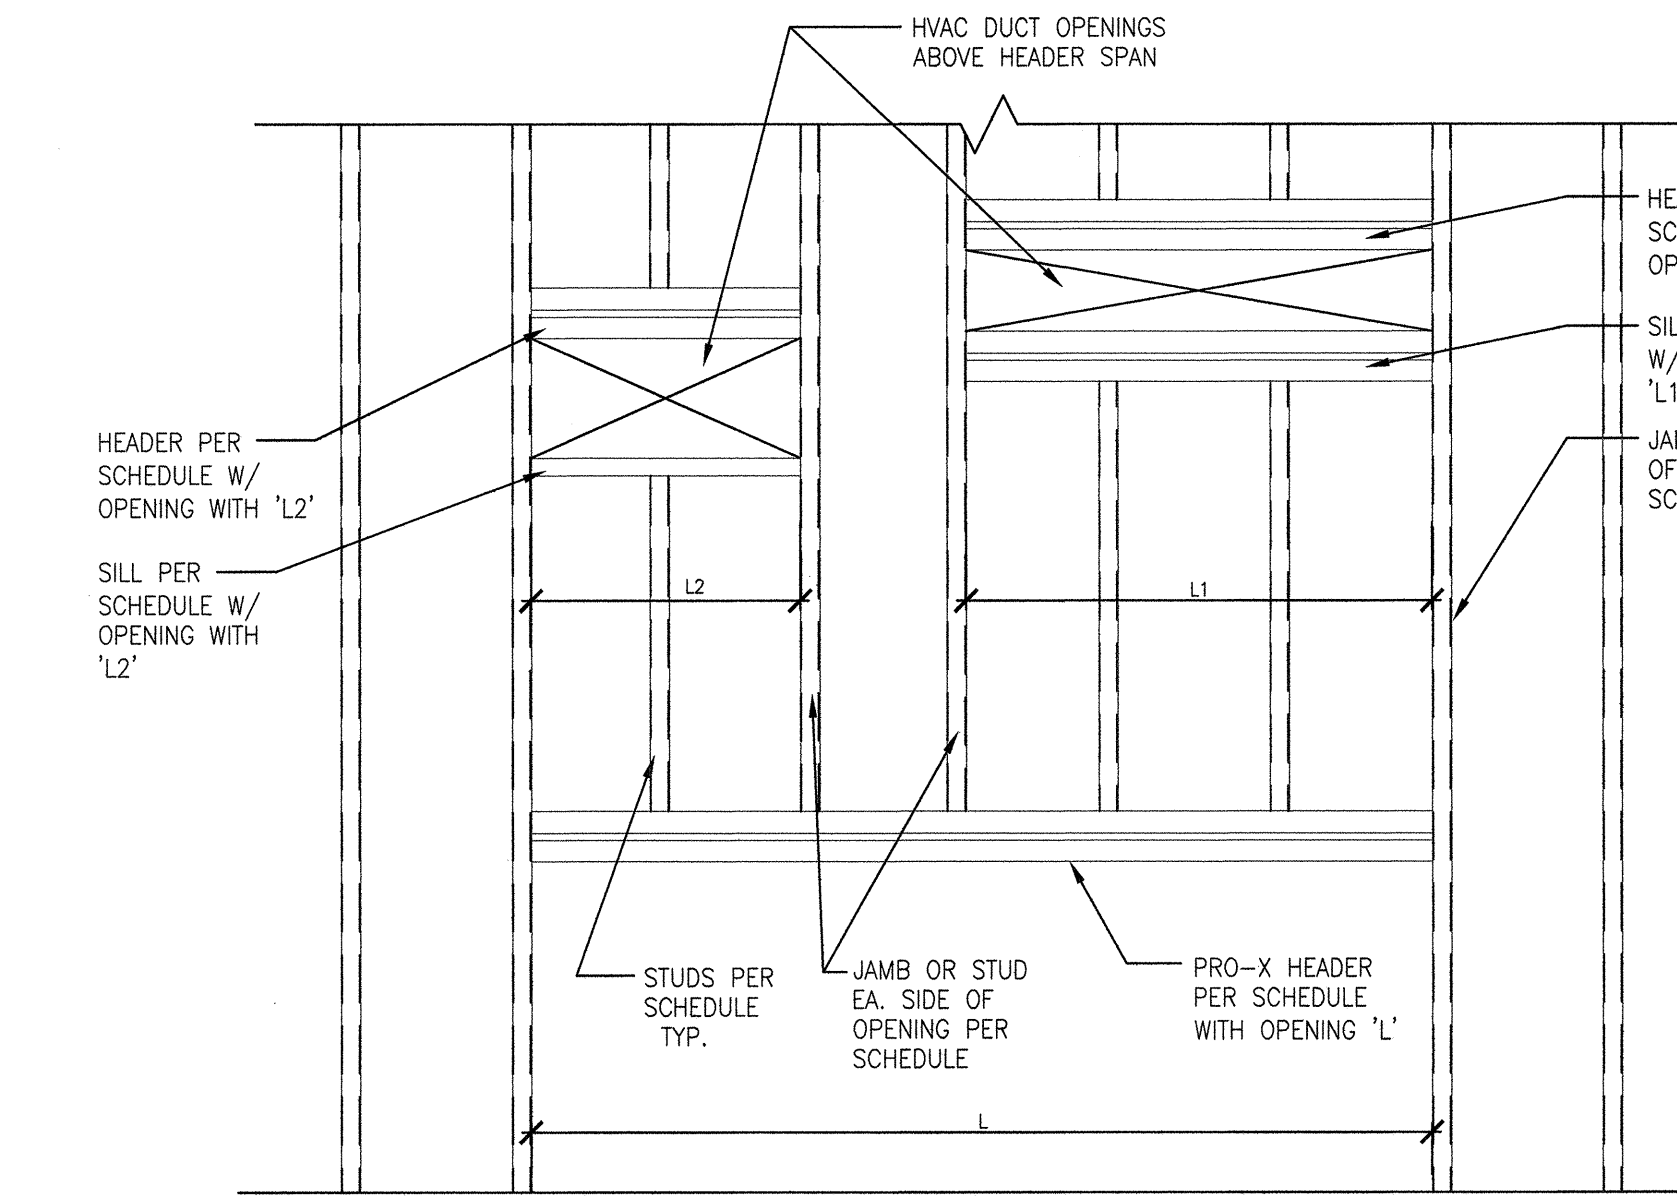


D3 HVAC OPENINGS ABOVE PRO-X HEADER

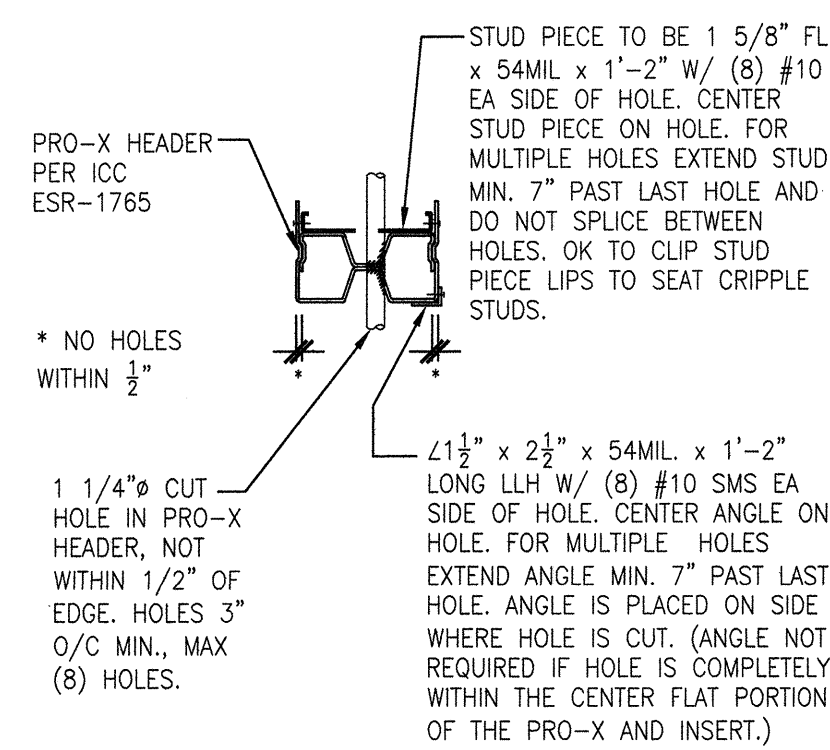


C3 FIX FOR VERTICAL PENETRATIONS IN PRO-X HEADER
- WITH INSERT

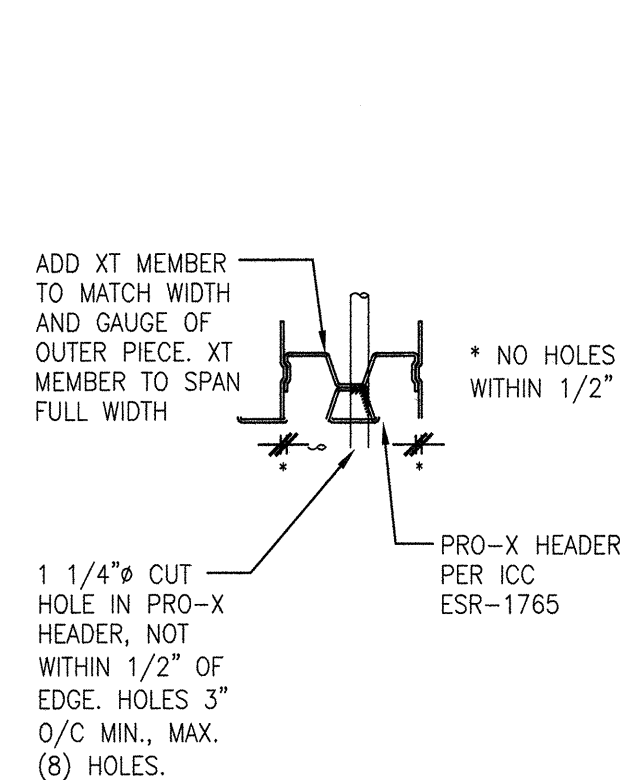


B3 FIX FOR VERTICAL PENETRATIONS IN PRO-X HEADER
- WITHOUT INSERT

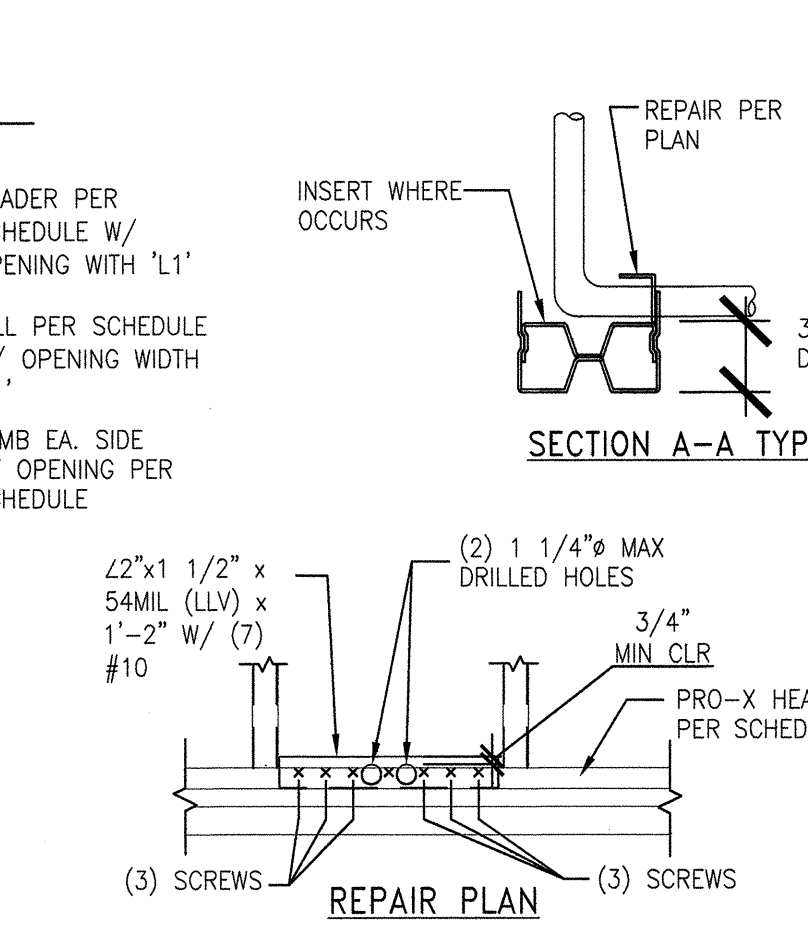



D2 ALLOWABLE HORIZONTAL PENETRATIONS IN PRO-X HEADER

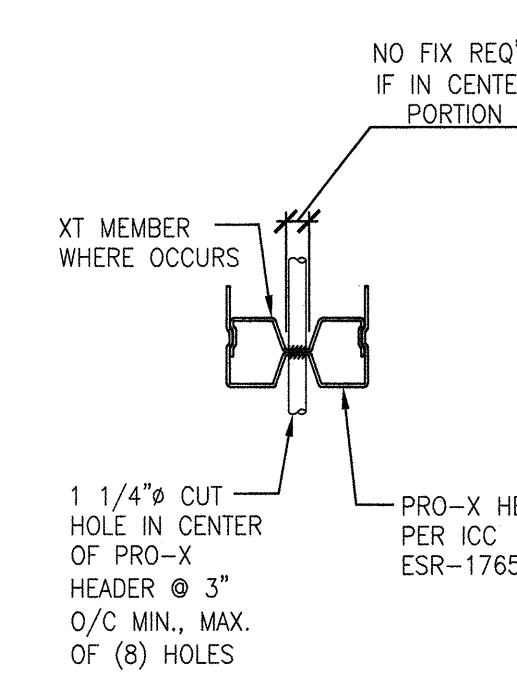

C2 ALLOWABLE VERTICAL PENETRATIONS IN PRO-X
HEADER - PREFERRED METHOD

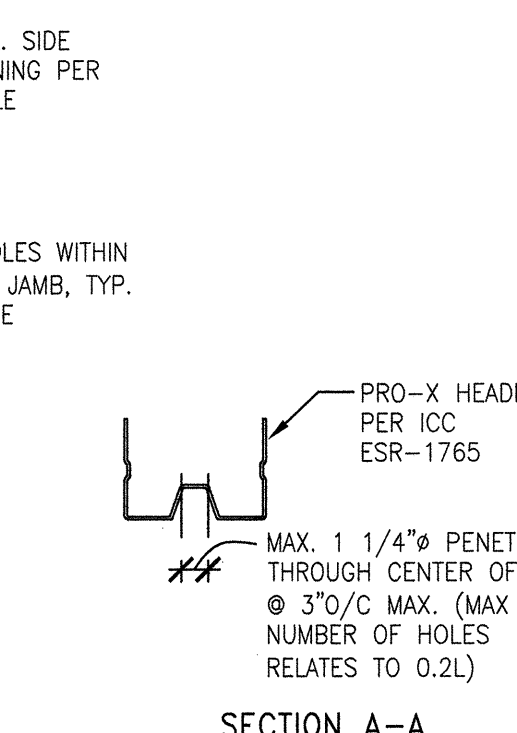


B2 ALLOWABLE VERTICAL PENETRATIONS IN PRO-X HEADER WITH
NO REINFORCEMENT REQUIRED - PREFERRED METHOD

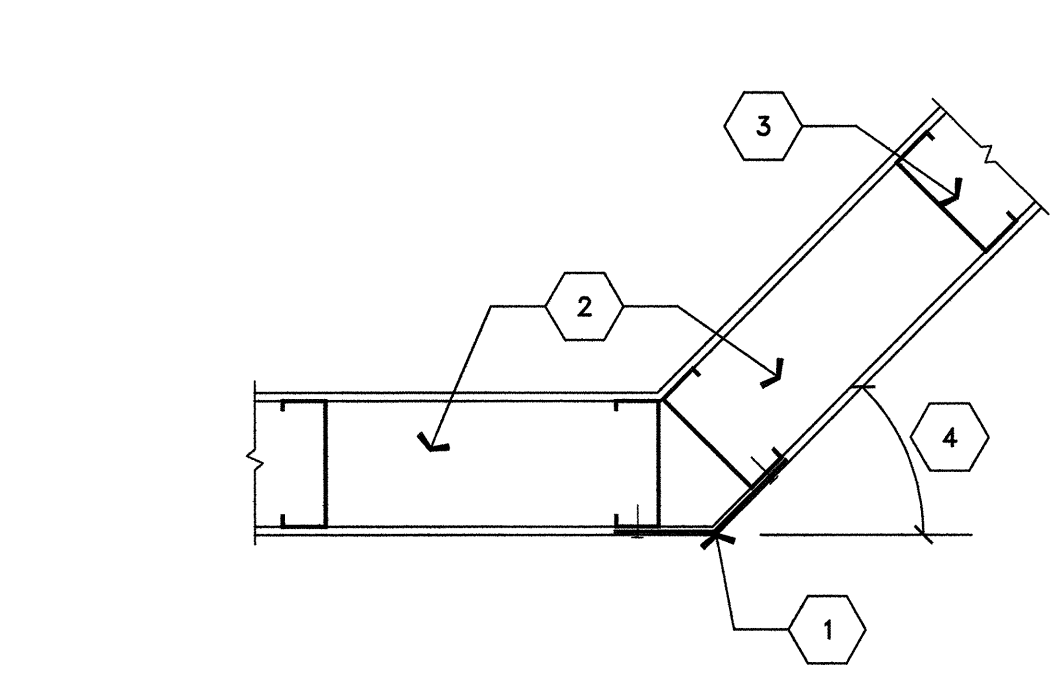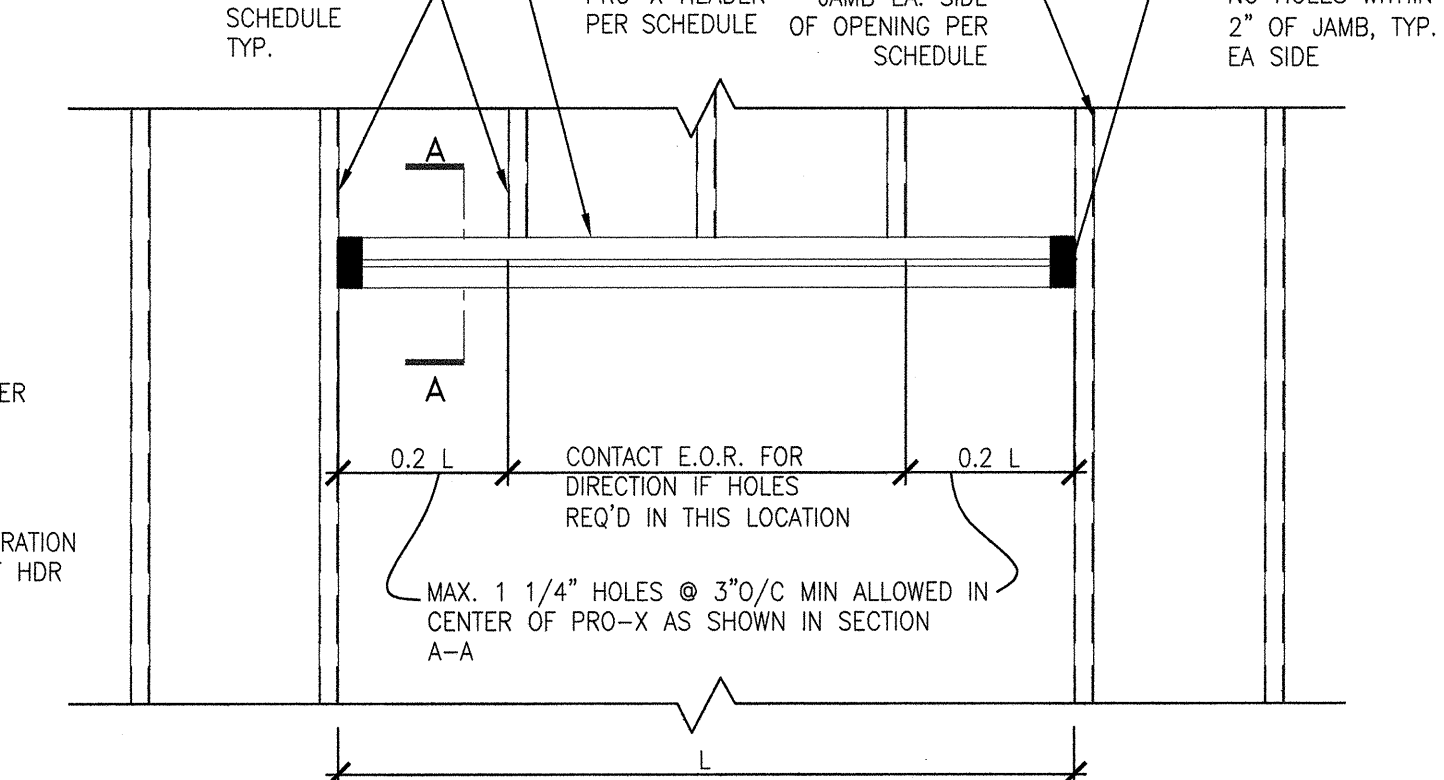


NOTE:
1. BENT ANGLE TO SIT ON BOTTOM TRACK
FLANGE TO ELIMINATE BUILD UP.
2. BENT ANGLE TO CONTINUE 6" ABOVE CEILING

1. 20GA BENT ANGLE CONT. W/ #10 SMS @ 12" O.C. EA STUD WHERE WALL FINISH OCCURS
2. TRACK BELOW PER PLAN
3. METAL STUDS PER PLAN (TYP.)
4. ANGLE @ CORNER PER PLAN

A6 DRYWALL BACKING DETAIL @ ANGLE CORNER


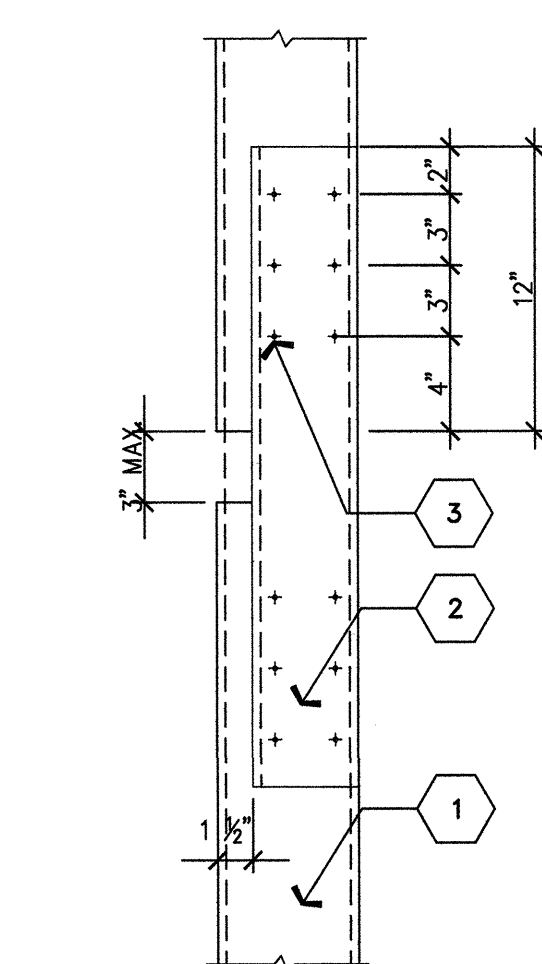


A5 STUD NOTCH DETAIL

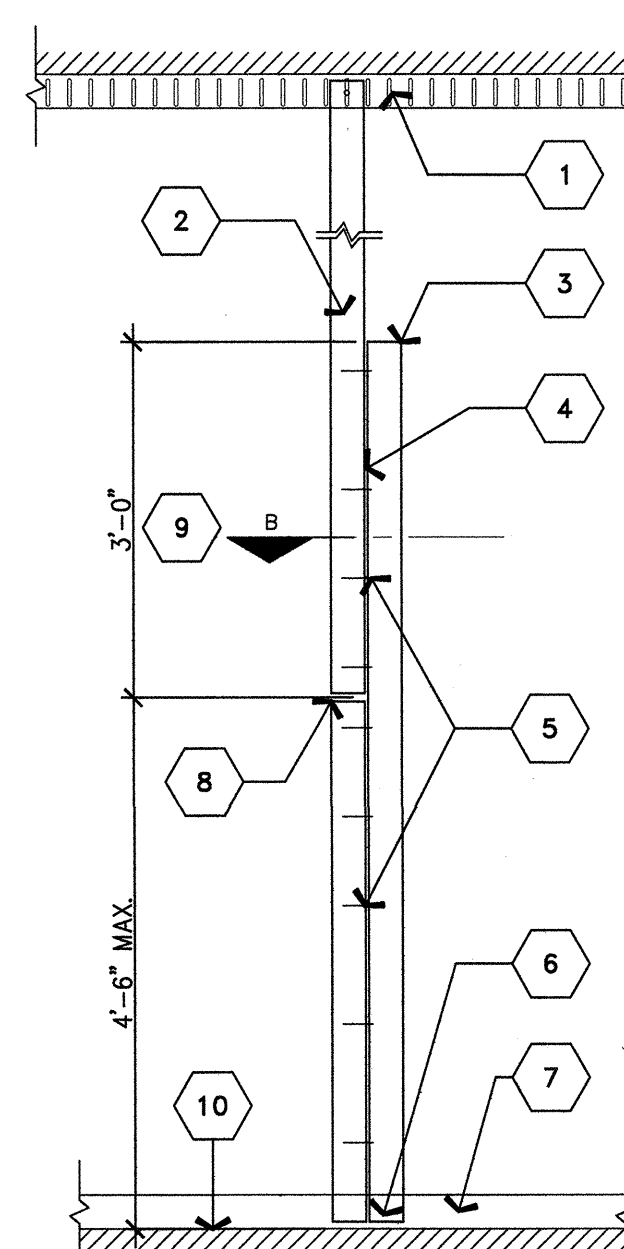


A4 DAMAGE STUD REPAIR

RFI 2010
Stud repair at outside corner

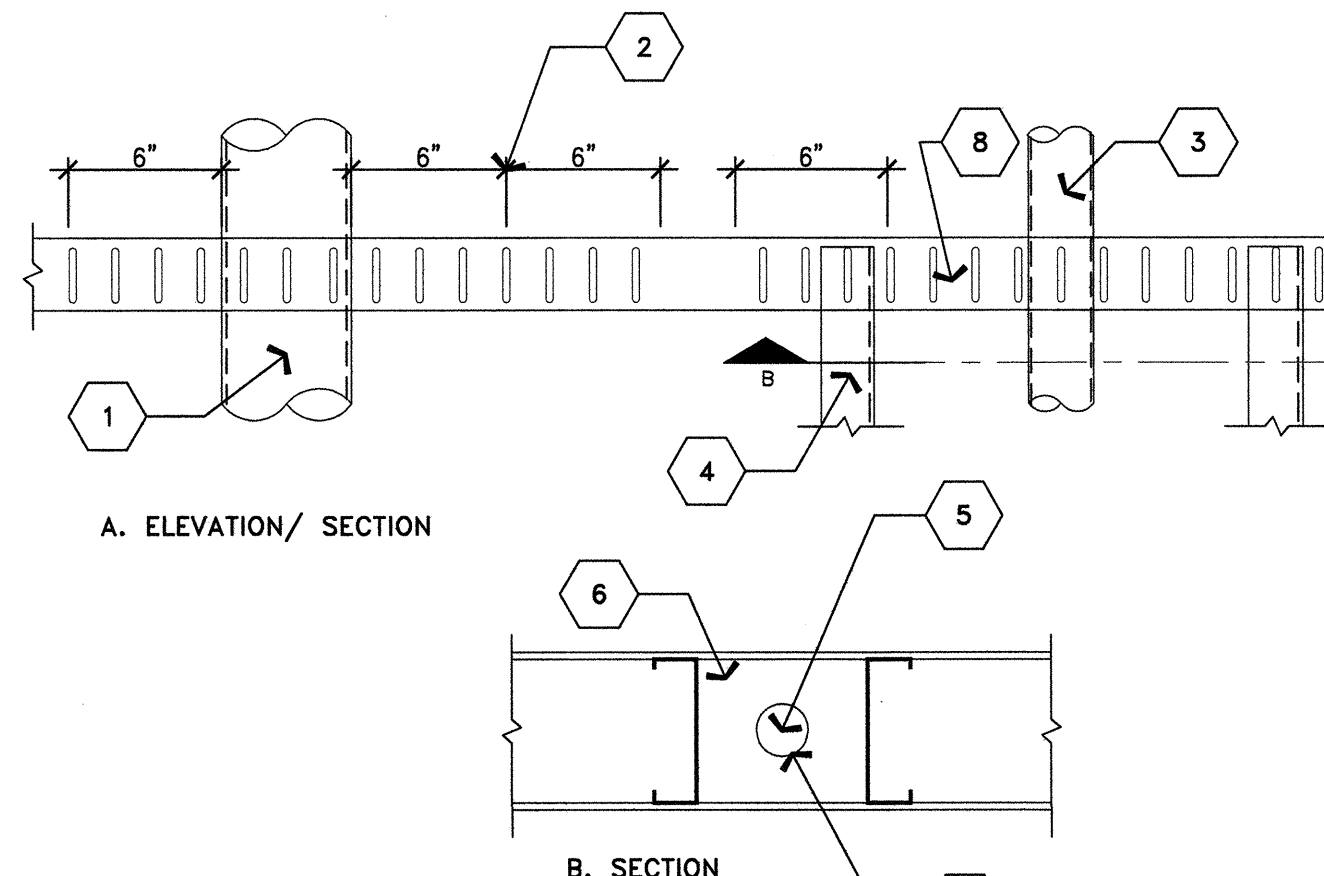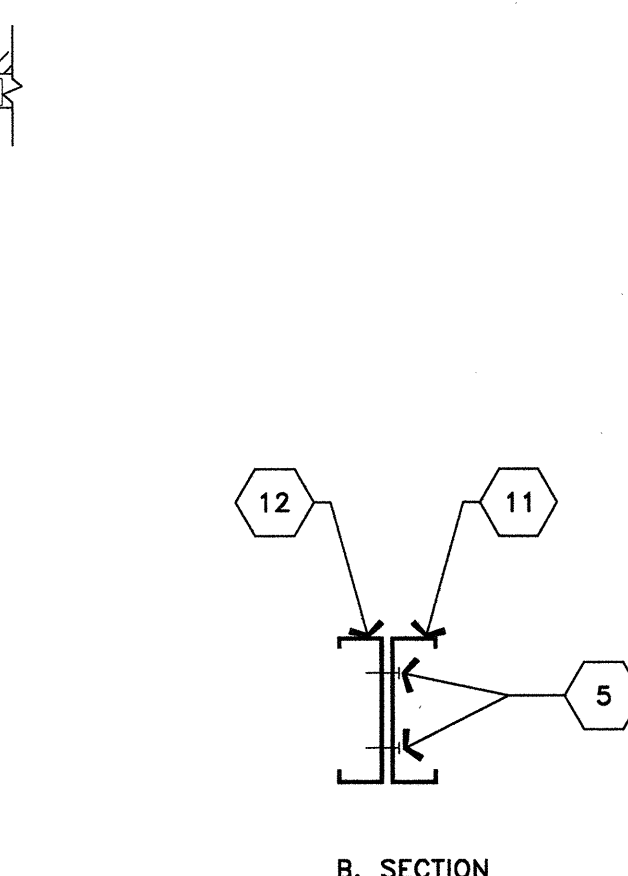

1. PIPE OR CONDUIT LARGER THAN 1 1/2" DIA. FOR 4" STUD, 2" DIA. FOR 6" STUD
2. SEE PARTITION SCHEDULE FOR FASTENER
3. PIPE OR CONDUIT METAL STUD
4. METAL STUD
5. HOLE TO BE CENTERED IN TRACK
6. TOP TRACK
7. 4" STUD- 1 1/4" DIA. MAX 6" STUD- 2" DIA. MAX
8. SLIP TRACK

A3 METAL TRACK REINFORCING DETAIL

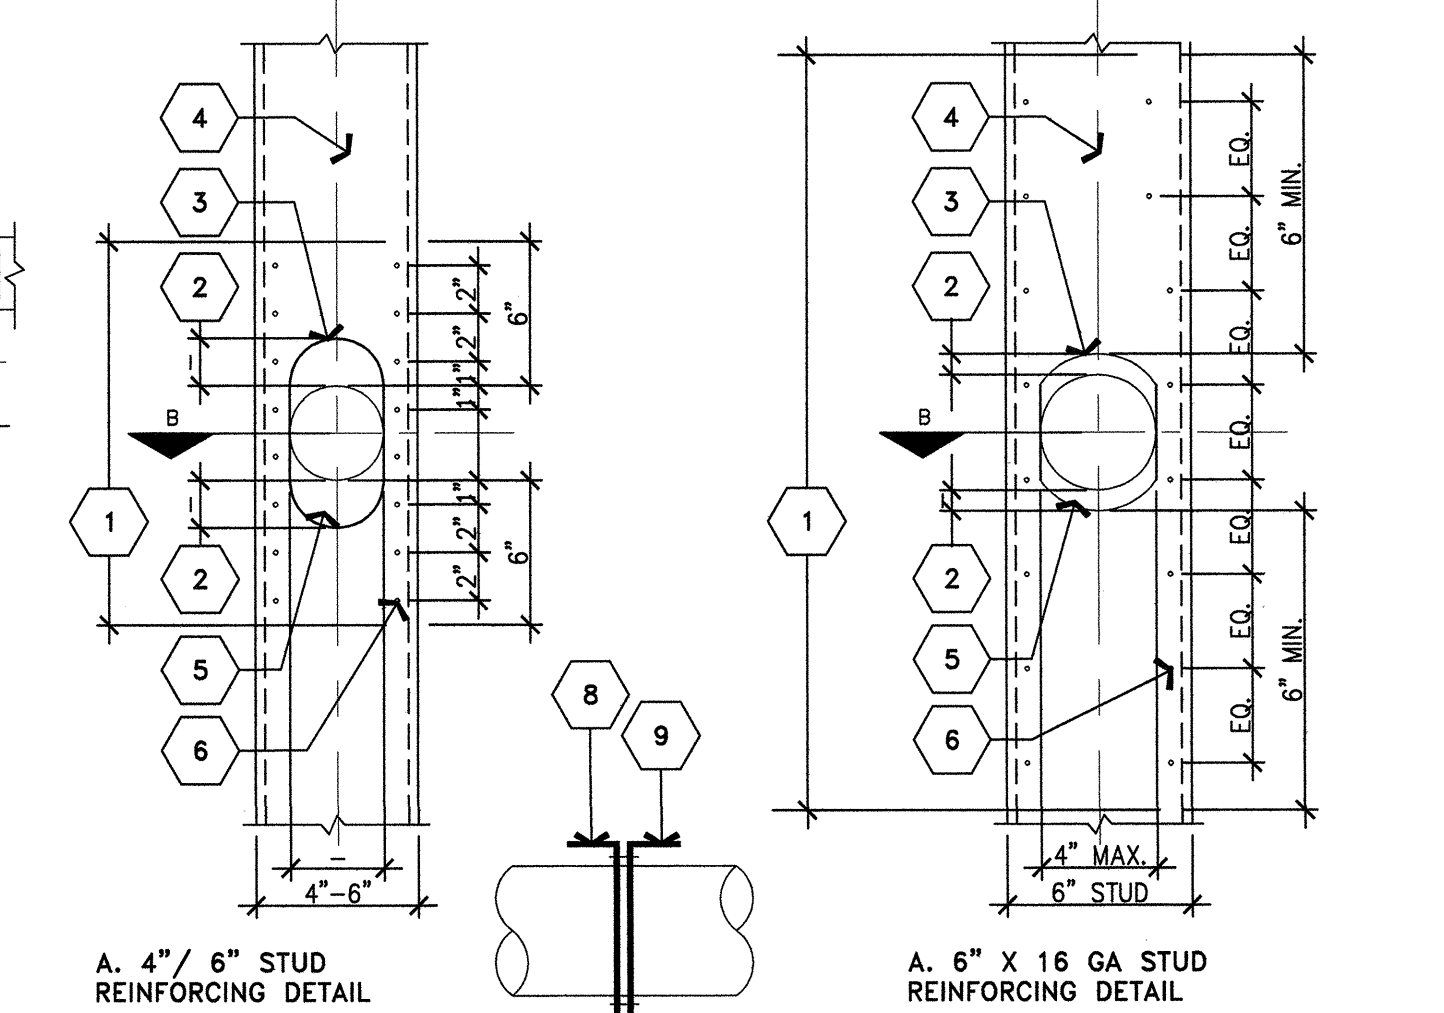

1. 1/2" FLANGE UNPUNCHED TRACK. GAUGE TO MATCH GAUGE OF VERT. STUD
2. 1/2" OVER CUT ALLOWED IN VERT @ EA END
3. PLUMBING OR CONDUIT PENETRATION IN VERT STUD
4. VERTICAL INTERIOR METAL STUD
5. PUNCHED OPENING IN REINF. TRACK DIAMETER OF OPENING TO MATCH O.D. PIPING OR CONDUIT +1"
6. #10 SMS - TYP.
7. (2) 4" WIDE PENETRATION MAX. NO OVER-CUT ALLOWED
8. VERT. STUD REINF. TRACK

A2 STUD REINFORCING DETAIL

RFI 3108
Alternate stud
reinforcement for partition
intersections where studs
are not accessible

NOTE:
1. FOR PIPE AND/ OR CONDUIT PENETRATIONS IN VERTICAL INTERIOR METAL STUDS 3" DIAMETER. REINFORCE THE STUD PER THE PROJECT SPECIFICATIONS.

RFI 2660 Acceptable
to penetrate metal stud
per attached sketch
CK 879-1