


FKP Architects

ARCHITECT OF RECORD
Paul C. Gloriot

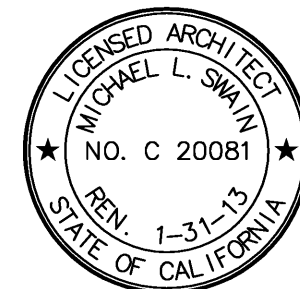

REVISIONS

11	03/11/10	CHANGE ORDER #17
71	08/06/10	COM#1
218	05/09/11	ASI #84

APPROVAL

PROJECT NAME

CHILDREN'S HOSPITAL
OF ORANGE COUNTY

455 S. Main St.
Orange, CA 92668-3874

TOWER II

RECEIVED
May 05 2011
McCarthy



PROJECT NUMBER

12011.00
Increment #7

OSHPD - PROJECT NUMBER

IL 072072-30

ISSUE

OSHPD PERMIT

DATE

01/27/2010

SCALE

N.T.S.

DRAWING TITLE

TYPICAL MOUNTING
HEIGHTS MISC.
DETAILS

DRAWING NUMBER

A11.9

