


FKP Architects

ARCHITECT OF RECORD

Paul C. Gloriod

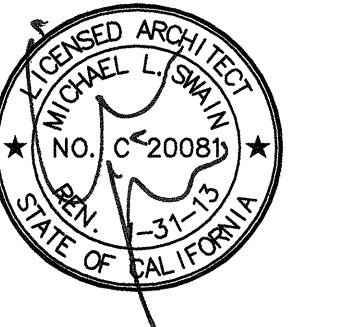


Changes on these drawings do not consist of materially altered changes to approved drawings and don't require a change order.
OSHPD review ACO
OSHPD review FLSO
OSHPD review DSE

REVISIONS

44	05/28/10	ASI #08
55	09/28/11	CO#262

APPROVAL

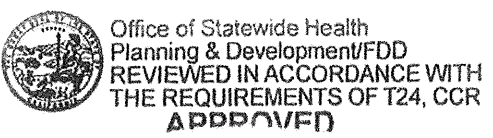

CHANGE ORDER: PAD-2011-00629
INSTRUCTION BULLETIN
DEFERRED APPROVAL
ADDENDUM

PROJECT NAME

CHILDREN'S HOSPITAL
OF ORANGE COUNTY

455 S. Main St.
Orange, CA 92668-3874

RECEIVED
TOWER II OCTOBER 13, 2011
McCarthy



PROJECT NUMBER

12011.00
Increment #7

OSHPD - PROJECT NUMBER

IL 072072-30

ISSUE
OSHPD PERMIT

DATE

01/27/2010

SCALE

1/4"=1'-0"

DRAWING TITLE

LOWER LEVEL ENLARGED
PLAN AREA - G

DRAWING NUMBER

NB

A3.0G

