

FKP Architects

ARCHITECT OF RECORD
Paul C. Gloriot




Changes on these drawings do not consist of
materially altered changes to approved drawings
and don't require a change order.
OSHPD review ACO
OSHPD review FLSO
OSHPD review DSE

REVISIONS

09/19/11 CHANGE ORDER #257

APPROVAL

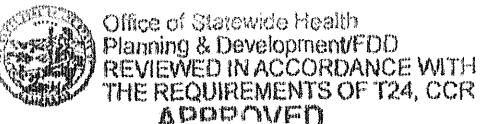

CHANGE ORDER #257
INSTRUCTION BULLETIN
DEFERRED APPROVAL
TODAY

PROJECT NAME

CHILDREN'S HOSPITAL
OF ORANGE COUNTY

455 S. Main St.
Orange, CA 92668-3874

TOWER II RECEIVED
SEPT. 21 2011
McCARTHY



PROJECT NUMBER

12011.00
Increment #7

OSHPD - PROJECT NUMBER

IL 072072-30

ISSUE

OSHPD PERMIT

DATE

01/27/2010

SCALE

1/4" = 1'


DRAWING TITLE

LOWER LEVEL ENLARGED
PLAN AREA - Q

DRAWING NUMBER

A3.0Q

CO #257

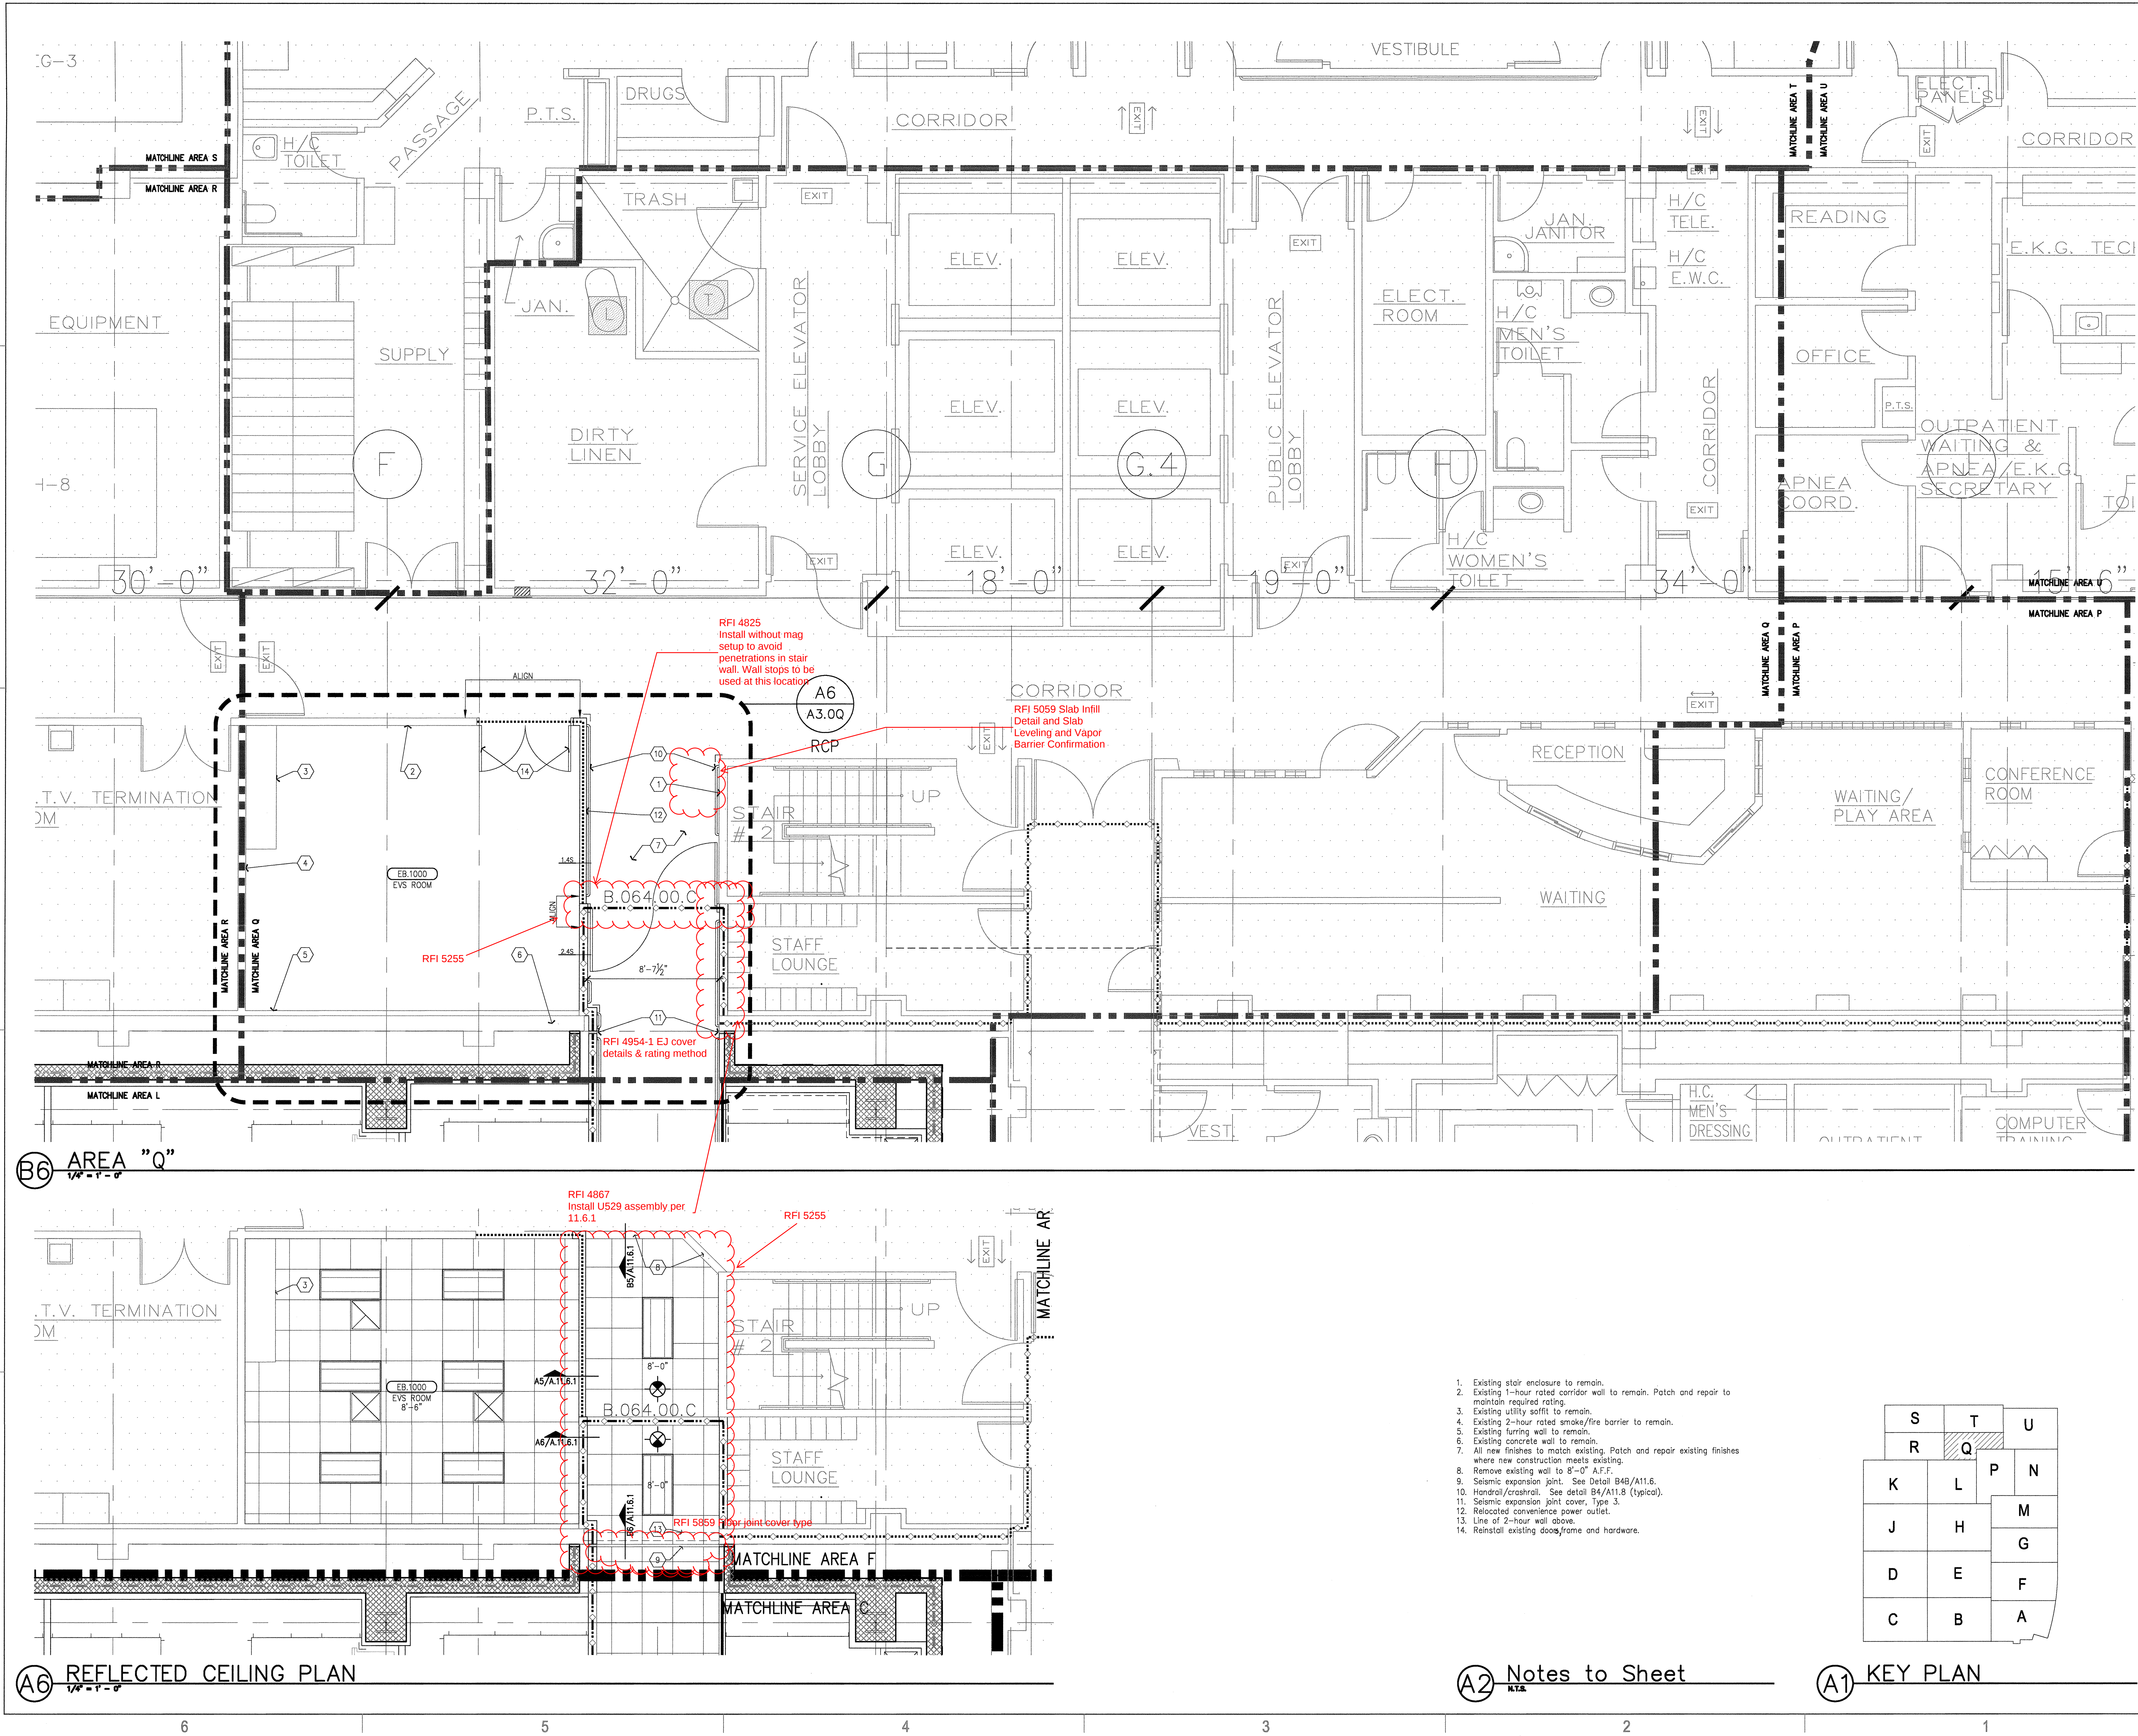

A2 Notes to Sheet

A1 KEY PLAN