


FKP Architects

ARCHITECT OF RECORD
Paul C. Gloriod

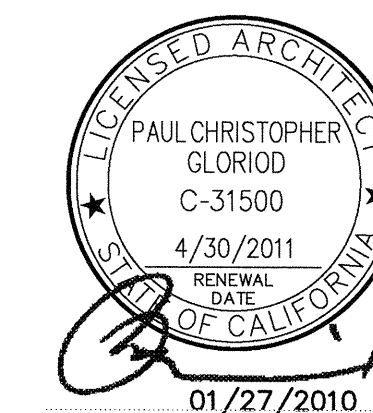

REVISIONS

APPROVAL



PROJECT NAME
**CHILDREN'S HOSPITAL
OF ORANGE COUNTY**
455 S. Main St.
Orange, CA 92668-3874

TOWER II



PROJECT NUMBER

12011.00
Increment #7

OSHPD - PROJECT NUMBER
IL 072072-30

ISSUE
OSHPD PERMIT

DATE
01/27/2010


SCALE

1/16"=1' 0"

DRAWING TITLE
LEVEL 1 FLOOR PLAN

DRAWING NUMBER

A3.11

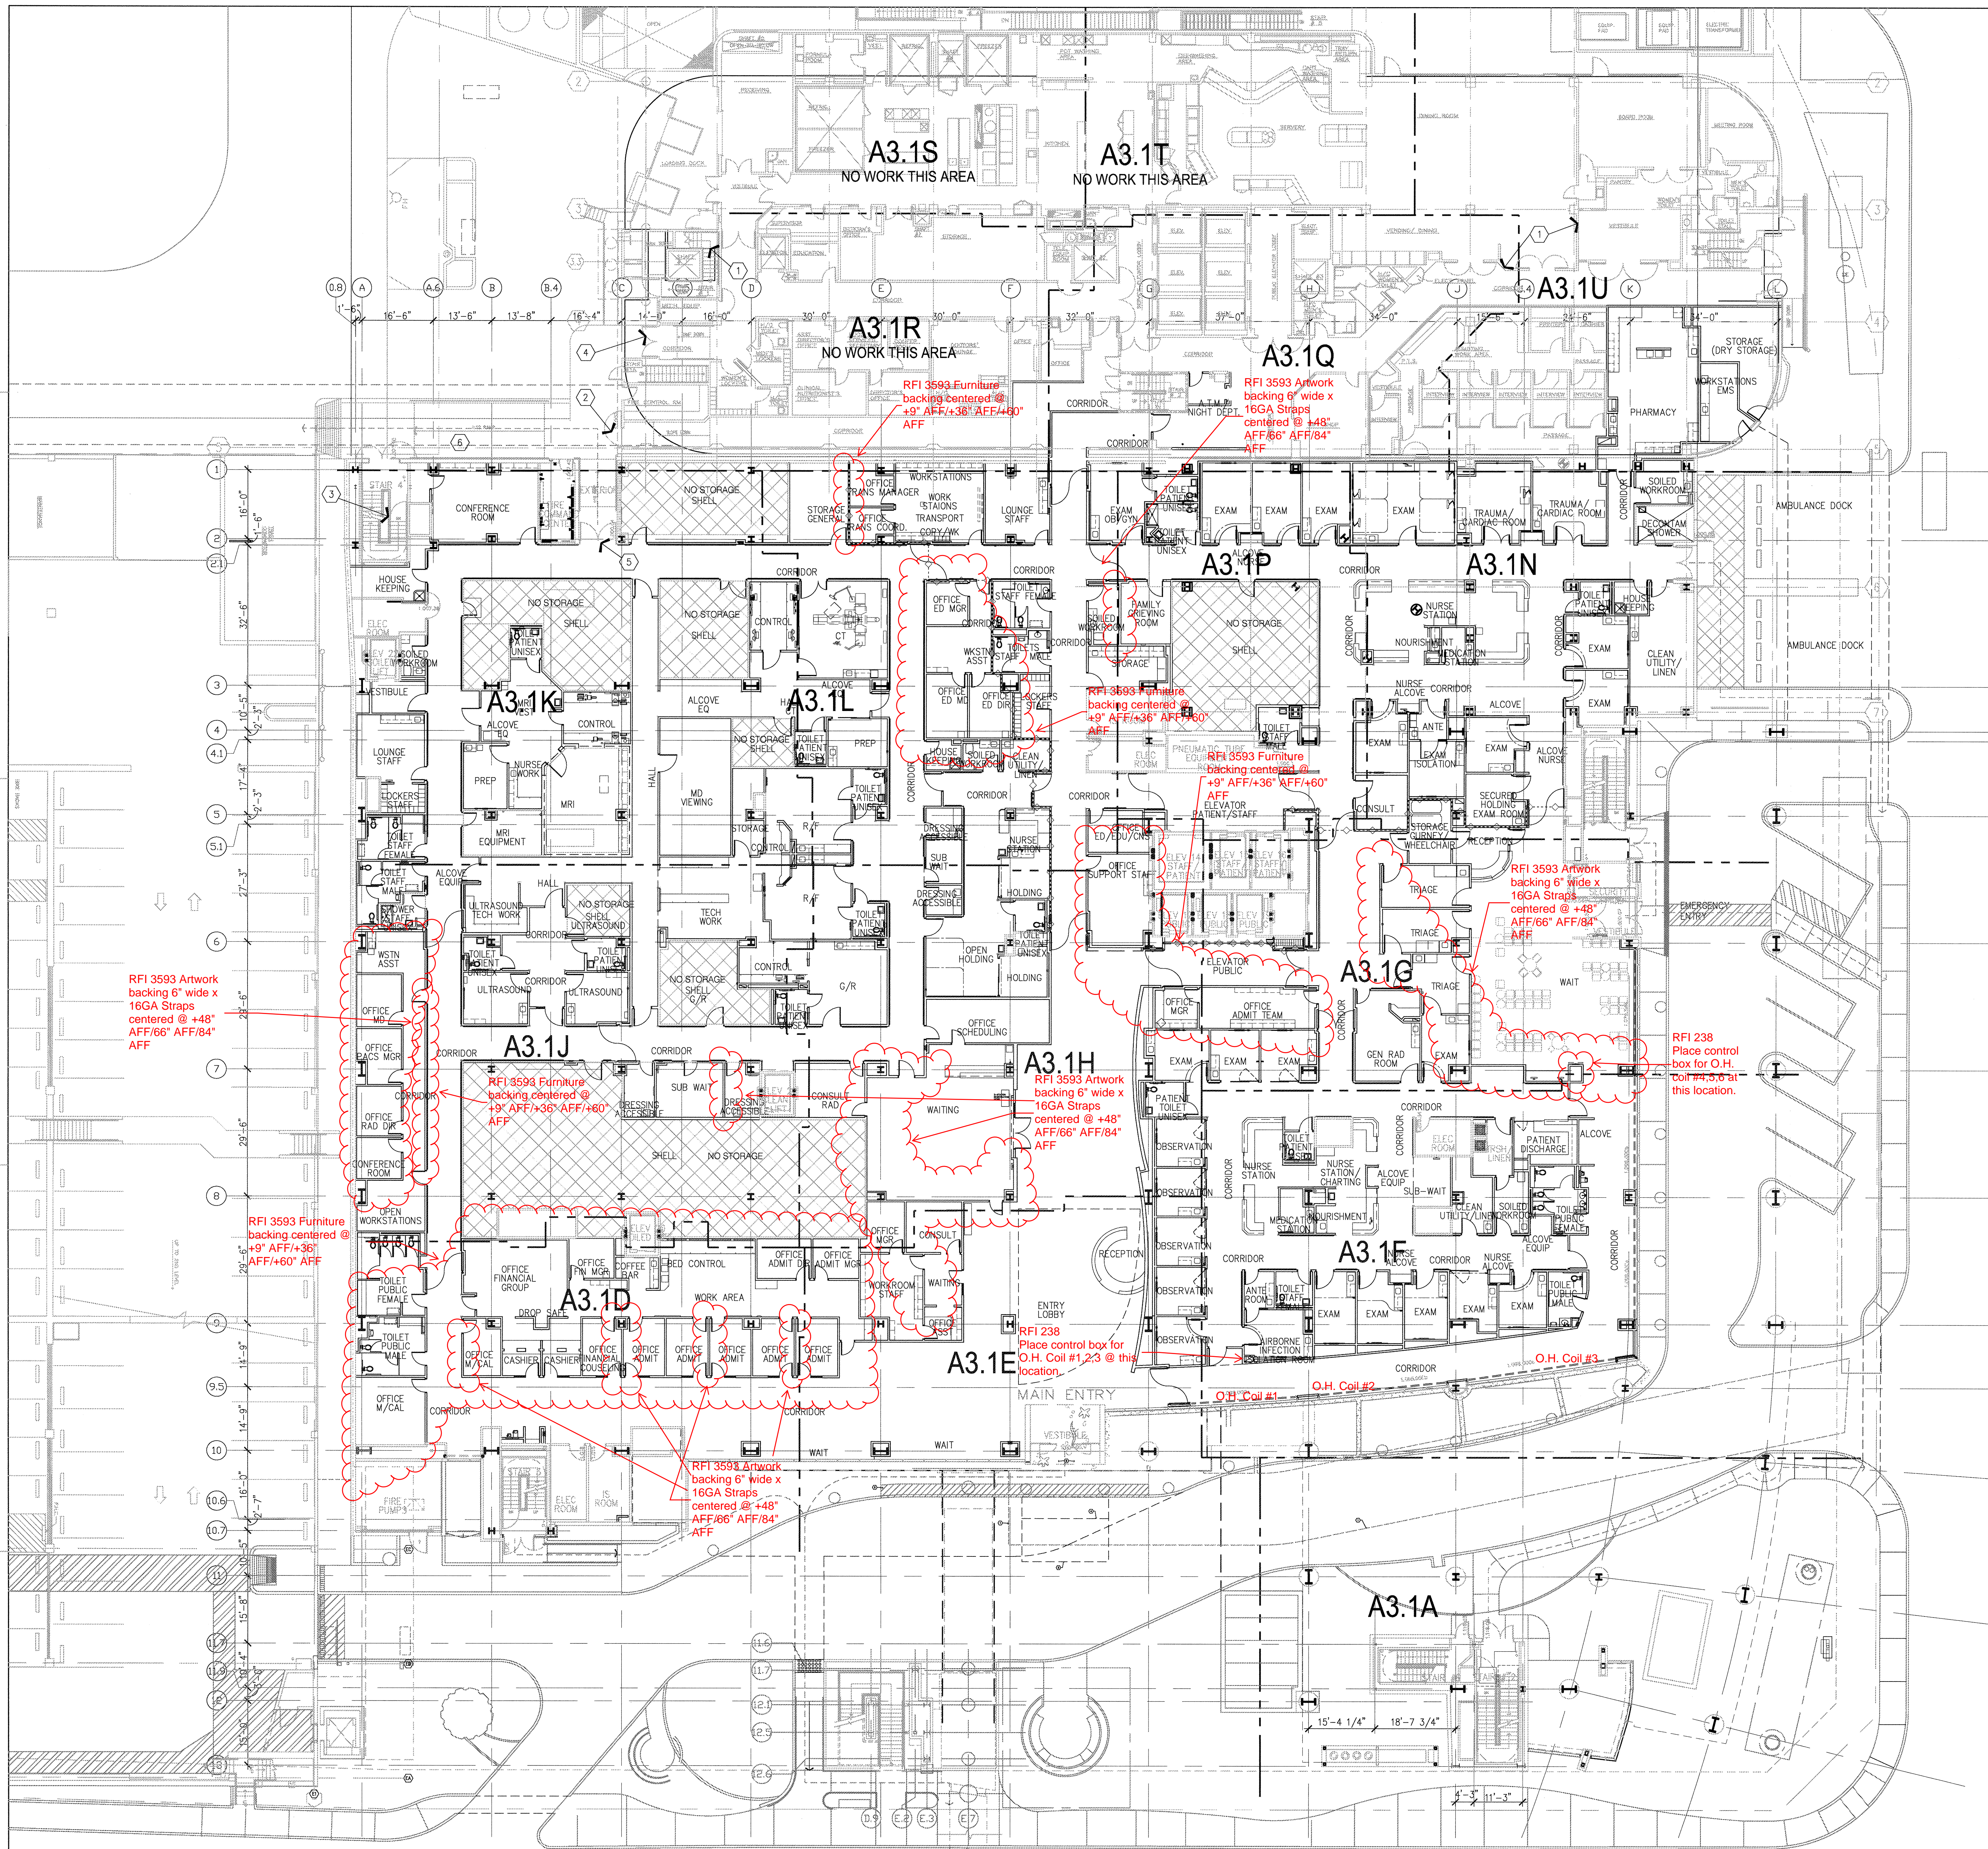

RFI 4137
Life Safety Approval in
ED Remodel Area

RFI 3593 Artwork
backing 6" wide x
16GA Straps
centered @ +48"
AFF/66" AFF/84"
AFF

RFI 3593 Furniture
backing centered @
+9" AFF/36" AFF/60"
AFF

RFI 3593 Artwork
backing 6" wide x
16GA Straps
centered @ +48"
AFF/66" AFF/84"
AFF

RFI 3593 Artwork
backing 6" wide x
16GA Straps
centered @ +48"
AFF/66" AFF/84"
AFF

RFI 3593 Furniture
backing centered @
+9" AFF/36" AFF/60"
AFF

RFI 3593 Furniture
backing centered @
+9" AFF/36" AFF/60"
AFF

RFI 3593 Artwork
backing 6" wide x
16GA Straps
centered @ +48"
AFF/66" AFF/84"
AFF

RFI 238
Place control box for O.H.
Coil #1, 2, 3 @ this location.

1. Canopy. See Increment #6.
2. Detectable warning. See Civil.
3. Passenger drop off zone, 2% cross slope maximum.
4. 20'x5' access aisle, 2% cross slope maximum.
5. Accessible entrance.

(B1) NOTES TO SHEET

S	T	U
R	Q	
K	L	P N
J	H	G
D	E	F
A		

(A1) KEY PLAN

(A6) LEVEL 1
1/16"=1' 0"