© 2009 FKP Architects, Inc. All rights reserved. No part of this document may be reproduced or utilized in any form without prior written authorization of FKP Architects, Inc.

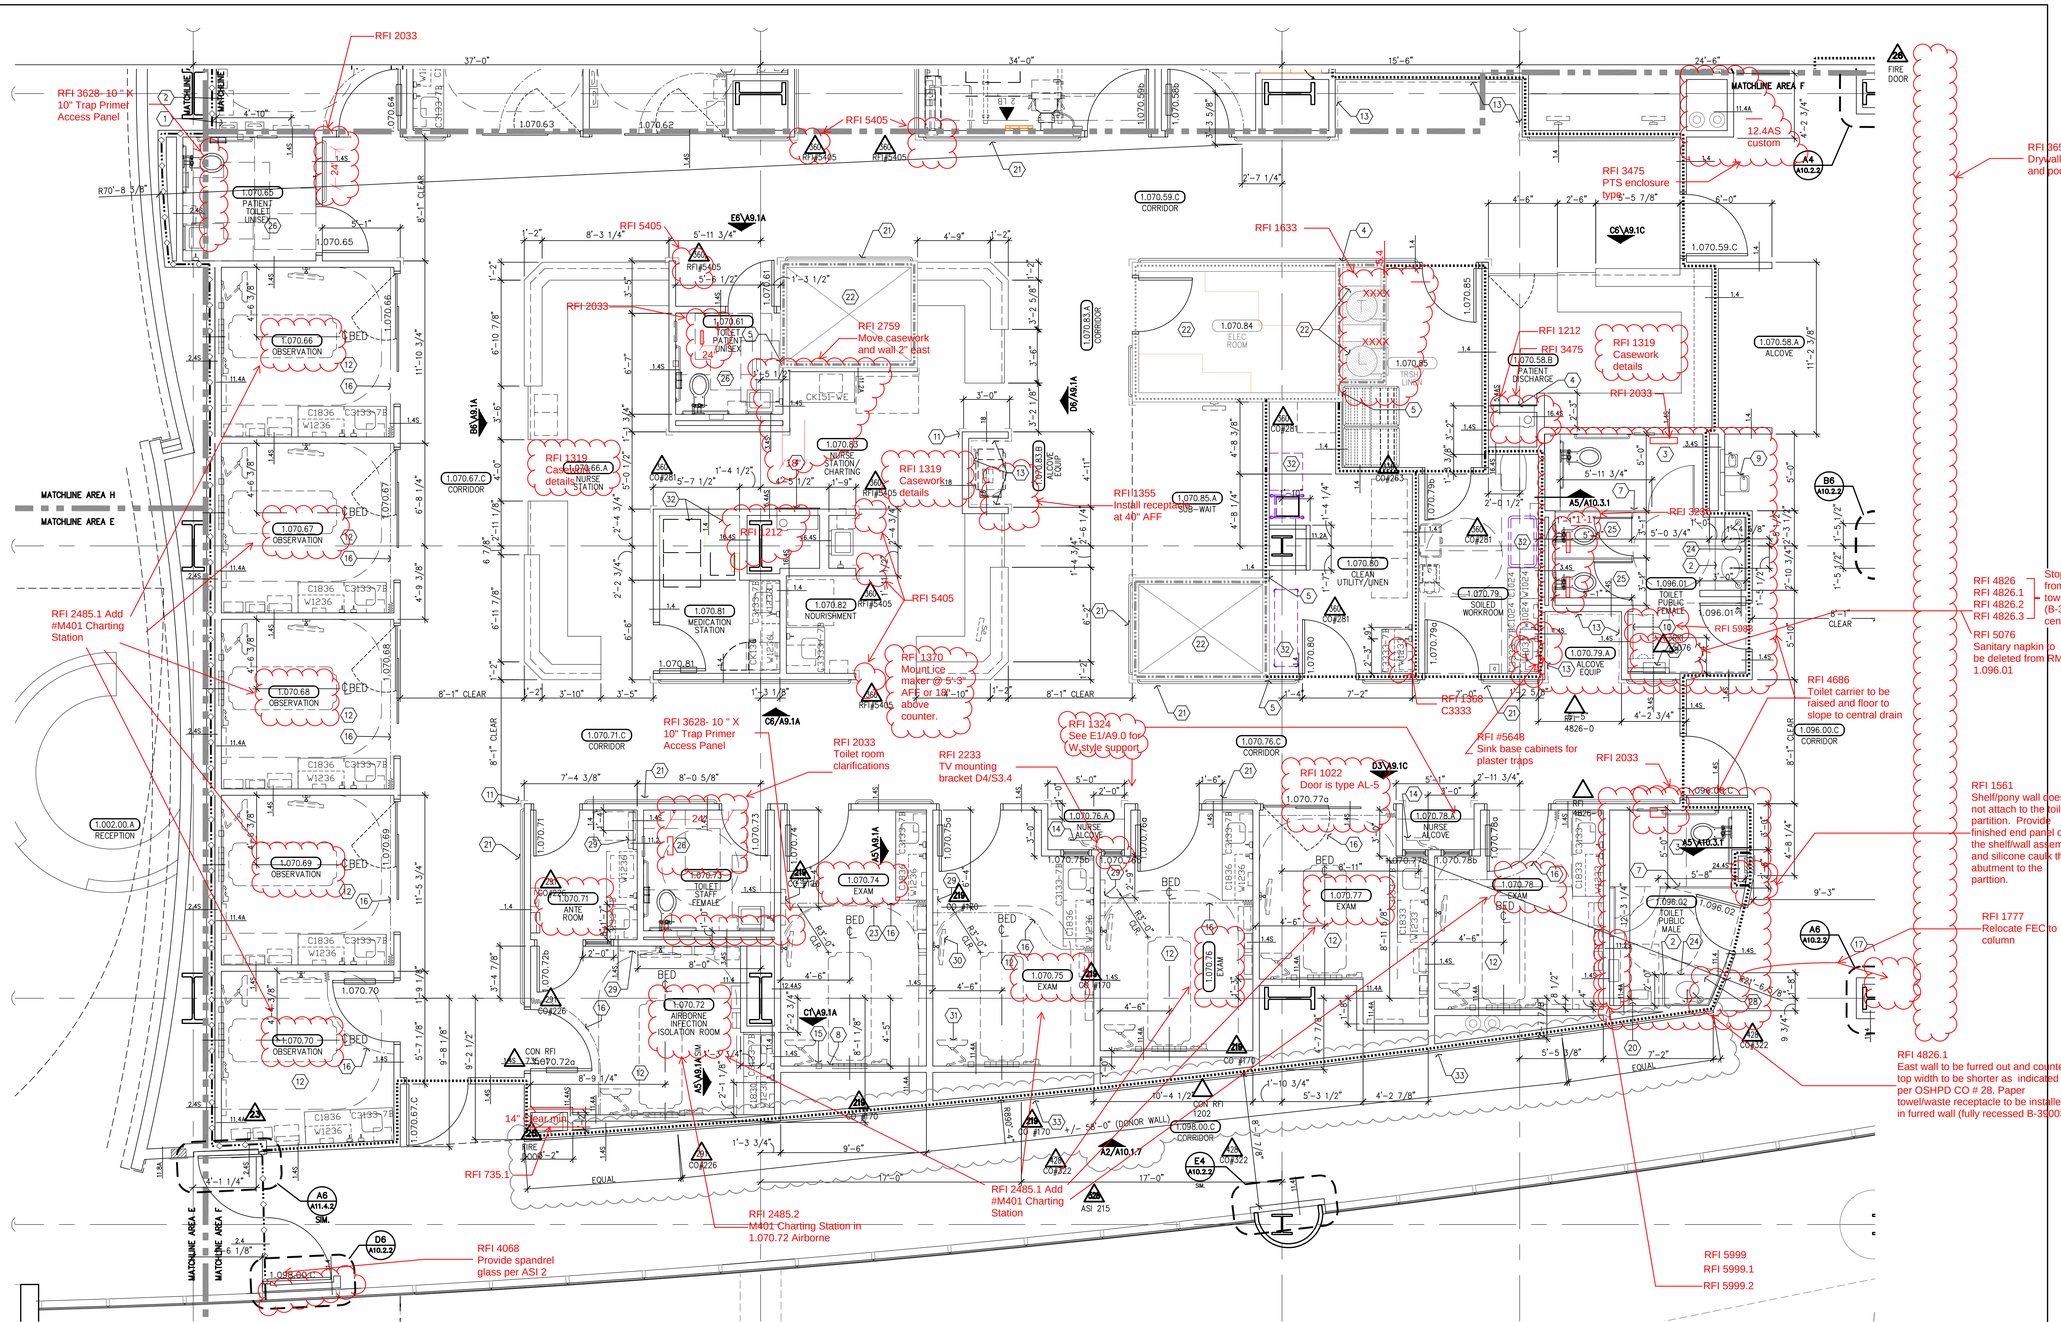

B6 AREA F
1/4" = 1'- 0"

A6 NOTES TO SHEET

1. Urinal screen, wall mounted. See similar structural detail Increment #7 B4/
2. Lavatory counter, solid surface. See detail A2/A11.7.
3. Accessible toilet stall. See typical plan detail B5/A11.7.
4. Pneumatic tube station, OFCI.
5. Align finish face of partitions.
6. Medical gas outlets. See B2/A11.9. See Plumbing.
7. Toilet partition, floor mounted.
8. Nurse call, wall mounted. See nurse call drawings.
9. Electric drinking fountains. See D2/A11.8. See Plumbing.
10. Changing station, wall mounted. See detail D6/A11.8.
11. Corner guard, high impact plastic surface mounted. See detail B4/A11.8 ty
12. See room 1.070.74 for typical note designations.
13. Sheet wall protection to 48" A.F.F. See finish schedule.
14. PC monitor, wall mounted. See Equipment drawings and workbook.
15. Physiological monitor, wall mounted. See Equipment drawings and workbook
16. Cubicle curtain track, ceiling mounted. See detail D4/A11.8.
17. Fire extinguisher cabinet, wall recessed, paint to match adjacent wall, typic See detail A2 or B2/A11.8.
18. 18" deep shelf above, wall mounted with standards and brackets.
19. Tracking board, wall mounted. See similar structural detail Increment #7 B4
20. Urinal, see D4A/A11.7.
21. Handrail/bumper rail. See detail B4/A11.8, typical.
22. For construction requirements, this area, see Increment 6, Vol. 2A & 2B..
23. OSHPD clearance zone around bed, typical.
24. Mirror, full width of counter, full height from backsplash to 7'-0" A.F.F.
25. Toilet stall. See A4/A11.7 for mounting height.
26. Accessible toilet room. See typical plan detail B3/A11.7.
27. Sanitary dispenser. See detail B6/A11.7 for mounting location.
28. Fully recessed paper towel and trash receptacle. See B5/A11.7.
29. Charting station per RTKL ME equipment drawings. See A6/A11.3.1 for backing detail.
30. TV Monitor at 6'-8" bottom, See RTKL Low voltage drawings for model inf For wall attachment detail refer to structural drawings A4/S3.3 Increment Typical.
31. Patient Monitor, See RTKL Low voltage drawings for model info. For wall attachment detail refer to structural drawings B4/S3.4 Increment Typical.
32. Equipment item. See Equipment plans and workbook.
33. Donor wall. see detail A3/A10.1.7 for section detail.

A5 GENERAL NOTES

A. Information shown or referenced on enlarged and/or 1/4" scale drawings will generally not be shown on the smaller scale drawings.
B. Partition types are scheduled on plans by number. See the "General Notes to Partition Types" on B2/A11.3 and Partition Types on Sheet A11.3, A11.3.1, and A11.3.2 for the definition of partition type references.
C. Field coordinate all field routed pipe, conduit runs, etc., with locations of recessed accessories and equipment. In the event of a conflict, accessory locations take precedence.
D. Close all joints between plumbing fixtures/accessories and dissimilar materials w/sealant (i.e. between sinks and countertops, toilet fixtures and accessories to wall, etc.)
E. Cabinet numbers noted on enlarged plans refer to Cabinet component numbers, fixtures, accessories, etc. that are defined or elevated on Sheet A9.0 unless specific detail references are keyed.
F. Plan dimensions – refer to B2/A11.3 (General Notes).
G. For vertical mounting heights of shower accessories, See Detail D6/A11.7.
H. For vertical mounting heights of typical toilet stall accessories, See Detail A4/A11.7.
I. For vertical mounting heights of accessible toilet stall accessories, See Detail A5/A11.7.
J. For vertical mounting heights of typical restroom accessories, See Detail B6/A11.7.
K. For vertical mounting heights of accessible accessories at restrooms, See Detail A6/A11.7.
L. For doors not identified on plan, see Equipment drawings and workbook–Increment#7, Vol. 2E.
M. For partial enlarged plan at janitor closets, See Detail A3/A11.7.
N. Public/handicapped restroom graphics will be furnished and installed by the Owner's graphics supplier.
O. Standard equipment wall mounting heights, see detail A2/A11.9.
P. Medical equipment wall mounting heights, see details A4/A11.9, D3/A11.9 & QD.02–Increment #7, Vol. 2E.
Q. Fire Protection equipment wall Mounting Heights, see detail D2/A11.9
R. Communication equipment wall Mounting Heights, see detail A3/A11.9.
S. Equipment mounting heights at Countertops, see detail D3/A11.9.
T. Equipment mounting heights at Desktops, see detail A4/A11.9.
U. A minimum head clearance of 6'-8" must be maintained at all points in stairways including stair and landing framing.
V. For all dashed in equipment not identified, refer to EQ drawing series–Increment #7, Vol. 2E and Equipment workbook. Specific items requiring structural support are cross referenced to structural support details via matrix shown on the Equipment drawings–Increment #7, Vol. 2F.
W. All elevator hoist way entrance frames to have an embossed stainless steel graphic plaque with the floor landing number and Standard Braille markings for the blind. Conform to governing Accessibility codes and standards.
X. All stair floor landings to receive stencil painted, semi–gloss enamel floor landing numerals 12" high adjacent to the door at 5'–0" AFF in a contrasting color to the scheduled wall color unless a graphic plaque is specifically detailed or noted.
Y. Elevator Equipment wall mounting heights, see detail A6/A11.9 and B3/A11.9.
Z. Doors, Frames, Sidelites and Windows: (See Door Schedule). See A11 sheet series.
AA. Provide wall blocking/backing for items weighting 20lbs or less. See A6/A11.3.1.
BB. For personal effects storage unit types and sizes see A4/A11.8.
CC. For typical equipment backing support, see A4/S1.1–increment #5.
DD. For boundaries of alternates and phasing, see the AP drawing series.
EE. Provide 3" grommet, unless otherwise noted at 3'–0" O.C. maximum, field located at all electrical components at Nurses stations and Reception desks.
FF. For vertical mounting heights of service accessories, See Detail A3/A11.7–Increment#7, Vol. 2E.
GG. Provide access panels below the Patient Room countertops to serve as inspection ports for the Patient Room bathtubs.

A2 NURSE ALCOVE CHAIR

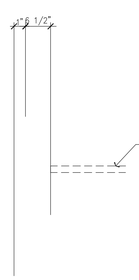

A1 KEY PLAN

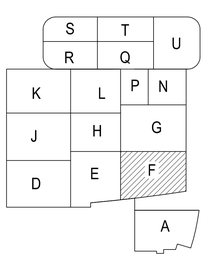

FKP Architects

ARCHITECT OF RECORD
Paul C. Gloriod

LICENSED ARCHITECT MICHAEL L. SMITH NO. C 20081 REN. 1-31-13 STATE OF CALIFORNIA

Changes on these drawings do not consist of materially altered changes to approved drawings and don't require a change order.
OSHPD review ACO _____
OSHPD review FLSO _____
OSHPD review DSE _____

REVISIONS

23	05/10/10	CO #25	
44	05/28/10	ASI #08	
26	07/12/10	CO #28	
219	05/26/11	CO #170	
[illegible]	[illegible]	1	CO #226
[illegible]	[illegible]	2	CO#263
228	04/20/12	CO#322	
228	05/17/12	ASI#215	

APPROVAL
Office of Statewide Health Planning & Development/FDD REVIEWED IN ACCORDANCE WITH THE REQUIREMENTS OF T24, CCR APPROVED
CHANGE ORDER# _____
INSTRUCTION BULLETIN# _____
DEFERRED APPROVAL# _____
ADDENDUM _____

PROJECT NAME
CHILDREN'S HOSPITAL OF ORANGE COUNTY
455 S. Main St.
Orange, CA 92868-3874

TOWER II

CHOC HOSPITAL

PROJECT NUMBER
12011.00
Increment #7

OSHPD - PROJECT NUMBER
IL 072072-30

ISSUE
OSHPD PERMIT

DATE
01/27/2010

SCALE
1/4" = 1'- 0"

DRAWING TITLE
LEVEL 1 ENLARGED PLAN
AREA - F

DRAWING NUMBER
A3.1F

N:\J8XXX\J8102 CHOC TOWER 2 SHELL BUILDING\FKP CONTRACTED PROJECTS\PROJECT INCREMENTS\INCR. #07_TENANT IMPROVEMENT\OSHPD PERMIT (CONSTRUCTION DOCUMENTS)\100602_CO#_____\A3.1F.DWG
4/24/2012
RONALD