


FKP Architects

ARCHITECT OF RECORD
Paul C. Gloriot

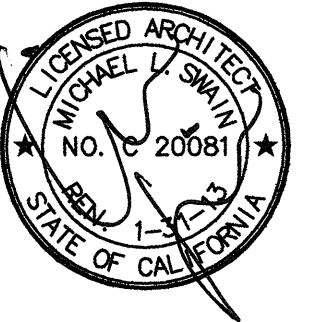


Changes on these drawings do not consist of
materially altered changes to approved drawings
and don't require a change order.
OSHPD review ACO
OSHPD review FLSO
OSHPD review DGE

REVISIONS

44	05/28/10	ASI #8
28	07/12/10	CO #28
67	07/12/10	CO #59
128	10/20/10	CO #98
129	01/24/11	ASI #51
218	05/28/11	CO #170

APPROVAL

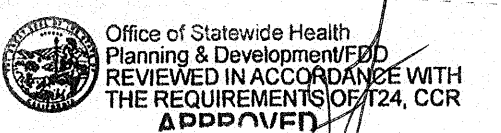

CHANGE ORDER
REVIEWED IN ACCORDANCE WITH
APPROVED

PROJECT NAME

CHILDREN'S HOSPITAL
OF ORANGE COUNTY

455 S. Main St.
Orange, CA 92668-3874

TOWER II

RECEIVED
June 08 2011
McCarthy



PROJECT NUMBER

12011.00
Increment #7

OSHPD - PROJECT NUMBER

IL 072072-30

ISSUE

OSHPD PERMIT

DATE

01/27/2010

SCALE

1/4" = 1'-0"

DRAWING TITLE

LEVEL 1 ENLARGED PLAN
AREA - G

DRAWING NUMBER

A3.1G

