© 2009 FKP Architects, Inc. All rights reserved. No part of this document may be reproduced or utilized in any form without prior written authorization of FKP Architects, Inc.

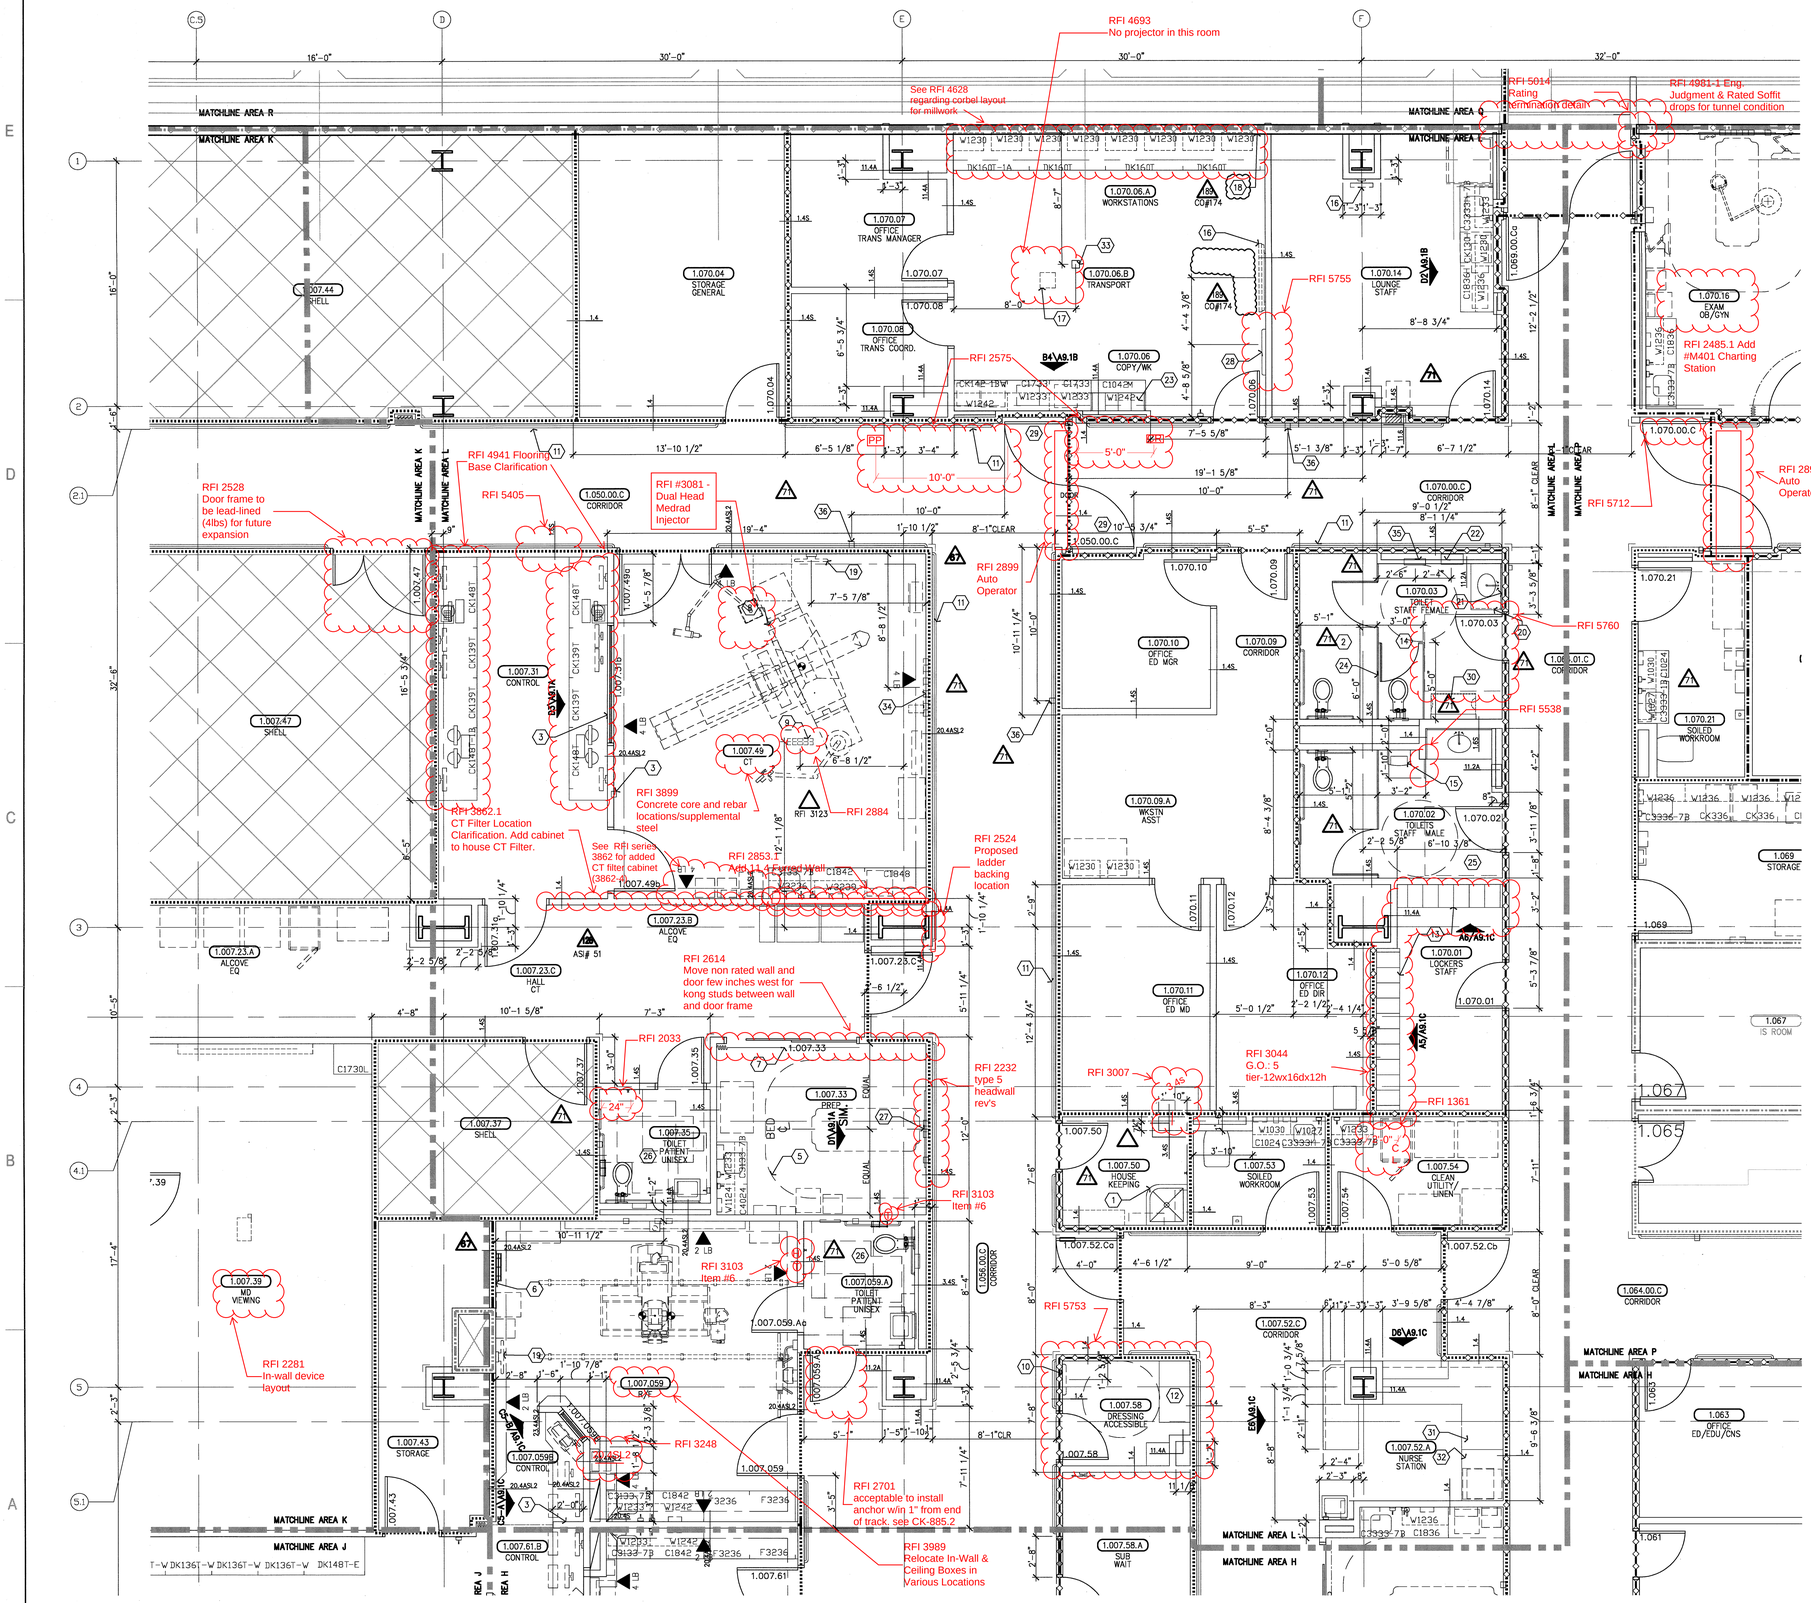

A6 AREA L
1/4" = 1'-0"

1. Housekeeping mop sink. See detail B2/A11.7.1.
2. Accessible toilet stall. See typical plan detail B5/A11.7.
3. Nurse call, wall mounted. See Nurse call drawings.
4. Not used.
5. OSHPD clearance zone around bed. (F.1.0)
6. Add layer of lead lined gypsum board to align with partition.
7. Cubicle curtain track, ceiling mounted. See detail D4/A11.8.
8. Injector, ceiling mounted. See Plumbing drawings and reflected ceiling plan.
9. Medical gas outlets, ceiling mounted. See Legend C1/A3.1L. See Plumbing drawings.
10. Mirror, framed, 24"x60" wall mounted.
11. Handrail/crashrail. See detail B4/A11.8 (Typical)
12. Bench, 24"x48", wall mounted. See detail B2/A11.7
13. Personal effects storage units, Type D 5 high (80 total). See referenced elevation.
14. Toilet stall. See A4/A11.7 for mounting heights.
15. Urinal, see D4A/A11.7.
16. TV monitor, wall mounted, See Telecom and Equipment drawings. See structural detail A2/S3.4 or A5/S3.5.
17. Projector ceiling mounted, wired to PC's with net jacks.
18. AV rack under workstation.
19. Lead apron rack, wall mounted. See D2/S3.6.
20. Solid surface material countertop. See A2/A11.7. Counter top end support refer to E1/A9.0 style "F".
21. Mirror, full width of counter, 7'-0" A.F.F. from top of backsplash.
22. Fully recessed paper towel and trash receptacle. See B5/A11.7.
23. Mail box, 50 slots (9" wide x 12" deep x 1 ½" height). See Elevation B4/A9.1B for detail.
24. Toilet partition, floor mounted.
25. See room 1.070.03 for typical note designations.
26. Accessible toilet room. See typical plan detail B3/A11.7.
27. Medical gas outlets, see Plumbing drawings.
28. Tack board, 4' W x 3' H, wall mounted. See A6/A11.3.1 detail.
29. Integrated double egress doors, wall recessed. See D5 & D6/A11.4.
30. Changing station, wall mounted. See detail D6/A11.8.
31. Counter at 30" height A.F.F.
32. Counter at 36" height A.F.F. with end panel support.
33. Floor box.
34. Medical gas outlets, wall mounted. See Plumbing drawings.
35. Sanitary dispenser. See B6/A11.7 for mounting locations.
36. Auto-operator push button.

D1 NOTES TO SHEET

V	NO	V	A	E
O	O	EL	EL	EL

V VACUUM
NO NITROUS OXIDE
A MEDICAL AIR
E WAGC
O OXYGEN
EL ELECTRICAL OUTLET

▲ 2 LB LEAD LINED GYPSUM BOARD TO 7'-0" A.F.F.
2 LB REFER TO PHYSICIST REPORT FOR ADDITIONAL REPORT

▲ 4 LB LEAD LINED GYPSUM BOARD TO 7'-0" A.F.F.
4 LB REFER TO PHYSICIST REPORT FOR ADDITIONAL REPORT

C1 LEGEND

A. Information shown or referenced on enlarged and/or 1/4" scale drawings will generally not be shown on the smaller scale drawings.
B. Partition types are scheduled on plans by number. See the "General Notes to Partition Types" on B2/A11.3 and Partition Types on Sheet A11.3, A11.3.1, and A11.3.2 for the definition of partition type references.
C. Field coordinate all field routed pipe, conduit runs, etc., with locations of recessed accessories and equipment. In the event of a conflict, accessory locations take precedence.
D. Close all joints between plumbing fixtures/accessories and dissimilar materials w/sealant (i.e. between sinks and countertops, toilet fixtures and accessories to wall, etc.)
E. Cabinet numbers noted on enlarged plans refer to Cabinet component numbers, fixtures, accessories, etc. that are defined or elevated on Sheet A9.0 unless specific detail references are keyed.
F. Plan dimensions – refer to B2/A11.3 (General Notes).
G. For vertical mounting heights of shower accessories, See Detail D6/A11.7.
H. For vertical mounting heights of typical toilet stall accessories, See Detail A4/A11.7.
I. For vertical mounting heights of accessible toilet stall accessories, See Detail A5/A11.7.
J. For vertical mounting heights of typical restroom accessories, See Detail B6/A11.7.
K. For vertical mounting heights of accessible accessories at restrooms, See Detail A6/A11.7.
L. For equipment not identified on plan, see Equipment drawings and workbook–Increment#7, Vol. 2E.
M. For partial enlarged plan at janitor closets, See Detail A3/A11.7.
N. Public/handicapped restroom graphics will be furnished and installed by the Owner's graphics supplier.
O. Standard equipment wall mounting heights, see detail A2/A11.9.
P. Medical equipment wall mounting heights, see details A4/A11.9, D3/A11.9 & Q0.02–Increment #7, Vol. 2E.
Q. Fire Protection equipment wall mounting heights, see detail D2/A11.9
R. Communication equipment wall mounting heights, see detail A3/A11.9.
S. Equipment mounting heights at Countertops, see detail D3/A11.9.
T. Equipment mounting heights at Desktops, see detail A4/A11.9.
U. A minimum head clearance of 6'-8" must be maintained at all points in stairways including stair and landing framing.
V. For all dashed in equipment not identified, refer to EQ drawing series–Increment #7, Vol. 2E and Equipment workbook. Specific items requiring structural support are cross referenced to structural support details via matrix shown on the Equipment drawings–Increment #7, Vol. 2F.
W. All elevator hoist way entrance frames to have an embossed stainless steel graphic plaque with the floor landing number and Standard Braille markings for the blind. Conform to governing Accessibility codes and standards.
X. All stair floor landings to receive stencil painted, semi-gloss enamel floor landing numerals 12" high adjacent to the door at 5'-0" AFF in a contrasting color to the scheduled wall color unless a graphic plaque is specifically detailed or noted.
Y. Elevator Equipment Wall Mounting Heights, see detail A6/A11.9 and B3/A11.9.
Z. Doors, Frames, Sidelites and Windows: (See Door Schedule). See A11 sheet series.
AA. Provide wall blocking/backing for items weighting 20lbs or less. See A6/A11.3.1.
BB. For personal effects storage unit types and sizes see A4/A11.8.
CC. For typical equipment backing support, see A4/S11–Increment #5.
DD. For boundaries of alternates and phasing, see the AP drawing series.
EE. Provide 3" grommet, unless otherwise noted at 3'-0" O.C. maximum, field located at all electrical components at Nurses stations and Reception desks.
FF. For vertical mounting heights of service accessories, See Detail A3/A11.
GG. Provide access panels below the Patient Room countertops to serve as inspection ports for the Patient Room bathtubs.

B1 GENERAL NOTES

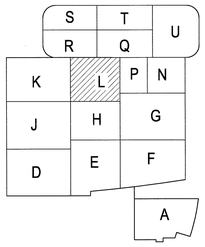

A1 KEY PLAN

FKP Architects

ARCHITECT OF RECORD
Paul C. Gloriod

LICENSED ARCHITECT
MICHAEL J. SHEA
NO. C 20081
STATE OF CALIFORNIA

REVISIONS

4A	05/28/10	ASI #8
6A	07/12/10	CO #59
7A	08/06/10	CO #62
12A	01/24/11	ASI #51
8A	03/28/10	CO #174

Office of Statewide Health Planning & Development
REVIEWED IN ACCORDANCE WITH THE REQUIREMENTS OF Sec. 1724, CCR
APR 01 2011
CHANGE ORDER# 174
INSTRUCTION BULLETIN#
DEFERRED APPROVAL#
ADDENDUM
APPROVAL

PROJECT NAME
CHILDREN'S HOSPITAL OF ORANGE COUNTY
455 S. Main St.
Orange, CA 92868-3874

TOWER II
RECEIVED
Apr 6 2011
McCARTHY

CHOC HOSPITAL

PROJECT NUMBER
12011.00
Increment #7

OSHPD - PROJECT NUMBER
IL 072072-30

ISSUE
OSHPD PERMIT

DATE
01/27/2010

SCALE
1/4" = 1'-0"

DRAWING TITLE
LEVEL 1 ENLARGED PLAN
AREA - L

DRAWING NUMBER
A3.1L