


FKP Architects

ARCHITECT OF RECORD
Paul C. Gloriot

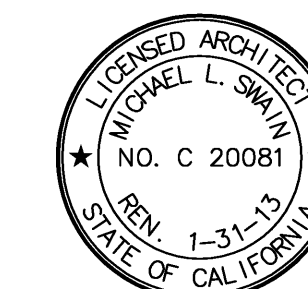


Changes on these drawings do not consist of materially altered changes to approved drawings and don't require a change order.
OSHPD review ACO
OSHPD review FLSO
OSHPD review DSE

REVISIONS

23	05/10/10	CO #25
44	05/28/10	ASI #08
138	12/01/10	ASI #48
29	07/18/11	CO #226
31A	08/22/11	CO #247
338	08/24/11	ASI #111

APPROVAL

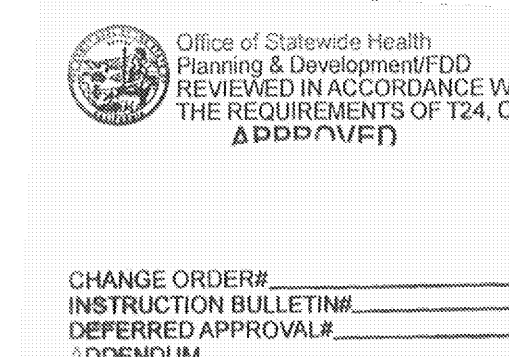

PROJECT NAME

CHILDREN'S HOSPITAL
OF ORANGE COUNTY

455 S. Main St.
Orange, CA 92668-3874

TOWER II RECEIVED
August 26 2011
McCarthy



PROJECT NUMBER

12011.00
Increment #7

OSHPD - PROJECT NUMBER

IL 072072-30

ISSUE

OSHPD PERMIT

DATE

01/27/2010

SCALE

1/4" = 1' 0"

DRAWING TITLE

LEVEL 1 ENLARGED PLAN
AREA - P

DRAWING NUMBER

A3.1P

- Expansion joint cover, wall. See floor plan for fire rating requirements.
- Expansion joint cover, floor. See increment #6.
- Provide additional 5/8" gypsum board, see referenced detail.
- Towel rack. See detail D6/A11.7 for mounting height location.
- Not used.
- Push button/auto door open, wall mounted.
- Accessible toilet stall/shower. See typical plan detail B3&B3/A11.7. (Similar)
- Accessible toilet room. See typical plan detail B3/A11.7.
- Not used.
- See room 1.070.33 on A3.1N for typical note designation.s
- Not used.
- Medical gas outlet, see Plumbing.
- Not used.
- Corner guard, high impact plastic surface mounted, see detail B4/A11.8.
- Handrail/bumperail. See detail B4/A11.8 (Typical)
- Integrated double door, wall recessed. See D5 & D6/A11.4.
- Integrated double door, wall recessed. See A3 & A4/A11.4.2
- Integrated double door, wall recessed. See A5/A11.4.2
- Integrated double door, wall recessed. See C3/A11.4.2
- Integrated double door, wall recessed. See D5/A11.4.2
- Integrated double door, wall recessed. See B6/A11.4.2
- Modified countertop to 25 1/2" deep for entire cabinet length. Detail C5A/A5.0.
- Charting station per RTKL ME equipment drawings. CO#226 See A6/A11.3.1 for backing detail.


D1 NOTES TO SHEET

- A. Information shown or referenced on enlarged and/or 1/4" scale drawings will generally not be shown on the smaller scale drawings.
- B. Partition types are scheduled on plans by number. See the "General Notes to Partition Types" on B2/A11.3 and Partition Types on Sheet A11.3.1, and A11.3.2 for the definition of partition type references.
- C. Field coordinate all field routed pipe, conduit runs, etc., with locations of recessed accessories and equipment. In the event of a conflict, accessories take precedence.
- D. Close all joints between plumbing fixtures/accessories and dissimilar materials w/ caulk (i.e. between sinks and countertops, toilet fixtures and accessories to wall, etc.).
- E. Cabinet numbers noted on enlarged plans refer to Cabinet component numbers, fixtures, accessories, etc. that are defined or elevated on Sheet A8.0 unless specific detail references are keyed.
- F. Plan dimensions - refer to B2/A11.3 (General Notes).
- G. For vertical mounting heights of shower accessories, See Detail D6/A11.7.
- H. For vertical mounting heights of typical toilet stall accessories, See Detail A4/A11.7.
- I. For vertical mounting heights of accessible toilet stall accessories, See Detail A5/A11.7.
- J. For vertical mounting heights of typical restroom accessories, See Detail B6/A11.7.
- K. For vertical mounting heights of accessible accessories at restrooms, See Detail A6/A11.7.
- L. For equipment not identified on plan, see Equipment drawings and workbook-Increment #7, Vol. 2E.
- M. For partial enlarged plan of janitor closets, See Detail A3/A11.7.
- N. Public/handicapped restroom graphics will be furnished and installed by the Owner's graphics supplier.
- O. Standard equipment wall mounting heights, see detail A2/A11.9.
- P. Medical equipment wall mounting heights, see details A4/A11.9, D3/A11.9 & Q0.02-Increment #7, Vol. 2E.
- Q. Fire Protection equipment wall mounting heights, see detail D2/A11.9.
- R. Communication equipment wall mounting heights, see detail A3/A11.9.
- S. Equipment mounting heights at Countertops, see detail D3/A11.9.
- T. Equipment mounting heights at Desks, see detail A4/A11.9.
- U. A minimum head clearance of 6'-8" must be maintained at all points in stairways including stair and landing framing.
- V. For all dashed in equipment not identified, refer to EQ drawing series-Increment #7, Vol. 2E and Equipment workbook. Specific items requiring structural support are cross referenced to structural support details via matrix shown on the Equipment drawings-Increment #7, Vol. 2E.
- W. All elevator hold way entrance frames to have an embossed stainless steel graphic plaque with the floor landing number and Standard Braille markings for the blind. Conform to governing Accessibility codes and standards.
- X. All stair floor landings to receive stencil painted, semi-gloss enamel floor landing numerals 12" high adjacent to the door at 5'-0" AFF in a contrasting color to the scheduled wall color unless a graphic plaque is specifically detailed or noted.
- Y. Elevator Equipment Wall Mounting Heights, see detail A6/A11.9 and B3/A11.9.
- Z. Doors, Frames, Sidelites and Windows: (See Door Schedule). See A11 sheet series.
- AA. Provide wall blocking/locking for items weighing 20lbs or less. See A6/A11.3.1.
- BB. For personal effects storage types and sizes see A4/A11.8.
- CC. For typical equipment backing support, see A4/S1.1-Increment #5.
- DD. For boundaries of alternates and phasing, see the AP drawing series.
- EE. Provide 3" grommet, unless otherwise noted at 3'-0" O.C. maximum, field located at all electrical components of Nurses stations and Reception desks.
- FF. For vertical mounting heights of service accessories, See Detail A3/A11.
- GG. Provide access panels below the Patient room countertops to serve as inspection ports for the Patient Room bellhops.

B1 GENERAL NOTES

S	T	U
R	Q	P
K	L	N
J	H	G
D	E	F
		A

A1 KEY PLAN

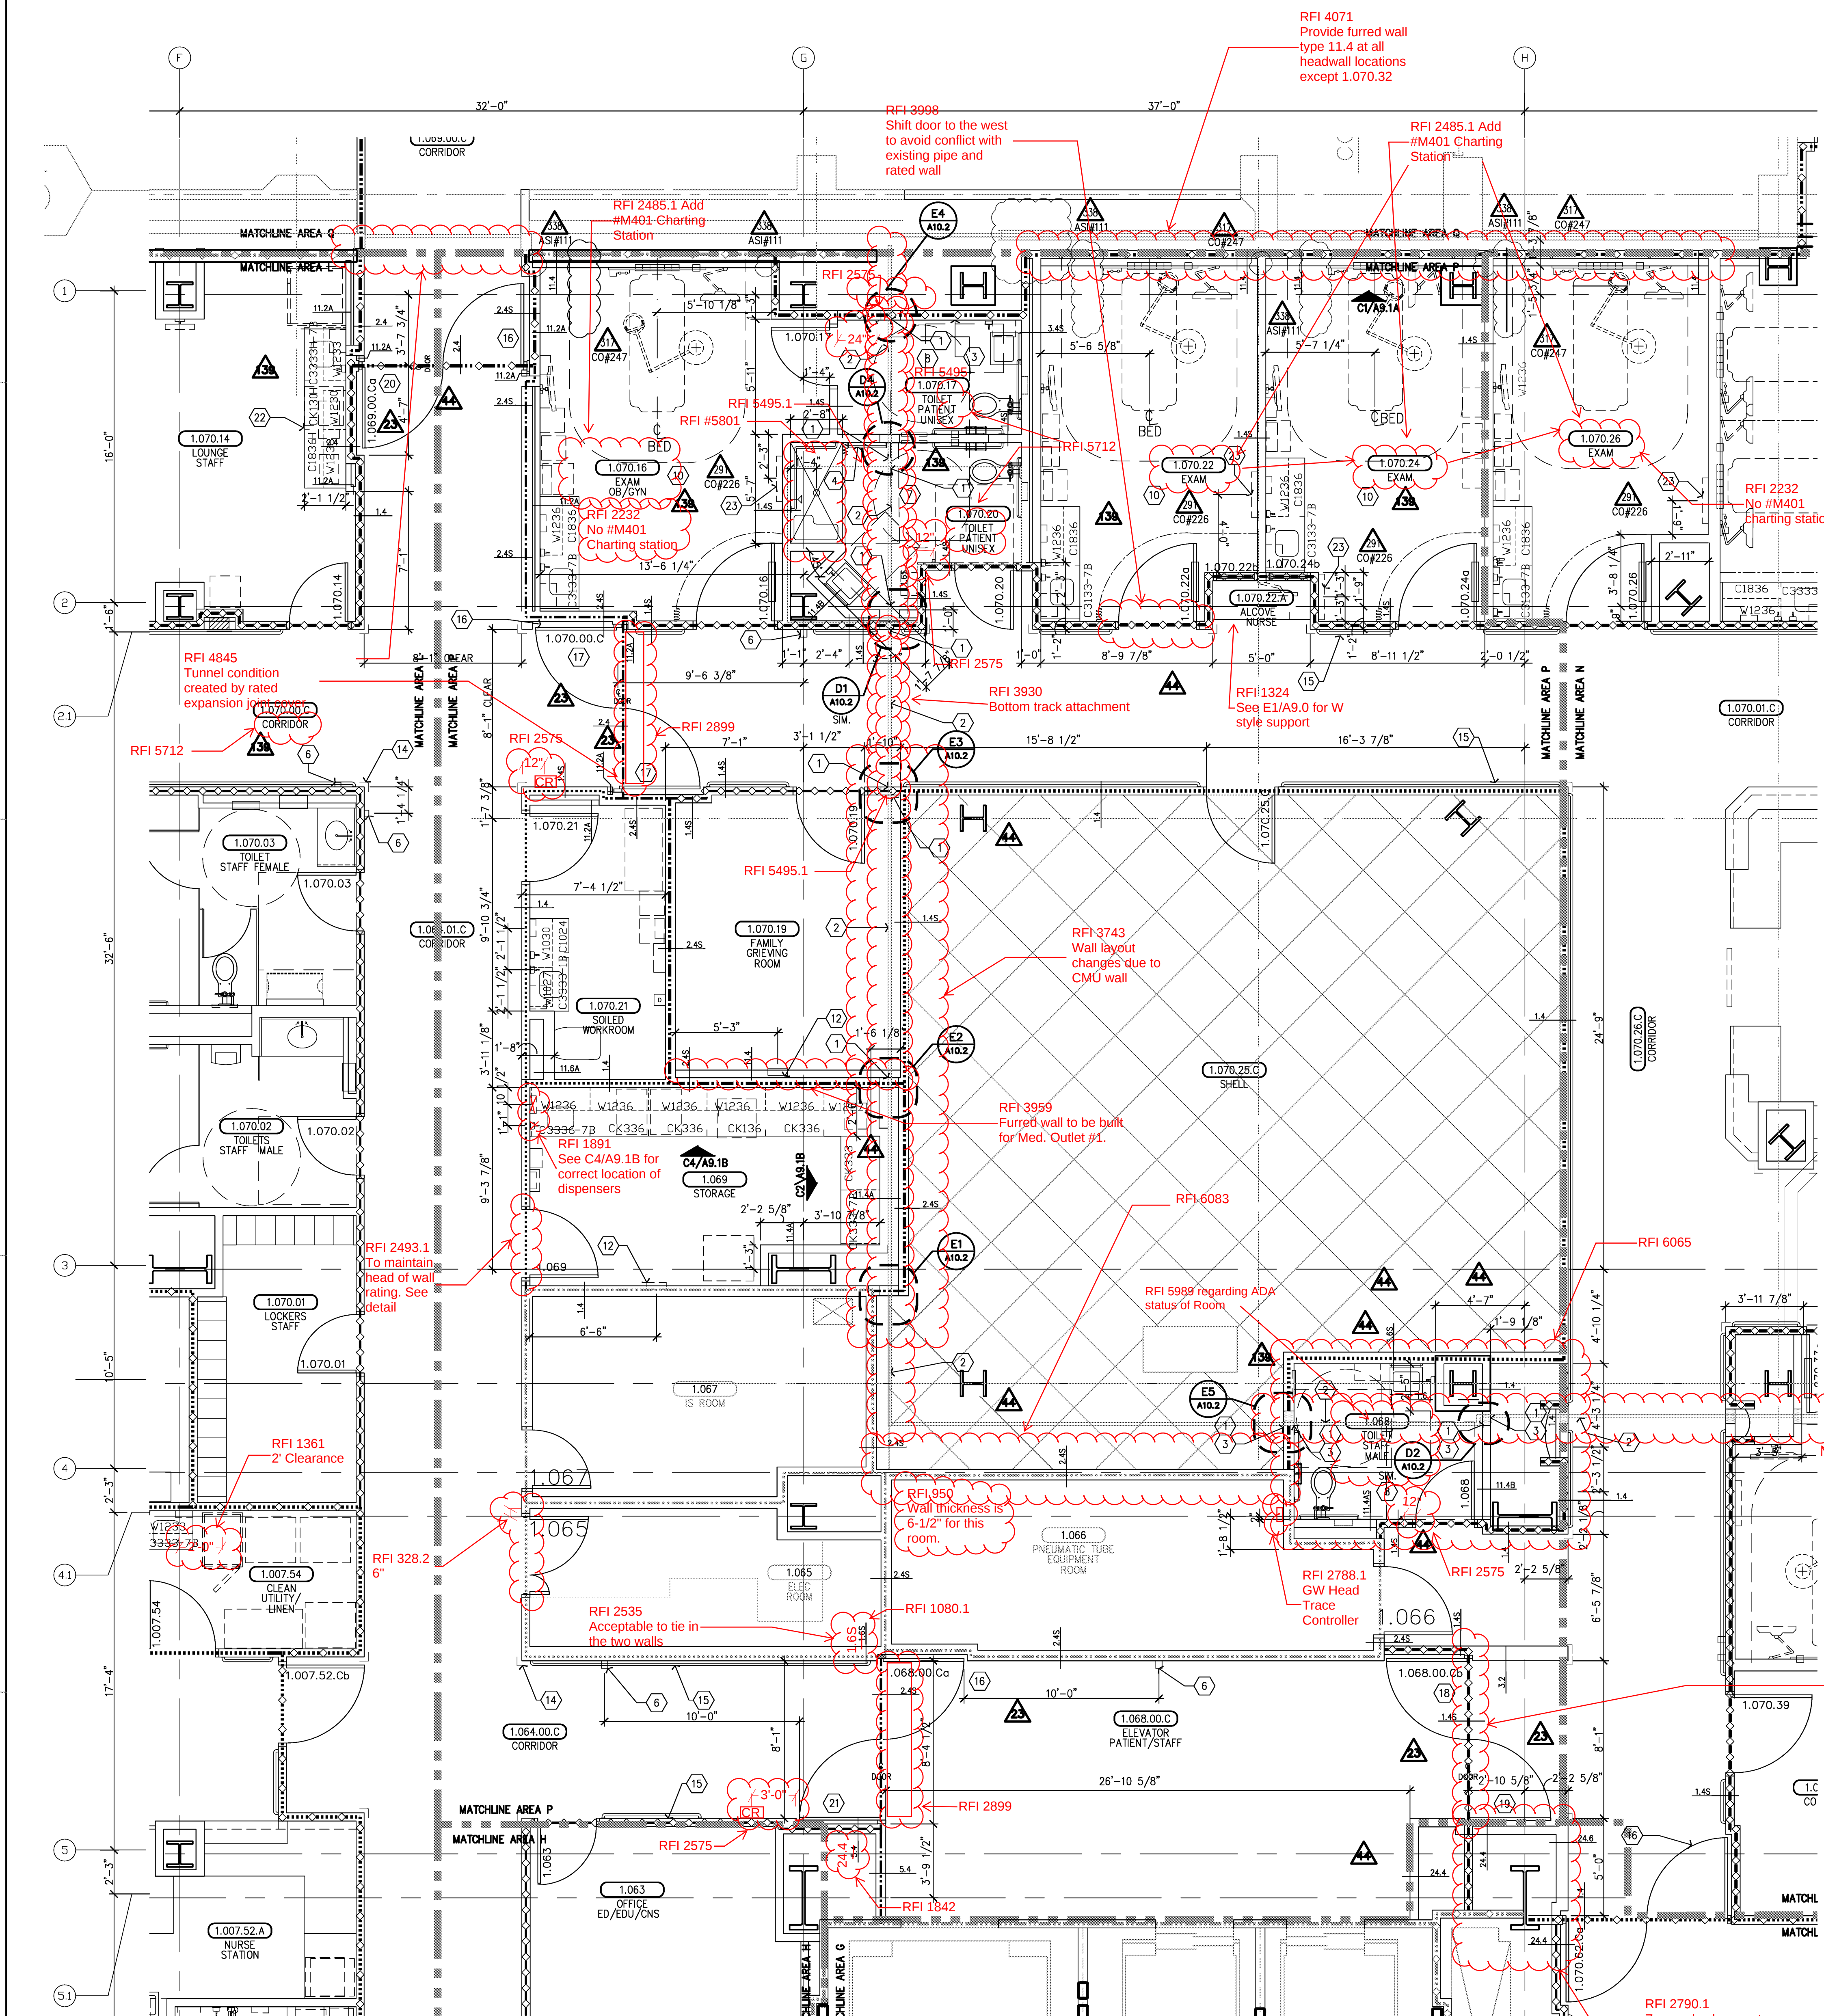

A6 AREA P
1/4" = 1' 0"