


FKP Architects

ARCHITECT OF RECORD


Paul C. Gloriot

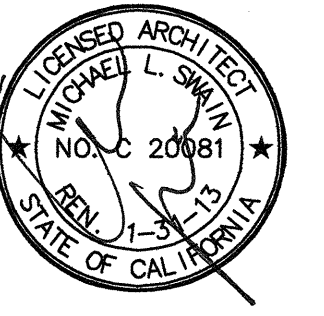


Changes on these drawings do not consist of material altered changes to approved drawings and don't require a change order.
OSHPD review ACO
OSHPD review FLSO
OSHPD review DSE

REVISIONS

40	05/25/10	CHANGE ORDER #39
41	05/28/10	ASI #08
42	08/31/10	CHANGE ORDER #74
43	08/08/11	CHANGE ORDER #233
44	11/08/11	CHANGE ORDER #296
45	04/17/12	CHANGE ORDER #360

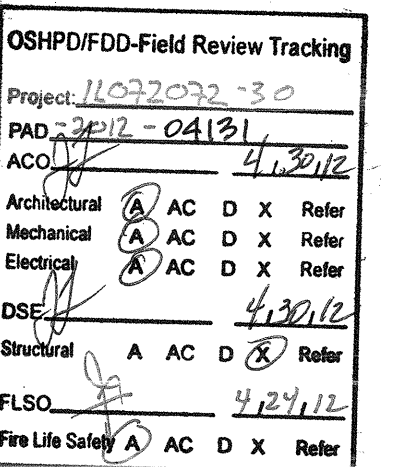

APPROVAL

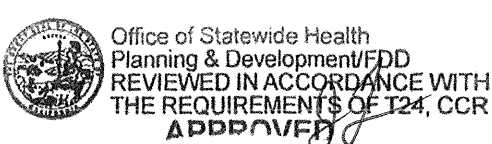

CHANGE ORDER #360
INSTRUCTION BULLETIN
DEFERRED APPROVAL

PROJECT NAME

CHILDREN'S HOSPITAL
OF ORANGE COUNTY

455 S. Main St.
Orange, CA 92668-3874

TOWER II



PROJECT NUMBER

12011.00
Increment #7

OSHPD - PROJECT NUMBER

IL 072072-30

ISSUE

OSHPD PERMIT

DATE

01/27/2010

SCALE


1/4" = 1' - 0"

DRAWING TITLE

LEVEL 1 ENLARGED PLAN
AREA - Q

DRAWING NUMBER

A3.1Q

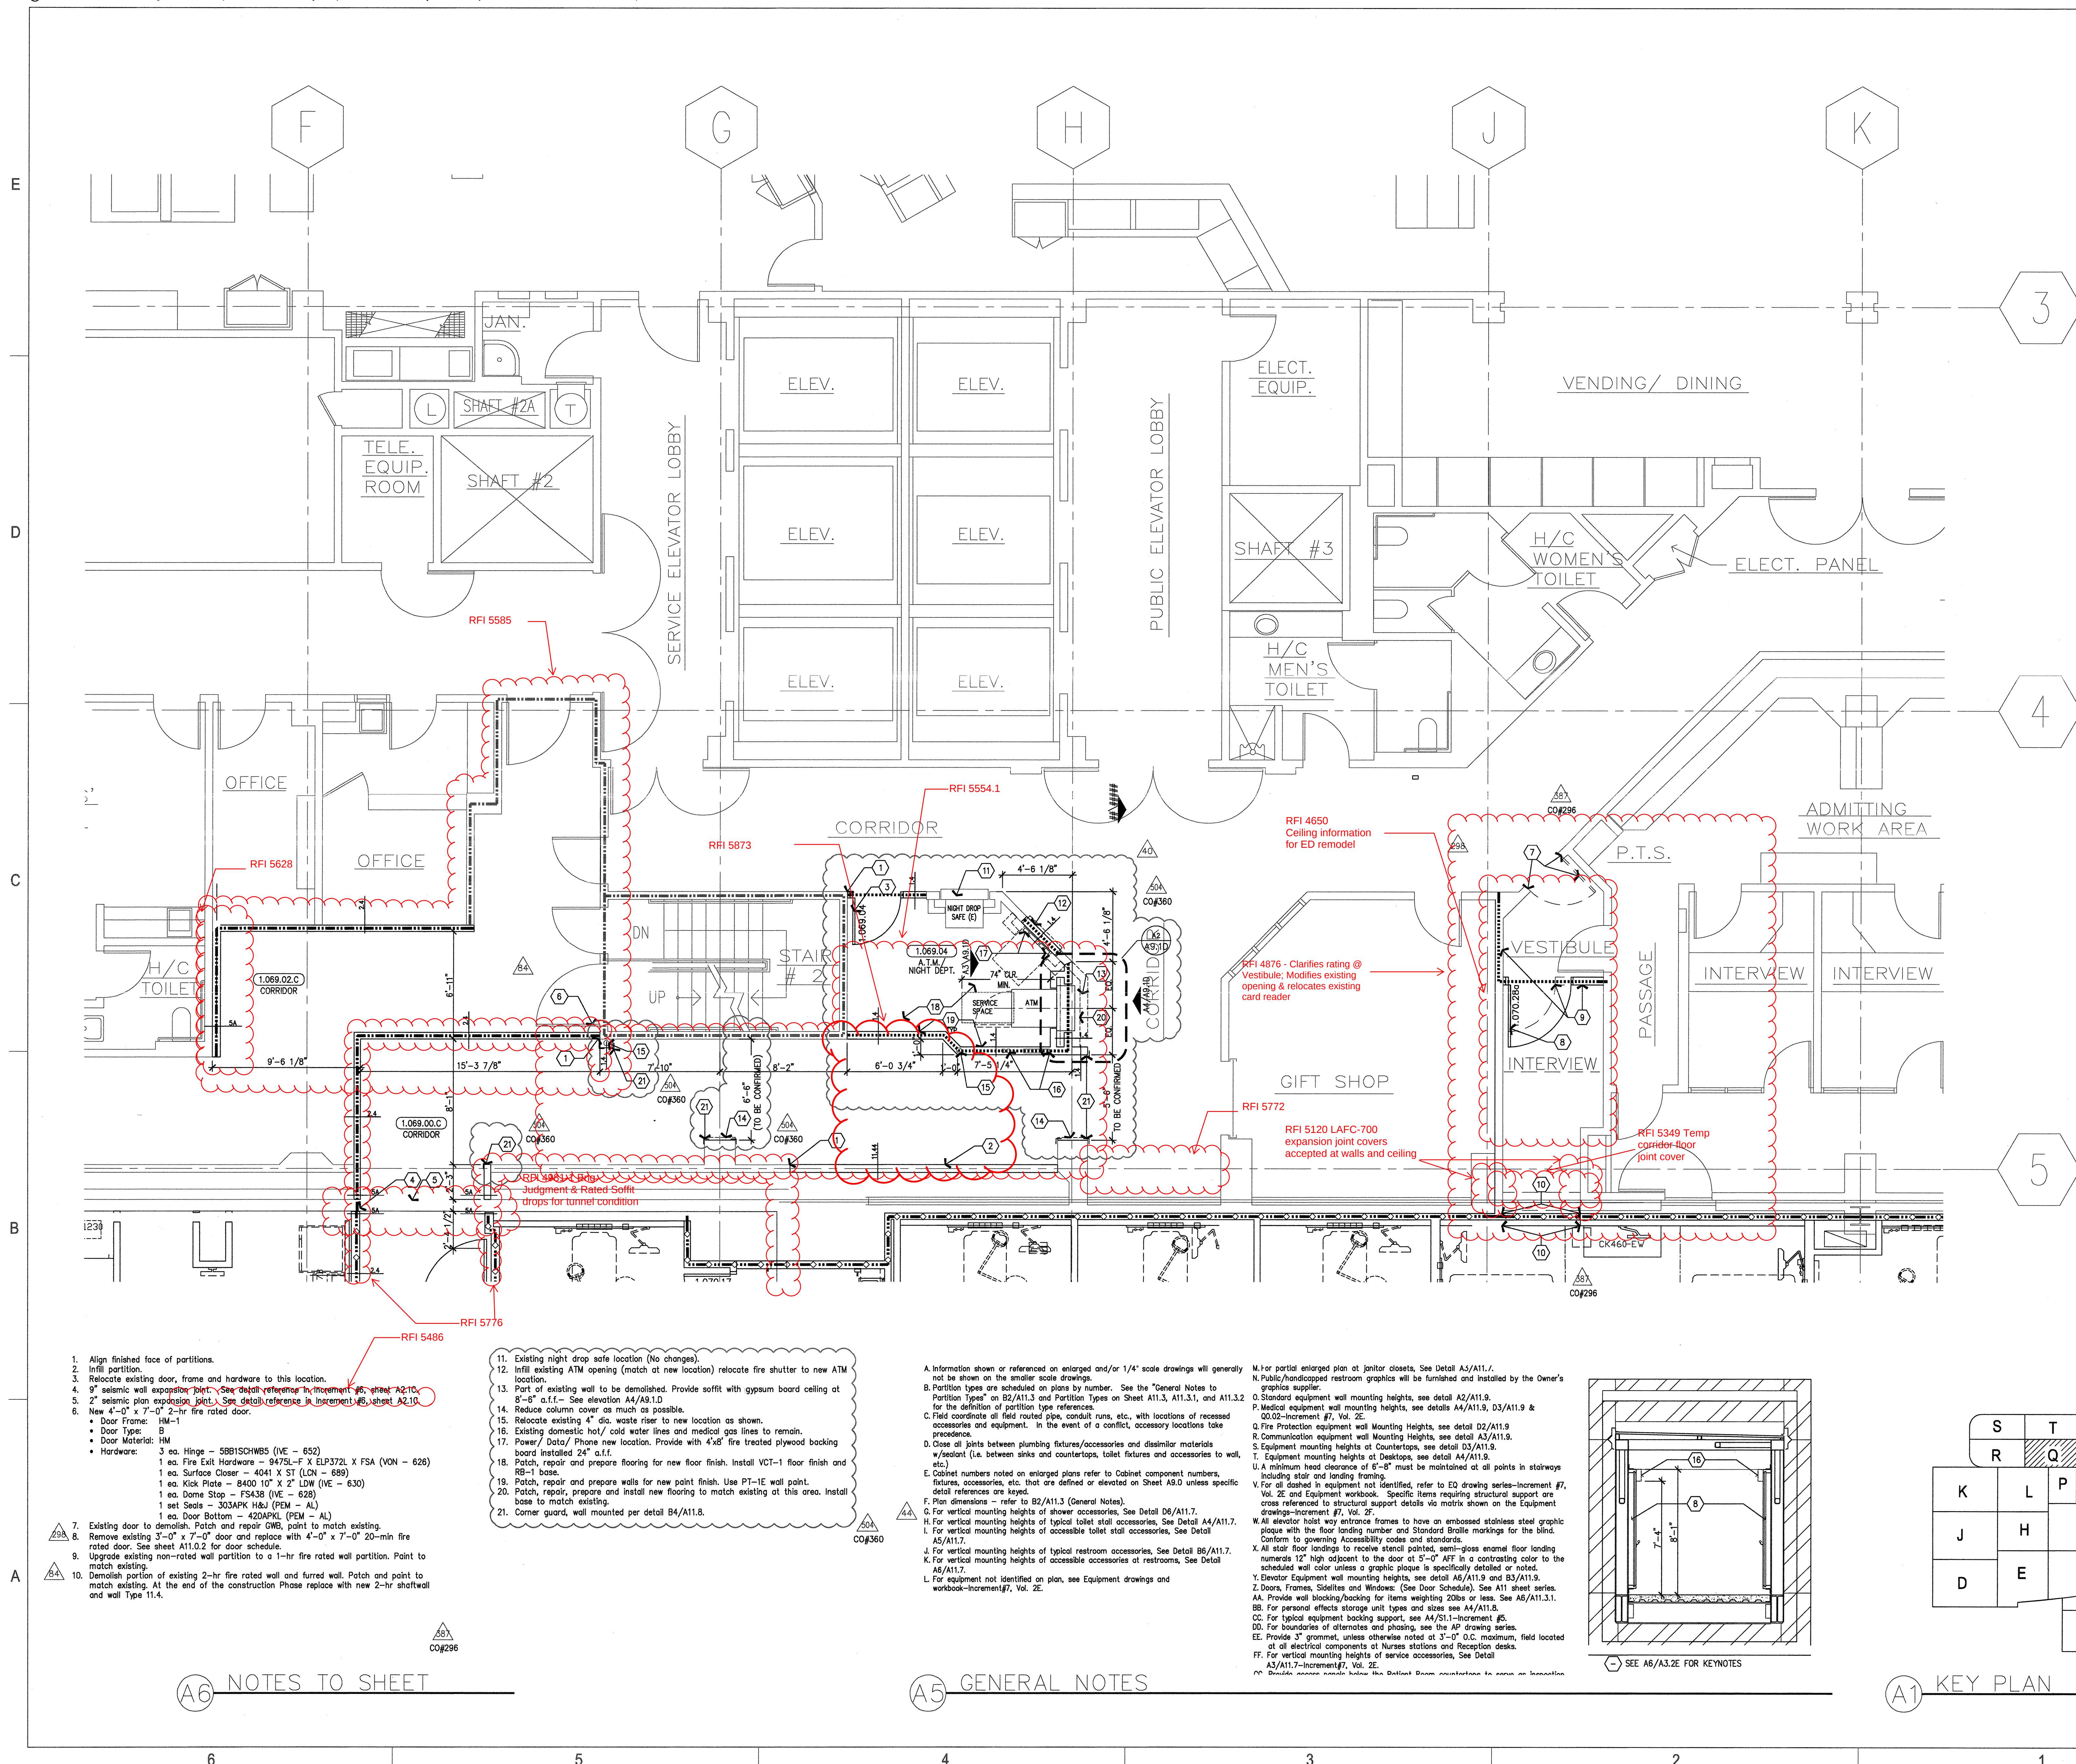

A6 NOTES TO SHEET

A5 GENERAL NOTES

A1 KEY PLAN