


FKP Architects

ARCHITECT OF RECORD
Paul C. Gloriot

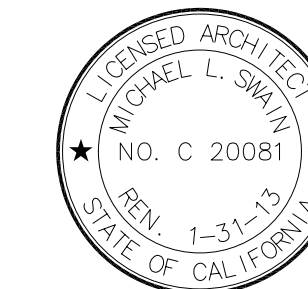


Changes on these drawings do not consist of materially altered changes to approved drawings and don't require a change order.
OSHPD review ACO _____
OSHPD review FLSO _____
OSHPD review DSE _____

REVISIONS

44	05/28/10	ASI #08
134	12/6/10	CO #109
71	08/06/10	CO #62
161	03/01/11	CO #134
537	11/02/11	CO #264
472	03/14/11	ASI #184
478	03/15/12	ASI #188
495	04/04/12	ASI #196

APPROVAL

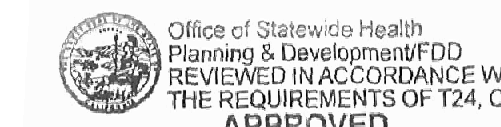

CHANGE ORDER/INSTRUCTION BULLETIN/DEFERRED APPROVAL # _____
(PRELIMINARY)

PROJECT NAME

CHILDREN'S HOSPITAL
OF ORANGE COUNTY

455 S. Main St.
Orange, CA 92668-3874

TOWER II



PROJECT NUMBER

12011.00
Increment #7

OSHPD - PROJECT NUMBER

IL 072072-30

ISSUE

OSHPD PERMIT

DATE

01/27/2010


SCALE

1/4" = 1' - 0"

LEVEL 2 ENLARGED PLAN
AREA - D

DRAWING NUMBER

A3.2D

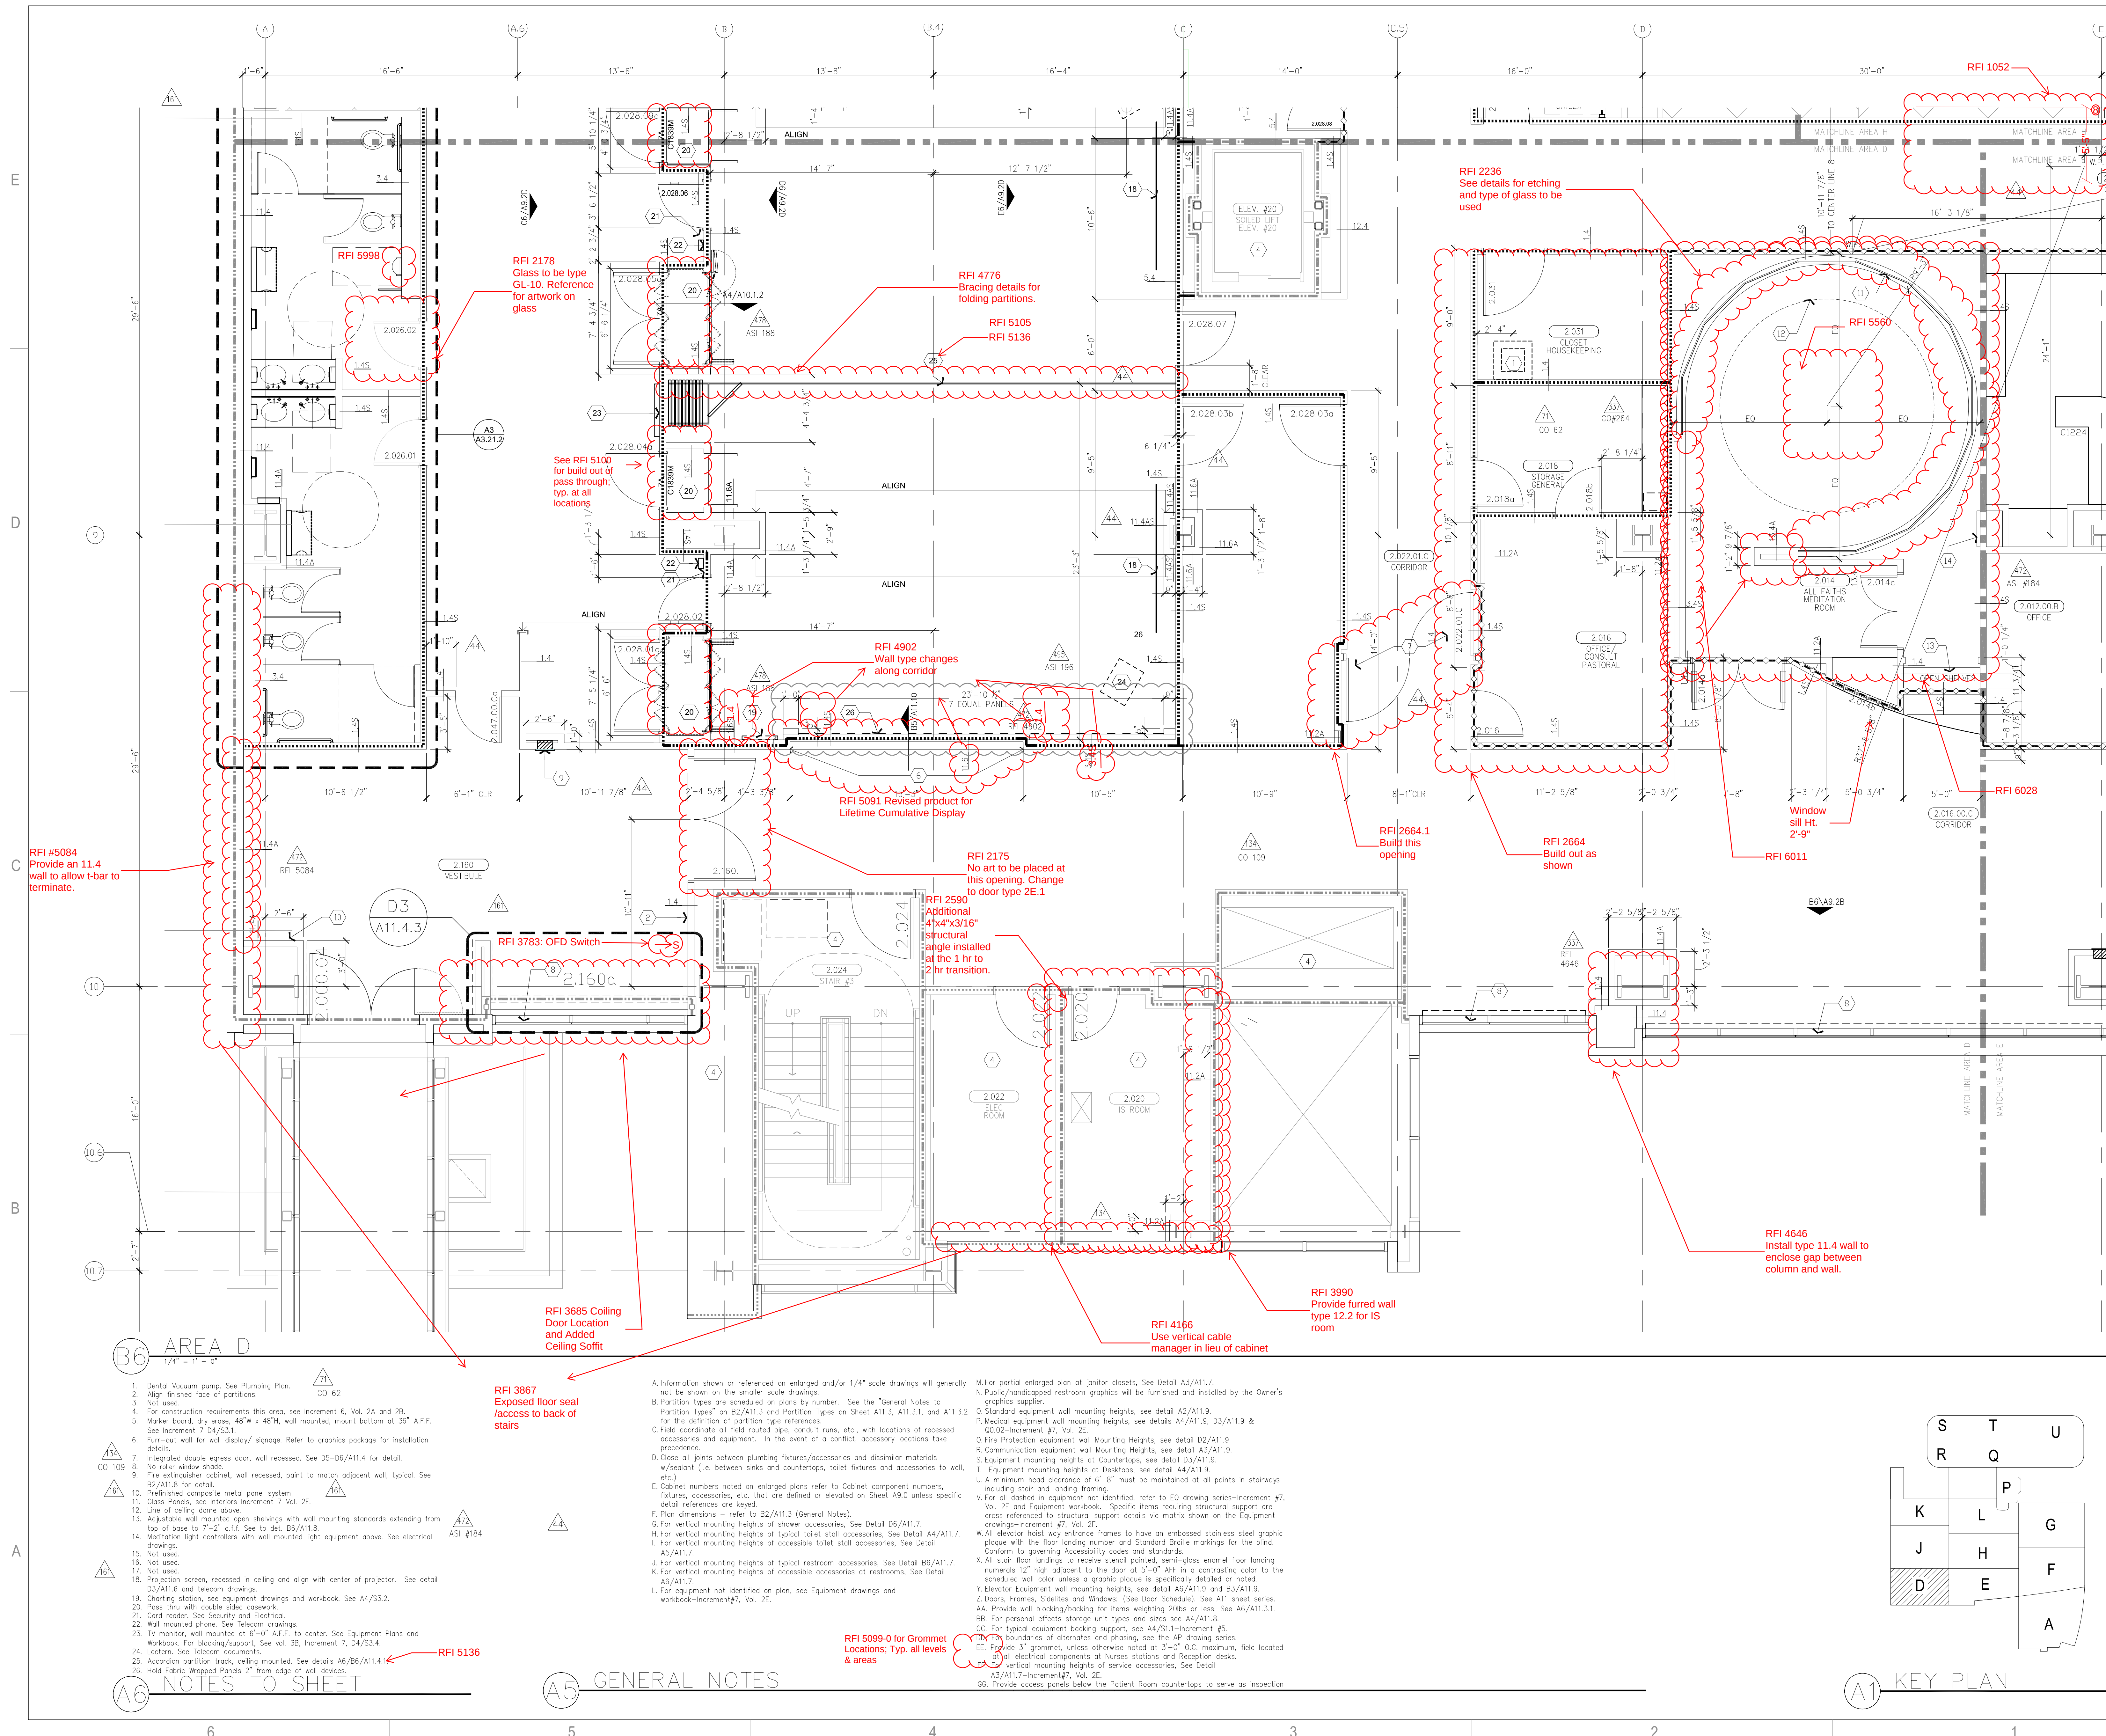

NOTES TO SHEET

GENERAL NOTES

KEY PLAN