


ARCHITECT OF RECORD
Paul C. Gloriod

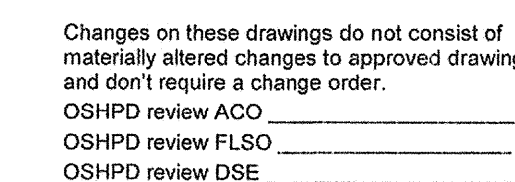

44	05/28/10	ASI #08
23	05/10/10	CO #25
19	12/01/10	ASI #48
74	02/24/11	CO #146
189	03/28/10	CO #174
248	06/07/10	CO #193
181	03/01/11	CO #134
510	07/19/11	ASI #100
321	08/18/11	CO #251
297	10/10/11	CO #232

Office of Statewide Health
Planning & Development/HDD
REVIEWED IN ACCORDANCE
WITH THE REQUIREMENTS OF 124,
APPROVED

**CHILDREN'S HOSPITAL
OF ORANGE COUNTY**
455 S. Main St.
Orange, CA 92868-3874

12011.00
Increment #7

ISSUE
OSHPD PERMIT

SCALE _____

$$1/4'' = 1' - 0$$

DRAWING NUMBER

A3.2G

