© 2009 FKP Architects, Inc. All rights reserved. No part of this document may be reproduced or utilized in any form without prior written authorization of FKP Architects, Inc.

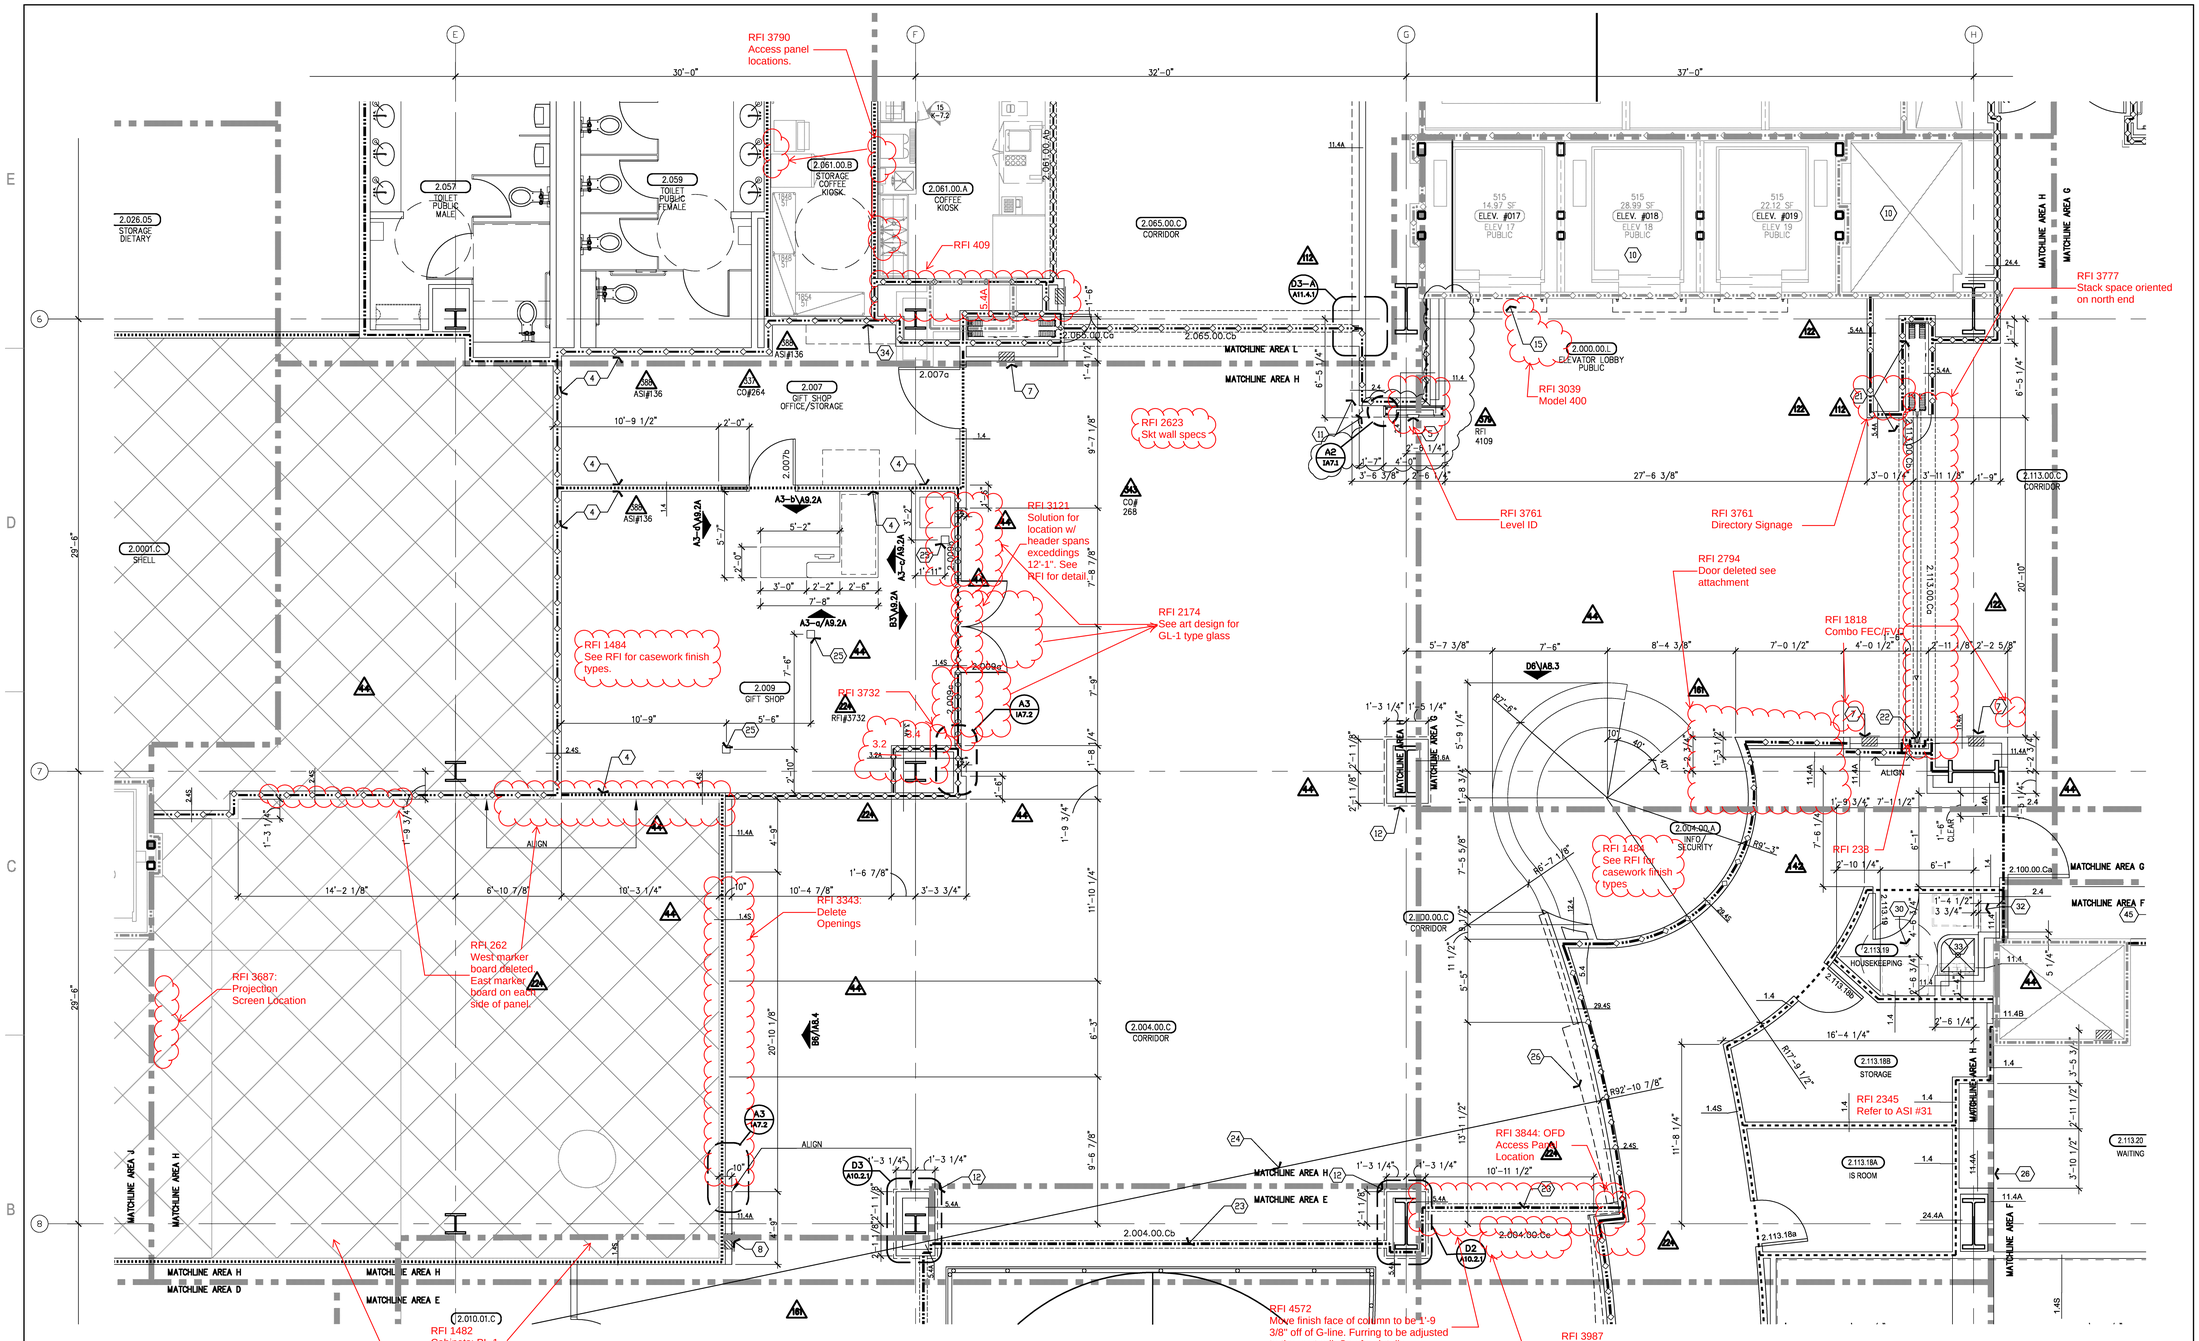

B6 AREA H
1/4" = 1' - 0"

1. Electric drinking fountain. See plumbing.
2. Paper towel dispenser, wall mounted, OFCI, see Equipment drawings and workbook.
3. Soap dispenser, wall mounted, OFCI, see Equipment drawings and workbook.
4. Stud wall. See IA8.6.
5. Recessed backlite graphic elevator sign light box per det. A4/A10.1.3. See interior drawings and electrical. (ASI#129)
6. Not used.
7. Fire valve cabinet, wall recessed, paint to match adjacent wall, typical. See A2 or B2/A11.8 for detail.
8. Fire extinguisher cabinet, wall recessed, paint to match adjacent wall, typical. See A2 or B2/A11.8 for detail..
9. Flat panel monitor, see Telecom drawings. See A2/S3.4.
10. For construction requirements this area, see Increment 6, Vol. 2A and 2B.
11. Decorative panels, see IA8.8.
12. Decorative glass panels, see D3/IA8.6.
13. Accordion partition track, ceiling mounted.
14. Marker board, 6'x3', wall mounted at 36" A.F.F. to bottom. Provide blocking, see A6/A11.3.1.
15. 'Smoke Guard' smoke and draft control assembly, Model 900.
16. Projection screen, recessed ceiling. See detail D3/A11.6 and Telecom drawings.
17. Projector, ceiling mounted, see Telecom drawings.
18. Charting station, see Equipment drawings and workbook. See A1/S3.6.
19. Not used.
20. Not used.
21. Accordion fire door. See detail B4 and D4/A11.4.1.
22. Accordion fire door jamb. See detail B5/A11.4.1.
23. Fire shutter, automatic roll down, ceiling recessed, see Door Schedule.
24. Refer to sheet A3.2D for radius workpoint and dimensions.
25. Floor box.
26. Refer to IA7.8 for interior finishes.
27. Not used.
28. Not used.
29. Not used.
30. Floor drain. sloped floor to drain.
31. Wall to be modified to become a 2-HR rated wall.
32. 14" deep shelf above, wall mounted with standards and brackets. See Detail B6/A11.8. (ASI#136)
33. Janitor mop sink. See Detail A3/A11.7.
34. Relocated Metal shelf unit. Provide backing per det. C5/A11.3.1.

See RFI 5912

RFI 3039
400

A6 NOTES TO SHEET

A. Information shown or referenced on enlarged and/or 1/4" scale drawings will generally not be shown on the smaller scale drawings.
B. Partition types are scheduled on plans by number. See the "General Notes to Partition Types" on B2/A11.3 and Partition Types on Sheet A11.3, A11.3.1, and A11.3.2 for the definition of partition type references.
C. Field coordinate all field routed pipe, conduit runs, etc., with locations of recessed accessories and equipment. In the event of a conflict, accessory locations take precedence.
D. Close all joints between plumbing fixtures/accessories and dissimilar materials w/sealant (i.e. between sinks and countertops, toilet fixtures and accessories to wall, etc.)
E. Cabinet numbers noted on enlarged plans refer to Cabinet component numbers, fixtures, accessories, etc. that are defined or elevated on Sheet A9.0 unless specific detail references are keyed.
F. Plan dimensions – refer to B2/A11.3 (General Notes).
G. For vertical mounting heights of shower accessories, See Detail D6/A11.7.
H. For vertical mounting heights of typical toilet stall accessories, See Detail A4/A11.7.
I. For vertical mounting heights of accessible toilet stall accessories, See Detail A5/A11.7.
J. For vertical mounting heights of typical restroom accessories, See Detail B6/A11.7.
K. For vertical mounting heights of accessible accessories at restrooms, See Detail A6/A11.7.
L. For equipment not identified on plan, see Equipment drawings and workbook–Increment#7, Vol. 2E.
M. For partial enlarged plan at janitor closets, See Detail A3/A11.7.
N. Public/handicapped restroom graphics will be furnished and installed by the Owner's graphics supplier.
O. Standard equipment wall mounting heights, see detail A2/A11.9.
P. Medical equipment wall mounting heights, see details A4/A11.9, D3/A11.9 & QQ.02–Increment #7, Vol. 2E.
Q. Fire Protection equipment wall Mounting Heights, see detail D2/A11.9
R. Communication equipment wall Mounting Heights, see detail A3/A11.9.
S. Equipment mounting heights at Countertops, see detail D3/A11.9.
T. Equipment mounting heights at Desktops, see detail A4/A11.9.
U. A minimum head clearance of 6'-8" must be maintained at all points in stairways including stair and landing framing.
V. For all dashed in equipment not identified, refer to EQ drawing series–Increment #7, Vol. 2E and Equipment workbook. Specific items requiring structural support are cross referenced to structural support details via matrix shown on the Equipment drawings–Increment #7, Vol. 2E.
W. All elevator hoist way entrance frames to have an embossed stainless steel graphic plaque with the floor landing number and Standard Braille markings for the blind. Conform to governing Accessibility codes and standards.
X. All stair floor landings to receive stencil painted, semi-gloss enamel floor landing numerals 12" high adjacent to the door at 5'-0" AFF in a contrasting color to the scheduled wall color unless a graphic plaque is specifically detailed or noted.
Y. Elevator Equipment wall mounting heights, see detail A6/A11.9 and B3/A11.9.
Z. Doors, Frames, Sidelites and Windows: (See Door Schedule). See A11 sheet series.
AA. Provide wall blocking/backing for items weighting 20lbs or less. See A6/A11.3.1.
BB. For personal effects storage unit types and sizes see A4/A11.8.
CC. For typical equipment backing support, see A4/S1.1–increment #5.
DD. For boundaries of alternates and phasing, see the AP drawing series.
EE. Provide 3" grommet, unless otherwise noted at 3'-0" O.C. maximum, field located at all electrical components at Nurses stations and Reception desks.
FF. For vertical mounting heights of service accessories, See Detail A3/A11.7–Increment#7, Vol. 2E.
GG. Provide access panels below the Patient Room countertops to serve as inspection ports for the Patient Room bathtubs.

A3 GENERAL NOTES

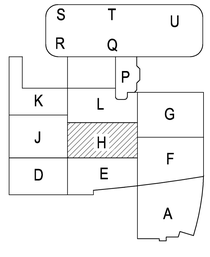

A1 KEY PLAN

FKP Architects

ARCHITECT OF RECORD
Paul C. Gloriod

LICENSED ARCHITECT MICHAEL L. SMITH NO. C 20081 REN. 1-31-13 STATE OF CALIFORNIA

Changes on these drawings do not consist of materially altered changes to approved drawings and don't require a change order.
OSHPD review ACO _____
OSHPD review FLSO _____
OSHPD review DSE _____

REVISIONS

44	05/28/10	ASI #08
122	10/20/10	CO #98
112	10/25/10	ASI 36
142	12/06/10	CO#113
161	03/01/11	CO #134
224	07/18/11	CO #176
243	10/31/11	CO #268
68b	11/17/11	ASI#136
57b	12/05/11	ASI#129

APPROVAL
Office of Statewide Health Planning & Development/FDD REVIEWED IN ACCORDANCE WITH THE REQUIREMENTS OF T24, CCR APPROVED

CHANGE ORDER#_____
INSTRUCTION BULLETIN#_____
DEFERRED APPROVAL#_____
ADDENDUM_____

PROJECT NAME
CHILDREN'S HOSPITAL OF ORANGE COUNTY
455 S. Main St.
Orange, CA 92868-3874

TOWER II

RECEIVED
Dec 13 2011
McCARTHY

CHOC HOSPITAL

PROJECT NUMBER
12011.00
Increment #7

OSHPD - PROJECT NUMBER
IL 072072-30

ISSUE
OSHPD PERMIT

DATE
01/27/2010

SCALE
1/4" = 1' - 0"

DRAWING TITLE
LEVEL 2 ENLARGED PLAN
AREA - H

DRAWING NUMBER
A3.2H

N:\06XXX\06102 CHOC TOWER 2 SHELL BUILDING\FKP CONTRACTED PROJECTS\PROJECT INCREMENTS\INCR. #07_TENANT IMPROVEMENT\OSHPD PERMIT (CONSTRUCTION DOCUMENTS)\100602_CO#_____\A3.2H.DWG
12/13/2011
RULA