


ARCHITECT OF RECORD
Paul C. Gloriod

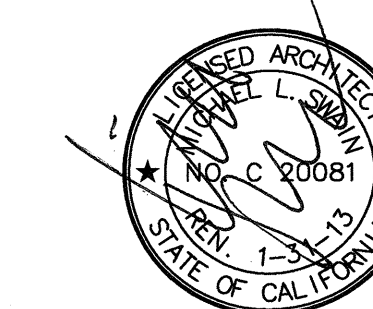

Changes on these drawings do not consist of materially altered changes to approved drawing and don't require a change order.

OSHPD review ACO _____

OSHPD review FLSO _____

OSHPD review DSE _____

	05/28/10	ASI #08
	05/10/10	CO #25
	10/25/10	ASI 36
	12/6/10	CO #109
	03/01/11	CO #134
	08/08/11	CO #135
	11/02/11	CO#264

APPROVAL



CHANGE ORDER# 264
INSTRUCTION BULLETIN# _____
DEFERRED APPROVAL# _____
ADDENDUM _____

PROJECT NAME

455 S. Main St.
Orange, CA 92868-3874



PROJECT NUMBER

OSHPD - PROJECT NUMBER
IL 072072-30

ISSUE
OSH/OSHPD PERMIT

DATE
01/27/2010

SCALE _____


$$1/4'' = 1' - 0''$$

DRAWING TITLE

LEVEL 2 ENLARGED PLAN
AREA - L

DRAWING NUMBER

A3.2L

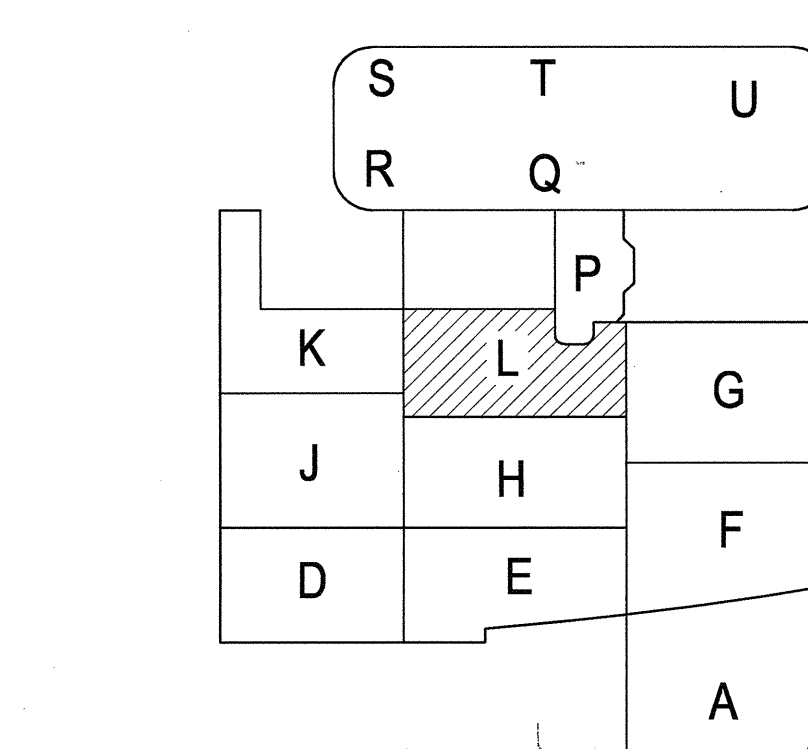

— SEE A6/A3.2E FOR

A1 KEY PLAN

- 1. Changing station, wall mounted, see D6/A11.8.
- 2. Window treatment, roller window shade, typical at all exterior glazing. U.N.O.
- 3. See room 2.059 for typical note designations.
- 4. Integrated double egress door, wall recessed. See D5/A11.4 for detail.
- 5. Fully recessed paper towel and trash receptacle. See B6/A11.7.
- 6. Soap dispenser, inventory mounted.
- 7. Solid surface material countertop. See A4/A11.7 for detail.
- 8. Mirror, full width of counter, from top of splash to 7'-0" A.F.F.
- 9. Accessible toilet stall. See A5 & B5/A11.7 for detail.
- 10. Toilet stall. See A4/A11.7 for mounting heights.
- 11. Toilet partition, floor mounted.
- 12. Paper towel dispenser, wall mounted, OFO, see Equipment drawings and workbook.
- 13. Pads, cabinet, pc, keyboard, monitor and mouse, wall mounted, see Equipment drawings and workbook.
- 14. See A1/S3.6.
- 15. Fire extinguisher and/or fire valve cabinet, wall recessed, paint to match adjacent wall, typical. See B2/A11.8 for details.
- 16. Kitchen equipment. See Food Services drawings.
- 17. Accordion fire door. See detail B4/A11.4, 1.1.
- 18. Accordion fire door jamb. See detail B5/A11.4, 1.
- 19. Fire shutter, automatic roll down, ceiling recessed.
- 20. Outdoor Terrace, see landscape drawings.
- 21. Provide wall blocking for partition, full height to ceiling height, U.N.O. per detail A6/A11.3.1.
- 22. Wall mounted TV, see Visual Drawings. See Structural detail D5/S3.4 similar.
- 23. Upright screen, wall mounted, see detail D4/A11.7. Provide wall blocking per detail A6/A11.3.1 similar.

24. Accordion partition pocket. RF1
25. Back partition to clear beam. #3591
26. Electric drinking fountains. See detail D2/A11.8
27. Decorative wall panels. See D3/A18.3
28. Overhead ceiling door. See Door Schedule.
29. For construction requirements this area, see Increment #6, Vol. 2A & 2B.
30. 30"x48" refuge space.
31. 2-Way communications system and signage.
32. Security grille remains open during business hours; retracts during fire alarm.
33. Integrated double egress door, wall recessed. See C4/A11.4.2 Srm
34. Sanitary dispenser. See B6/A11.7 for mounting location.
35. Align edge of wall with wall on south side of folding door.
36. Proposed "Donor Signage Wall".

B. Partition types are scheduled on plans by number. See the General Notes to Partitions on Sheet A11.3 and Partition Types on Sheet A11.3. A11.3.1 through A11.3.7 for the definition of partition type references.

C. Field coordinate all field routed pipes, conduit runs, etc., with locations of recessed accessories and/or lights. In the event of a conflict, accessory location takes precedence.

D. Close all joints between plumbing fixtures/accessories and dissimilar materials w/sealant (i.e. between sinks and countertops, toilet fixtures and accessories to wc etc.).

E. Cabinet numbers noted on enlarged plans refer to Cabinet component numbers, fixtures, accessories, etc. that are defined or elevated on Sheet A9.0 unless specific detail references are keyed.

F. Plan dimensions = 82/111.3 and Partitions Types on Sheet A11.3 (General Notes).

G. For vertical mounting heights of shower accessories, See Detail D6/A11.7.

H. For vertical mounting heights of typical toilet stall accessories, See Detail A4/A11.7.

I. For vertical mounting heights of accessible toilet stall accessories, See Detail A5/A11.7.

J. For vertical mounting heights of typical restroom towel accessories, See Detail B6/A11.7.

K. For vertical mounting heights of accessible accessories at restrooms, See Detail A6/A11.7.

L. For equipment not identified on plan, see Equipment drawings and workbook-Increment 1, p. 25.

- M.1 per patient entangled pad in patient closets. See Detail A5/11.1.
- N. Public/entranced restroom graphics will be furnished and installed by the Owner's graphics supplier.
- 3.2 O. Stanchion placement with mounting heights, see detail A4/11.9.
- P. Medical equipment wall mounting heights, see detail A4/11.9, A5/11.9 & 00-02-00-02, #7, Vol. 2E.
- Q. The Equipment workbooks for Mounting Heights, see detail D2/11.9.
- R. Communication equipment wall Mounting Heights, see detail A5/11.9.
- S. Equipment mounting heights at Countertops, see detail D3/11.9.
- T. Equipment wall mounting heights, see detail A5/11.9.
- U. A minimum head clearance of 6'-8" must be maintained at all points in stairwells including stair and landing framing.
- V. Drawings of equipment, (refer to E drawing series-increment #7).
- W. 2E and Equipment workbook. Specific items requiring structural support are cross referenced to structural support details via matrix shown on the Equipment workbook.
- X. All elevator host way entrance frames to have an unobstructed steel graphic paneling floor to ceiling with wall markings for the floor to ceiling. Conform to Accessibility Compliance codes and standards.
- X. All stair floor landings to receive stencil painted, semi-gloss enamel floor lining. Stencil to be applied to all stair nosings and wall markings for the floor to the scheduled wall color unless a graphic plate is specifically detailed or noted.
- Y. Elevator Equipment wall mounting heights, see detail A5/A11.9 and B3/11.9.
- Z. Elevator doors to be finished with a wall color matching the wall color for the scheduled wall color unless a graphic plate is specifically detailed or noted.
- AA. Provide wall blocking/bracing for types weighing 20lbs or less. See A6/11.1(A).
BB. For personal effects storage unit types and sizes see A4/11.1(A).
CC. For types of equipment and mounting heights see detail A5/11.9.
- DD. For boundaries of entrances and phasing, see the AP drawing series.
- E. Provide 3" grommet, unless otherwise noted at 1"-0" O.C. maximum, field located and installed in concrete and masonry walls.
- F. For vertical mounting heights of service accessories, See Detail A3/11.1-increment#7, Vol. 2E.
- GG. Provide 1/2" x 1/2" x 1/2" Polished Roman Countertops to serve as inspection

SEE A6/A3.2E FOR

1

KEY PLAN

(A6) NOTES TO SHEET

A4 GENERAL NOTES

(A1) KEY PLAN