© 2009 FKP Architects, Inc. All rights reserved. No part of this document may be reproduced or utilized in any form without prior written authorization of FKP Architects, Inc.

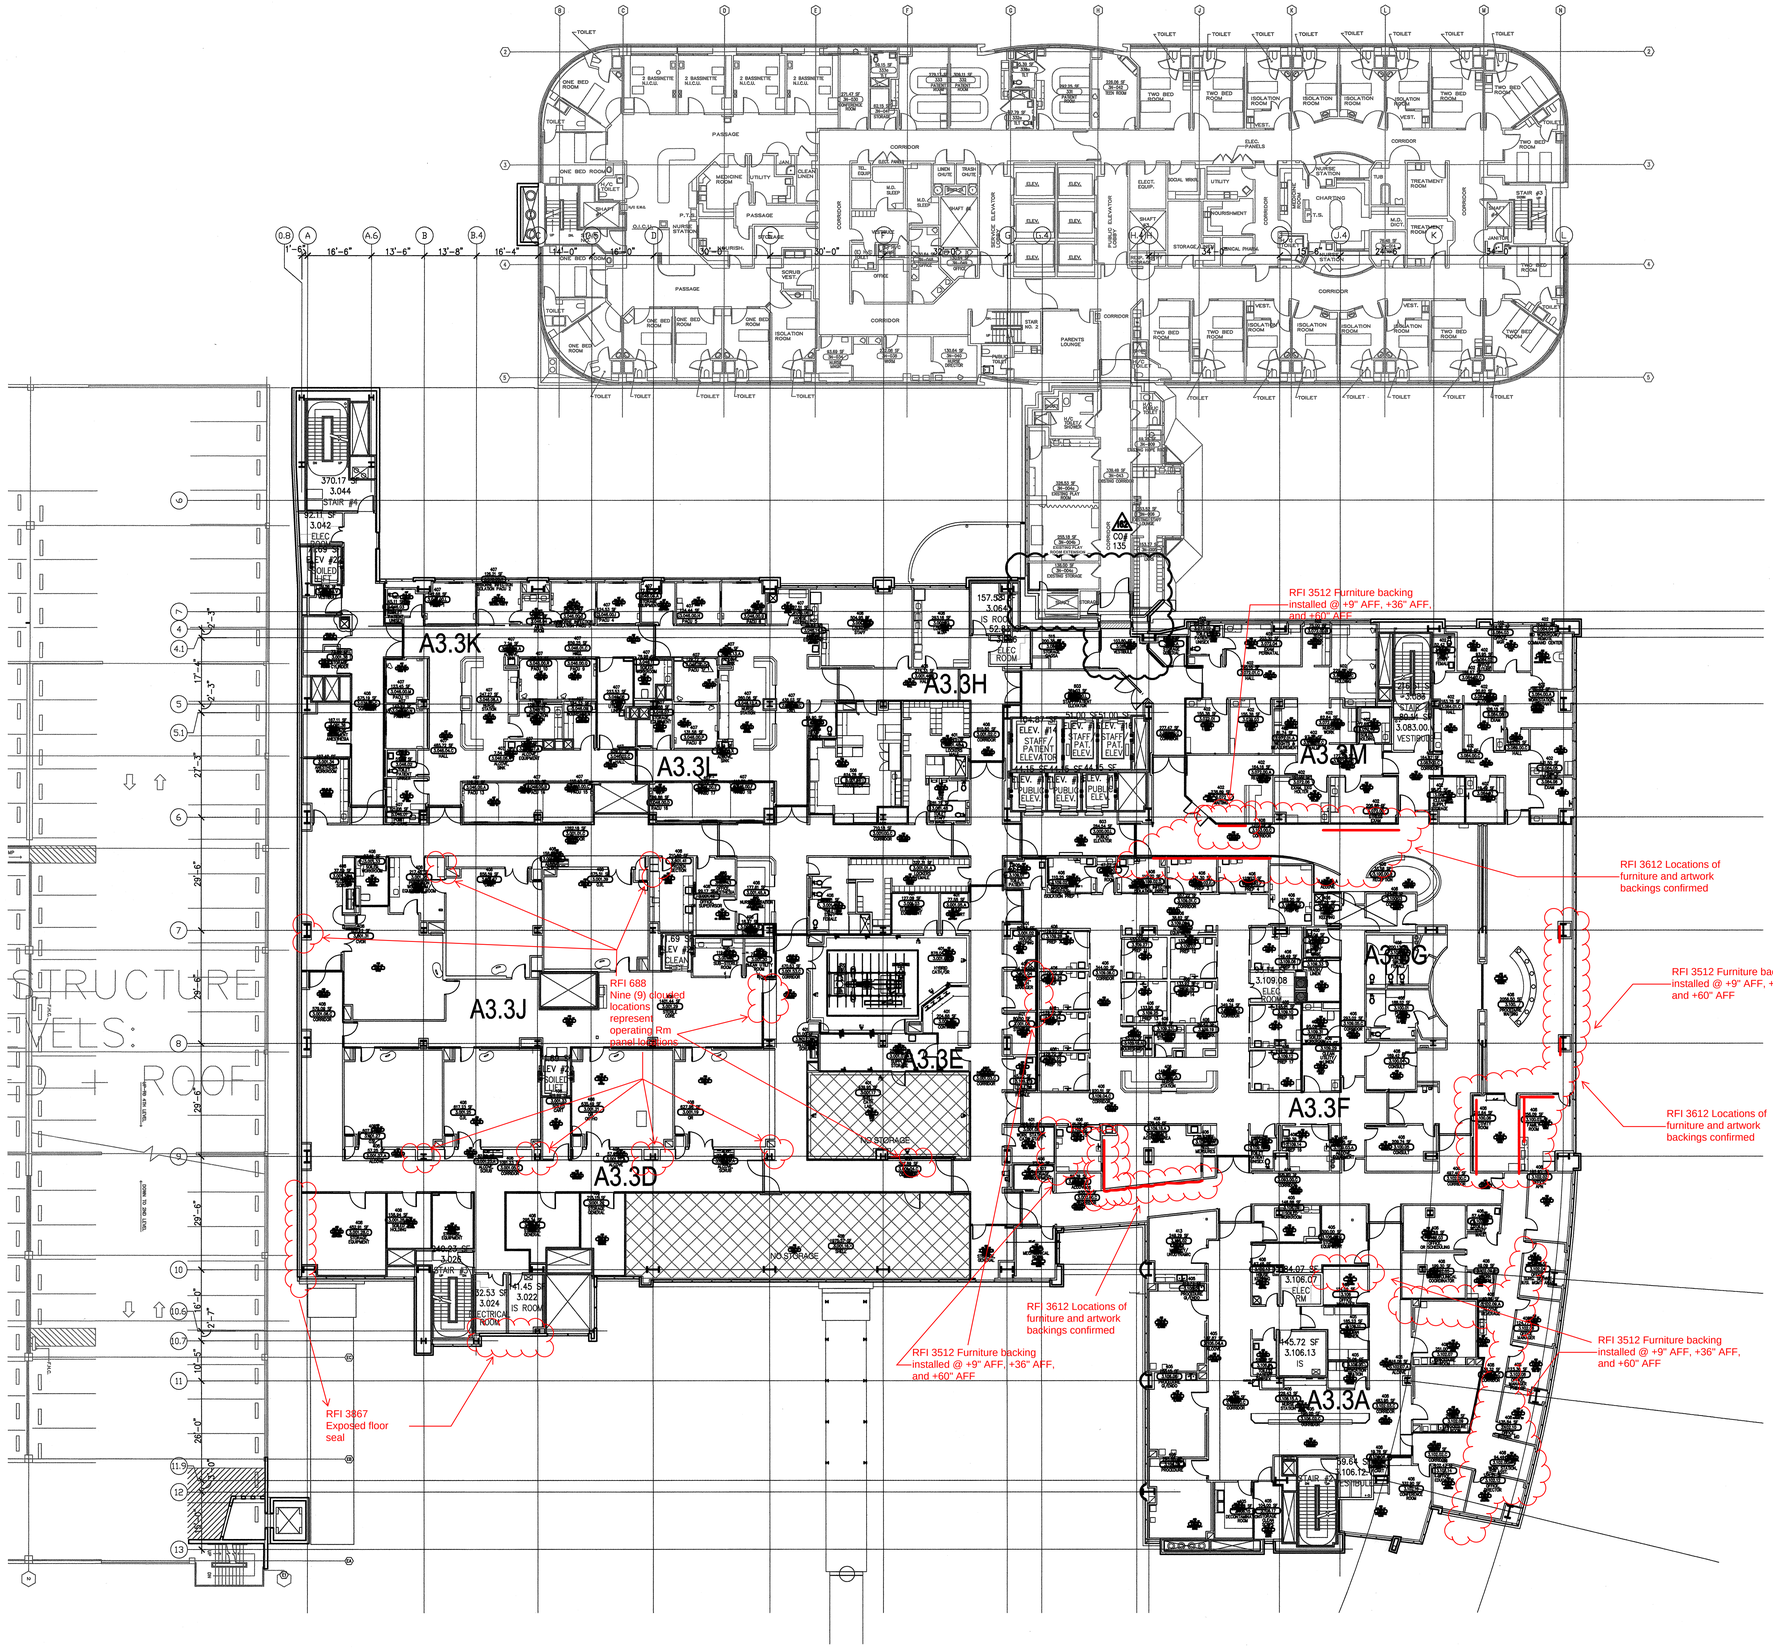

A6 LEVEL 3
1/16 = 1'-0"

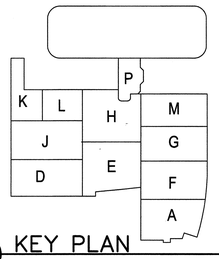

A1 KEY PLAN

FKP Architects

ARCHITECT OF RECORD

Paul C. Gloriod

LICENSED ARCHITECT PAUL C. GLORIOD No. C 20081 STATE OF CALIFORNIA

Changes on these drawings do not consist of materially altered changes to approved drawings and don't require a change order.
OSHPD review ACO _____
OSHPD review FLSO _____
OSHPD review DSE _____

REVISIONS

162	08/08/11	CO #135

APPROVAL

Office of Statewide Health Planning & Development(OSHPD) REVIEWED IN ACCORDANCE WITH THE REQUIREMENTS OF 24 CCR APPROVED

CHANGE ORDER# 135
INSTRUCTION BULLETIN# _____
DEFERRED APPROVAL# _____
ADDENDUM _____

PROJECT NAME

CHILDREN'S HOSPITAL OF ORANGE COUNTY
455 S. Main St.
Orange, CA 92868-3874

TOWER II

RECEIVED
SEPT. 21 2011
McCARTHY

CHOC HOSPITAL

PROJECT NUMBER

12011.00
Increment #7

OSHPD - PROJECT NUMBER

IL 072072-30

ISSUE

OSHPD PERMIT

DATE

01/27/2010

SCALE

1/16 = 1'-0"

DRAWING TITLE

LEVEL 3 FLOOR PLAN

DRAWING NUMBER

A3.31

\\WBSA-GFSITE\CADSERVER\06XXX\06102 CHOC TOWER 2 SHELL BUILDING\FKP CONTRACTED PROJECTS\PROJECT INCREMENTS\INCR. #07_TENANT IMPROVEMENT\OSHPD PERMIT (CONSTRUCTION DOCUMENTS)\06602_CO#_____\A3.31 LEVEL 3 FLOOR PLAN.DWG
8/13/2011
GEORGINA