


FKP Architects

ARCHITECT OF RECORD
Paul C. Gloriot

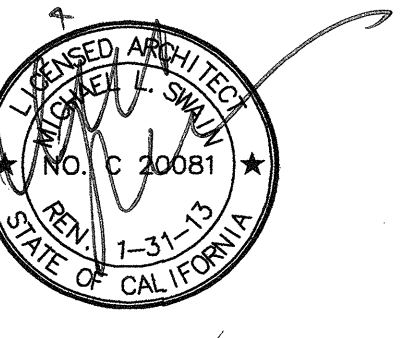


Changes on these drawings do not consist of
materially altered changes to approved drawings
and don't require a change order.
OSHPD review FLSO
OSHPD review FLSO
OSHPD review FLSO

REVISIONS

44	05/28/10	ASI #08
71	08/06/10	CO#62
91	11/18/10	ASI #27
205	03/01/11	ASI #72
188	03/28/10	CO #174
248	06/07/10	CO #193
29	07/18/11	CO #226
334	09/19/11	CO# 261
39	11/15/11	CO#289
280	03/12/12	CO#281
500	07/30/12	CO#361

APPROVAL

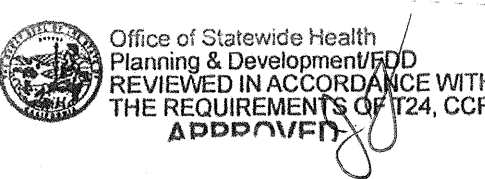

CHANGE ORDER
INSTRUCTION BULLETIN
DEFERRED APPROVAL
10/20/2010

PROJECT NAME

CHILDREN'S HOSPITAL
OF ORANGE COUNTY

455 S. Main St.
Orange, CA 92668-3874

TOWER II



PROJECT NUMBER

12011.00
Increment #7

OSHPD - PROJECT NUMBER

IL 072072-30

ISSUE

OSHPD PERMIT

DATE

01/27/2010

SCALE

1/4" = 1' - 0"

DRAWING TITLE

LEVEL 3 ENLARGED PLAN
AREA - A

DRAWING NUMBER

A3.3A

