


FKP Architects

ARCHITECT OF RECORD
Paul C. Gloriot

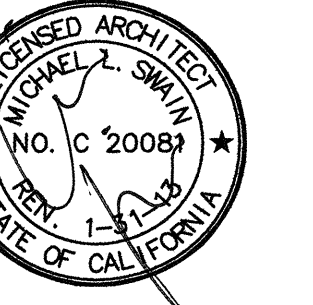


Changes on these drawings do not consist of materially altered changes to approved drawings and don't require a change order.
OSHPD review ACO
OSHPD review FLSO
OSHPD review DSE

REVISIONS

44	05/28/10	ASI #08
23	05/10/10	CO#25
71	00/00/10	CO#62
113	10/01/10	ASI #39
248	05/09/11	ASI #84
583	11/29/11	CO#295

APPROVAL

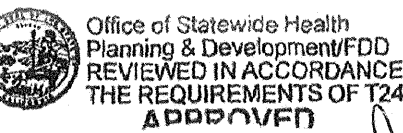

PAD# 2012-02334
CHANGE ORDER# 295
INSTRUCTION BULLETIN#
DEFERRED APPROVAL#
ADDENDUM#

PROJECT NAME

CHILDREN'S HOSPITAL
OF ORANGE COUNTY

455 S. Main St.
Orange, CA 92668-3874

TOWER II



PROJECT NUMBER

12011.00
Increment #7

OSHPD - PROJECT NUMBER

IL 072072-30

ISSUE

OSHPD PERMIT

DATE

01/27/2010

SCALE


1/4" = 1' - 0"

DRAWING TITLE

LEVEL 3 ENLARGED PLAN
AREA - D

DRAWING NUMBER

A3.3D

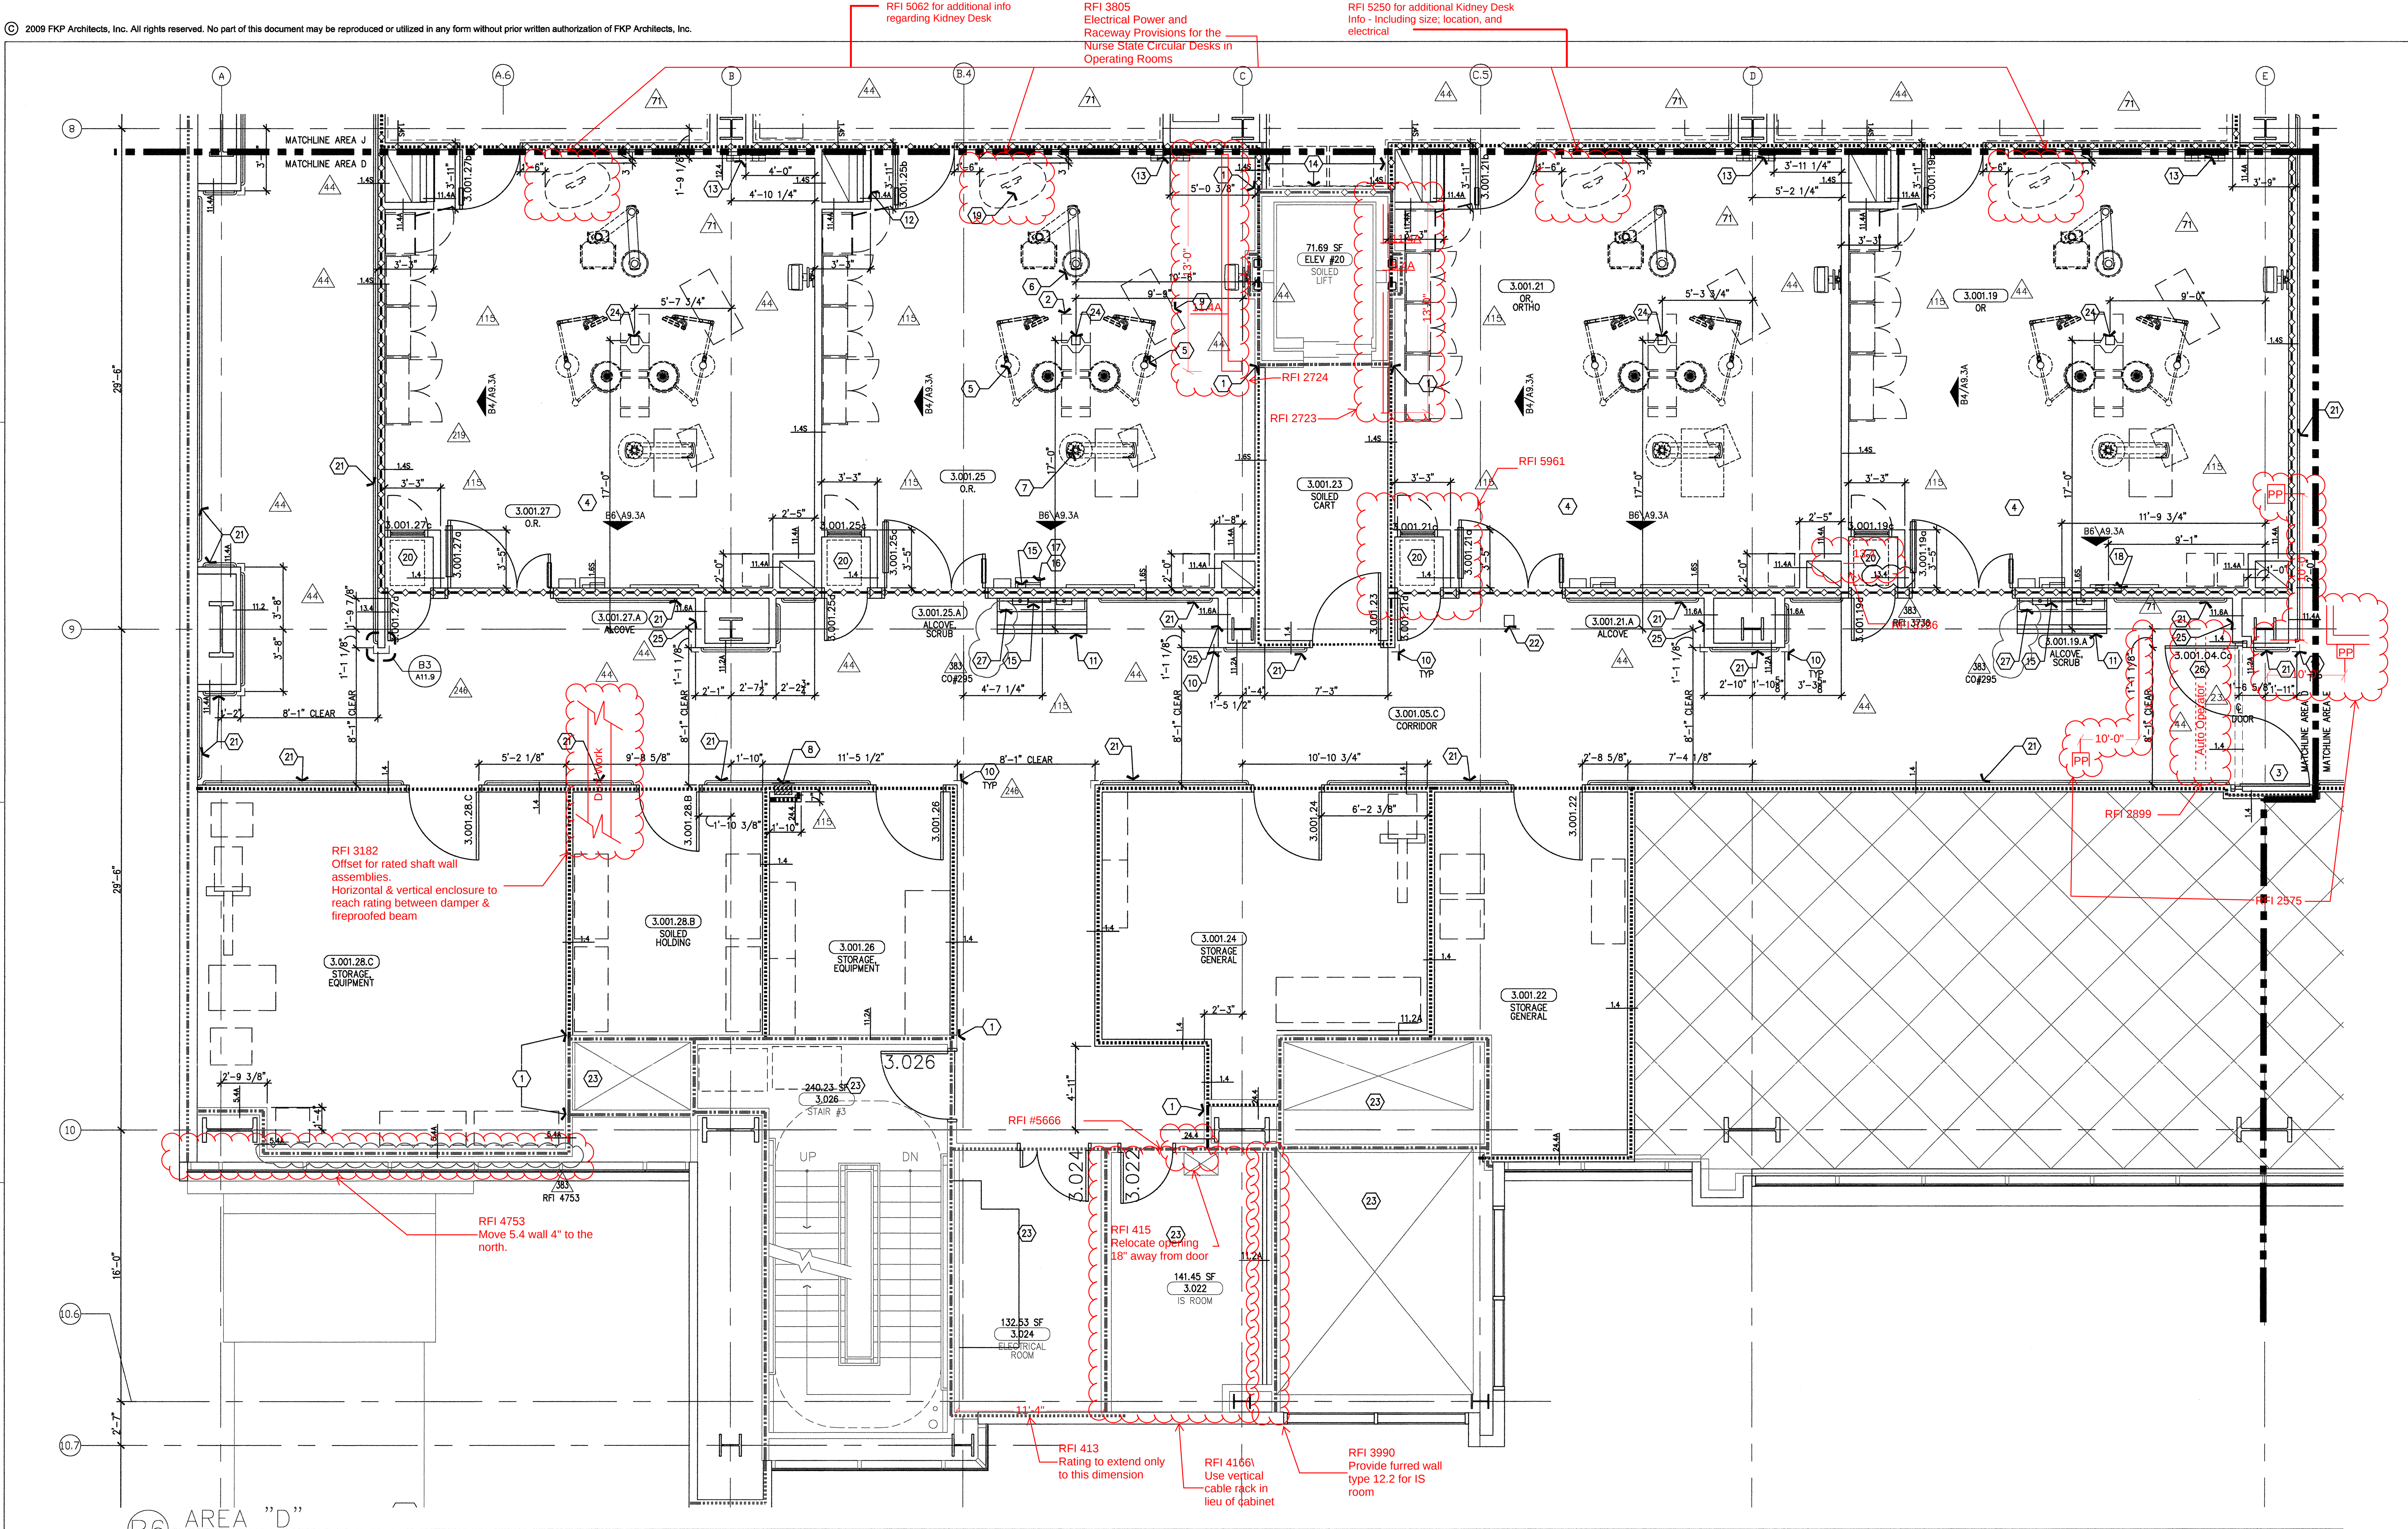

NOTES TO SHEET

- Align finished face of partitions.
- Operating room table, see Equipment Book.
- Integrated double egress door, wall recessed.
- See 05/06/A11.4 for detail.
- See room 3.001.25 for typical note designations.
- Articulating boom with surgery light & monitor, ceiling mounted. See increment #7 detail A2/S3. See Equipment drawings.
- Surgical support boom with medical gases/utilities, ceiling mounted. See similar increment #7 detail A2/S3.5. See Equipment and MEP drawings.
- Anesthesia boom with medical gases/utilities, ceiling mounted. See similar increment #7 detail A2/S3.5. See Equipment and Plumbing drawings.
- Fire extinguisher cabinet, wall recessed, point to match adjacent wall, typical. See B2 or A2/A11.8 for detail.
- Table, see Equipment book.
- Corner guard, see detail B4/A11.8
- Scrub sink, see Plumbing drawings.
- Isolation power panel above low air return.
- Medical gas outlets, see Plumbing. See elevation B2/A11.9.
- Sheet wall protection to 48" A.F.F.
- Clock, wall-mounted, elapse time and normal time, synchronize with all procedure rooms.
- Sharps container, see Equipment drawings. Provide blocking.
- Glove dispenser, see Equipment drawings. Provide blocking.
- Dental air/vacuum outlets, see Plumbing drawings.
- See elevation B2/A11.9
- Scrub-sink workstation, see Equipment book
- Integration systems cabinet

RFI 4221
See detail for attachment to wall
See A6/A11.3.1 for backing detail

GENERAL NOTES

A. Information shown or referenced on enlarged and/or 1/4" scale drawings will generally not be shown on the smaller scale drawings.

B. Partition types are scheduled on plans by number. See the "General Notes to Partition Types" on B2/A11.3 and Partition Types on Sheet A11.3.1, and A11.3.2 for the definition of partition type references.

C. Field coordinate all field routed pipe, conduit runs, etc., with locations of recessed accessories and equipment. In the event of a conflict, accessory locations take precedence.

D. Close all joints between plumbing fixtures/accessories and dissimilar materials w/sealant (i.e. between sinks and countertops, toilet fixtures and accessories to wall, etc.)

E. Cabinet numbers noted on enlarged plans refer to Cabinet component numbers, fixtures, accessories, etc. that are defined or elevated on Sheet A9.0 unless specific detail references are keyed.

F. Plan dimensions - refer to B2/A11.3 (General Notes).

G. For vertical mounting heights of shower accessories. See Detail D6/A11.7.

H. For vertical mounting heights of typical toilet stall accessories. See Detail A4/A11.7.

I. For vertical mounting heights of accessible toilet stall accessories. See Detail A5/A11.7.

J. For vertical mounting heights of shower accessories. See Detail B6/A11.7.

K. For vertical mounting heights of accessible accessories at restrooms. See Detail A6/A11.7.

L. For equipment not identified on plan, see Equipment drawings and workbook-Increment#7, Vol. 2E.

M. For partial enlarged plan at Junior closets, See Detail A3/A11.7.

N. Public/handicapped restroom graphics will be furnished and installed by the Owner's graphics supplier.

O. Standard equipment wall mounting heights, see detail A2/A11.8.

P. Medical equipment wall mounting heights, see details A4/A11.9, D3/A11.9 & Q0.02-Increment #7, Vol. 2E.

Q. Fire Protection equipment wall mounting heights, see detail D2/A11.9.

R. Communication equipment wall mounting heights, see detail A3/A11.8.

S. Equipment mounting heights at Countertops, see detail D3/A11.9.

T. Equipment mounting heights at Desks, see detail A4/A11.9.

U. A minimum head clearance of 6'-8" must be maintained at all points in stairways including stair and landing framing.

V. For all dashed in equipment not identified, refer to EQ drawing series-Increment #7, Vol. 2E and Equipment workbook. Specific items requiring structural support are cross referenced to structural support details via matrix shown on the Equipment drawings-Increment #7, Vol. 2E.

W. All elevator hoist way entrance frames to have an embossed stainless steel graphic plaque with the floor landing number and Standard Braille markings for the blind. Conform to governing Accessibility codes and standards.

X. All stair floor landings to receive stencil pointed, semi-gloss enamel floor landing numerals 12" high adjacent to the door at 5'-0" AFF in a contrasting color to the scheduled wall color unless a graphic plaque is specifically detailed or noted.

Y. Elevator Equipment wall mounting heights, see detail A5/A11.9 and B3/A11.8.

Z. Doors, Frames, Sidelites and Windows: (See Door Schedule). See A11 sheet series.

AA. Provide wall blocking/blocking for items weighing 20lbs or less. See A6/A11.3.1.

BB. For personal effects storage unit types and sizes see A4/A11.6.

CC. For typical equipment blocking support, see A4/S1-Increment #5.

DD. For boundaries of alternates and phasing, see the AP drawing series.

EE. Provide 3" grommet, unless otherwise noted at 3'-0" O.C. maximum, field located of all electrical components at Nurses stations and Reception desks.

FF. For vertical mounting heights of service accessories, See Detail A3/A11.7-Increment#7, Vol. 2E.

GG. Provide access panels below the Patient Room countertops to serve as inspection

RFI 5099-0 for Grommet Locations; Typ. all levels & areas

KEY PLAN