© 2009 FKP Architects, Inc. All rights reserved. No part of this document may be reproduced or utilized in any form without prior written authorization of FKP Architects, Inc.

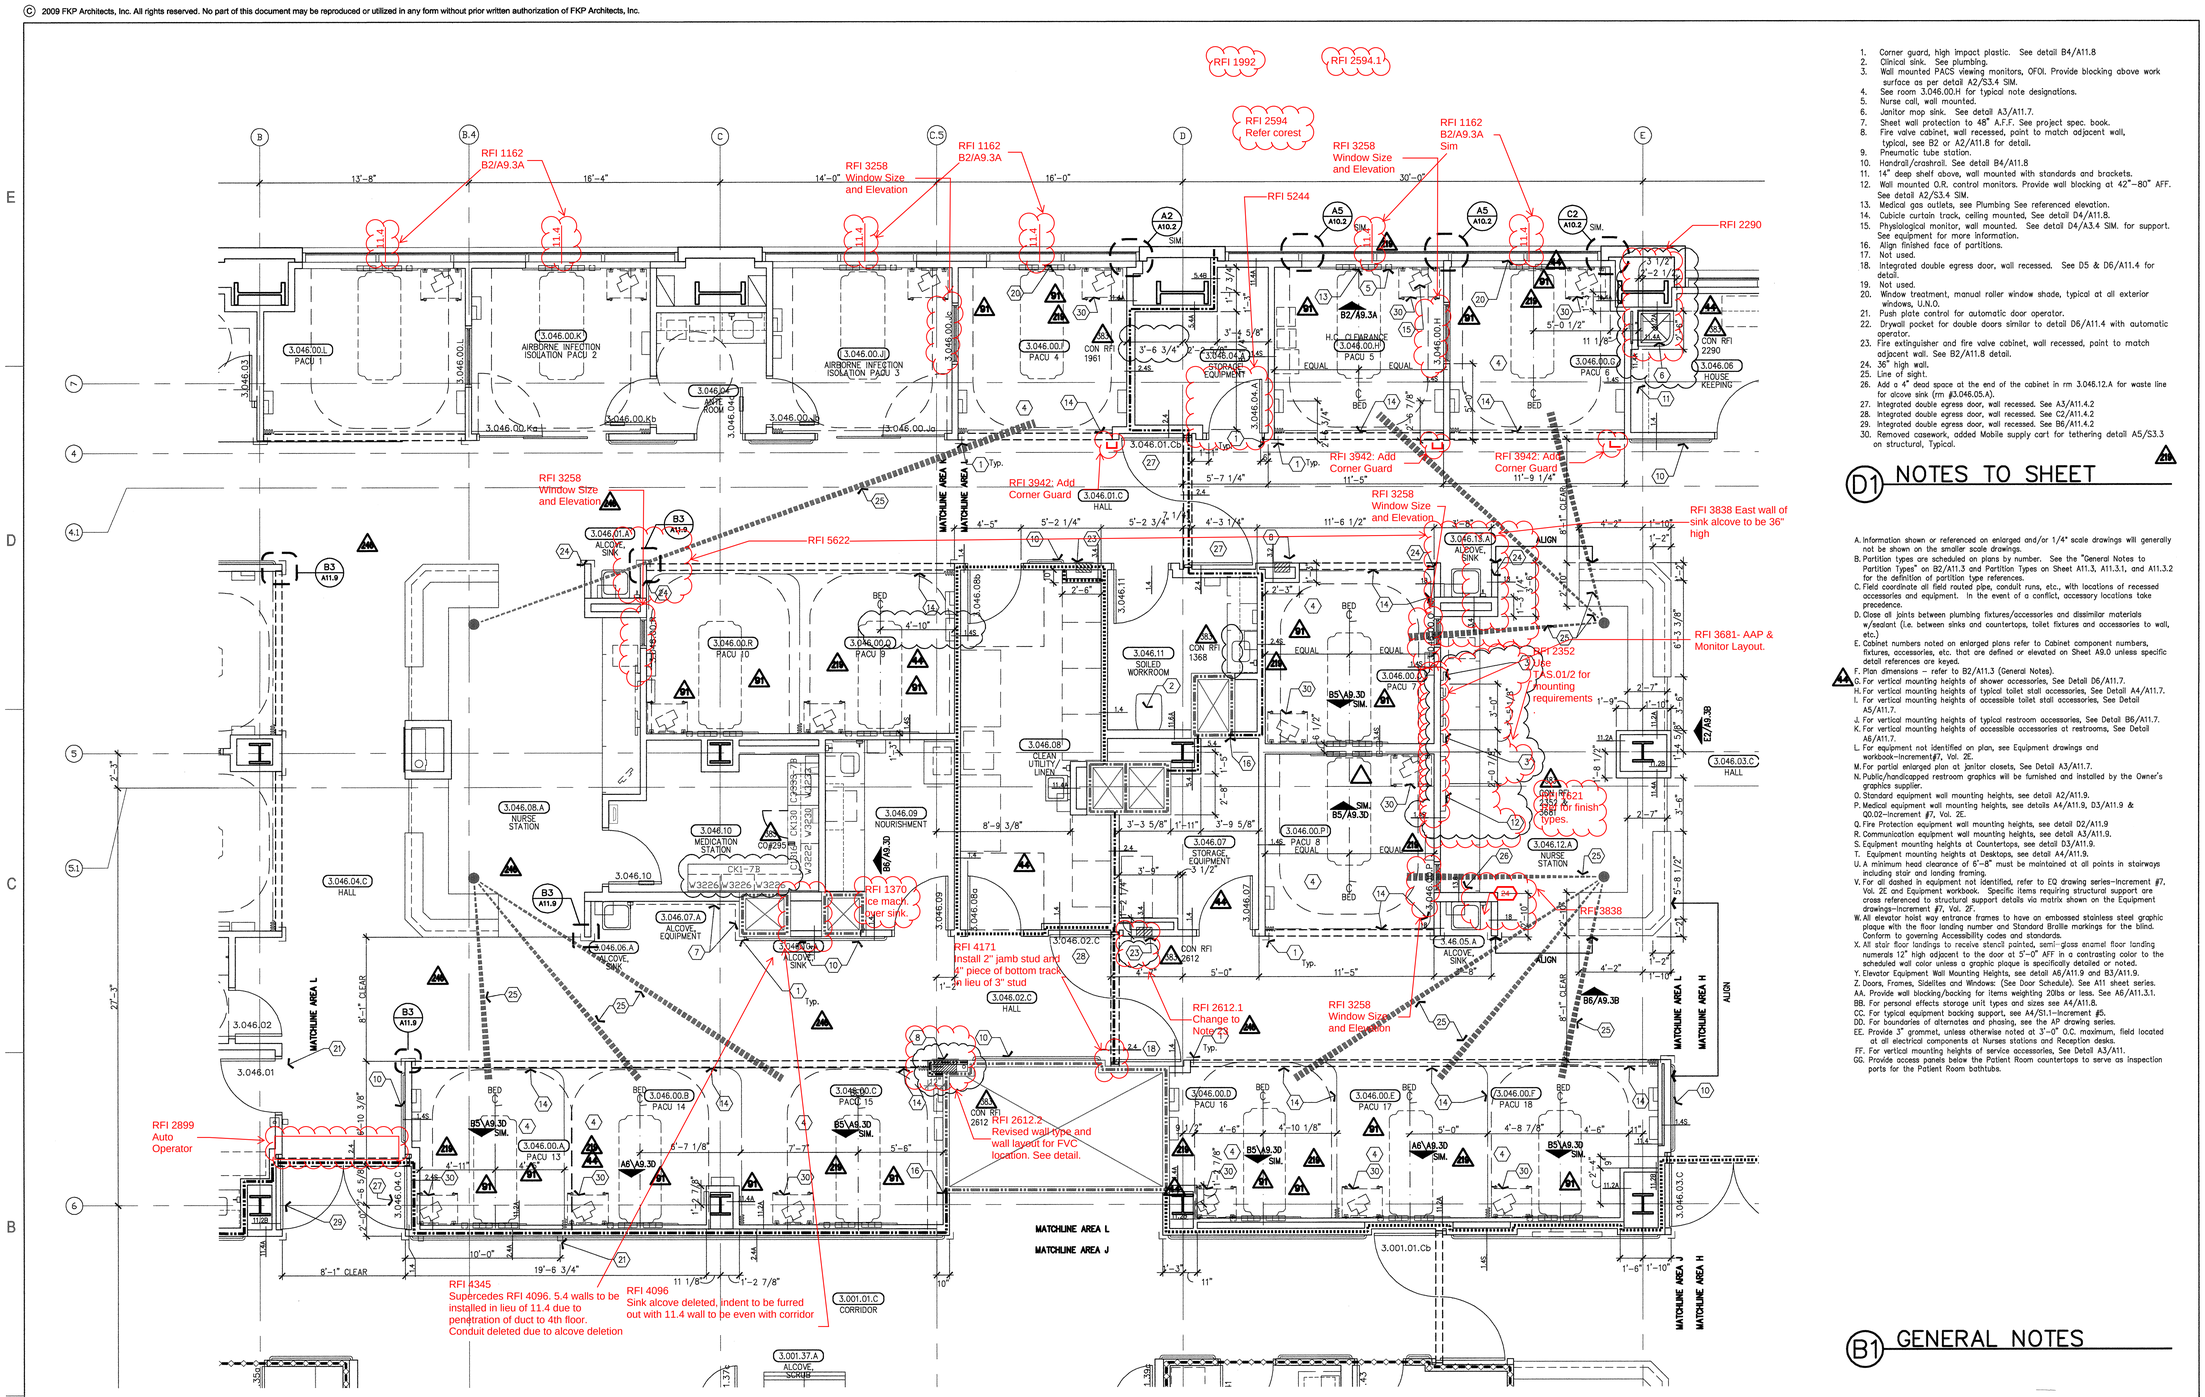

B6 AREA "L"
1/4" = 1'-0"

1. Corner guard, high impact plastic. See detail B4/A11.8
2. Clinical sink. See plumbing.
3. Wall mounted PACS viewing monitors, OFOI. Provide blocking above work surface as per detail A2/S3.4 SIM.
4. See room 3.046.00.H for typical note designations.
5. Nurse call, wall mounted.
6. Janitor mop sink. See detail A3/A11.7.
7. Sheet wall protection to 48" A.F.F. See project spec. book.
8. Fire valve cabinet, wall recessed, paint to match adjacent wall, typical, see B2 or A2/A11.8 for detail.
9. Pneumatic tube station.
10. Handrail/crashrail. See detail B4/A11.8
11. 14" deep shelf above, wall mounted with standards and brackets.
12. Wall mounted O.R. control monitors. Provide wall blocking at 42"–80" AFF. See detail A2/S3.4 SIM.
13. Medical gas outlets, see Plumbing See referenced elevation.
14. Cubicle curtain track, ceiling mounted, See detail D4/A11.8.
15. Physiological monitor, wall mounted. See detail D4/A3.4 SIM. for support. See equipment for more information.
16. Align finished face of partitions.
17. Not used.
18. Integrated double egress door, wall recessed. See D5 & D6/A11.4 for detail.
19. Not used.
20. Window treatment, manual roller window shade, typical at all exterior windows, U.N.O.
21. Push plate control for automatic door operator.
22. Drywall pocket for double doors similar to detail D6/A11.4 with automatic operator.
23. Fire extinguisher and fire valve cabinet, wall recessed, paint to match adjacent wall. See B2/A11.8 detail.
24. 36" high wall.
25. Line of sight.
26. Add a 4" dead space at the end of the cabinet in rm 3.046.12.A for waste line for alcove sink (rm #3.046.05.A).
27. Integrated double egress door, wall recessed. See A3/A11.4.2
28. Integrated double egress door, wall recessed. See C2/A11.4.2
29. Integrated double egress door, wall recessed. See B6/A11.4.2
30. Removed casework, added Mobile supply cart for tethering detail A5/S3.3 on structural, Typical.

D1 NOTES TO SHEET

A. Information shown or referenced on enlarged and/or 1/4" scale drawings will generally not be shown on the smaller scale drawings.
B. Partition types are scheduled on plans by number. See the "General Notes to Partition Types" on B2/A11.3 and Partition Types on Sheet A11.3, A11.3.1, and A11.3.2 for the definition of partition type references.
C. Field coordinate all field routed pipe, conduit runs, etc., with locations of recessed accessories and equipment. In the event of a conflict, accessory locations take precedence.
D. Close all joints between plumbing fixtures/accessories and dissimilar materials w/sealant (i.e. between sinks and countertops, toilet fixtures and accessories to wall, etc.)
E. Cabinet numbers noted on enlarged plans refer to Cabinet component numbers, fixtures, accessories, etc. that are defined or elevated on Sheet A9.0 unless specific detail references are keyed.
F. Plan dimensions – refer to B2/A11.3 (General Notes).
G. For vertical mounting heights of shower accessories, See Detail D6/A11.7.
H. For vertical mounting heights of typical toilet stall accessories, See Detail A4/A11.7.
I. For vertical mounting heights of accessible toilet stall accessories, See Detail A5/A11.7.
J. For vertical mounting heights of typical restroom accessories, See Detail B6/A11.7.
K. For vertical mounting heights of accessible accessories at restrooms, See Detail A6/A11.7.
L. For equipment not identified on plan, see Equipment drawings and workbook–increment #7, Vol. 2E.
M. For partial enlarged plan at janitor closets, See Detail A3/A11.7.
N. Public/handicapped restroom graphics will be furnished and installed by the Owner's graphics supplier.
O. Standard equipment wall mounting heights, see detail A2/A11.9.
P. Medical equipment wall mounting heights, see details A4/A11.9, D3/A11.9 & Q0.02–increment #7, Vol. 2E.
Q. Fire Protection equipment wall mounting heights, see detail D2/A11.9
R. Communication equipment wall mounting heights, see detail A3/A11.9.
S. Equipment mounting heights at Countertops, see detail D3/A11.9.
T. Equipment mounting heights at Desktops, see detail A4/A11.9.
U. A minimum head clearance of 6'–8" must be maintained at all points in stairways including stair and landing framing.
V. For all dashed in equipment not identified, refer to EQ drawing series–Increment #7, Vol. 2E and Equipment workbook. Specific items requiring structural support are cross referenced to structural support details via matrix shown on the Equipment drawings–increment #7, Vol. 2F.
W. All elevator hoist way entrance frames to have an embossed stainless steel graphic plaque with the floor landing number and Standard Braille markings for the blind. Conform to governing Accessibility codes and standards.
X. All stair floor landings to receive stencil painted, semi–gloss enamel floor landing numerals 12" high adjacent to the door at 5'–0" AFF in a contrasting color to the scheduled wall color unless a graphic plaque is specifically detailed or noted.
Y. Elevator Equipment Wall Mounting Heights, see detail A6/A11.9 and B3/A11.9.
Z. Doors, Frames, Sidelites and Windows: (See Door Schedule). See A11 sheet series.
AA. Provide wall blocking/backing for items weighing 20lbs or less. See A6/A11.3.1.
BB. For personal effects storage unit types and sizes see A4/A11.8.
CC. For typical equipment backing support, see A4/S1.1–Increment #5.
DD. For boundaries of alternates and phasing, see the AP drawing series.
EE. Provide 3" grommet, unless otherwise noted at 3'–0" O.C. maximum, field located at all electrical components at Nurses stations and Reception desks.
FF. For vertical mounting heights of service accessories, See Detail A3/A11.
GG. Provide access panels below the Patient Room countertops to serve as inspection ports for the Patient Room bathtubs.

B1 GENERAL NOTES

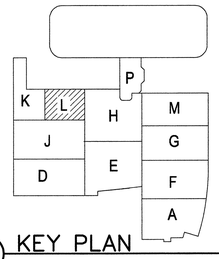

A1 KEY PLAN

FKP Architects

ARCHITECT OF RECORD
Paul C. Gloriod

LICENSED ARCHITECT MICHAEL L. MARTIN NO. C-20081 3-15 STATE OF CALIFORNIA

Changes on these drawings do not consist of materially altered changes to approved drawings and don't require a change order.
OSHPD review ACO
OSHPD review FLSO
OSHPD review DSE

REVISIONS

44	05/28/10	ASI #08
23	05/10/10	CO #25
91	11/18/10	ASI #27
246	05/09/11	ASI #84
219	05/26/11	CO #170
583	11/29/11	CO#295

APPROVAL
Office of Statewide Health Planning & Development/FDD REVIEWED IN ACCORDANCE WITH THE REQUIREMENTS OF T24, CCR. APPROVED 3/6/12
PAD-2012-02334
CHANGE ORDER# 295
INSTRUCTION BULLETINS#
DEFERRED APPROVAL#
ADDENDUM

PROJECT NAME
CHILDREN'S HOSPITAL OF ORANGE COUNTY
455 S. Main St.
Orange, CA 92868-3874

TOWER II

CHOC HOSPITAL

PROJECT NUMBER
12011.00
Increment #7

OSHPD - PROJECT NUMBER
IL 072072-30

ISSUE
OSHPD PERMIT

DATE
01/27/2010

SCALE
1/4" = 1' - 0"

DRAWING TITLE
LEVEL 3 ENLARGED PLAN AREA - L

DRAWING NUMBER
A3.3L

N:\06XXX\06102 CHOC TOWER 2 SHELL BUILDING\FKP CONTRACTED PROJECTS\PROJECT INCREMENTS\INCR. #07_TENANT IMPROVEMENT\OSHPD PERMIT (CONSTRUCTION DOCUMENTS)\100602_CO#_____\A3.3L.DWG
1/25/2012
RILLA