


FKP Architects

ARCHITECT OF RECORD
Paul C. Gloriot

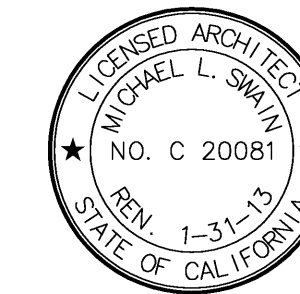

REVISIONS

44	05/28/10	ASI #08
203	03/01/11	ASI #72

APPROVAL

PROJECT NAME

CHILDREN'S HOSPITAL
OF ORANGE COUNTY

455 S. Main St.
Orange, CA 92668-3874

TOWER II



PROJECT NUMBER

12011.00
Increment #7

OSHPD - PROJECT NUMBER

IL 072072-30

ISSUE

DATE


SCALE

1/4" = 1' - 0"

DRAWING TITLE

DRAWING NUMBER

A3.3M

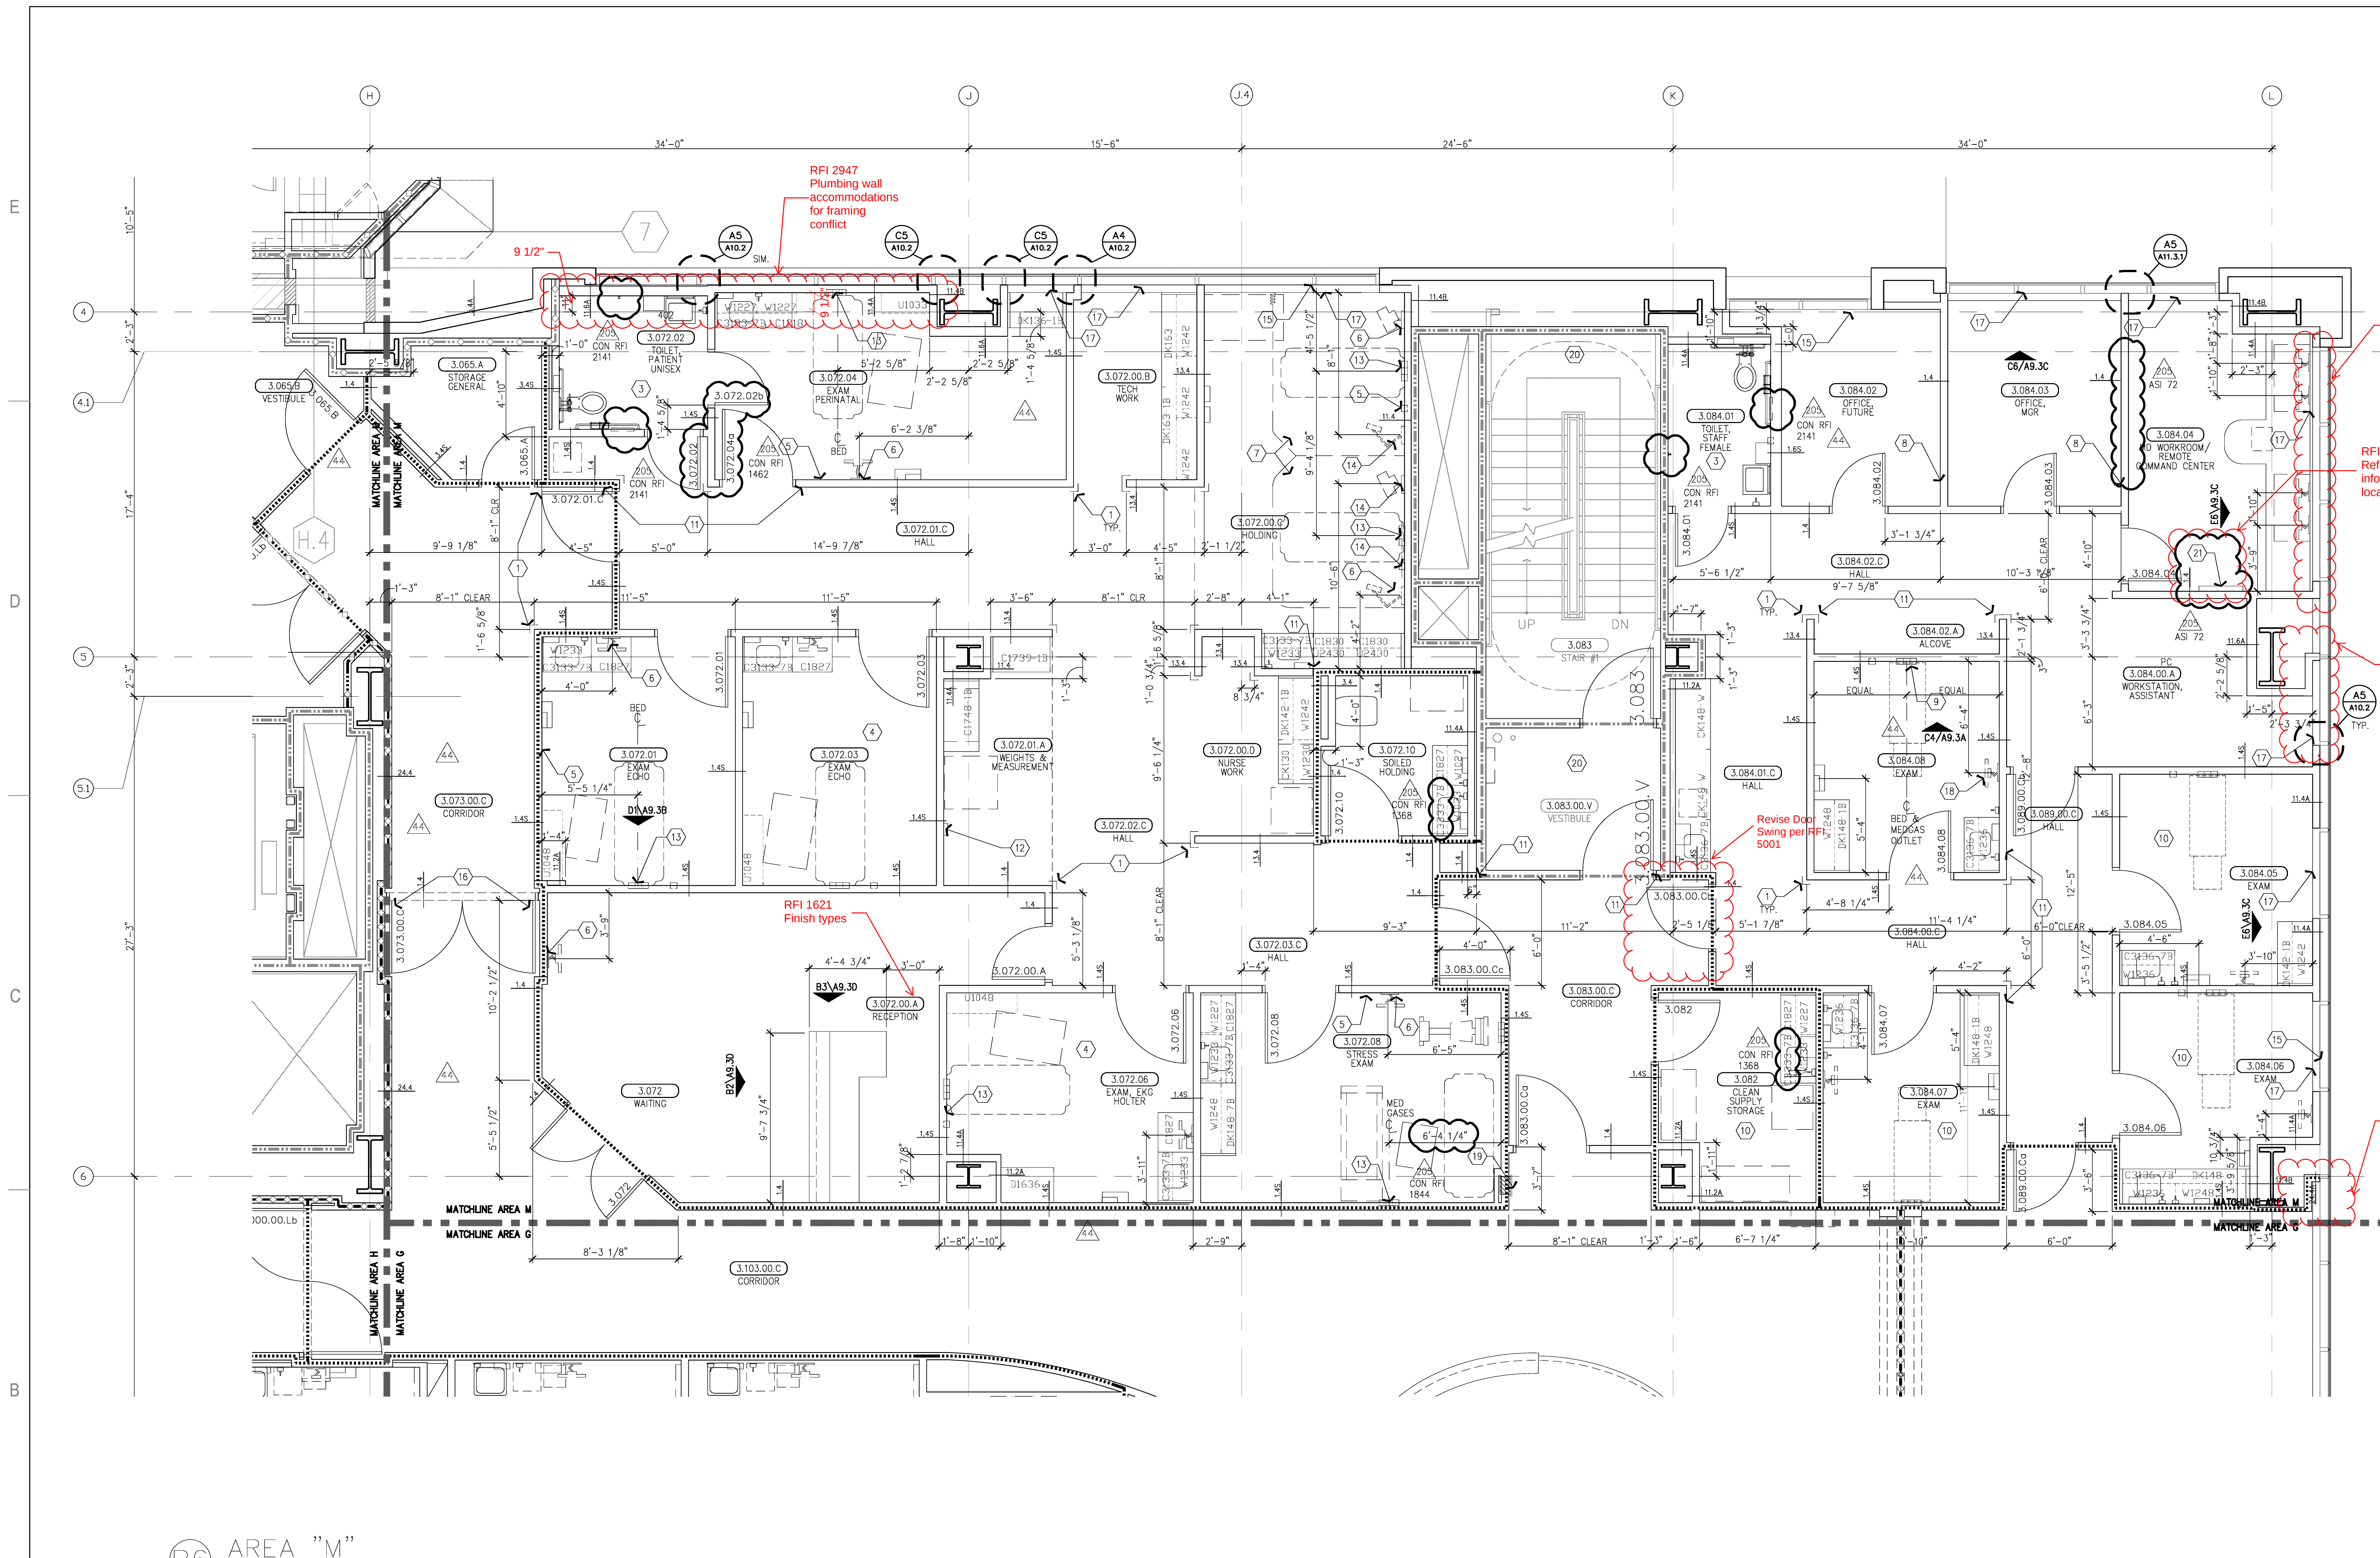

B6 AREA "M"
1/4" = 1'-0"


- Corner guard, high impact plastic. See B4/A11.8 for detail.
- Not used.
- Accessible toilet room. See typical plan detail B3/A11.7.
- See room 3.072.01 for typical note designations.
- Nurse call, wall mounted at 48" A.F.F..
- TV monitor with articulating arm, wall mounted. Provide blocking as per detail A5/S3.5, D1/S3.6, and D4/A11.8.
- Cable curtain track, ceiling mounted. See reflected ceiling plan.
- Provide plumbing rough-in for future sink.
- Medical gas outlets, see Plumbing. See B2/A11.9 for mounting height.
- See room 3.084.08 for typical note designations.
- Align finished face of partitions.
- Stadiometer, wall mounted. See equipment.
- Medical gas outlets, see Plumbing. See B2/A11.9 for mounting height.
- Physiological monitor, wall mounted. See Increment #7 detail D4/S3.4 SIM for backing support. See equipment drawings.
- Window Treatment, automatic rolling shade, typical at all Exterior windows, U.N.O.
- Integrated double egress door, wall recessed. See D5/A11.4 for detail.
- Sill wall, 2'-10" A.F.F., typical. See C5/A10.1 for detail.
- Wall mounted TV/DVD support bracket. See detail A5/S3.5 and D1/S3.6.
- Fire extinguisher cabinet, wall recessed, paint to match adjacent wall.
- For construction requirements this area, see Increment 6, Vol. 2A and D1/S3.6.
- Surface mounted dual X-Ray Film Viewer, hardware.

A6 NOTES TO SHEET


A5 GENERAL NOTES

- Information shown or referenced on enlarged and/or 1/4" scale drawings will generally not be shown on the smaller scale drawings.
- Partition types are scheduled on plans by number. See the "General Notes to Partition Types" on B2/A11.3 and Partition Types on Sheet A11.3.1, and A11.3.2 for the definition of partition type references.
- Field coordinate all field routed pipe, conduit runs, etc., with locations of recessed accessories and equipment. In the event of a conflict, accessory locations take precedence.
- Close all joints between plumbing fixtures/accessories and dissimilar materials w/sealant (i.e. between sinks and countertops, toilet fixtures and accessories to wall, etc.).
- Cabinet numbers noted on enlarged plans refer to Cabinet component numbers, fixtures, accessories, etc. that are defined or elevated on Sheet A9.0 unless specific detail references are keyed.
- Plan dimensions - refer to B2/A11.3 (General Notes).
- For vertical mounting heights of shower accessories, See Detail D6/A11.7.
- For vertical mounting heights of typical toilet stall accessories, See Detail A4/A11.7.
- For vertical mounting heights of accessible toilet stall accessories, See Detail A5/A11.7.
- For vertical mounting heights of typical restroom accessories, See Detail D6/A11.7.
- For vertical mounting heights of accessible accessories at restrooms, See Detail A6/A11.7.
- For equipment not identified on plan, see Equipment drawings and workbook-Increment#7, Vol. 2E.
- For partial enlarged plan at junior closets, See Detail A5/A11.1.
- Public/handicapped restroom graphics will be furnished and installed by the Owner's graphics supplier.
- Standard equipment wall mounting heights, see detail A2/A11.9.
- Medical equipment wall mounting heights, see details A4/A11.8, D3/A11.9 & Q0.02-Increment #7, Vol. 2E.
- Fire Protection equipment wall Mounting Heights, see detail D2/A11.9.
- Communication equipment wall Mounting Heights, see detail A3/A11.9.
- Equipment mounting heights at Counter tops, see detail D3/A11.9.
- Equipment mounting heights at Desks, see detail A4/A11.9.
- A minimum head clearance of 6'-8" must be maintained at all points in stairways including stair and landing framing.
- For all dashed in equipment not identified, refer to EQ drawing series-Increment #7, Vol. 2E and Equipment workbook. Specific items requiring structural support are cross referenced to structural support details via matrix shown on the Equipment drawings-Increment #7, Vol. 2E.
- All elevator hoist way entrance frames to have an embossed stainless steel graphic plaque with the floor landing number and Standard Braille markings for the blind. Conform to governing Accessibility codes and standards.
- All stair floor landings to receive stencil painted, semi-gloss enamel floor landing numerals 12" high adjacent to the door at 5'-0" AFF in a contrasting color to the scheduled wall color unless a graphic plaque is specifically detailed or noted.
- Elevator Equipment wall mounting heights, see detail A5/A11.9 and B3/A11.9.
- Doors, Frames, Sidelites (See Door Schedule). See A11 sheet series.
- AA. Provide wall blocking/backing for items weighing 20lbs or less. See A6/A11.3.1.
- BB. For personal effects storage unit types and sizes see A4/A11.8.
- CC. For typical equipment backing support, see A4/S3.1-Increment #6.
- DD. For boundaries of alternates and phasing, see the AP drawing series.
- EE. Provide 3" grommet, unless otherwise noted at 3'-0" O.C. maximum, field located at all electrical components at Nurses stations and Reception desks.
- FF. For vertical mounting heights of service accessories, See Detail A5/A11.7-Increment#7, Vol. 2E.
- PP. Public room entrance below the Patient Room counter to show an iconation.


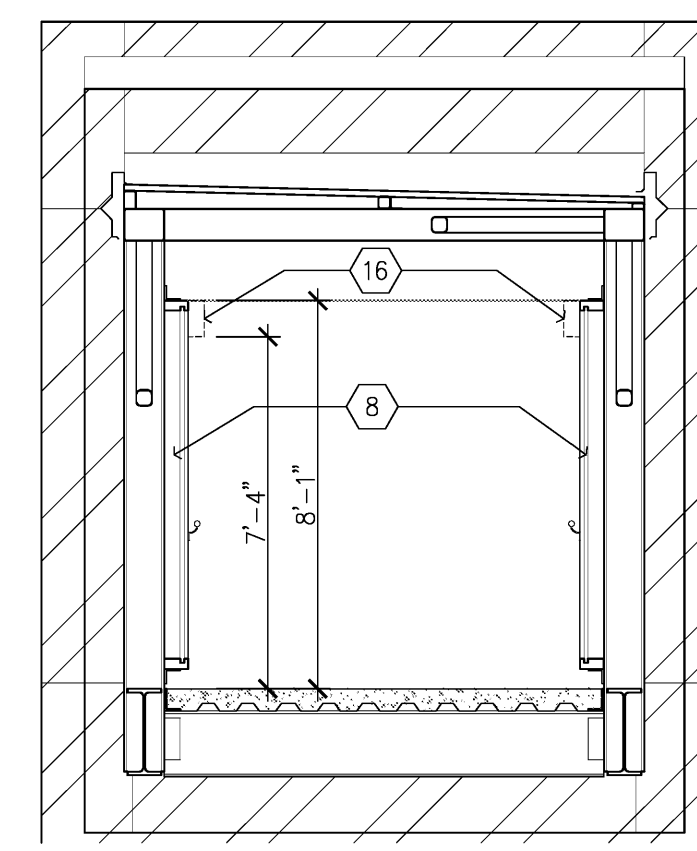

SEE A6/A3.2E FOR KEYNOTES

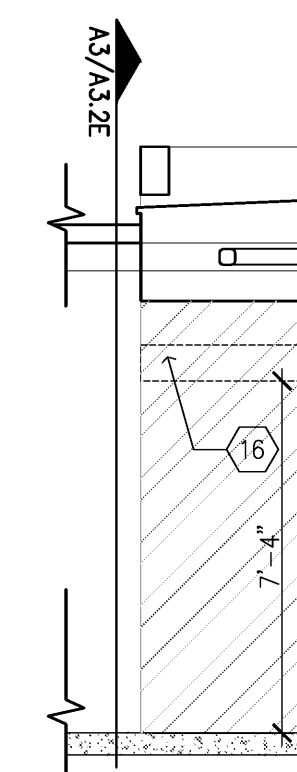

SEE A6/A3.2E FOR KEYNOTES

A1 KEY PLAN