


FKP Architects

ARCHITECT OF RECORD

Paul C. Gloriod

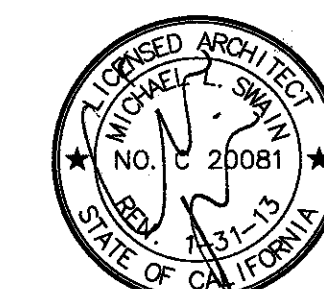


Changes on these drawings do not consist of
materially altered changes to approved drawings
and don't require a change order.
OSHPD review ACO
OSHPD review FLSO
OSHPD review DSE

REVISIONS

02/13/11 CO #300

APPROVAL

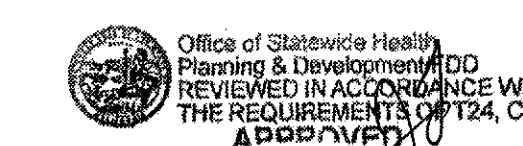

CHANGE ORDER
INSTRUCTION BULLETIN
DEFERRED APPROVAL
ADDENDUM

PROJECT NAME PAD 2011-02398

CHILDREN'S HOSPITAL
OF ORANGE COUNTY

455 S. Main St.
Orange, CA 92668-3874

TOWER II Received
June 05 2012
McCarthy



PROJECT NUMBER

12011.00
Increment #7

OSHPD - PROJECT NUMBER
IL 072072-30

ISSUE
OSHPD PERMIT

DATE
01/27/2010

SCALE


1/16 = 1'-0"

DRAWING TITLE

LEVEL 4 FLOOR PLAN


DRAWING NUMBER

A3.41

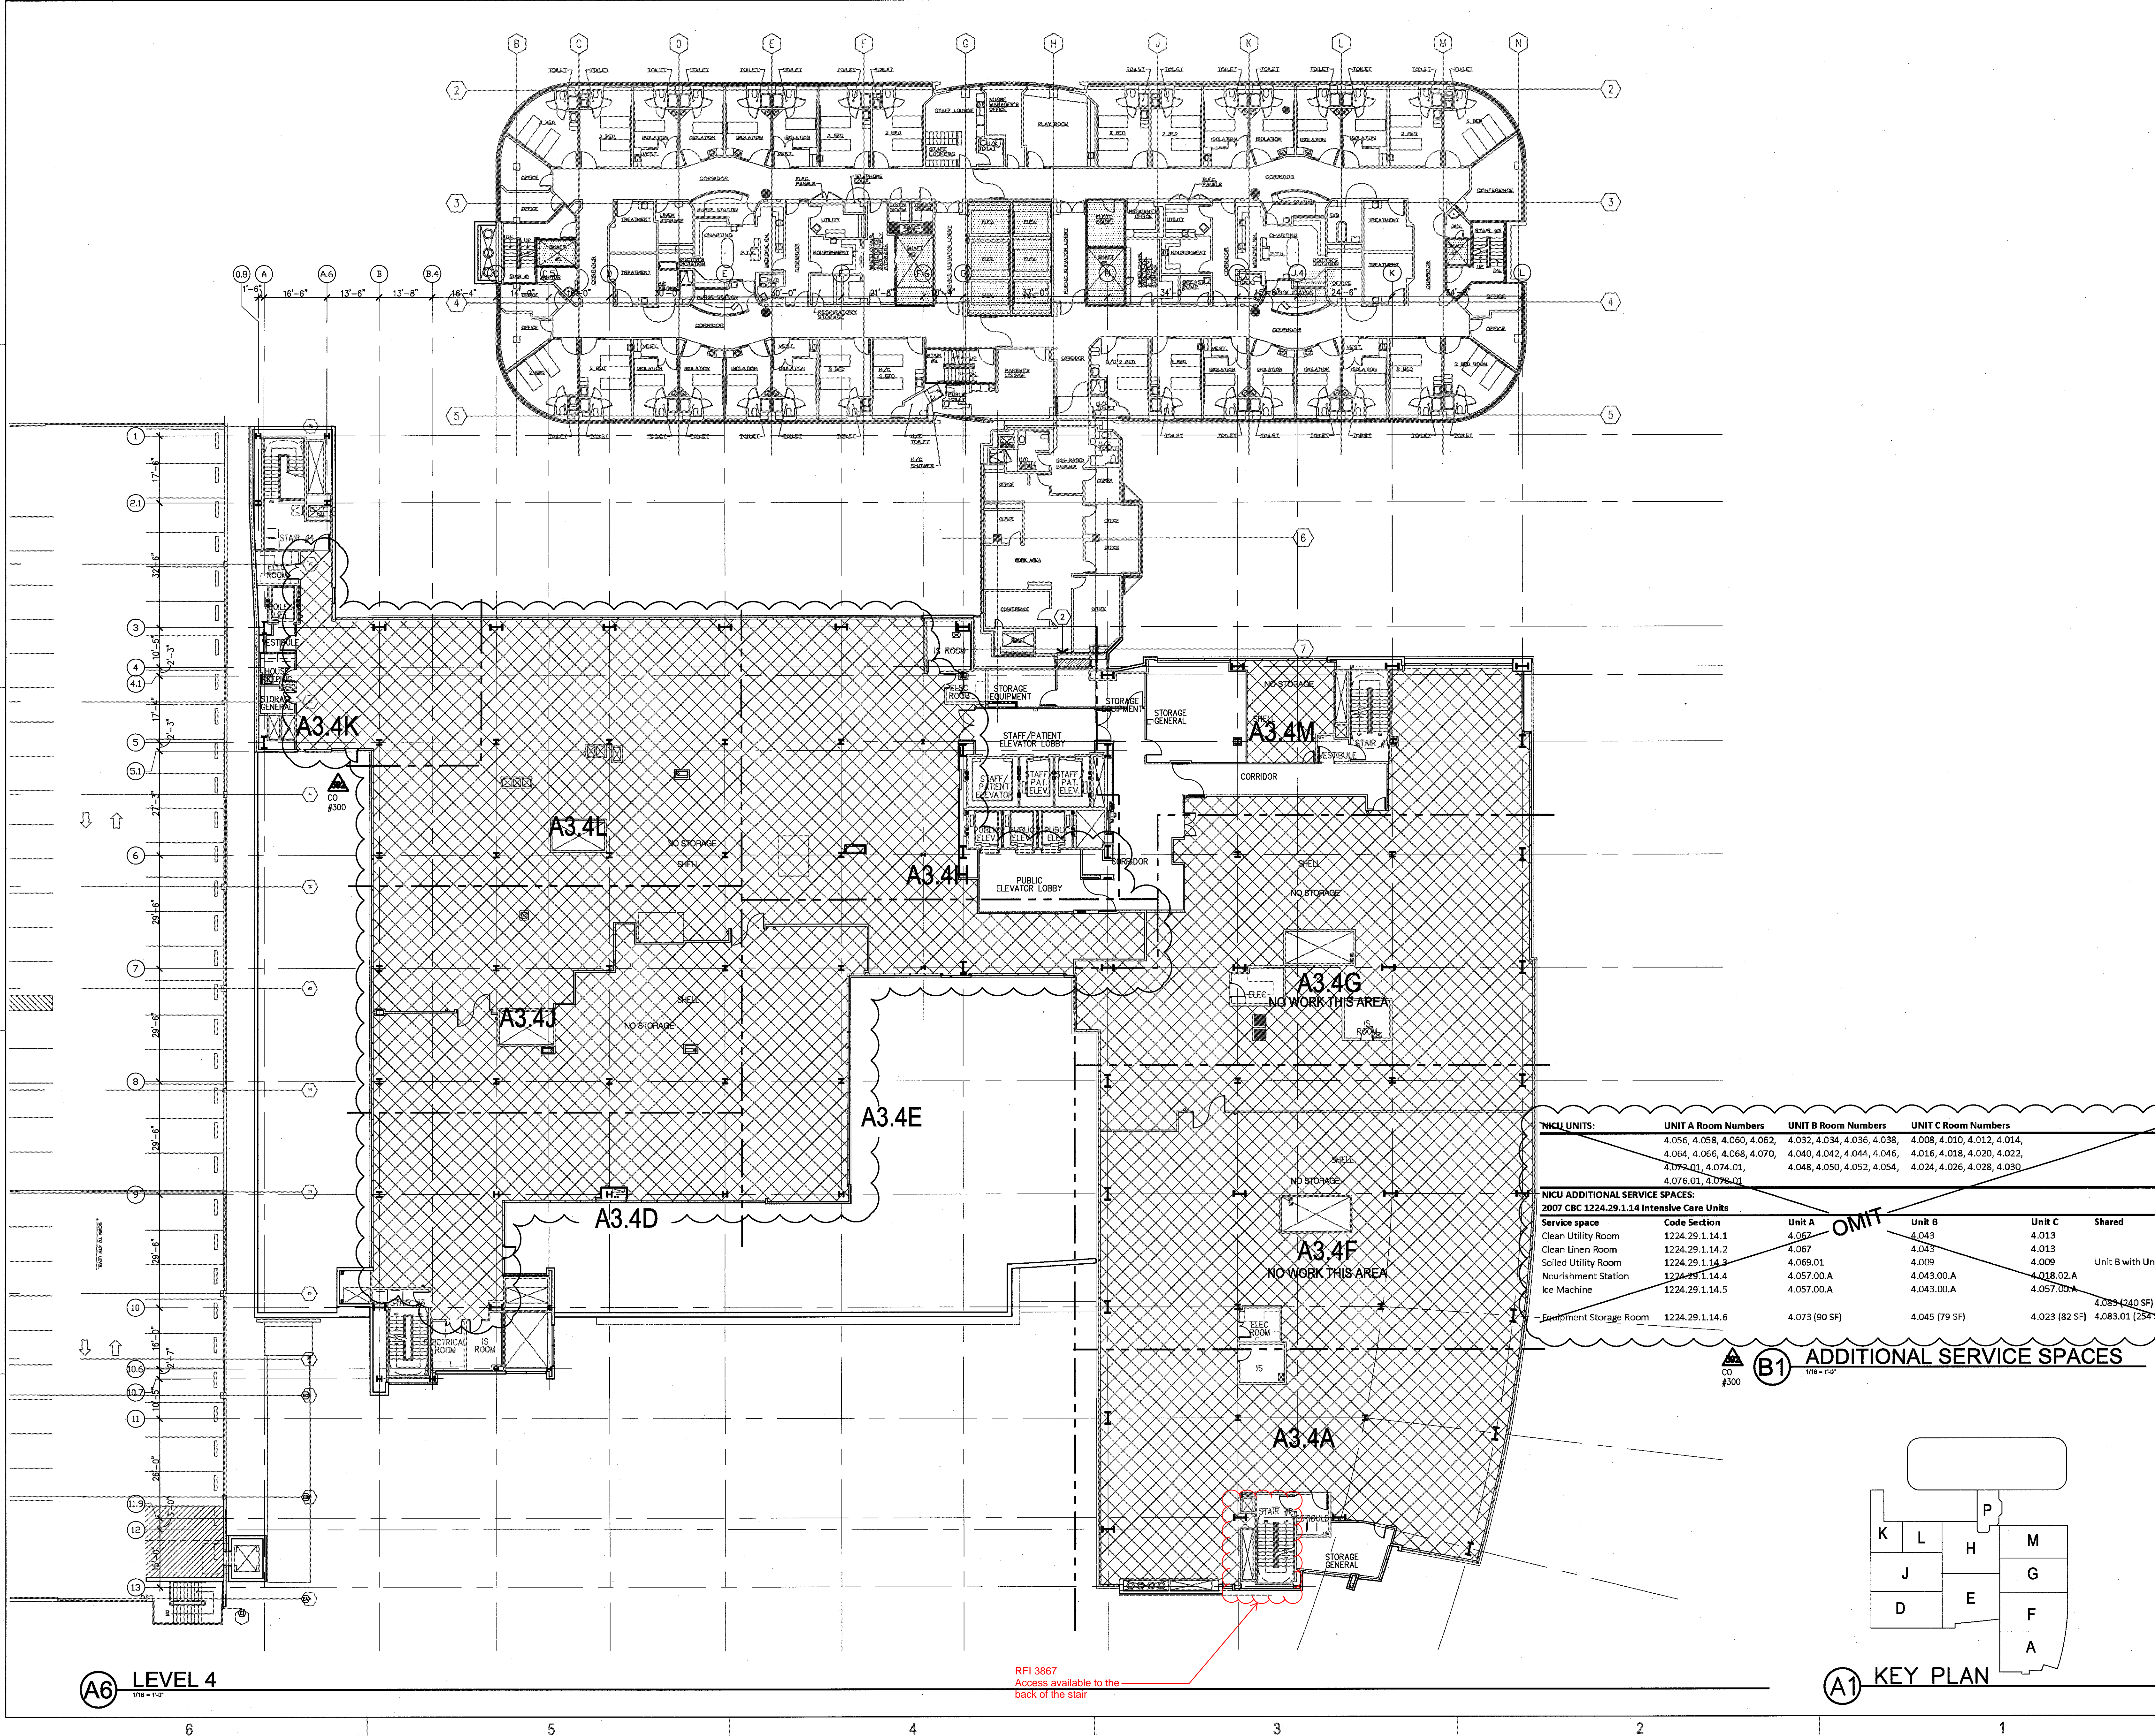

NICU UNITS:		UNIT A Room Numbers	UNIT B Room Numbers	UNIT C Room Numbers	
		4.056, 4.058, 4.060, 4.062, 4.064, 4.066, 4.068, 4.070, 4.072-01, 4.074-01, 4.076-01, 4.078-01	4.032, 4.034, 4.036, 4.038, 4.040, 4.042, 4.044, 4.046, 4.048, 4.050, 4.052, 4.054	4.008, 4.010, 4.012, 4.014, 4.016, 4.018, 4.020, 4.022, 4.024, 4.026, 4.028, 4.030	
NICU ADDITIONAL SERVICE SPACES:					
2007 CBC 1224.29.1.14 Intensive Care Units					
Service space	Code Section	Unit A	Unit B	Unit C	Shared
Clean Utility Room	1224.29.1.14.1	4.067	4.043	4.013	
Clean Linen Room	1224.29.1.14.2	4.067	4.043	4.013	
Soiled Utility Room	1224.29.1.14.3	4.069.01	4.009	4.009	Unit B with Unit C
Nourishment Station	1224.29.1.14.4	4.057.00.A	4.043.00.A	4.018.02.A	
Ice Machine	1224.29.1.14.5	4.057.00.A	4.043.00.A	4.057.00.A	
Equipment Storage Room	1224.29.1.14.6	4.073 (90 SF)	4.045 (79 SF)	4.023 (82 SF)	4.083.01 (254 SF)

(B1) 1/16 = 1'-0" ADDITIONAL SERVICE SPACES

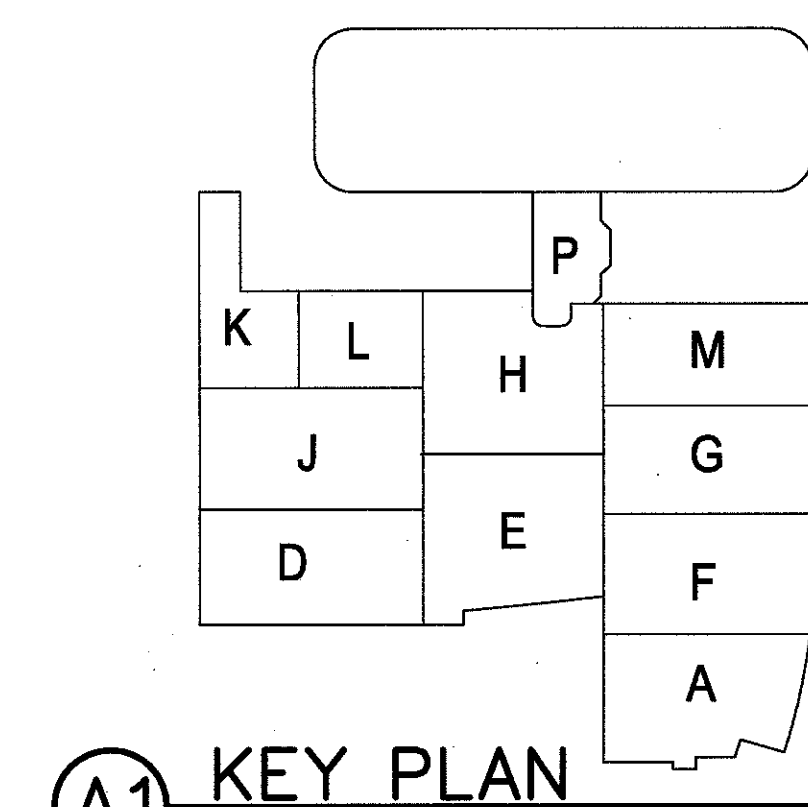

(A1) KEY PLAN

(A6) LEVEL 4
1/16 = 1'-0"

RFI 3867
Access available to the
back of the stair

N:\V0600\06102 CHOC TOWER 2 SHELL BUILDING\PROJECT INCREMENTS\INC. #7_TENANT IMPROVEMENT\OSHPD PERMIT (CONSTRUCTION DOCUMENTS)\V06002_CO#_A3.41 LEVEL 4 FLOOR PLAN.DWG
12/5/2011
GEORGIA