


FKP Architects

ARCHITECT OF RECORD

Paul C. Gloriod

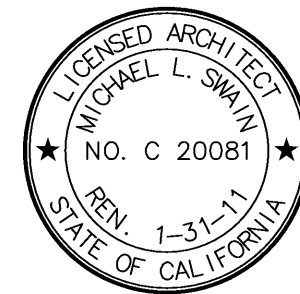

REVISIONS

| NO. | DATE | DESCRIPTION |
|-----|----------|-------------------------|
| 1 | 02/05/10 | INFORMATION BULLETIN #5 |
| 2 | 05/28/10 | ASI #08 |

APPROVAL

PROJECT NAME

CHILDREN'S HOSPIT.
OF ORANGE COUNT

455 S. Main St.
Orange, CA 92868-3874

TOWER II



PROJECT NUMBER

12011.00
Increment #7

OSHPD - PROJECT NUMBER

IL 072072-30

ISSUE

OSHPD PERMIT

DATE

01/27/2010

SCALE


1/4" = 1' - 0"

DRAWING TITLE

LEVEL 4 ENLARGED PLAN
AREA - A

DRAWING NUMBER

A3.4A

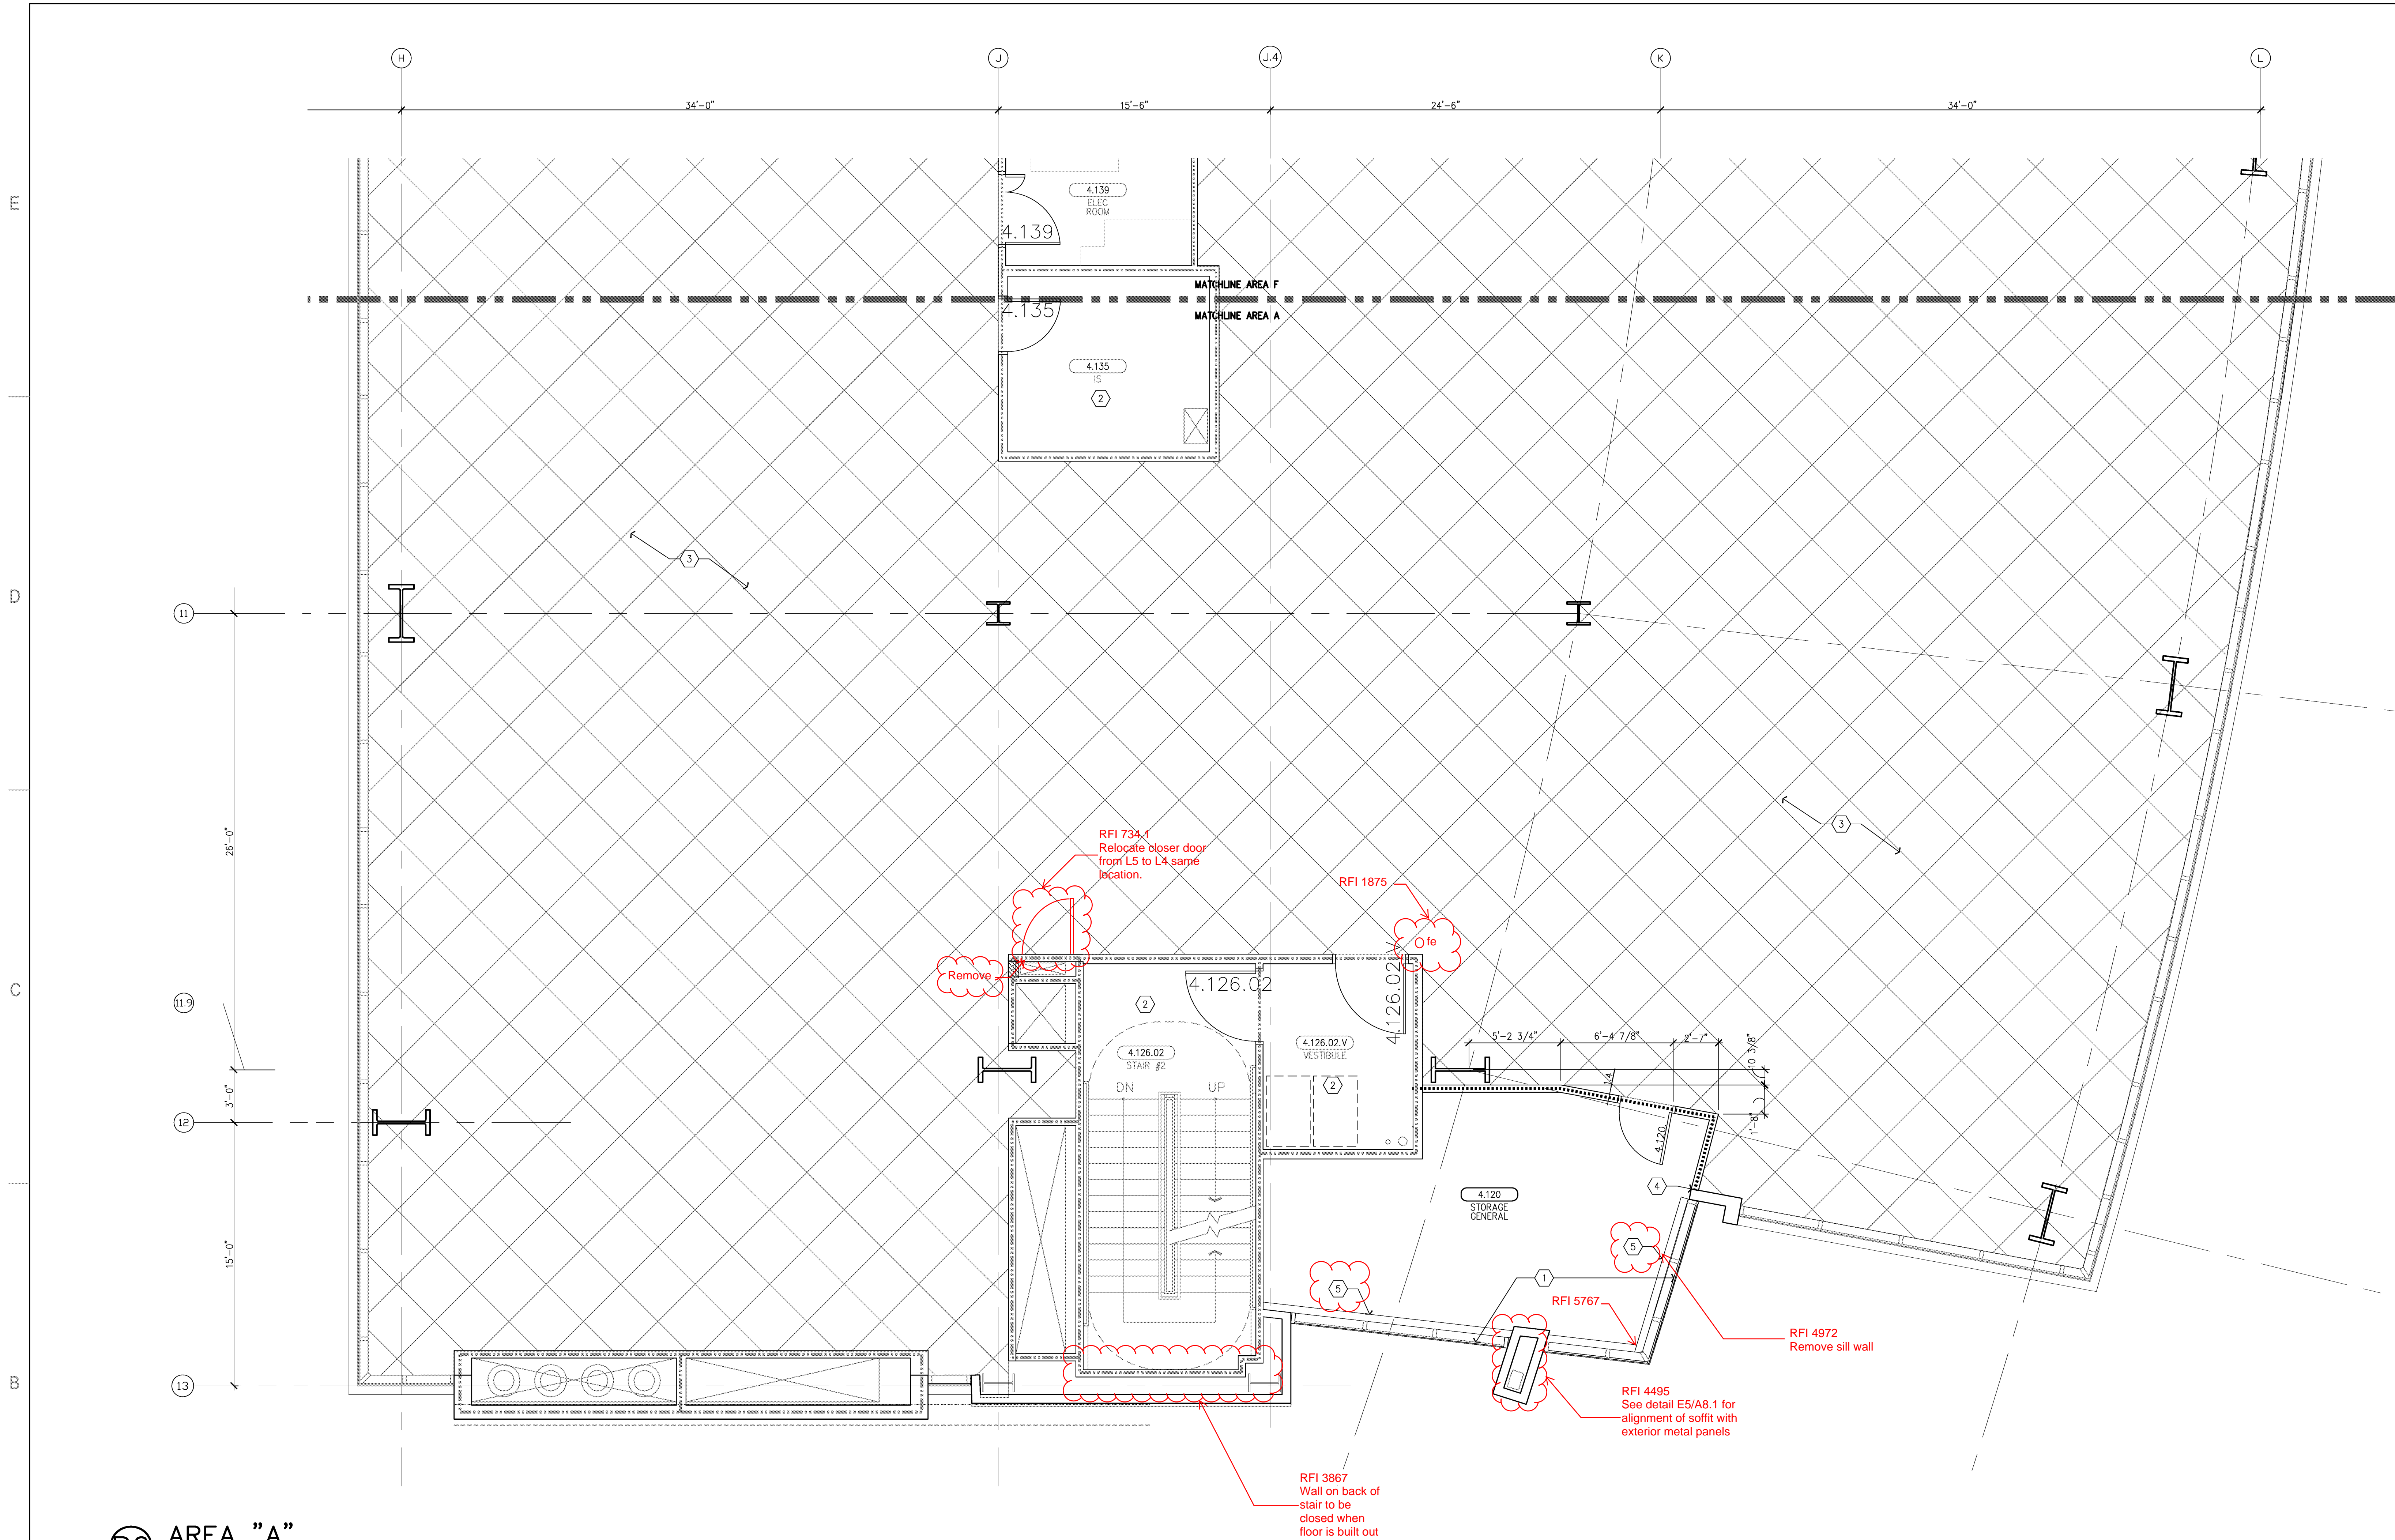

B6 AREA "A"
1/4" = 1'-0"

A6 NOTES TO SHEET

A5 GENERAL NOTE

A1 KEY PLAN

