


FKP Architects

ARCHITECT OF RECORD
Paul C. Gloriot

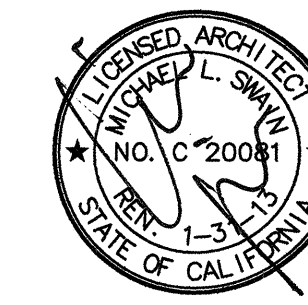

Changes on these drawings do not consist of materially altered drawings to approved drawings and don't require a change order.
OSHDP review ACO
OSHDP review FLSO
OSHDP review DSE

REVISIONS

44	05/28/10	ASI #08
49	02/13/11	CO #300
55	06/27/12	CO #383

OSHDP/DO-Field Review Tracking			
Project:	2012-06-17		
PAD:	4/1/12		
ACO:	4/1/12		
Architectural:	A	AC	D X Refer
Mechanical:	A	AC	D X Refer
Electrical:	A	AC	D X Refer
DSE:	A	AC	D X Refer
Structural:	A	AC	D X Refer
FLSO:	A	AC	D X Refer
Fire Life Safety:	A	AC	D X Refer

APPROVAL



CHANGE ORDER# 383
INSTRUCTION BULLETIN#
DEFERRED APPROVAL#
ADDENDUM

PROJECT NAME

CHILDREN'S HOSPITAL
OF ORANGE COUNTY
455 S. Main St.
Orange, CA 92668-3874

TOWER II



PROJECT NUMBER

12011.00
Increment #7

OSHDP - PROJECT NUMBER

IL 072072-30

ISSUE

OSHDP PERMIT

DATE

01/27/2010

SCALE

1/4" = 1' - 0"

DRAWING TITLE

LEVEL 4 ENLARGED PLAN
AREA - D

DRAWING NUMBER

A3.4D

M:\V0000\12011.00 CHOC TOWER II SHELL BUILDING\12011.00 CONTRACTED PROJECTS\PROJECT INCREMENTS\INCR_#07_TENANT IMPROVEMENT\OSHDP PERMIT (CONSTRUCTION DOCUMENTS)\100602_CO#_1\A3.4D.DWG
6/29/2012
F.K.P.

