


FKP Architects

ARCHITECT OF RECORD

Paul C. Gloriot

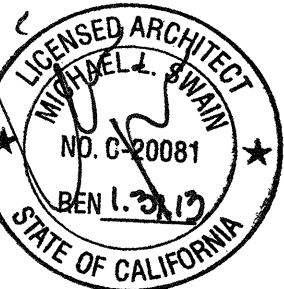


Changes on these drawings do not consist of material alterations to approved drawings and don't require a change order.
OSHPD review ACO
OSHPD review FLSO
OSHPD review DSE

REVISIONS

1/2 08/08/11 CO #135

APPROVAL

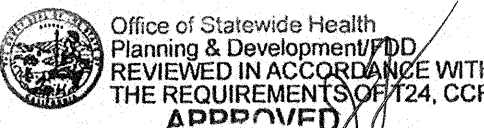

CHANGE ORDER #136
INSTRUCTION BULLETIN
DEFERRED APPROVAL #
VENDOR

PROJECT NAME

CHILDREN'S HOSPITAL
OF ORANGE COUNTY

455 S. Main St.
Orange, CA 92668-3874

TOWER II RECEIVED
SEPT. 21 2011
McCARTHY



PROJECT NUMBER

12011.00
Increment #7

OSHPD - PROJECT NUMBER

IL 072072-30

ISSUE

DATE

SCALE

1/16" = 1'-0"

DRAWING TITLE

LEVEL 5 FLOOR PLAN

DRAWING NUMBER

A3.51

