


FKP Architects

ARCHITECT OF RECORD  
Paul C. Gloriot

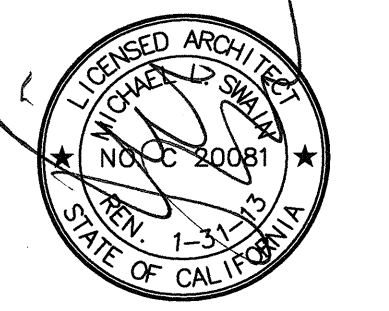


Changes on these drawings do not consist of  
materially altered changes to approved drawings  
and don't require a change order.  
OSHPD review ACO  
OSHPD review FLSO  
OSHPD review DOE

REVISIONS

|    |          |         |
|----|----------|---------|
| 44 | 05/28/10 | ASI #08 |
| 53 | 11/02/11 | CO#264  |

PAO-2011-02522

APPROVAL

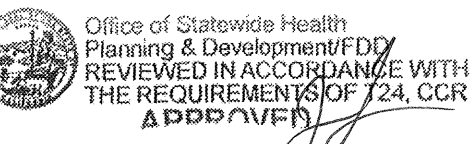

CHANGE ORDER 264  
INSTRUCTION BULLETIN  
DEFERRED APPROVAL  
ADDENDUM

PROJECT NAME  
**CHILDREN'S HOSPITAL  
OF ORANGE COUNTY**  
455 S. Main St.  
Orange, CA 92668-3874

TOWER II



PROJECT NUMBER

12011.00  
Increment #7

OSHPD - PROJECT NUMBER  
IL 072072-30

ISSUE  
OSHPD PERMIT

DATE  
01/27/2010

SCALE


1/4" = 1' - 0"

DRAWING TITLE

LEVEL 5 ENLARGED PLAN  
AREA - G

DRAWING NUMBER

A3.5G

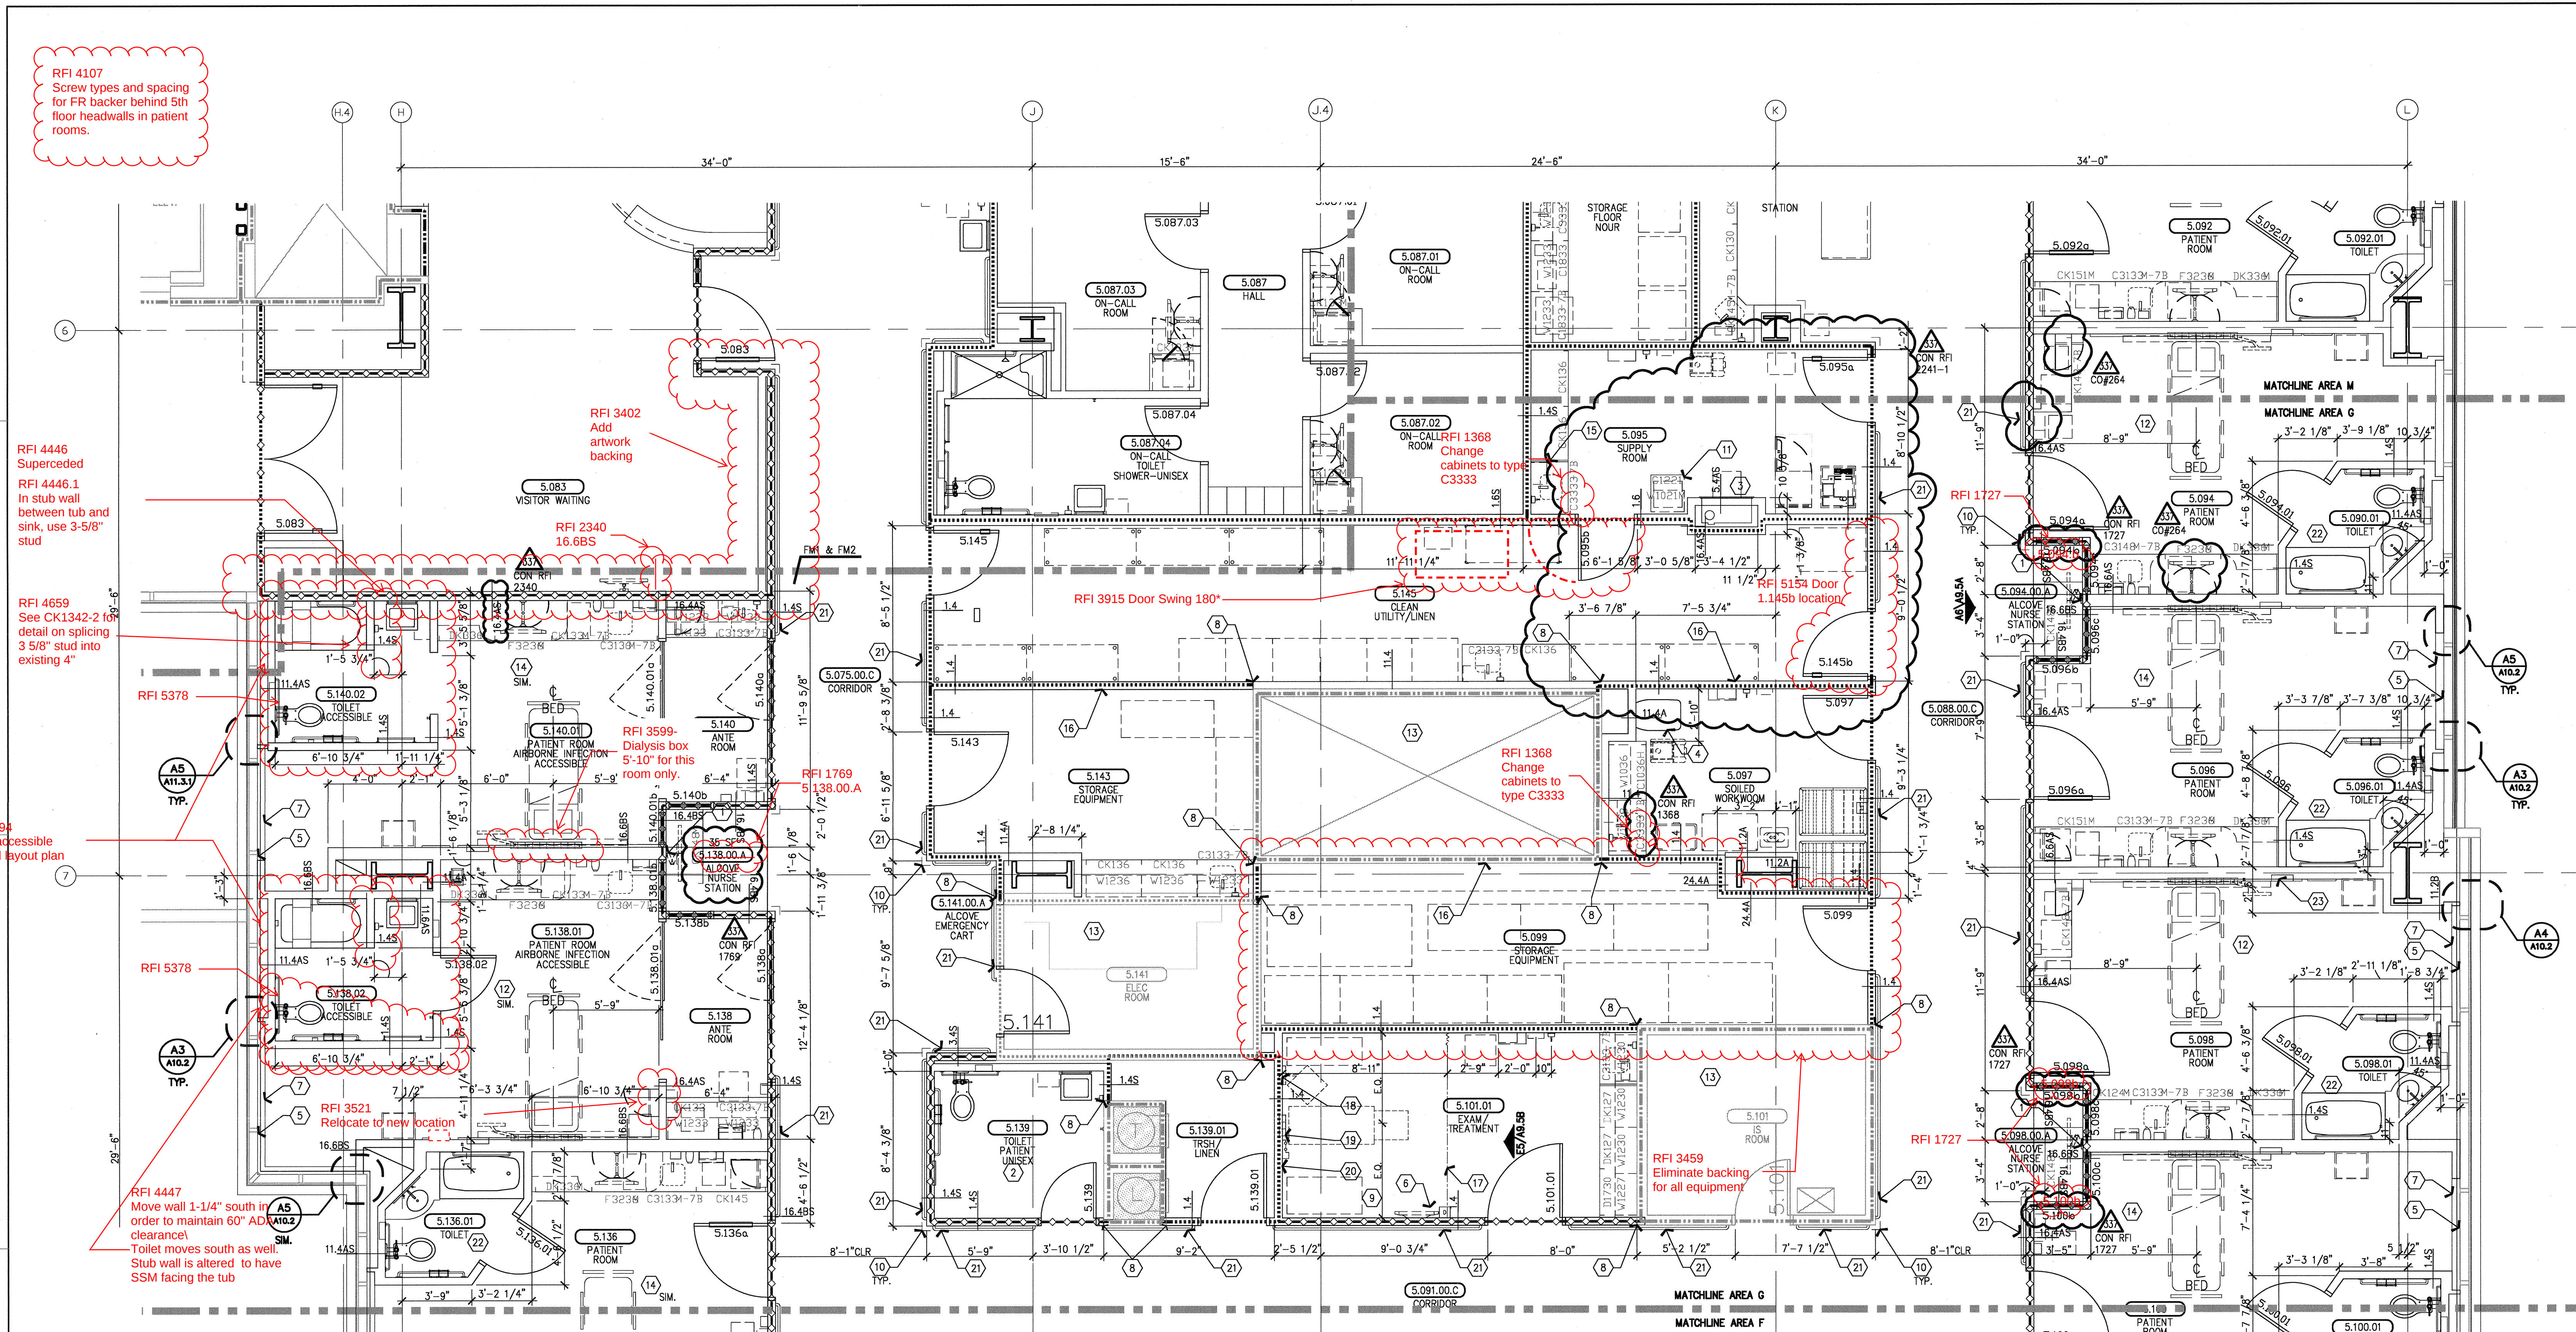


B6 AREA G  
1/4" = 1' - 0"

1. PC monitor, wall mounted. See Equipment drawings and workbook.
2. Accessible toilet room. See typical plan detail B5/A11.7.
3. Pneumatic tube station.
4. Clinical sink. See Plumbing drawings.
5. Window treatment, manual roller window shades, typical all exterior glazing.
6. Nurse call, duty station.
7. Sill wall, 2'-10" A.F.F., typical. See C5/A10.1 for detail.
8. Align finish face of partitions.
9. Reception, see Equipment drawings and workbook.
10. Corner guard, high impact plastic, typical. See B4/A11.8 for detail.
11. Upper shelf, modified to integrate with 2 med. cassettes.
12. See room 5.122 on Sheet A3.5A for typical note designations.
13. For construction requirements this area, see Increment 6, Vol. 2A & 2B.
14. See room 5.124 on Sheet A3.5A for typical note designations.
15. Splash guard.
16. Electrical power strip @ 24" & 48" A.F.F. See Electrical drawings.
17. Cubicle curtain, ceiling mounted.
18. Physiological monitor, wall mounted. See Equipment drawings and workbook.
19. Medical gas outlet. See Plumbing drawings.
20. TV monitor, wall mounted. See Equipment drawings and workbook and D4/S3.4.
21. Handrail/crashrail. See detail B4/A11.8.
22. See enlarged plan A3/A3.5A for typical note designations.
23. Dialysis drain, see Plumbing drawings. Locate center-line of DB-1 with center-line of tub wall in the room behind.


A6 NOTES TO SHEET

- A. Information shown or referenced on enlarged and/or 1/4" scale drawings will generally not be shown on the smaller scale drawings.
- B. Partition types are scheduled on plans by number. See the "General Notes to Partition Types" on B2/A11.3 and Partition Types on Sheet A11.3.1, A11.3.1, and A11.3.2 for the definition of partition type references.
- C. Field coordinate all field routed pipe, conduit runs, etc., with locations of recessed accessories and equipment. In the event of a conflict, accessory locations take precedence.
- D. Close all joints between plumbing fixtures/accessories and dissimilar materials w/sealant (i.e. between sinks and countertops, toilet fixtures and accessories to wall, etc.).
- E. Cabinet numbers noted on enlarged plans refer to Cabinet component numbers, fixtures, accessories, etc. that are defined or elevated on Sheet A3.0 unless specific detail references are keyed.
- F. Plan dimensions - refer to B2/A11.3 (General Notes).
- G. For vertical mounting heights of shower accessories, see Detail D6/A11.7.
- H. For vertical mounting heights of typical toilet stall accessories, see Detail A4/A11.7.
- I. For vertical mounting heights of accessible toilet stall accessories, see Detail A5/A11.7.
- J. For vertical mounting heights of typical restroom accessories, see Detail B6/A11.7.
- K. For vertical mounting heights of accessible accessories at restrooms, see Detail A6/A11.7.
- L. For equipment not identified on plan, see Equipment drawings and workbook-Increment#7, Vol. 2E.
- M. For partial enlarged plan at janitor closets, see Detail A3/A11.7.
- N. Public/handicapped restroom graphics will be furnished and installed by the Owner's graphics supplier.
- O. Standard equipment wall mounting heights, see detail A2/A11.9.
- P. Medical equipment wall mounting heights, see details A4/A11.9, D3/A11.9 & D0.02-Increment #7, Vol. 2E.
- Q. Fire Protection equipment wall Mounting Heights, see detail D2/A11.9.
- R. Communication equipment wall Mounting Heights, see detail A3/A11.9.
- S. Equipment mounting heights at Countertops, see detail D3/A11.9.
- T. Equipment mounting heights at Desks, see detail A4/A11.9.
- U. A minimum head clearance of 8'-0" must be maintained at all points in stairways including stair and landing framing.
- V. For all dashed in equipment not identified, refer to ED drawing series-Increment #7, Vol. 2E and Equipment workbook. Specific items requiring structural support are cross referenced to structural support details via matrix shown on the Equipment drawings-Increment #7, Vol. 2E.
- W. All elevator hotel way entrance frames to have an embossed stainless steel graphic plaque with the floor landing number and Standard Braille markings for the blind. Conform to governing Accessibility codes and standards.
- X. All stair floor landings to receive stencil painted, semi-gloss enamel floor landing numerals 12" high adjacent to the door at 5'-0" AFF in a contrasting color to the scheduled wall color unless a graphic plaque is specifically detailed or noted.
- Y. Elevator Equipment wall mounting heights, see detail A6/A11.9 and B3/A11.9.
- Z. Doors, Frames, Sidelites and Windows: (See Door Schedule). See A11 sheet series.
- AA. Provide wall blocking/bracing for items weighing 200lbs or less. See A6/A11.3.1.
- BB. For personal effects storage unit types and sizes see A4/A11.8.
- CC. For typical equipment backing support, see A4/S11-Increment #5.
- DD. For boundaries of alternates and phasing, see the AP drawing series.
- EE. Provide 3" grommet, unless otherwise noted at 3'-0" O.C. maximum, field located at all electrical components at Nurses stations and Reception desks.
- FF. For vertical mounting heights of service accessories, see Detail A3/A11.7-Increment#7, Vol. 2E.
- GG. Provide access panels below the Patient Room countertops to serve as inspection ports for the Patient Room bathtubs.


A4 GENERAL NOTES

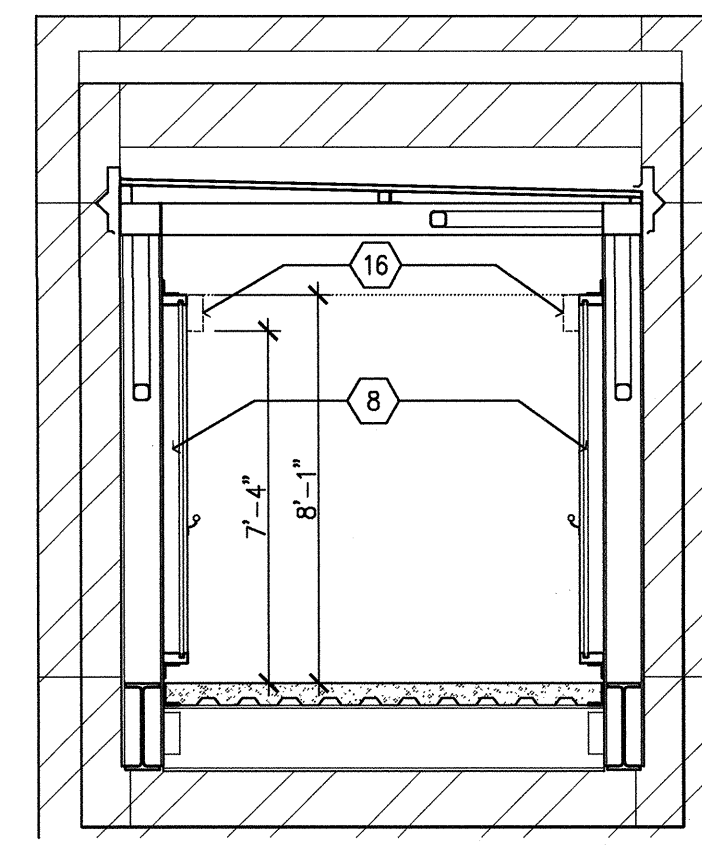

SEE A6/A3.2E FOR KEYNOTES

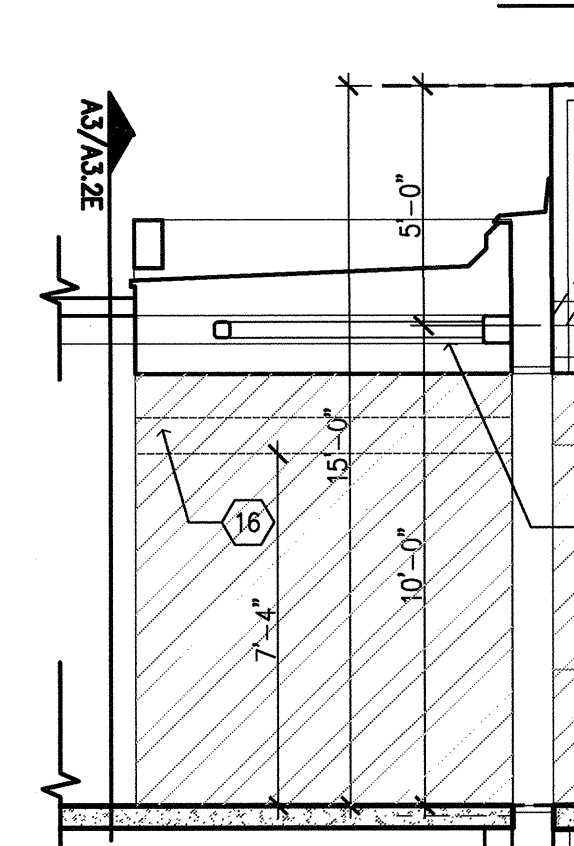

SEE A6/A3.2E FOR KEYNOTES

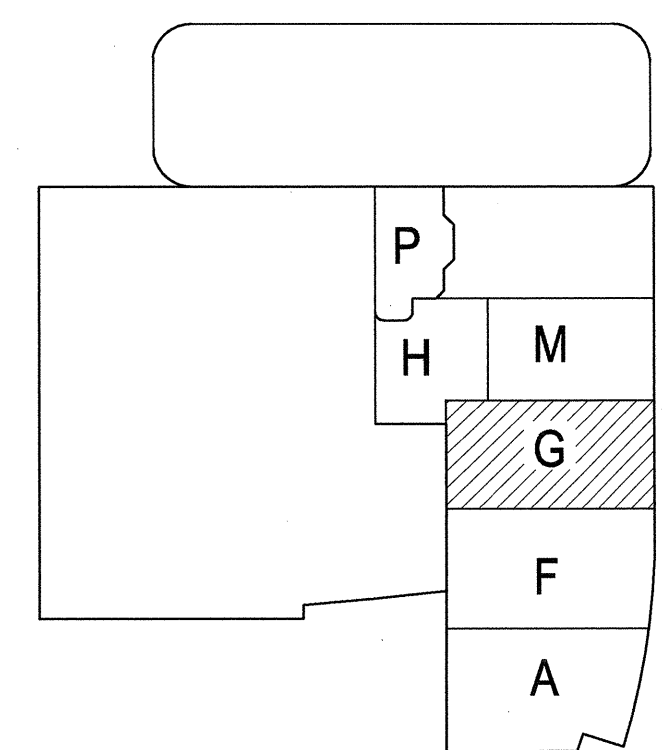

A1 KEY PLAN

RFI 2324  
Panels shall be 1'-3" AFF and 14"x14"

Note: RFI 318 changed WC-4 to WC-3 at non-ADA toilets. Locate WC-3 15" from wall.