


FKP Architects

ARCHITECT OF RECORD  
Paul C. Gloriod

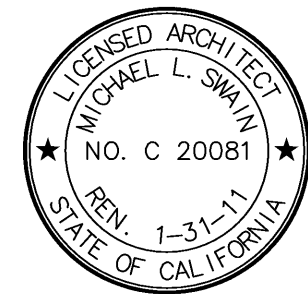

REVISIONS

02/05/10	INFORMATION BULLETIN #5
05/28/10	ASI #08

APPROVAL

PROJECT NAME  
**CHILDREN'S HOSPIT.  
OF ORANGE COUNT<sup>Y</sup>**  
455 S. Main St.  
Orange, CA 92868-3874

TOWER II



PROJECT NUMBER

**12011.00  
Increment #7**

OSHPD - PROJECT NUMBER  
**IL 072072-30**

ISSUE  
**OSHPD PERMIT**


DATE  
**01/27/2010**

SCALE  
**1/4" = 1' - 0"**

DRAWING TITLE  
**LEVEL 6 ENLARGED PLAN  
AREA - G**

DRAWING NUMBER

**A3.6G**

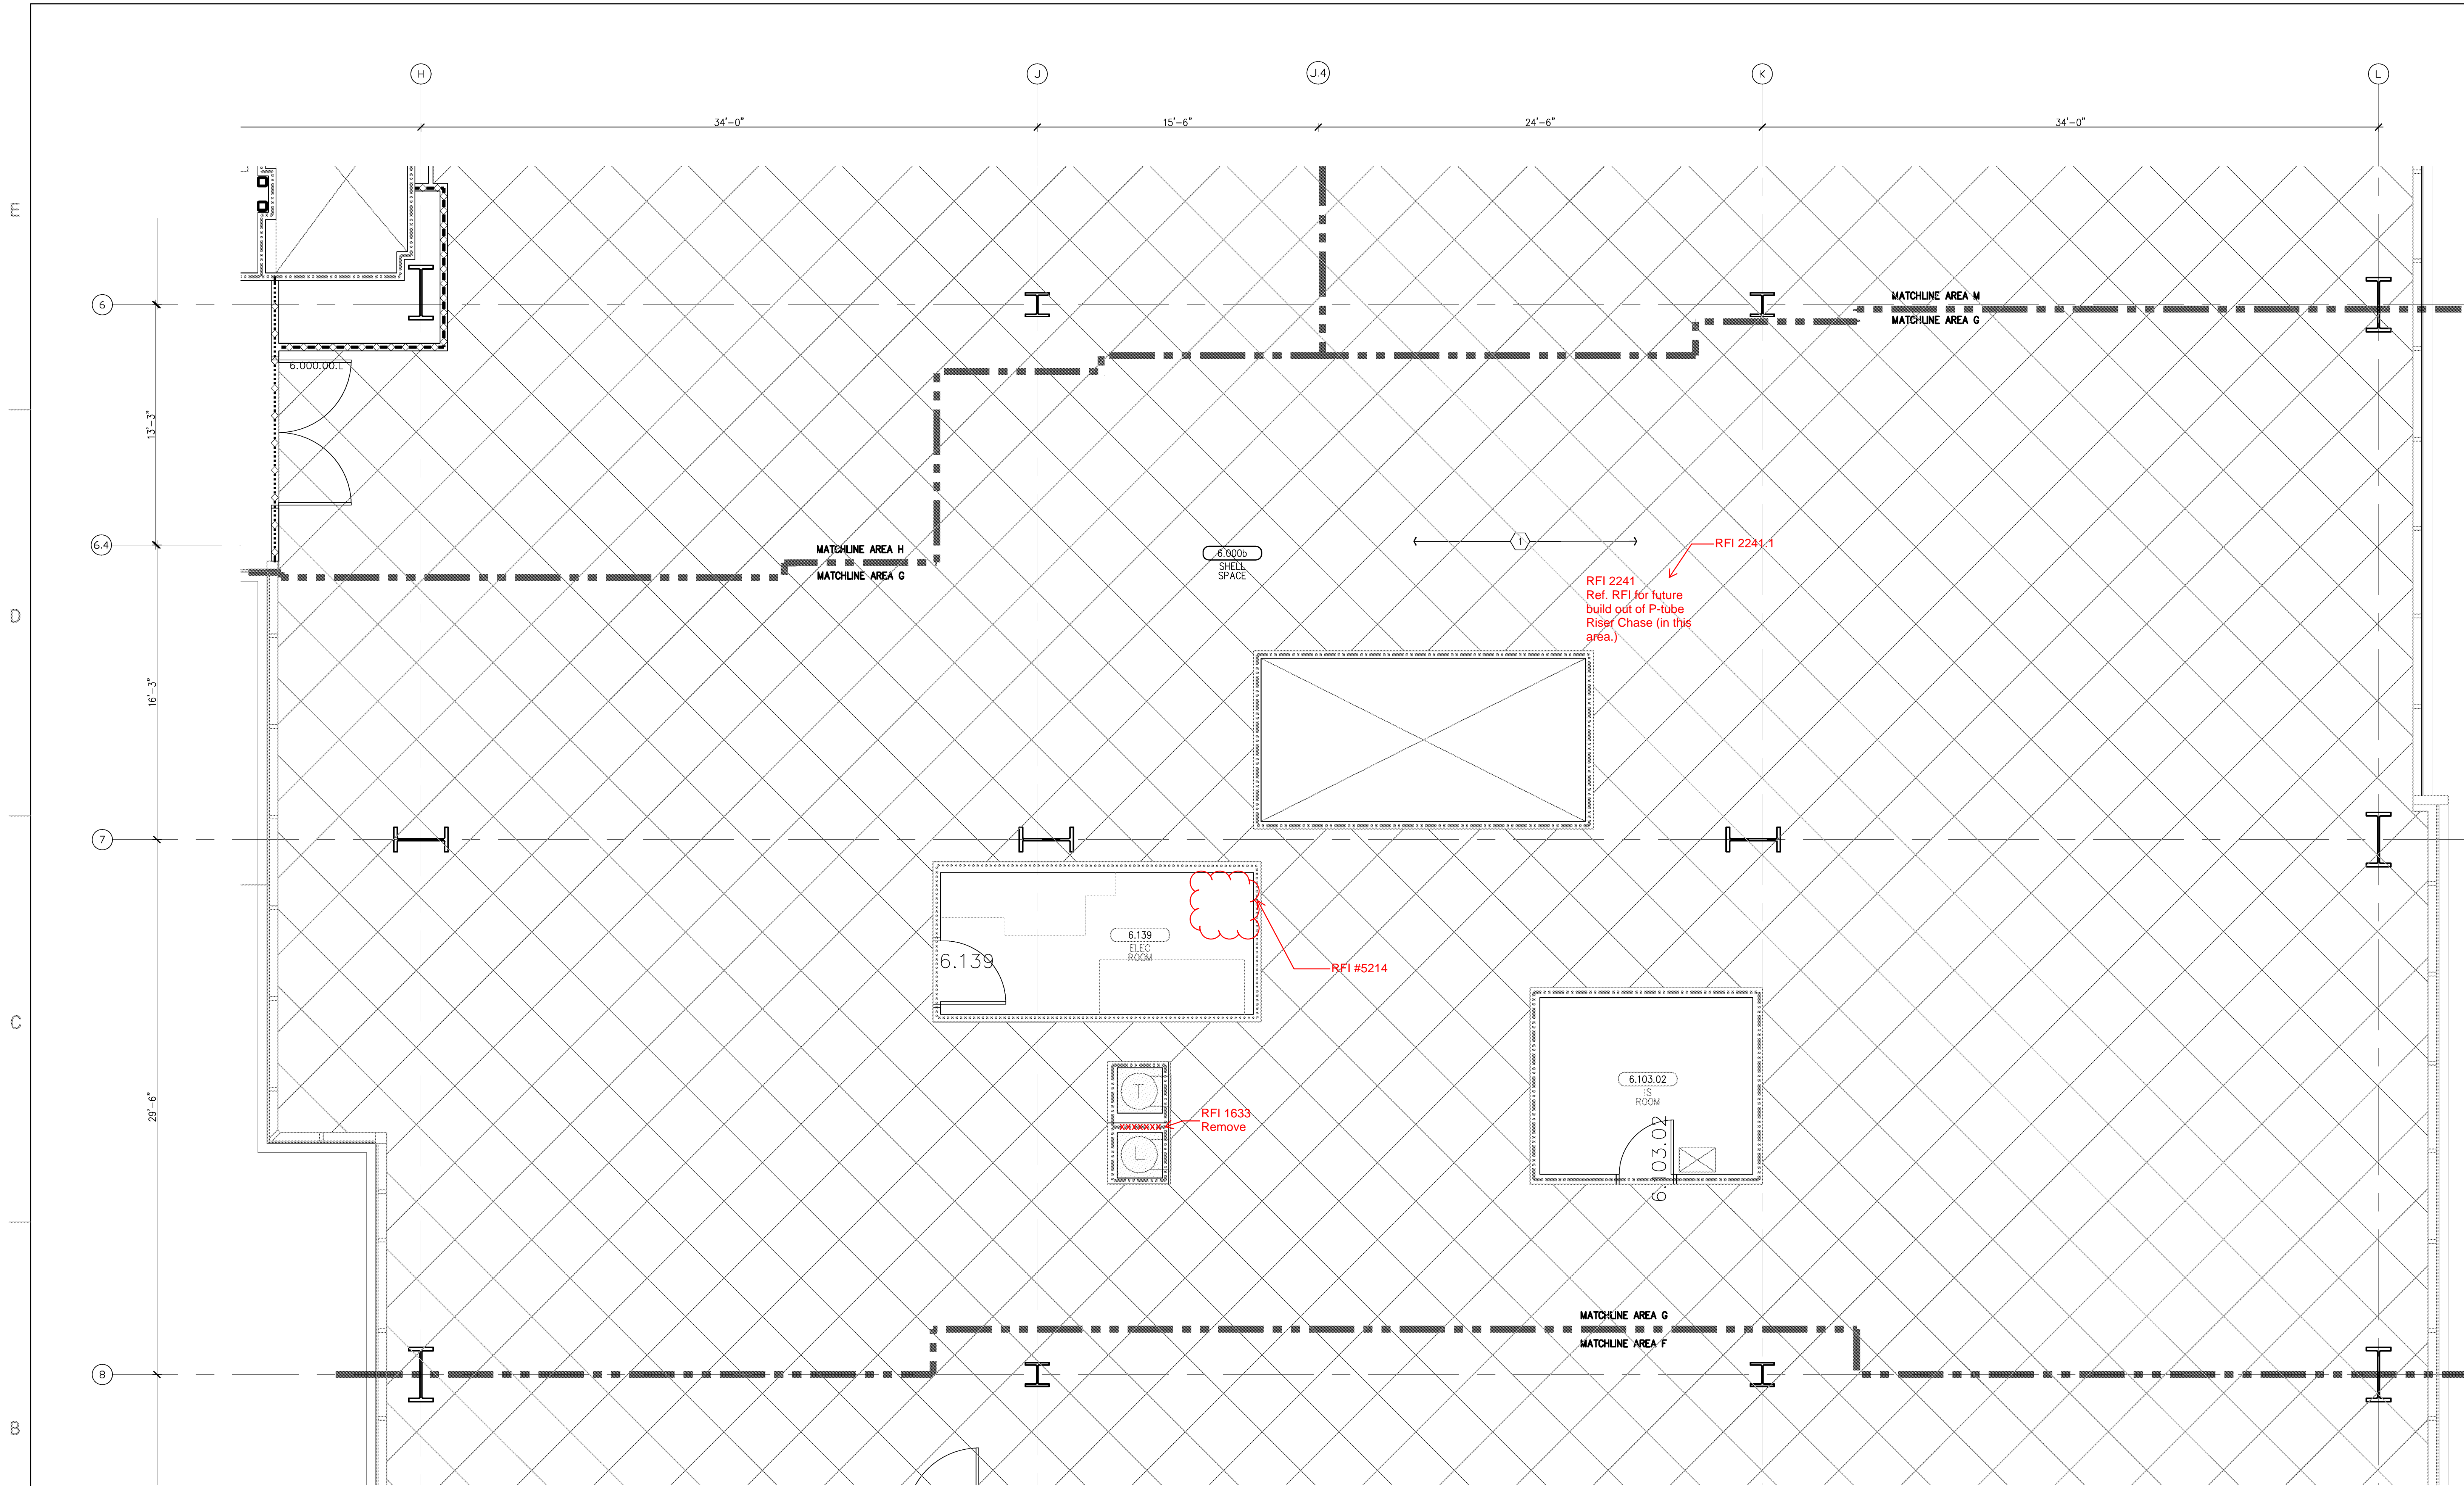

**B6 AREA "G"**  
1/4" = 1'-0"

1. Shell space for future expansion.

- A. Information shown or referenced on enlarged and/or 1/4" scale drawings will generally not be shown on the smaller scale drawings.  
B. Partition types are scheduled on plans by number. See the "General Notes to Partition Types" on B2/A11.3 and Partition Types on Sheet A11.3.1, and A11.3.2 for the definition of partition type references.  
C. Field coordinate all field routed pipe, conduit runs, etc., with locations of recessed accessories and equipment. In the event of a conflict, accessory locations take precedence.  
D. Close all joints between plumbing fixtures/accessories and dissimilar materials w/sealant (i.e. between sinks and countertops, toilet fixtures and accessories to wall, etc.)  
E. Cabinet numbers noted on enlarged plans refer to Cabinet component numbers, fixtures, accessories, etc. that are defined or elevated on Sheet A9.0 unless specific noted.  
F. For vertical mounting heights of typical toilet stall accessories, See Detail A4/A11.7.  
G. For vertical mounting heights of accessible toilet stall accessories, See Detail A5/A11.7.  
H. For vertical mounting heights of typical restroom accessories, See Detail B6/A11.7.  
I. For vertical mounting heights of accessible accessories at restrooms, See Detail A6/A11.7.  
L. For equipment not identified on plan, see Equipment drawings and workbook-Increment #7, Vol. 2E.

- M. For partial enlarged plan at janitor closets, See Detail A3/A11.7.  
N. Public/handicapped restroom graphics will be furnished and installed by the Owner's graphics supplier.  
O. Standard equipment wall mounting heights, see detail A2/A11.9.  
P. Medical equipment wall mounting heights, see details A4/A11.9, D3/A11.9 & Q1.02-Increment #7, Vol. 2E.  
Q. Fire Protection equipment wall Mounting Heights, see detail D2/A11.9.  
R. Communication equipment wall Mounting Heights, see detail A3/A11.9.  
S. Equipment mounting heights at Countertops, see detail D3/A11.9.  
T. Equipment mounting heights at Desks, see detail A4/A11.9.  
U. A minimum head clearance of 6'-8" must be maintained at all points in stairways including stair and landing flooring.  
V. For all cased in equipment not identified, refer to EQ drawing series-Increment #7, Vol. 2E and Equipment workbook. Specific items requiring structural support are cross referenced to structural support details via matrix shown on the Equipment drawings-Increment #7, Vol. 2F.  
W. All elevator hoist way entrance frames to have an embossed stainless steel graphic plaque with the floor landing number and Standard Braille markings for the blind. Conform to governing Accessibility codes and standards.  
X. All stair floor landings to receive stencil painted, semi-gloss enamel floor landing numerals 12" high adjacent to the door at 3'-0" AFF in a contrasting color to the scheduled wall color unless a graphic plaque is specifically detailed or noted.  
Y. Elevator Equipment wall mounting heights, see detail A6/A11.9 and B3/A11.9.  
Z. Doors, Frames, Sillings and Windows: (See Door Schedule). See A11 sheet series.  
AA. Provide wall blocking/backing for items weighing 20lbs or less. See A6/A11.3.1.  
BB. For personal effects storage unit types and sizes see A4/A11.8.  
CC. For typical equipment backing support, see A4/S1.1-Increment #5.  
DD. For boundaries of clienteltes and phasing, see the AP drawing series.  
EE. Provide 3" grommet, unless otherwise noted at 3'-0" O.C. maximum, field located at all electrical components at Nurses stations and Reception desks.  
FF. For vertical mounting heights of service accessories, See Detail A3/A11.7-Increment #7, Vol. 2E.  

**A6 NOTES TO SHEET**

**A5 GENERAL NOTES**

**A1 KEY PLAN**

