

FKP Architects


ARCHITECT OF RECORD

Paul C. Gloriod



REVISIONS

APPROVAL

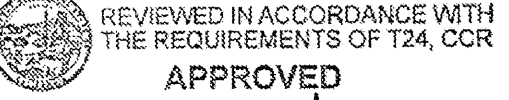

Office of Statewide Health
Planning & Development
FACILITIES DEVELOPMENT DIVISION

PROJECT NAME

CHILDREN'S HOSPITAL
OF ORANGE COUNTY

455 S. Main St.
Orange, CA 92868-3874

TOWER II



PROJECT NUMBER

12011.00
Increment #7

OSHPD - PROJECT NUMBER

IL 072072-30

ISSUE

OSHPD PERMIT

DATE

01/27/2010

SCALE


1/16" = 1'-0"

DRAWING TITLE

LEVEL 7 FLOOR PLAN

DRAWING NUMBER

A3.71

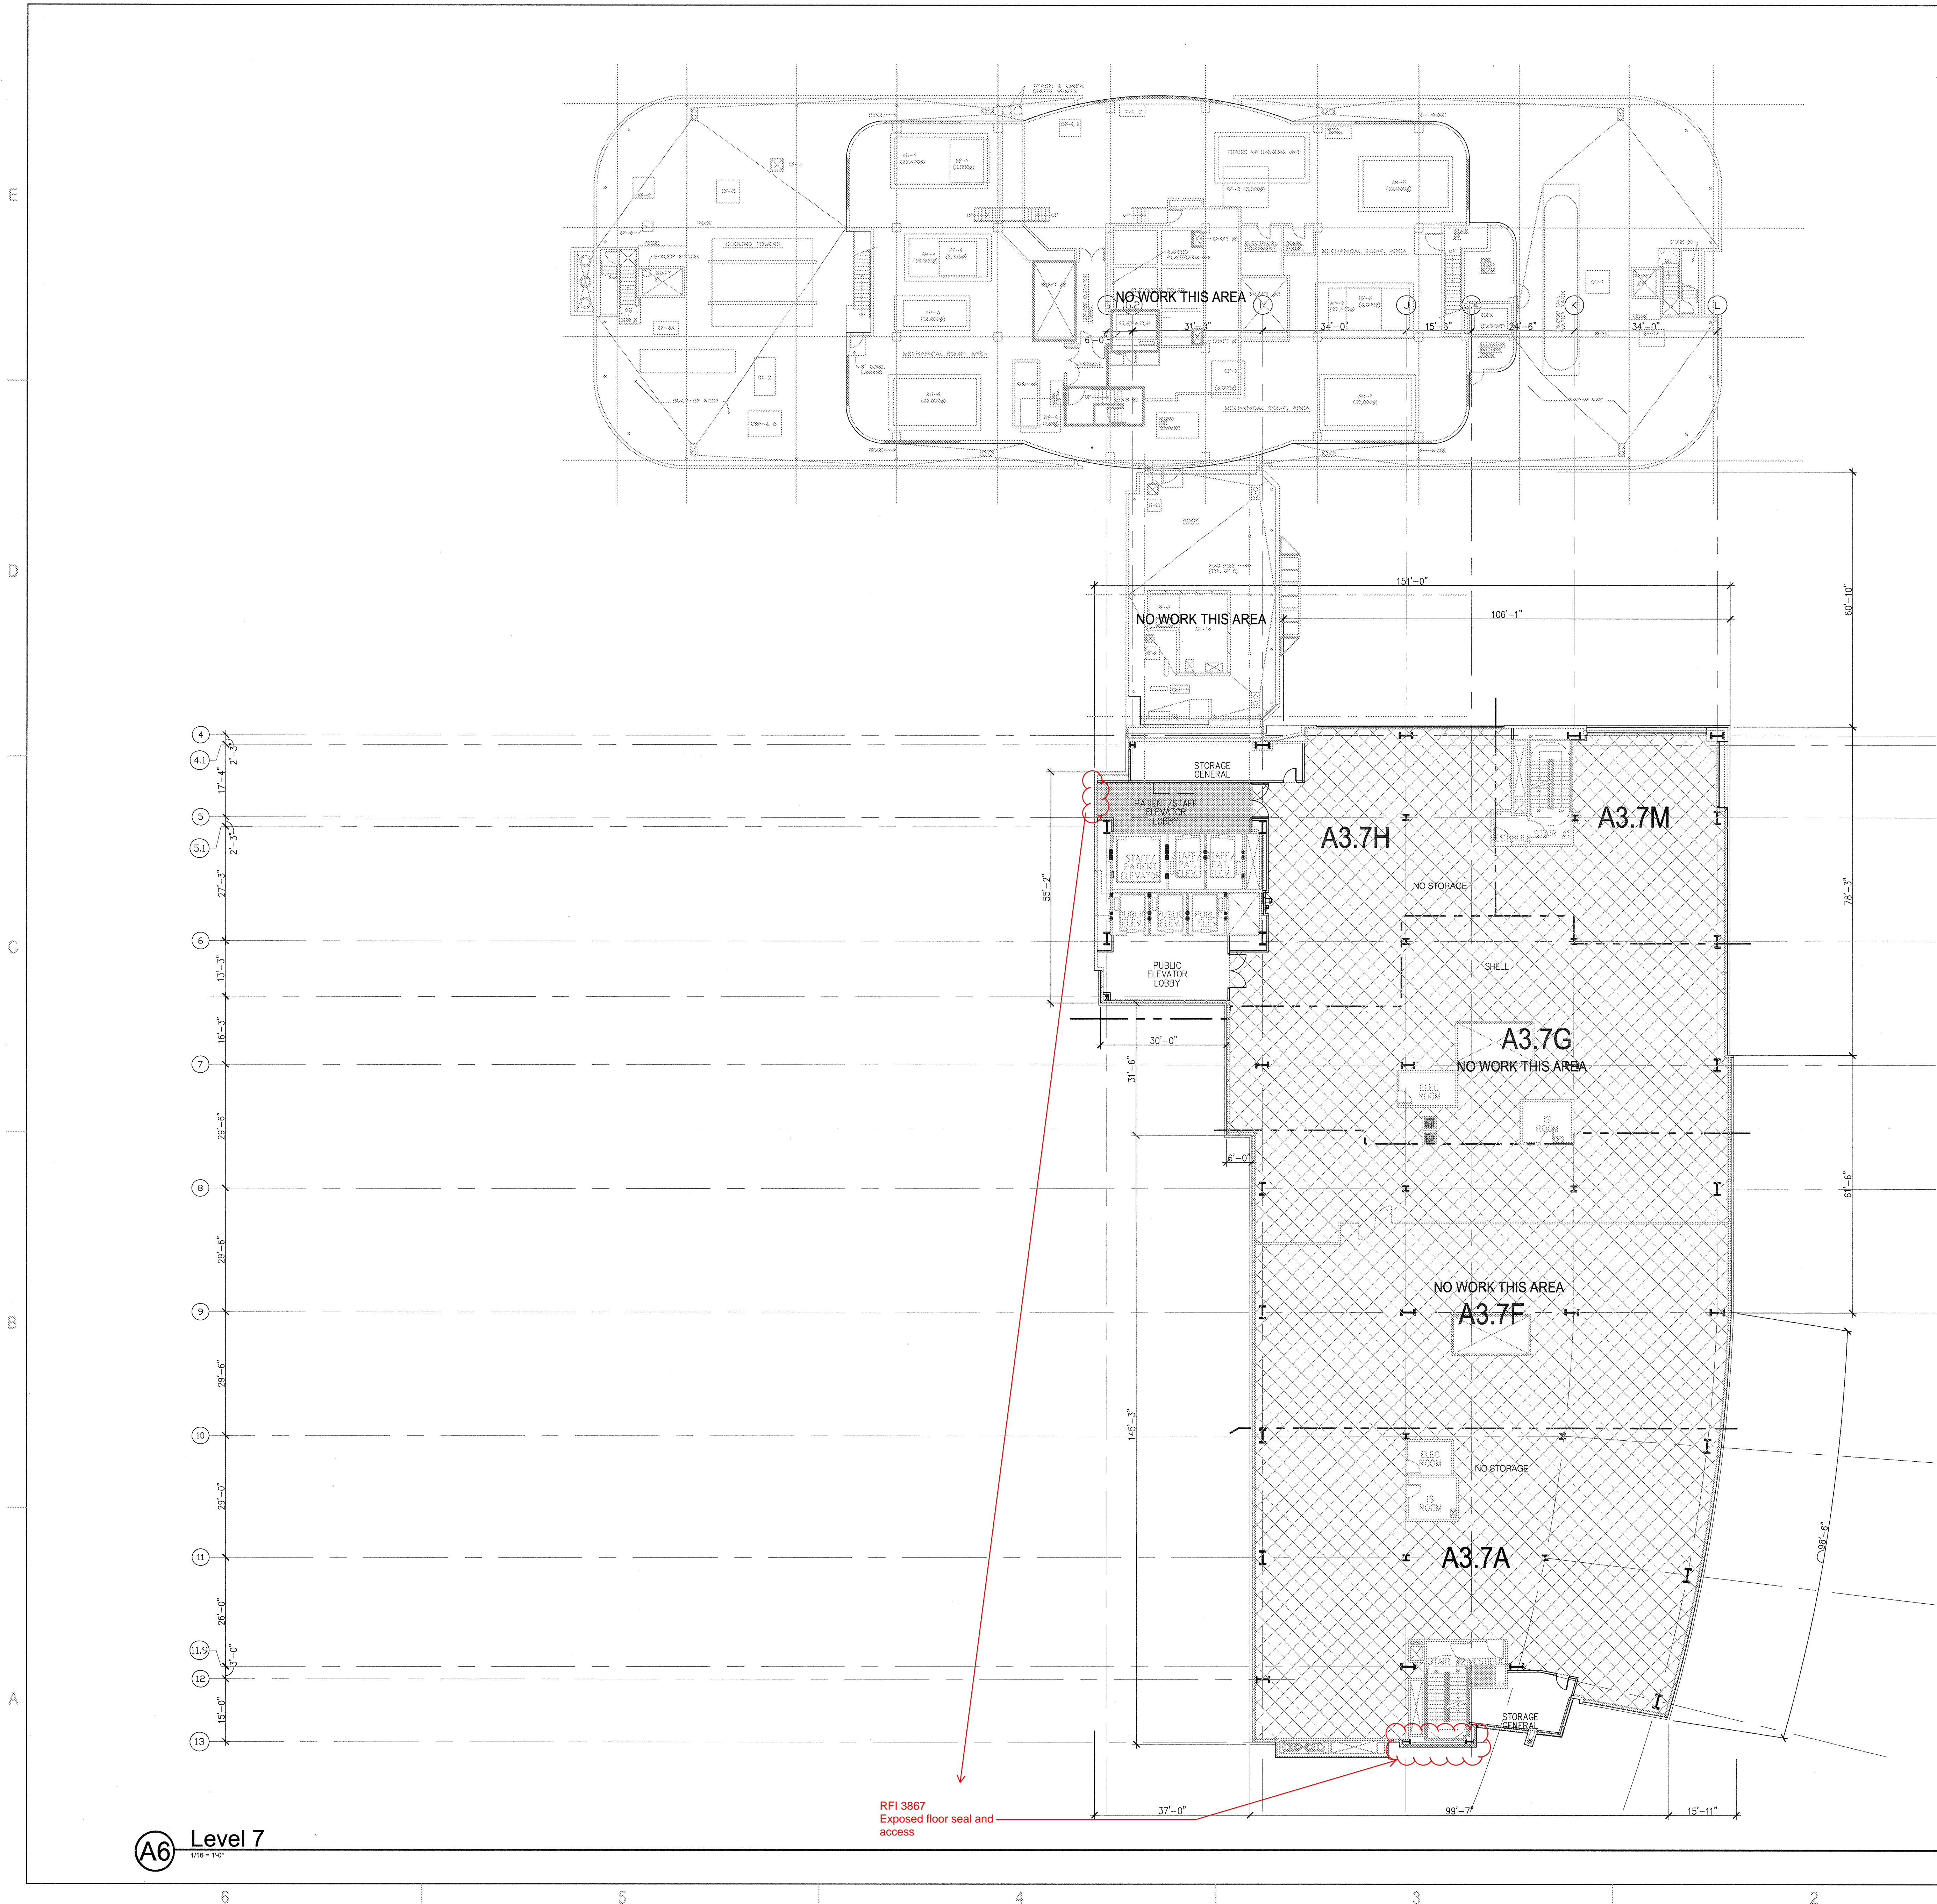

A6 Level 7
1/16" = 1'-0"

A1 KEY PLAN