


FKP Architects

ARCHITECT OF RECORD
Paul C. Gloriot

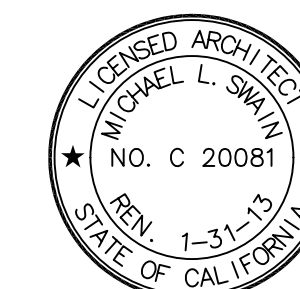

Changes on these drawings do not consist of
materially altered changes to approved drawings
and don't require a change order.
OSHPD review ACO _____
OSHPD review FLSO _____
OSHPD review DSE _____

REVISIONS

44	05/28/10	ASI #808
68	02/04/11	ASI #57
61	03/01/11	CO#134
840	09/05/11	CO#266
10	01/09/12	ASI #156

APPROVAL



CHANGE ORDER/INSTRUCTION BULLETIN/DEFERRED APPROVAL # _____
(PRELIMINARY)

PROJECT NAME

**CHILDREN'S HOSPITAL
OF ORANGE COUNTY**

455 S. Main St.
Orange, CA 92668-3874

TOWER II



PROJECT NUMBER

**12011.00
Increment #7**

OSHPD - PROJECT NUMBER

IL 072072-30

ISSUE

OSHPD PERMIT

DATE

01/27/2010

SCALE

1/8" = 1' - 0"

DRAWING TITLE

**LEVEL 2
REFLECTED
CEILING PLAN
AREA - A**

DRAWING NUMBER

A4.2A


- LASER -- IN USE LIGHT
- EXIT LIGHT FIXTURE
- RECESSED COMPACT FLUORESCENT DOWN LIGHT
- RECESSED COMPACT FLUORESCENT DIRECTIONAL SPOT LIGHT
- RECESSED LED DOWN LIGHT, WALL WASH TRIM, JUNO
- WALL MOUNTED LIGHT FIXTURE
- RECESSED COMPACT FLUORESCENT DOWN LIGHT WITH DIMMER
- RECESSED EXAM LIGHT, W/ WALL MOUNTED CONTROLS
- LOUIE LIGHTING, SD-888 RECESSED LIGHT
- RECESSED FIXTURE, P-8900, PRUDENTIAL LIGHTING
- LOUIS POULSEN, COLLAGE PENDANT
- PENDANT FIXTURE, QUEENY DOWN II, BRUCK
- BOYD, 9955 ARCHETYPE PENDANT, DIMMING SATIN NICKEL
- BOYD, 10217 CATACAOS PENDANT (30"), DIMMING SATIN NICKEL
- CORELITE, VERTECH 278 4' SUSPENDED DIRECT/INDIRECT LINEAR FIXTURE
- BOA CALO SWING SPOT, BRUCK, WITH V/A TRACK, BRUCK
- BRUCK LEDRA DISPLAY TRACK AND SPOT LIGHT
- COLOR KINETICS, ICOLOR FLEX SL, TRACK MOUNTING
- COLOR KINETICS, ICOLOR FLEX SL, STRING LIGHT
- INDIRECT COVE FIXTURE, P-59, PRUDENTIAL LIGHTING
- PERIMETER WALL WASHER W/ ACRYLIC LENS / FOCUS 1, FOCAL POINT
- LED COVE LIGHT
- FLUORESCENT COVE LIGHT
- FLUORESCENT WITH FLUSH LENS, AVENUE b, FOCAL POINT
- EUREKA C49169 LIGHT FIXTURE
- CEILING MOUNTED NURSE CALL INDICATOR
- 4" x 2' FLUORESCENT WALL MOUNTED LIGHT FIXTURE
- RECESSED FLUORESCENT LIGHT FIXTURE
- 1' x 4' FLUORESCENT WALL MOUNTED LIGHT FIXTURE
- 1' x 4' FLUORESCENT UTILITY LIGHT FIXTURE
- 2' x 4' FLUORESCENT LIGHT FIXTURE WITH PARABOLIC LENS
- 2' x 4' FLUORESCENT LIGHT FIXTURE DIRECT/INDIRECT
- 2' x 4' FLUORESCENT LIGHT FIXTURE WITH PRISMATIC LENS
- MULTI FUNCTION PATIENT LIGHT FIXTURE
- SQUARE MECHANICAL GRILLES
- LINEAR MECHANICAL GRILLES
- PLASTER CEILING
- METAL PANEL SOFFIT
- GYPSON BOARD CEILING
- OVERHEAD CABLE, TRAY-- SEE 15.13A FOR DETAIL
- 2' x 2' SUSPENDED ACOUSTICAL TILE
- FLUORESCENT STRIP FIXTURE
- 7" x 8' 'GAMMALUX' WALL MOUNTED LIGHT FIXTURE
- BUTTERFLY SPOT, BRUCK, WITH ENZIS TRACK
- MANUAL ROLLER SHADE WITH POCKET (STD. HEADBOX)
- MANUAL ROLLER SHADE WITH FASOIA / VALENCE

C1 Legend

- REFER TO "FINISH SCHEDULE" FOR FURTHER DEFINITION OF CEILING MATERIALS AND FINISHES.
- CEILING HEIGHT WILL TYPICALLY BE [9'-0"] UNLESS OTHERWISE NOTED ON THE REFLECTED CEILING PLAN.
- LOCATE ALL CEILING MOUNTED SMOKE DETECTORS AND SPEAKERS IN THE CENTER OF FULL PANELS AT LAY-IN CEILINGS.
- LOCATE ALL SPRINKLER HEADS IN THE CENTER OF FULL PANELS AT LAY-IN CEILINGS. AT GYPSUM BOARD CEILINGS, SYMMETRICALLY SPACE HEADS AND CENTER ON LIGHT ROWS WHERE AREA LIMITATIONS PERMIT.
- REFER TO MEP DOCUMENTS FOR LOCATIONS OF CEILING ACCESS PANELS. UNLESS NOTED OR DETAIL OTHERWISE ACCESS PANELS IN TOILETS AND BACK OF HOUSE SPACES WITH DRYWALL OR PLASTER CEILINGS ARE TO BE PAINTED METAL. PLASTER OR DRYWALL CEILINGS WITH ACCESS PANELS IN AUTOPSY AND BODY HOLDING AREAS ARE TO BE STAINLESS STEEL.
- FOR SEISMIC BRACINGS AND ANCHORAGE REQUIREMENTS FOR SUSPENDED ACOUSTICAL CEILINGS, SEE SHEET A11.10.
- FOR SEISMIC BRACING AND ANCHORAGE REQUIREMENTS FOR SUSPENDED GYPSUM BOARD CEILINGS SEE SHEET A11.10.1.
- GYPSUM BOARD FURRODOWN HEADERS WILL NOT BE LOWER THAN 8" A.F.F.
- ALL CEILING MOUNTED ITEMS WITH EQUIPMENT TAGS IDENTIFIED ON EQUIPMENT SERIES SHEETS ARE CROSSED REFERENCE TO STRUCTURAL SUPPORT DETAILS VIA MATRIX SHOWN ON EQUIPMENT DRAWINGS.
- FOR ALL LAY IN CEILING PANELS ARRANGE CEILINGS TO NOT HAVE LESS THAN 1/2" CEILING TILE UNLESS OTHERWISE NOTED.
- PROVIDE 2" WIDE TRIM AT ALL PERIMETER OF ACOUSTICAL CEILING GRID SYSTEM TO MEET SEISMIC REQUIREMENTS.
- IN THE EVENT OF A CONFLICT BETWEEN REFLECTED CEILING PLANS AND FINISH SCHEDULES, THE REQUIREMENTS OF TABLE 1224.1 CBC 2007 PART 2 SHALL GOVERN.
- FOR O.R. DIFFUSER ARRAY, PROVIDE 2x4 SUSPENSION SYS. W/ GASKETS (GORDON INC. : GC-15); HOLD DOWN CLIPS; ALUMINUM PANELS (USG: PANZ 2x4 (SMOOTH) SQUARE EDGE LAY-IN.

B1 General Notes


RFI #5906
RCP Coordination

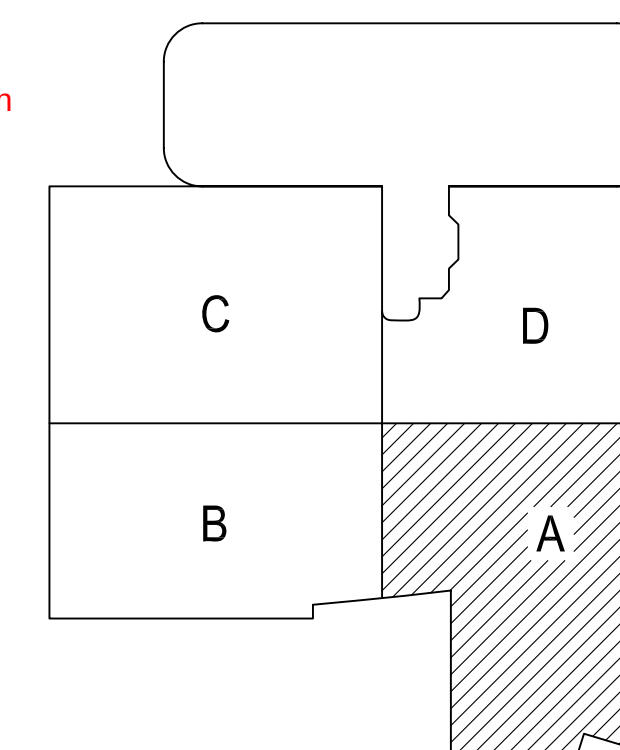

- No ceiling, exposed to structure.
- See Electrical and Mechanical for lighting and HVAC in this space.
- Wall mounted diffusers, see Mechanical drawings.
- Exterior soffits, see Increment 6, Vol. 2A.
- Not used.
- Not used.
- Not used.
- Not used.
- Not used.
- Projection screen, recessed ceiling. Locate centerline of screen with centerline of projector. See Detail D3/A11.6 and Telecom.
- Ceiling mounted projector. See Telecom.
- Locate center of light fixture with centerline of both corridors.
- Match existing grid to provide continuous like new system.
- Ceiling mounted projector, recessed. Locate centerline of projection screen with centerline of projector. See Telecom.
- Locate center of light fixture with centerline of soffits.

A2 Notes To Sheet

A1 KEY PLAN

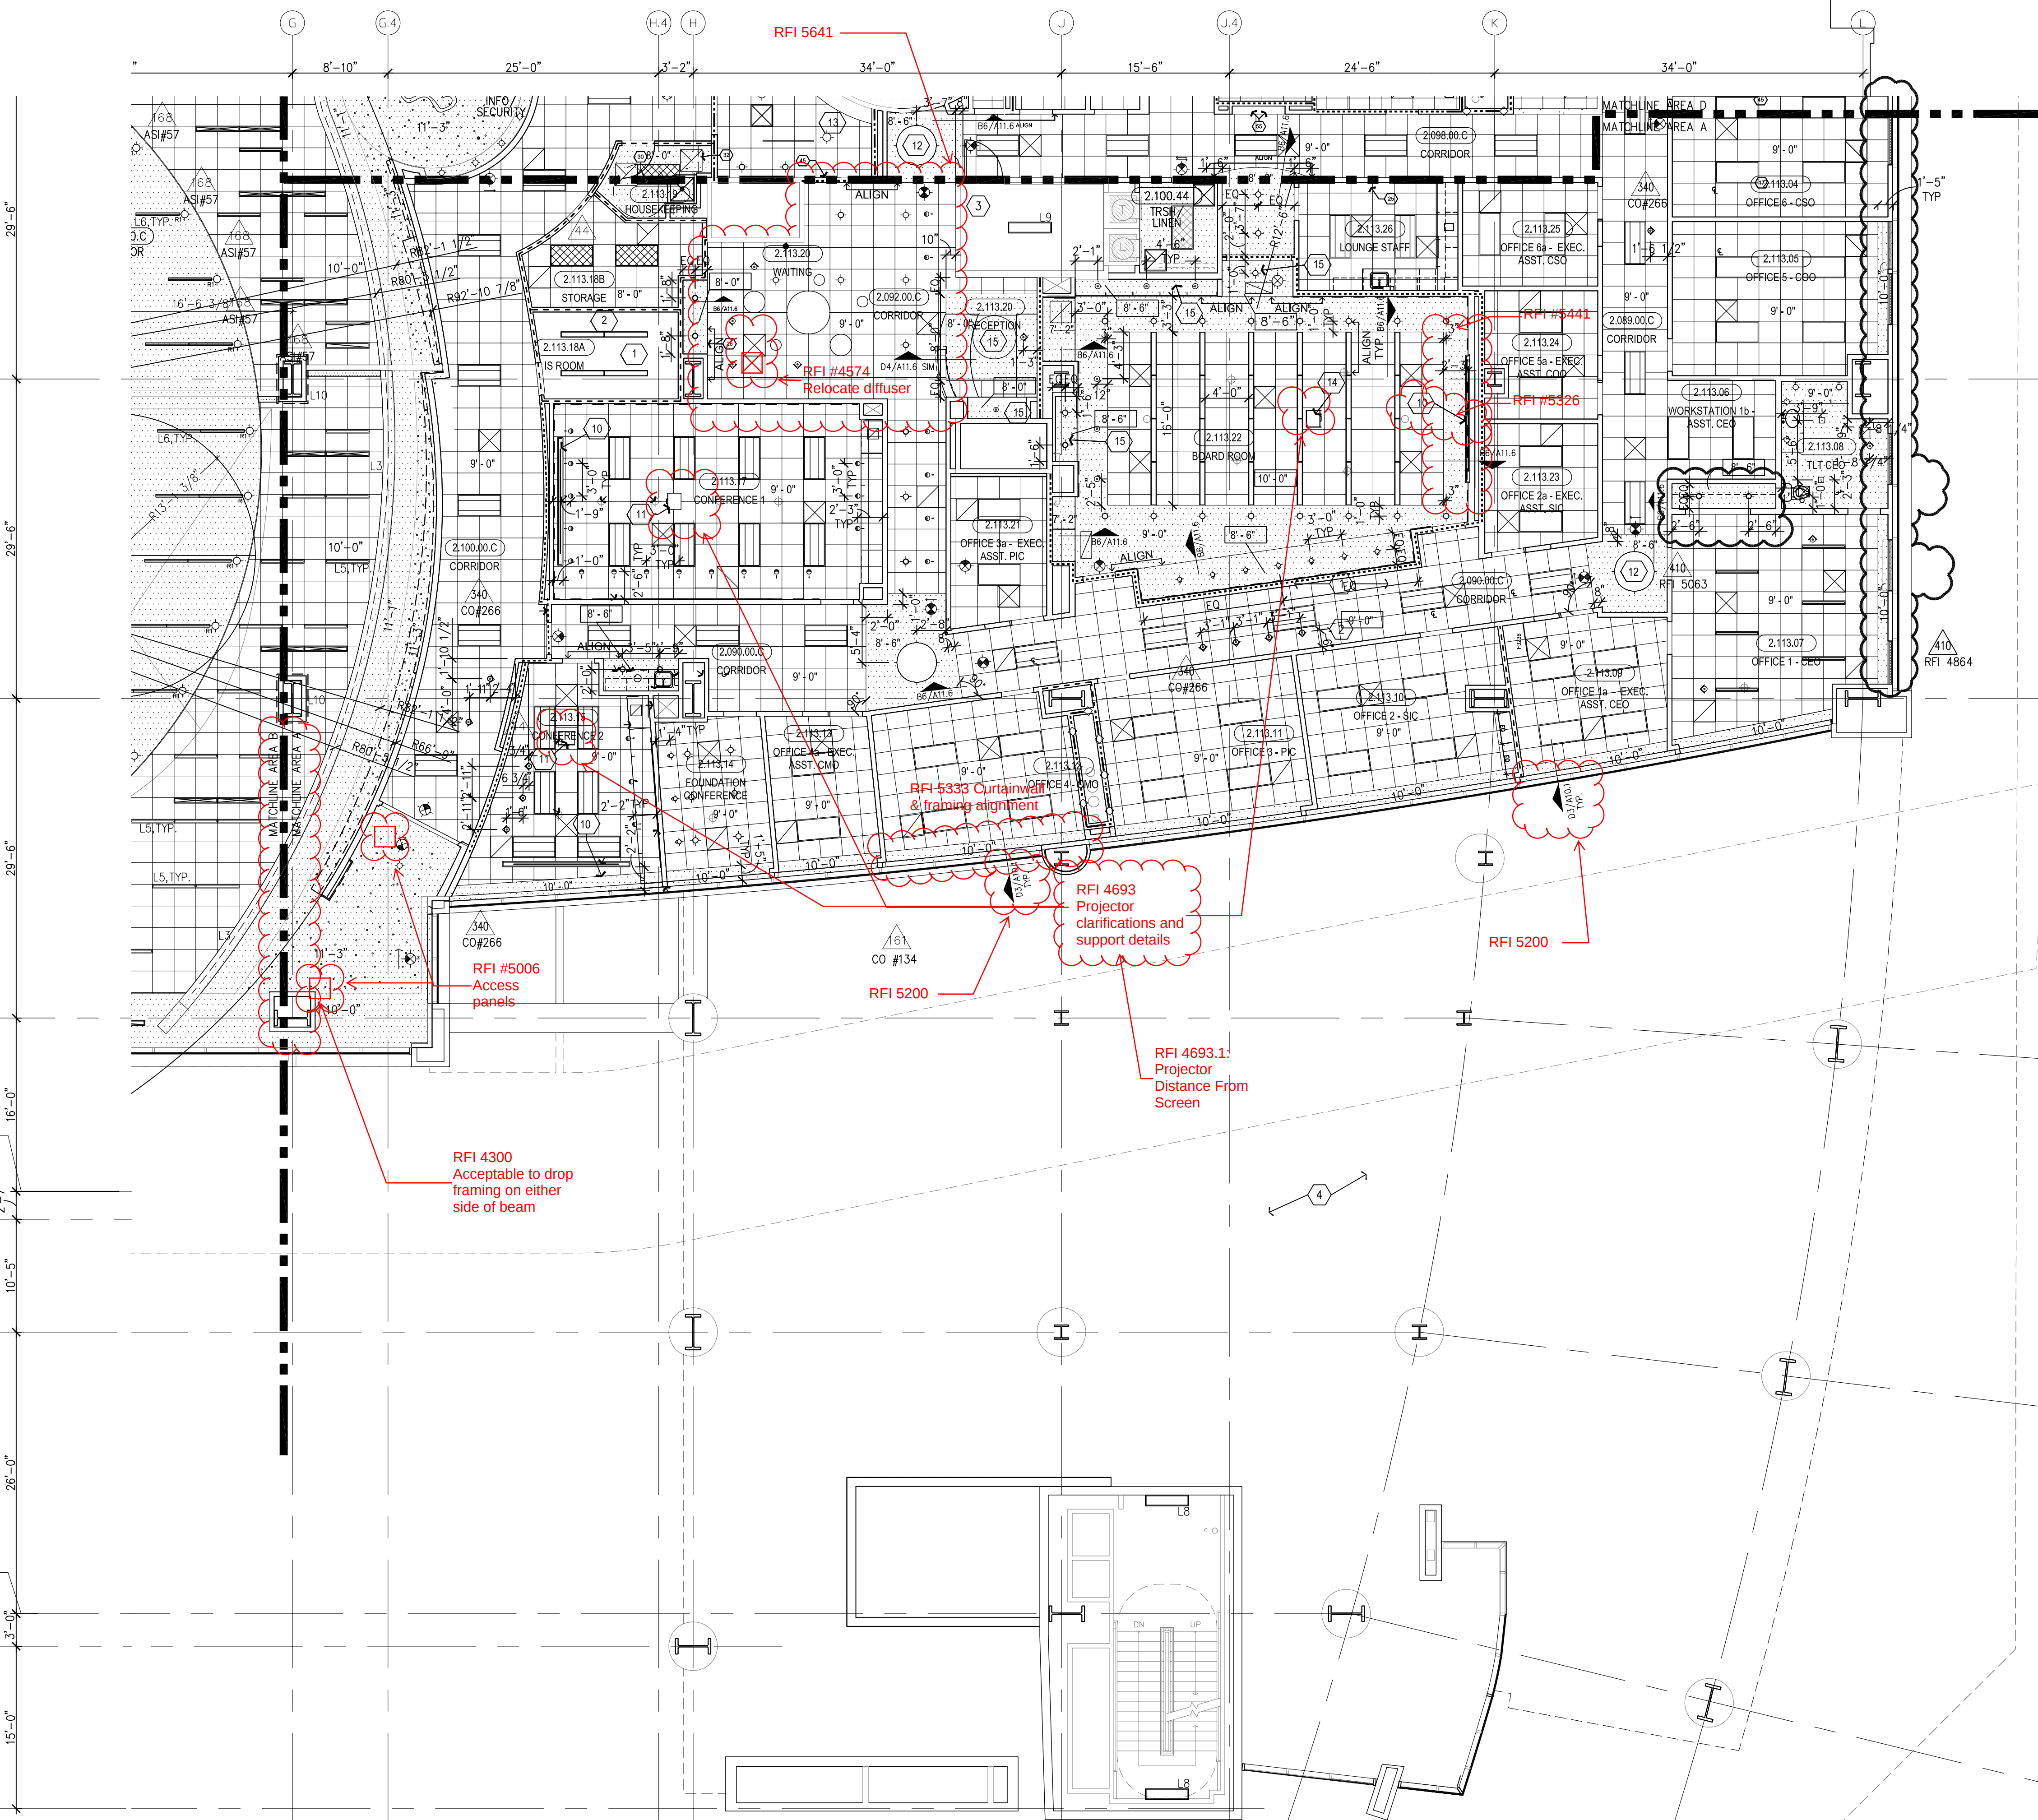

A6 AREA A

CO #134