


ARCHITECT OF RECORD
Paul C. Gloriod

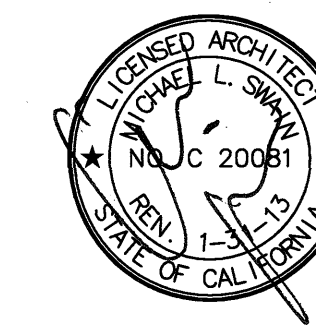

Changes on these drawings do not consist of materially altered changes to approved drawing and don't require a change order.

OSHPD review ACO _____

OSHPD review FLSO _____

OSHPD review DSE _____

44	05/28/10	ASI #08
112	10/25/10	ASI #38
168	02/04/11	ASI #57
189	03/28/10	CO #17
161	03/01/11	CO#134
340	09/05/11	CO#266

Office of Statewide Health
Planning & Development/FDD
REVIEWED IN ACCORDANCE
THE REQUIREMENTS OF T24.
APPROVED *KS*
9/26/11
CHANGE ORDER# *CO 266*
INSTRUCTION BULLETIN# _____
DEFERRED APPROVAL# _____
APPENDUM _____


TOWER II RECEIVED
September 26 2011
McCARTHY



12011.00
Increment #7

LEVEL 2
REFLECTED
CEILING PLAN
AREA - C

A4.2C

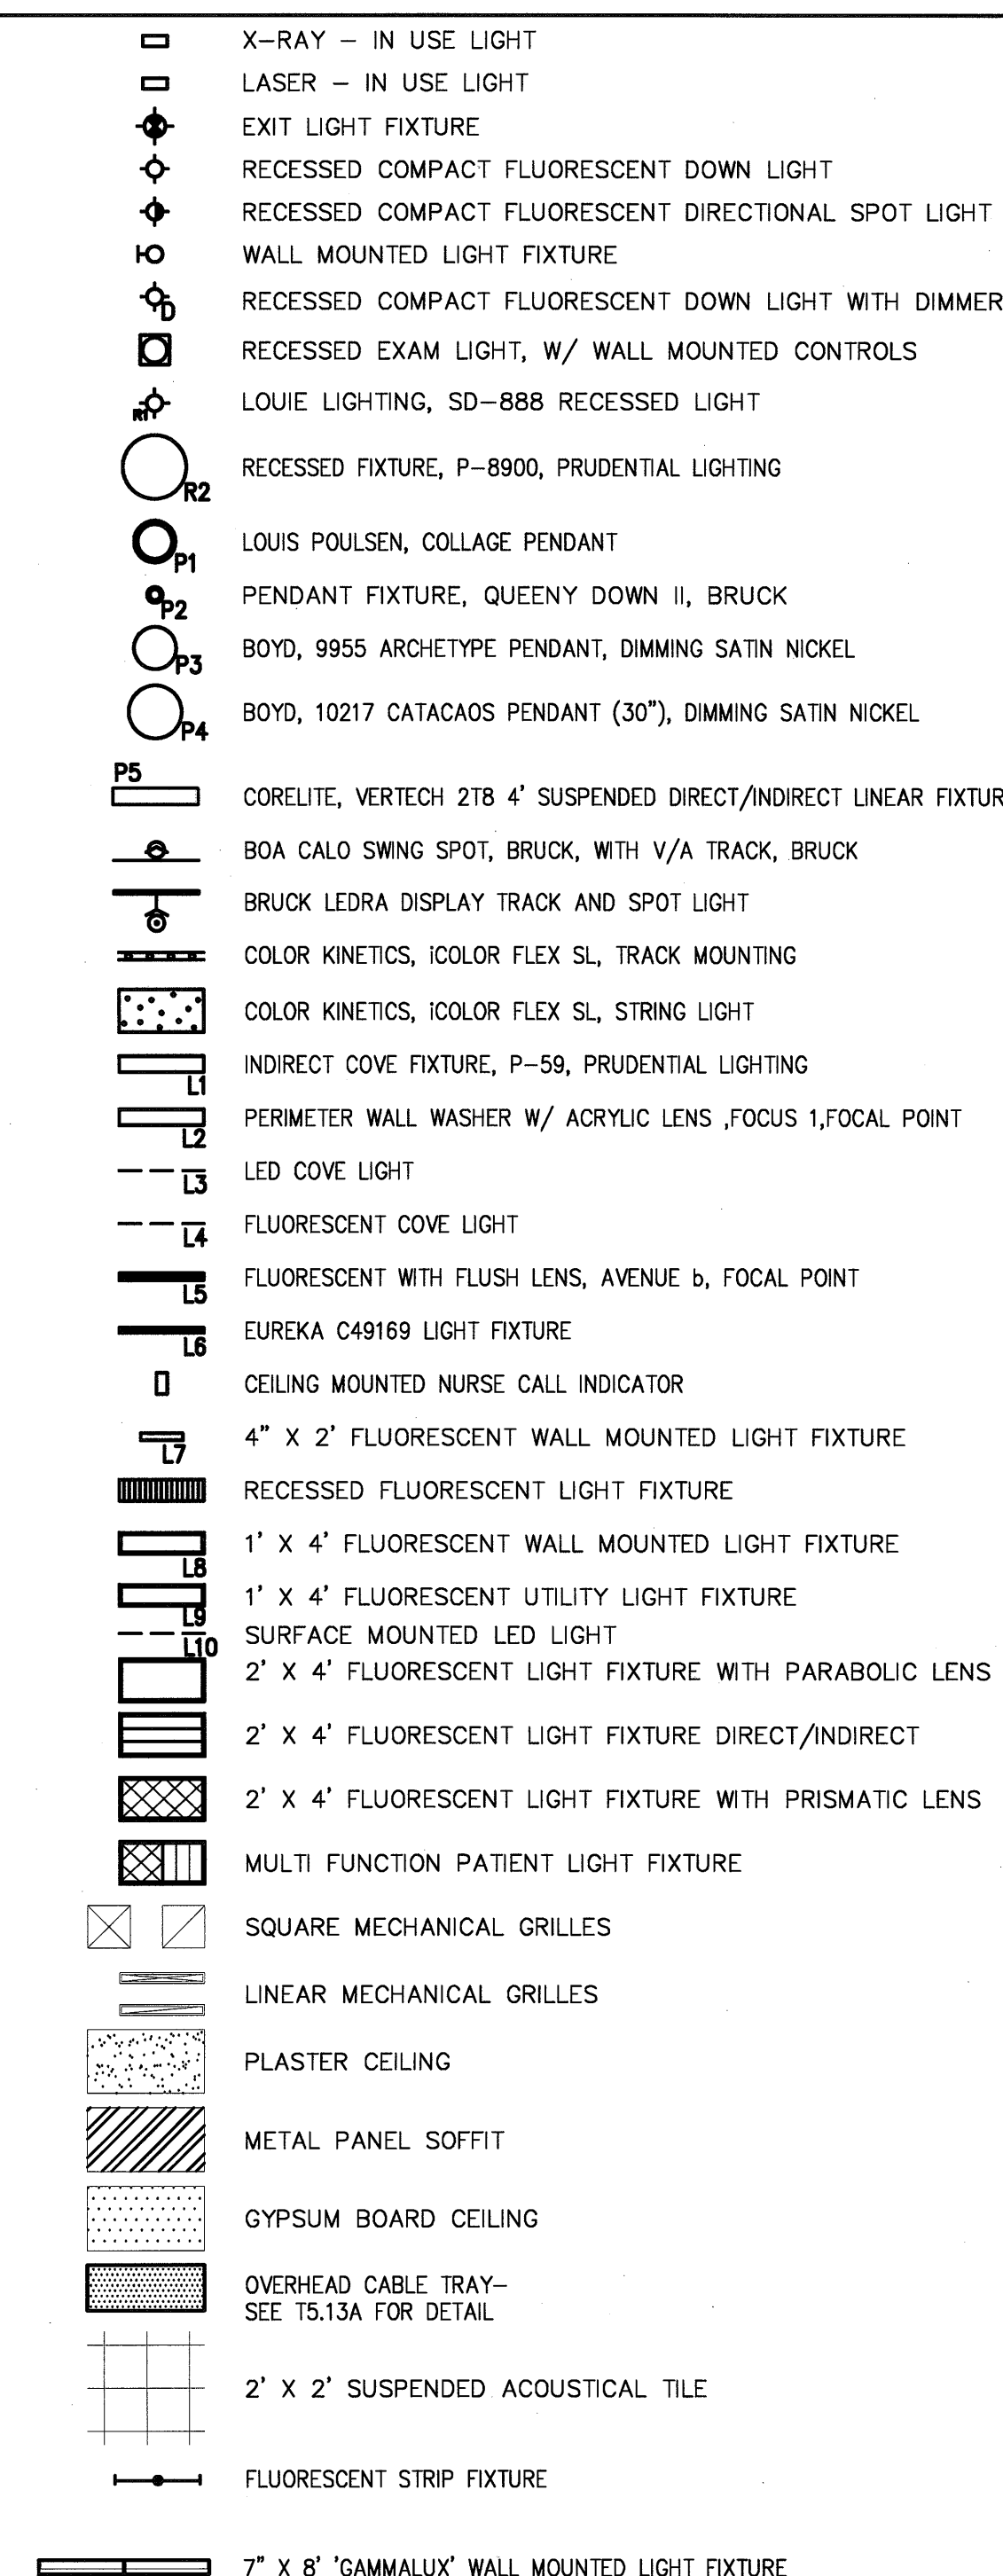

Legend

- A. REFER TO "FINISH SCHEDULE" FOR FURTHER DEFINITION OF CEILING MATERIALS AND FINISHES.
- B. CEILING HEIGHT WILL TYPICALLY BE 9'-0" UNLESS OTHERWISE NOTED ON THE DETAILING DRAWINGS.
- C. LOCATE ALL CEILING MOUNTED SMOKE DETECTORS AND SPEAKERS IN THE CENTER OF FULL PANELS AT LAY-IN CEILINGS.
- D. LAY-INS: LAY-INS SHALL BE 2'x2' SQUARES OF FULL PANELS AT LAY-IN CEILINGS. AT GYPSUM BOARD CEILINGS, SYMMETRICALLY SPACE HEADS AND CENTER ON LIGHT ROWS WHERE AREA LIMITATIONS PERMIT.
- E. PROVIDE 1" SQUARE ACCESS PANELS FOR ALL 2'x2' ACCESS PANELS, UNLESS NOTED OR DETAILED OTHERWISE INCLUDING PANELS IN TOILETS AND BACK ROOMS. PROVIDE 1" SQUARE ACCESS PANELS FOR PLASTER CEILINGS TO BE PAINTED TO MATCH PLASTER OR DRYWALL CEILINGS WITH ACCESS PANELS. AUTOMATIC METAL FLASHER AREAS ARE TO BE STAINLESS STEEL.
- F. FOR CEILING BRACING AND ANCHORAGE REQUIREMENTS FOR SUSPENDED ACoustICAL CEILING, SEE SHEET A111.0.
- G. FOR SSSMC BRACING AND ANCHORAGE REQUIREMENTS FOR SUSPENDED GYPSUM BOARD CEILING, SEE SHEET A112.0.
- H. GYPSUM BOARD FURROWDOWN HEADERS WILL NOT BE LOWER THAN 8" A.F.F.
- I. ALL CEILING MOUNTED ITEMS WITH EQUIPMENT JAKES IDENTIFIED ON EQUIPMENT SCHEDULES ARE TO BE CROSSED REFERRED TO STRUCTURAL SUPPORT DETAILS W MATRIX SHOWN ON EQUIPMENT DRAWINGS.
- J. FOR ALL LAY IN CEILING PANELS ARRANGE CEILING JOINTS TO HAVE NOT LESS THAN 12" OF CLEARANCE FROM ALL STRUCTURAL MEMBERS.
- K. PROVIDE 2" WIDE TRIM AT ALL PERIMETER OF ACoustICAL CEILING GRID SYSTEM TO MEET SSSMC REQUIREMENTS.
- L. PROVIDE 1/2" OF A CROSSED REFERENCE TO REFLECTED CEILING PLANS AND FINISH SCHEDULES, THE REQUIREMENTS OF TABLE 1224.1 CCB 2007 PART 2 SHALL GOVERN.
- M. FOR OR, DIFFUSER AREA, PROVIDE 224 SUSPENSION SYS. W/ GASKETS

General Notes

DT N.T.S

A2 Notes to Sheet

A1 KEY PLAN