


FKP Architects

ARCHITECT OF RECORD

Paul C. Gloriod

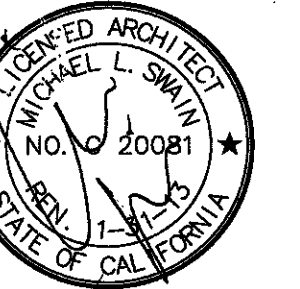

Changes on these drawings do not consist of
materially altered changes to approved drawings
and don't require a change order.
OSHPD review ACC
OSHPD review RSO
OSHPD review DSE

REVISIONS

392 02/13/11 CO #300

APPROVAL



CHANGE ORDER # 300
INSTRUCTION BULLETIN
DEFERRED APPROVAL
ADDENDUM

PROJECT NAME PAD 2012-0239B

CHILDREN'S HOSPITAL
OF ORANGE COUNTY

455 S. Main St.
Orange, CA 92668-3874

TOWER II Received
June 05 2012
McCarthy



PROJECT NUMBER

12011.00
Increment #7

OSHPD - PROJECT NUMBER

IL 072072-30

ISSUE

OSHPD PERMIT

DATE

01/27/2010

SCALE

1/16" = 1'-0"

DRAWING TITLE

LEVEL 4 REFLECTED
CEILING PLAN

DRAWING NUMBER

A4.41


E

D


C

B

A

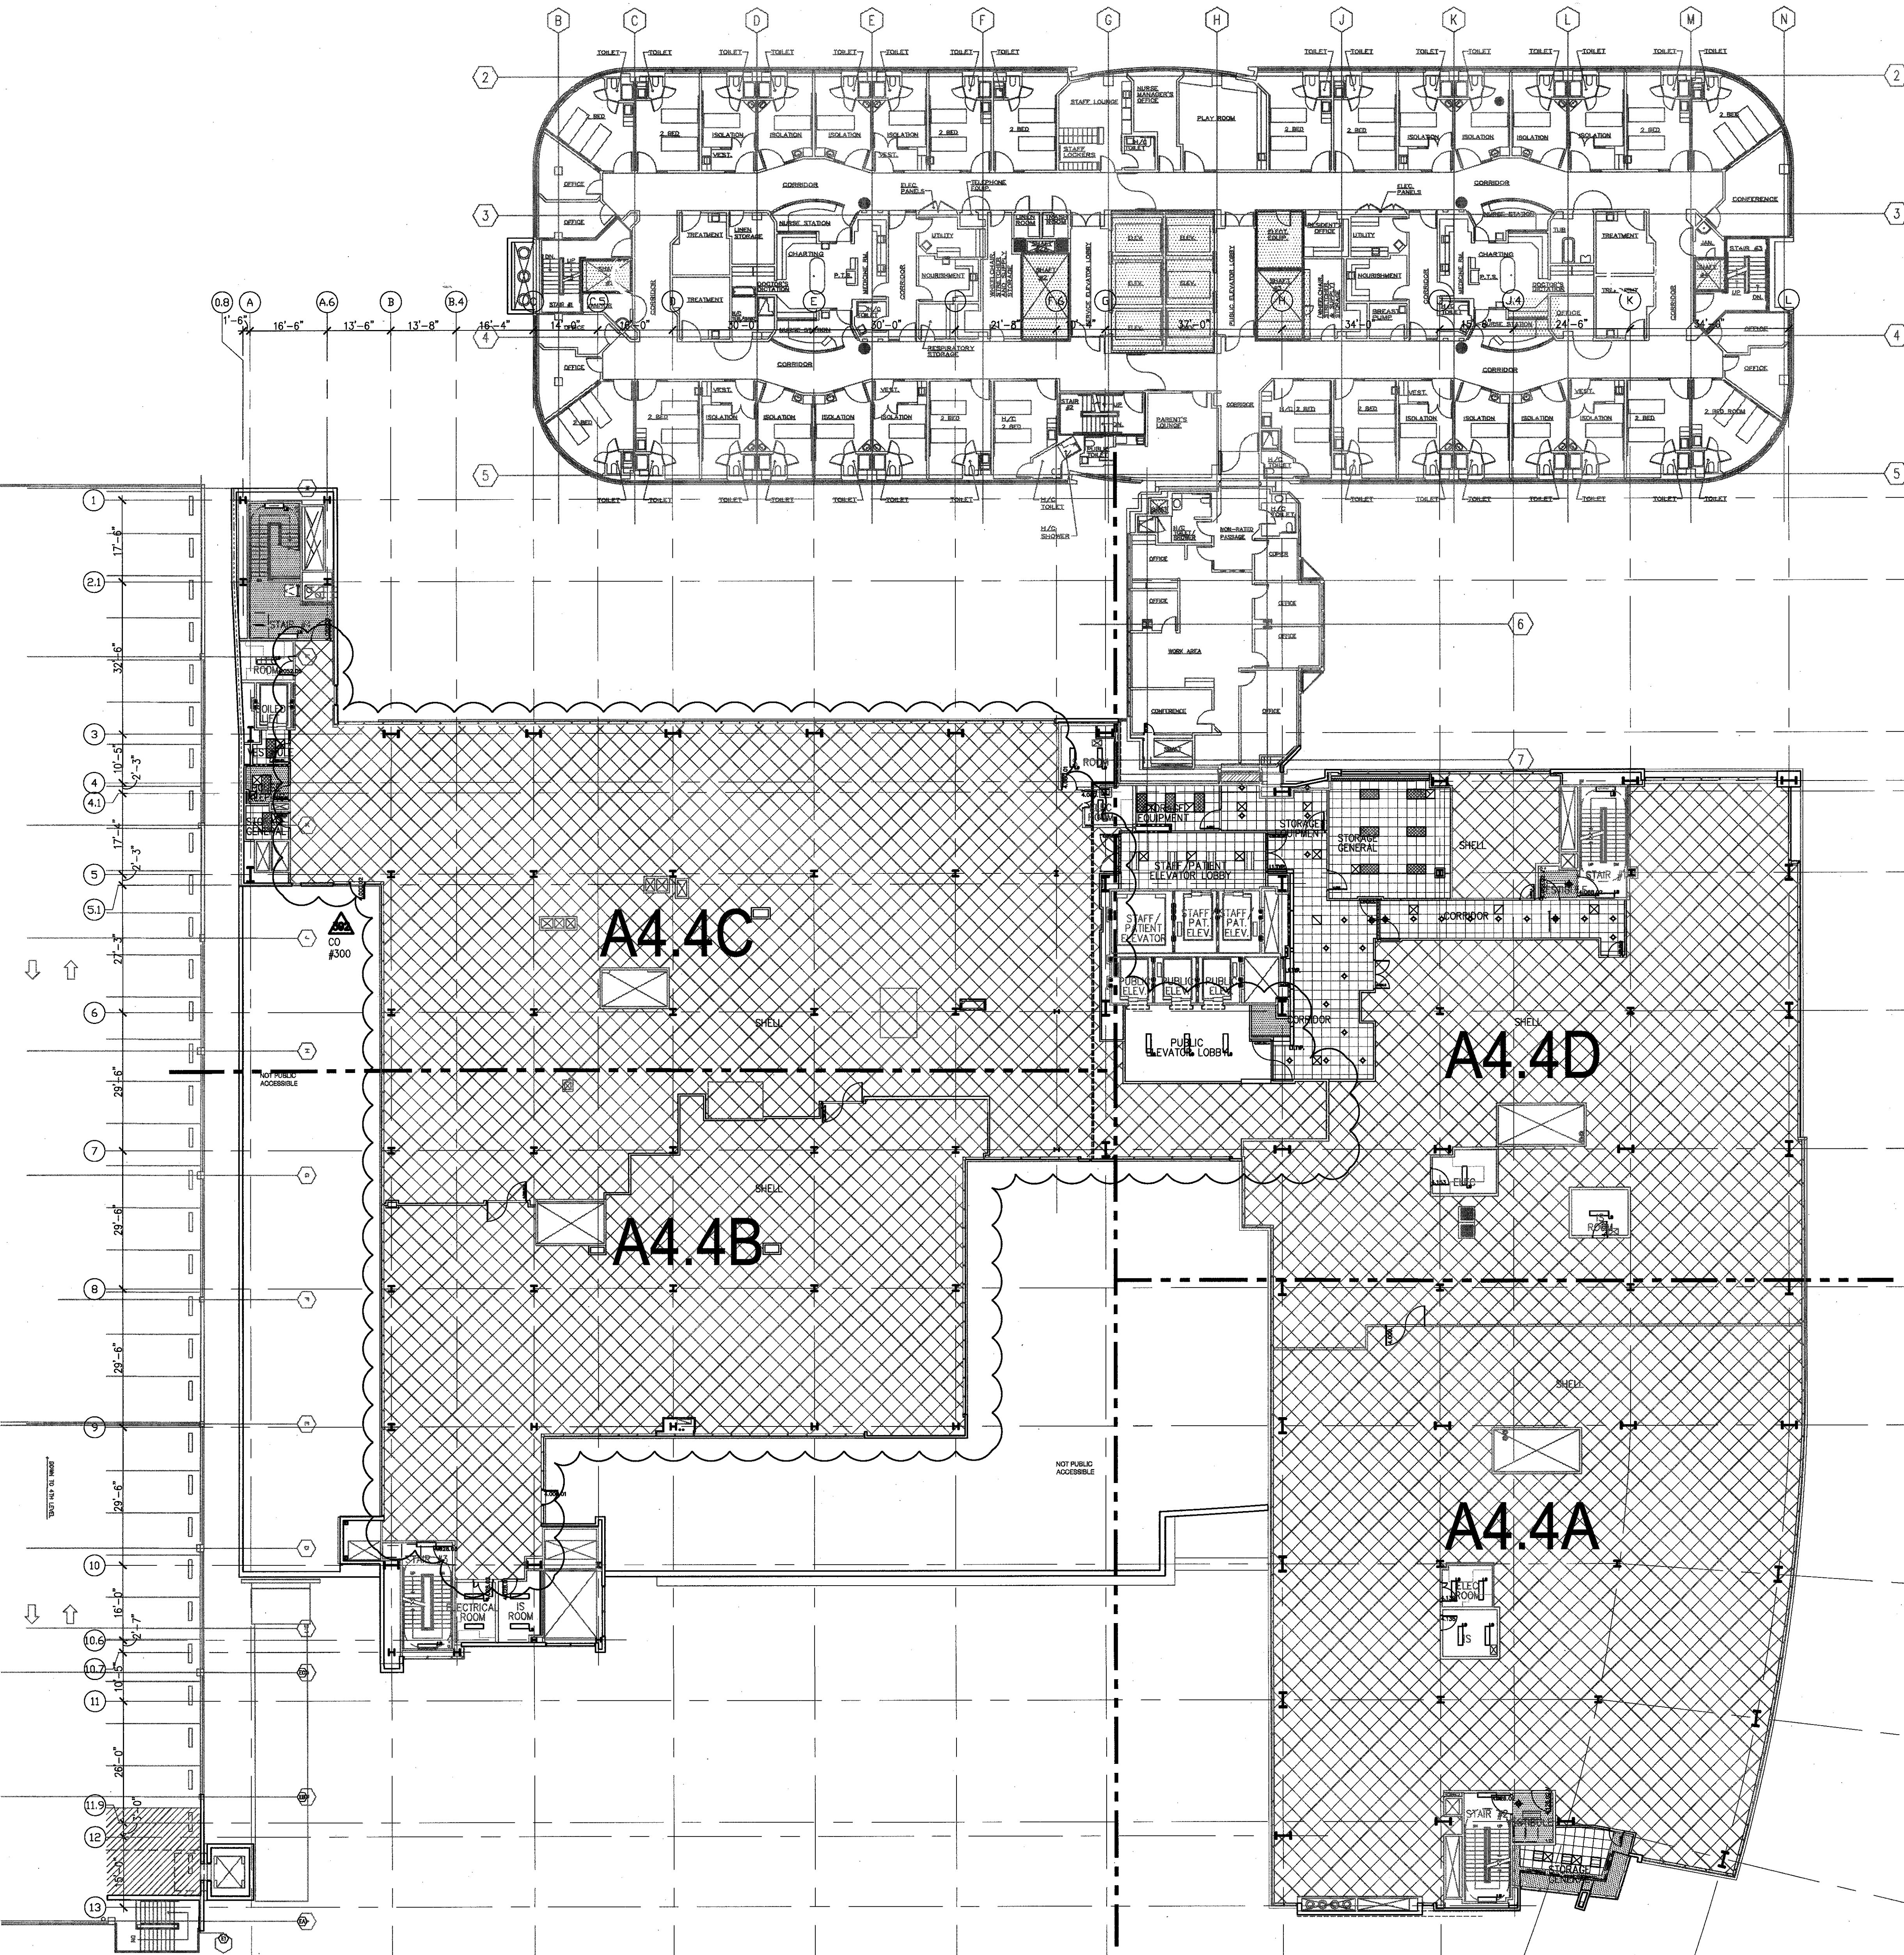

General Note:
RFI 340
For corridors on 4th floor with curved
soffit use detail shown in RFI.

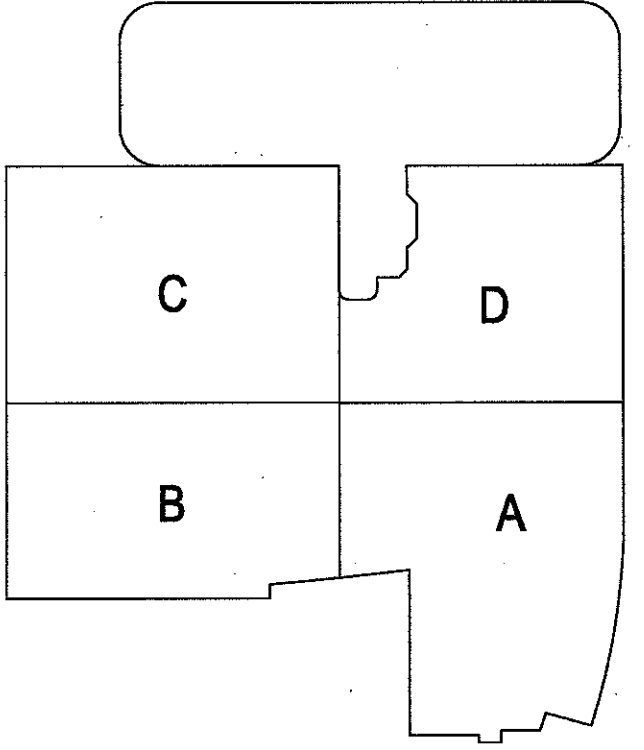

A1 KEY PLAN

A6 LEVEL 4
1/16" = 1'-0"