


FKP Architects

ARCHITECT OF RECORD
Paul C. Gloriot

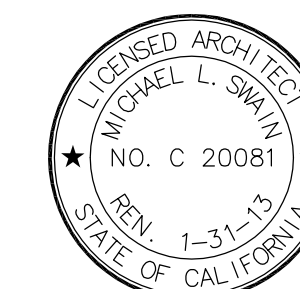

Changes on these drawings do not consist of materials altered changes to approved drawings and don't require a change order.
OSHPD review ACO
OSHPD review FLSO
OSHPD review DSE

REVISIONS

NO.	DATE	DESCRIPTION
28A	06/16/11	ASI #95
16A	08/08/11	CO #135
34A	09/05/11	CO #266
38A	12/23/11	ASI #131
45A	03/05/12	CO #340
58A	09/06/12	ASIM252

APPROVAL



CHANGE ORDER/INSTRUCTION BULLETIN/DEFERRED APPROVAL/REVISION

PROJECT NAME

CHILDREN'S HOSPITAL
OF ORANGE COUNTY

455 S. Main St.
Orange, CA 92668-3874

TOWER II



PROJECT NUMBER

12011.00
Increment #7

OSHPD - PROJECT NUMBER
IL 072072-30

ISSUE
OSHPD PERMIT

DATE
01/27/2010

SCALE
1/8" = 1'-0"
DRAWING TITLE

LEVEL 5 REFLECTED
CEILING PLAN AREA -
D-STAIR
#3-ELECTRICAL ROOM

DRAWING NUMBER

A4.5D

- LASER - IN USE LIGHT
- EXIT LIGHT FIXTURE
- RECESSED COMPACT FLUORESCENT DOWN LIGHT
- RECESSED COMPACT FLUORESCENT DIRECTIONAL SPOT LIGHT
- RECESSED LED DOWN LIGHT, WALL WASH TRIM, JUNO
- WALL MOUNTED LIGHT FIXTURE
- RECESSED COMPACT FLUORESCENT DOWN LIGHT WITH DIMMER
- RECESSED EXAM LIGHT, W/ WALL MOUNTED CONTROLS
- LOUIE LIGHTING, SD-888 RECESSED LIGHT
- RECESSED FIXTURE, P-8900, PRUDENTIAL LIGHTING
- LOUIS POULSEN, COLLAGE PENDANT
- PENDANT FIXTURE, QUEENY DOWN II, BRUCK
- BOYD, 9955 ARCHETYPE PENDANT, DIMMING SATIN NICKEL
- BOYD, 10217 CATAACS PENDANT (30"), DIMMING SATIN NICKEL
- CORELITE, VERTECH 278 4' SUSPENDED DIRECT/INDIRECT LINEAR FIXTURE
- BOA CALO SWING SPOT, BRUCK, WITH V/A TRACK, BRUCK
- BRUCK LEDRA DISPLAY TRACK AND SPOT LIGHT
- COLOR KINETICS, ICOLOR FLEX SL, TRACK MOUNTING
- COLOR KINETICS, ICOLOR FLEX SL, STRING LIGHT
- INDIRECT COVE FIXTURE, P-59, PRUDENTIAL LIGHTING
- PERIMETER WALL WASHER W/ ACRYLIC LENS, FOCUS 1, FOCAL POINT
- LED COVE LIGHT
- FLUORESCENT COVE LIGHT
- FLUORESCENT WITH FLUSH LENS, AVENUE D, FOCAL POINT
- EUREKA C49169 LIGHT FIXTURE
- CEILING MOUNTED NURSE CALL INDICATOR
- 4" X 2' FLUORESCENT WALL MOUNTED LIGHT FIXTURE
- RECESSED FLUORESCENT LIGHT FIXTURE
- 1' X 4' FLUORESCENT WALL MOUNTED LIGHT FIXTURE
- 1' X 4' FLUORESCENT UTILITY LIGHT FIXTURE
- SURFACE MOUNTED LED LIGHT
- 2' X 4' FLUORESCENT LIGHT FIXTURE WITH PARABOLIC LENS
- 2' X 4' FLUORESCENT LIGHT FIXTURE DIRECT/INDIRECT
- 2' X 4' FLUORESCENT LIGHT FIXTURE WITH PRISMATIC LENS
- MULTI FUNCTION PATIENT LIGHT FIXTURE
- SQUARE MECHANICAL GRILLES
- LINEAR MECHANICAL GRILLES
- PLASTER CEILING
- METAL PANEL SOFFIT
- GYPSUM BOARD CEILING
- OVERHEAD CABLE TRAY - SEE T5.13A FOR DETAIL
- 2' X 2' SUSPENDED ACOUSTICAL TILE
- CUBICLE CURTAIN

LEGEND

- A. REFER TO "FINISH SCHEDULE" FOR FURTHER DEFINITION OF CEILING MATERIALS AND FINISHES.
- B. CEILING HEIGHT WILL TYPICALLY BE 9'-0" UNLESS OTHERWISE NOTED ON THE REFLECTED CEILING PLAN.
- C. LOCATE ALL CEILING MOUNTED SMOKE DETECTORS AND SPEAKERS IN THE CENTER OF FULL PANELS AT LAY-IN CEILINGS.
- D. LOCATE ALL SPRINKLER HEADS IN THE CENTER OF FULL PANELS AT LAY-IN CEILINGS. AT GYPSUM BOARD CEILINGS, SYMMETRICALLY SPACE HEADS AND CENTER ON LIGHT ROWS WHERE AREA LIMITATIONS PERMIT.
- E. REFER TO MEP DOCUMENTS FOR LOCATIONS OF CEILING ACCESS PANELS. UNLESS NOTED OR OTHERWISE ACCESS PANELS IN TOILETS AND BACK OF HOUSE SPACES WITH DRYWALL OR PLASTER CEILINGS ARE TO BE PAINTED METAL. PLASTER OR DRYWALL CEILINGS WITH ACCESS PANELS IN AUTOPSY AND BODY HOLDING AREAS ARE TO BE STAINLESS STEEL.
- F. FOR SEISMIC BRACING AND ANCHORAGE REQUIREMENTS FOR SUSPENDED ACOUSTICAL CEILINGS, SEE SHEET A11.10.
- G. FOR SEISMIC BRACING AND ANCHORAGE REQUIREMENTS FOR SUSPENDED GYPSUM BOARD CEILINGS SEE SHEET A11.10.
- H. GYPSUM BOARD FURREDOWN HEADERS WILL NOT BE LOWER THAN 8" A.F.F.
- I. ALL CEILING MOUNTED ITEMS WITH EQUIPMENT TAGS IDENTIFIED ON EQUIPMENT SERIES SHEETS ARE CROSSED REFERENCE TO STRUCTURAL SUPPORT DETAILS VIA MATRIX SHOWN ON EQUIPMENT DRAWINGS.
- J. FOR ALL LAY IN CEILING PANELS ARRANGE CEILINGS TO NOT HAVE LESS THAN 1/2" CEILING TILE UNLESS OTHERWISE NOTED.
- K. PROVIDE 2" WIDE TRIM AT ALL PERIMETER OF ACOUSTICAL CEILING GRID SYSTEM TO MEET SEISMIC REQUIREMENTS.
- L. IN THE EVENT OF A CONFLICT BETWEEN REFLECTED CEILING PLANS AND FINISH SCHEDULES, THE REQUIREMENTS OF TABLE 1224.1 CBC 2007 PART 2 SHALL GOVERN.
- M. FOR O.R. DIFFUSER ARRAY, PROVIDE 2x4 SUSPENSION SYS. W/ GASKETS (GORDON INC. - CC-15); HOLD DOWN CLIPS; ALUMINUM PANELS (USG; PANZ 2x4 (SMOOTH) SQUARE EDGE LAY-IN.

GENERAL NOTES

RFI 3909
Reference RFI for MEP
coordination of over
head access panels

RFI 4136
Center to center is to
be 5'-0"
PV-1 Lights will not
interfere with higher
cloud

- 1. Wall mounted diffusers see Mechanical drawings.
- 2. Cubicle Curtain. Verify existing ceiling layout and location of curtain track prior to installation. See 04/A11.8 for mounting detail.
- 3. Roll-up shutter. See detail A2/A11.1.
- 4. For center location see A1 BCP.
- 5. Replace existing window with new integral blind window system.
- 6. Retain existing window size. See detail A4/A11.4.
- 7. Cubicle curtain, ceiling mounted.
- 8. Align finished face of soffit with finished face of partition.
- 9. Center point of fixture at intersection of lay-in grid, typical.
- 10. See A6/A4.5A for typical notes.
- 11. No ceiling, exposed to structure.
- 12. Suspended decorative ceiling. See detail A10/A11.2.
- 13. Not used.
- 14. See A4/A4.5D for typical notes.
- 15. Align centerline of fixture with centerline of bed. See plan.
- 16. Drywall furr down.
- 17. Clearstory window. See opening schedule.
- 18. Surface mounted manual roller shades.
- 19. Security camera, ceiling mounted dome.
- 20. Existing expansion joint.
- 21. Recessed light cove. See detail B3/A11.8.

NOTES TO SHEET

ELECTRICAL ROOM

STAIR #3

NURSE STATION

RECEPTION

KEY PLAN

