RFI 2257
Foot paddle 6" OC from right side of sink

© 2009 FKP Architects, Inc. All rights reserved. No part of this document may be reproduced or utilized in any form without prior written authorization of FKP Architects, Inc.

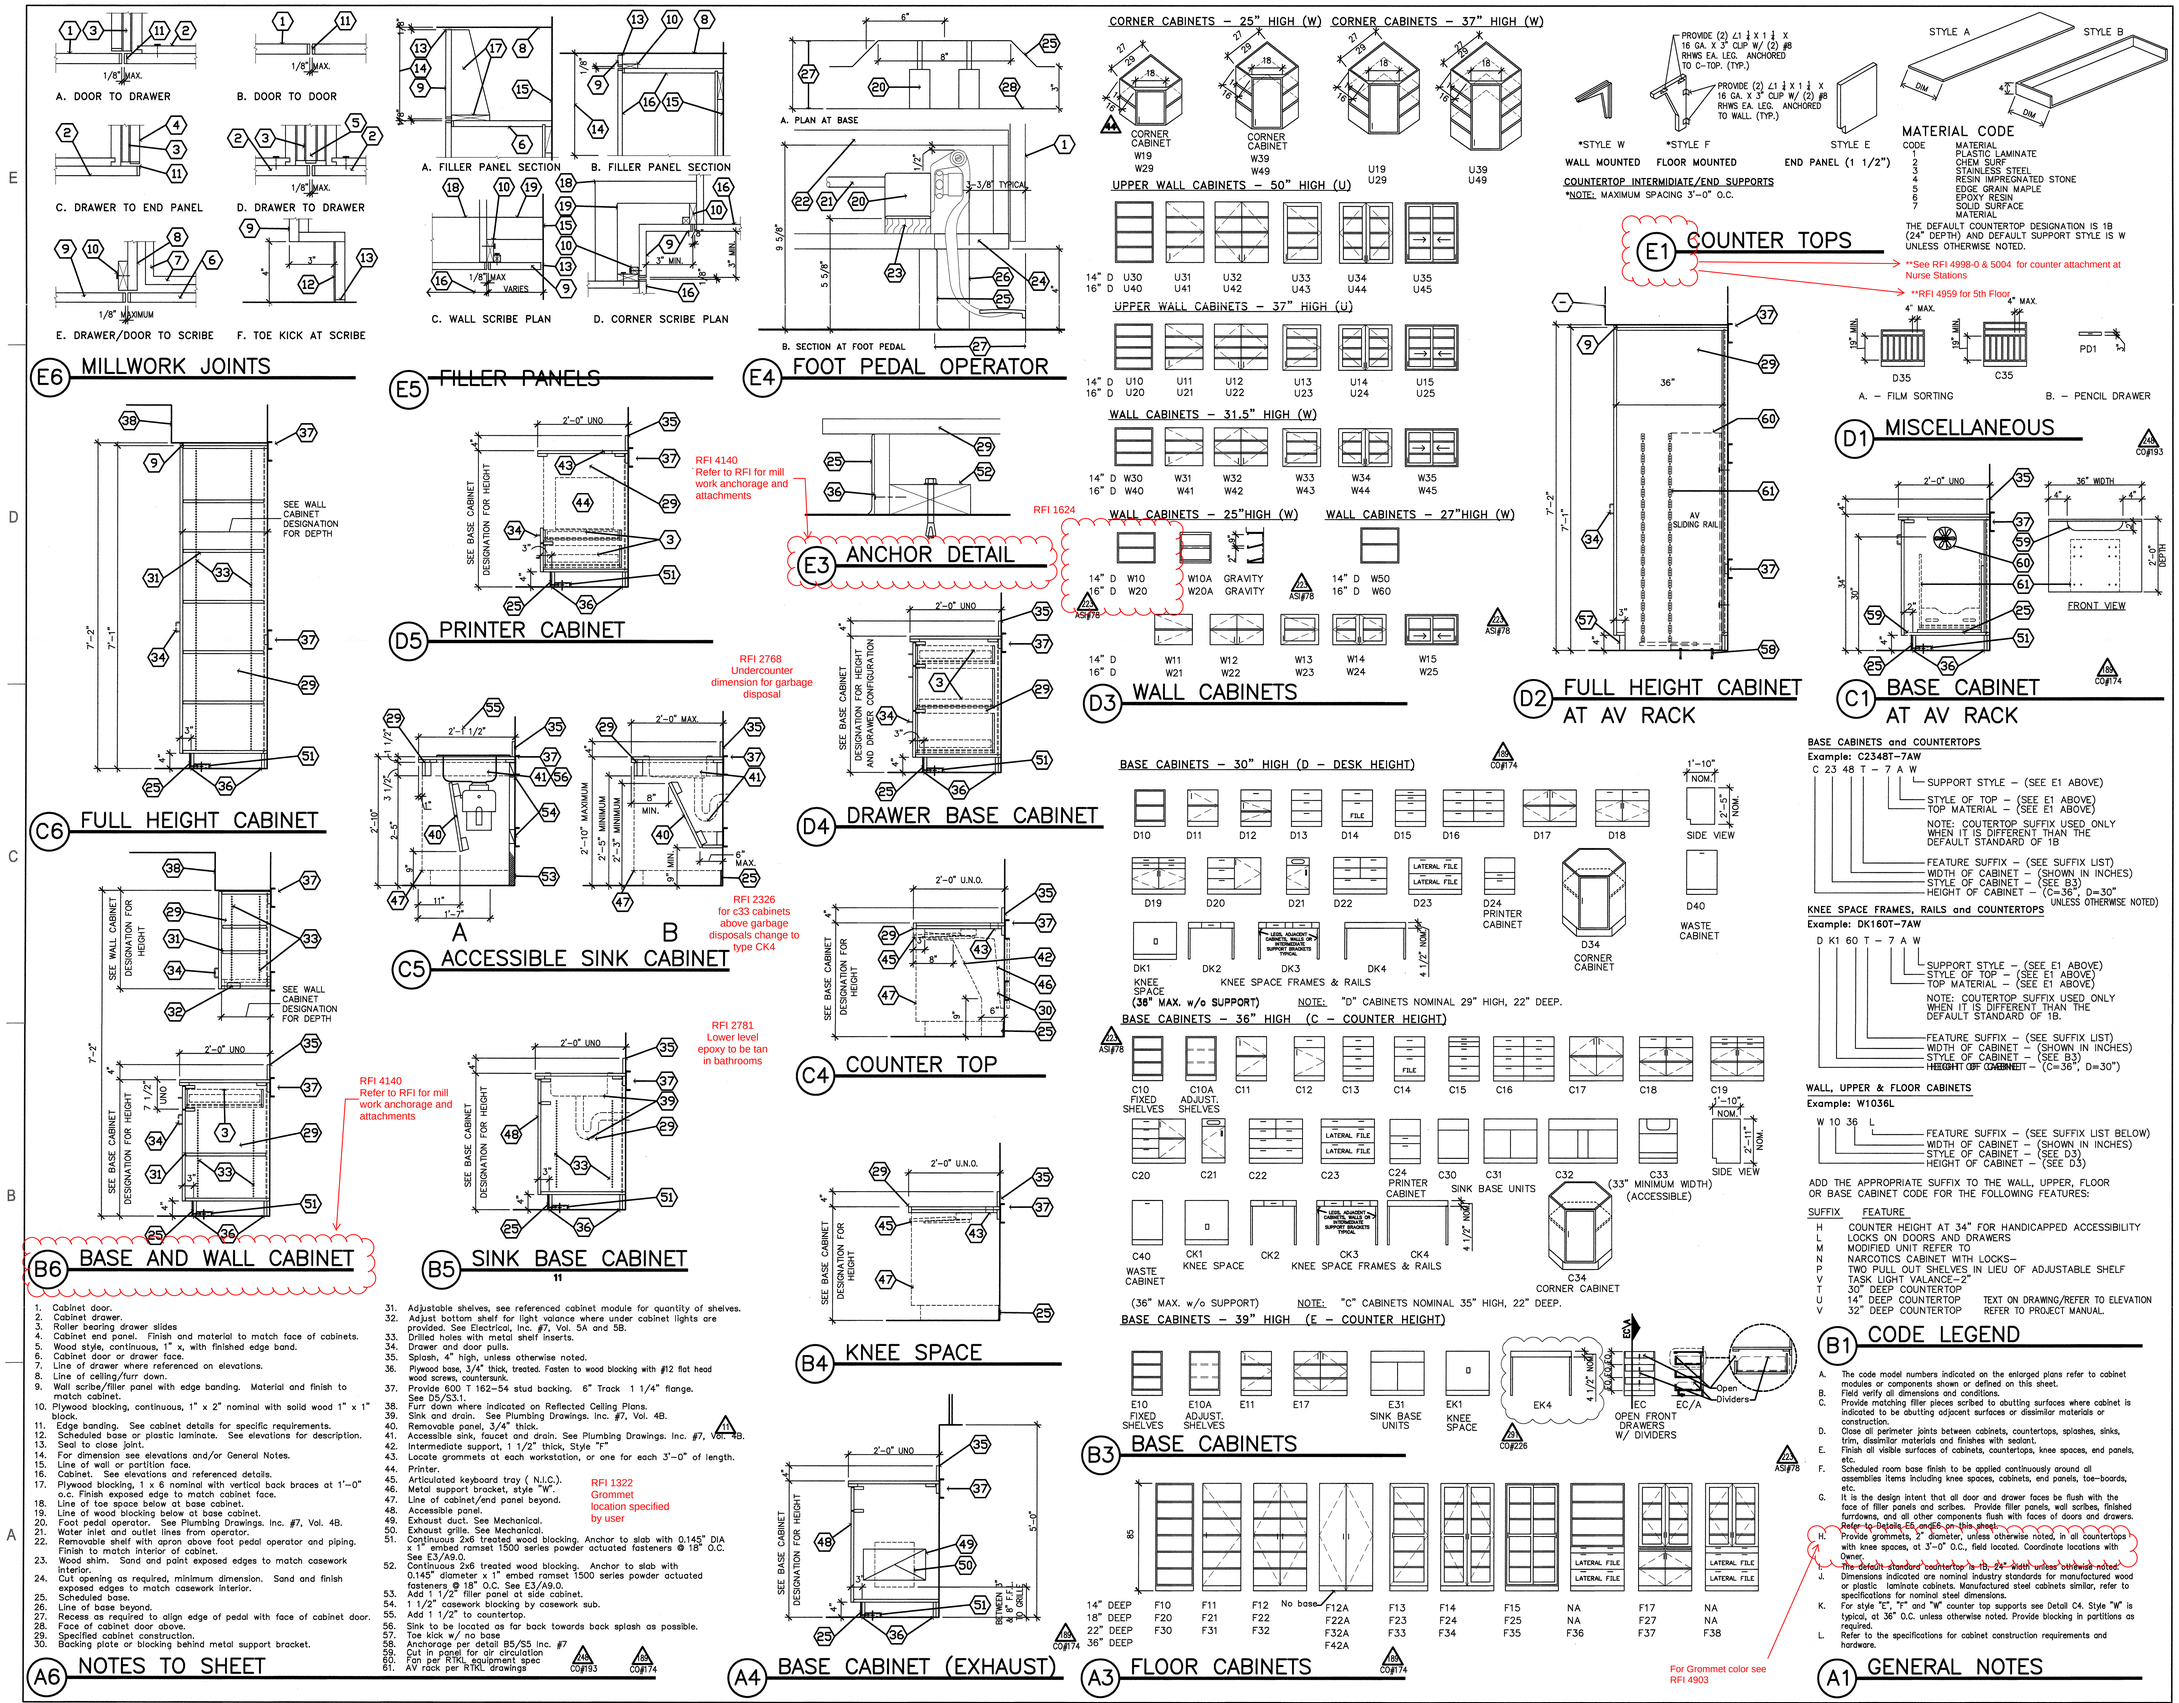

FKP Architects

ARCHITECT OF RECORD
Paul C. Gloriod

Changes on these drawings do not consist of materially altered changes to approved drawings and don't require a change order.
OSHPD review ACO
OSHPD review FLSO
OSHPD review DSE

REVISIONS

11	03/11/10	CHANGE ORDER #17
44	05/28/10	ASI #06
39	12/01/10	ASI #48
189	03/28/10	CO #174
223	05/20/11	ASI #78
246	06/07/10	CO #193
29	07/18/11	CO #226

APPROVAL
Office of Statewide Health Planning & Development/FDD REVIEWED IN ACCORDANCE WITH THE REQUIREMENTS OF T24, CCR APPROVED
CHANGE ORDER# CO #226
INSTRUCTION BULLETIN#
DEFERRED APPROVAL#
ADDENDUM 6

PROJECT NAME
CHILDREN'S HOSPITAL OF ORANGE COUNTY
455 S. Main St.
Orange, CA 92868-3874
TOWER II
RECEIVED August 08 2011 McCARTHY

CHOC HOSPITAL

PROJECT NUMBER
12011.00
Increment #7

OSHPD - PROJECT NUMBER
IL 072072-30

ISSUE
OSHPD PERMIT

DATE
01/27/2010

SCALE

DRAWING TITLE
CASEWORK SHEET

DRAWING NUMBER
A9.0

\\MRG4-OFFSITE\CADSERVER\@KXXX\@6102 CHOC TOWER 2 SHELL BUILDING\FKP CONTRACTED PROJECTS\PROJECT INCREMENTS\INCR. #07_TENANT IMPROVEMENT\OSHPD PERMIT (CONSTRUCTION DOCUMENTS)\100602_CO#_____\A9.0 CASEWORK SHEET.DWG
7/15/2011
RULA