


FKP Architects

RFI 507.1
See revised concept sketch for
glazing/millwork posted on
opposite sheet

ARCHITECT OF RECORD


Paul C. Gloriot

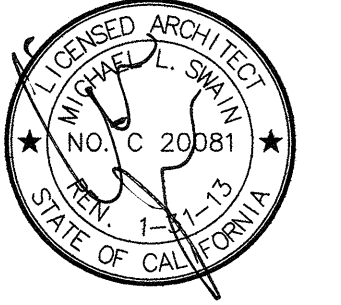

REVISIONS

10/25/10	CHANGE ORDER #67
01/24/11	ASI #51
02/28/11	CHANGE ORDER #144

OSHDP/FDD-Field Review Tracking	
Project:	
PAD:	
ACC:	
Architect:	
Mechanical:	
Electrical:	
Plumbing:	
Fire/Life Safety:	

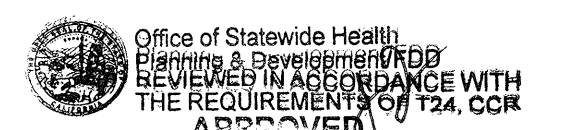

FEB 2 2011

APPROVAL
INSTRUCTION BULLETIN
DEFERRED APPROVALS
CONCURRENCE

PROJECT NAME

CHILDREN'S HOSPITAL
OF ORANGE COUNTY

455 S. Main St.
Orange, CA 92668-3874

TOWER II



PROJECT NUMBER

12011.00
Increment #7

OSHDP - PROJECT NUMBER

IL 072072-30

ISSUE

OSHDP PERMIT

DATE

01/27/2010

SCALE


3/8" = 1' - 0"

DRAWING TITLE


FIRST FLOOR INTERIOR
ELEVATIONS

DRAWING NUMBER


A9.1A

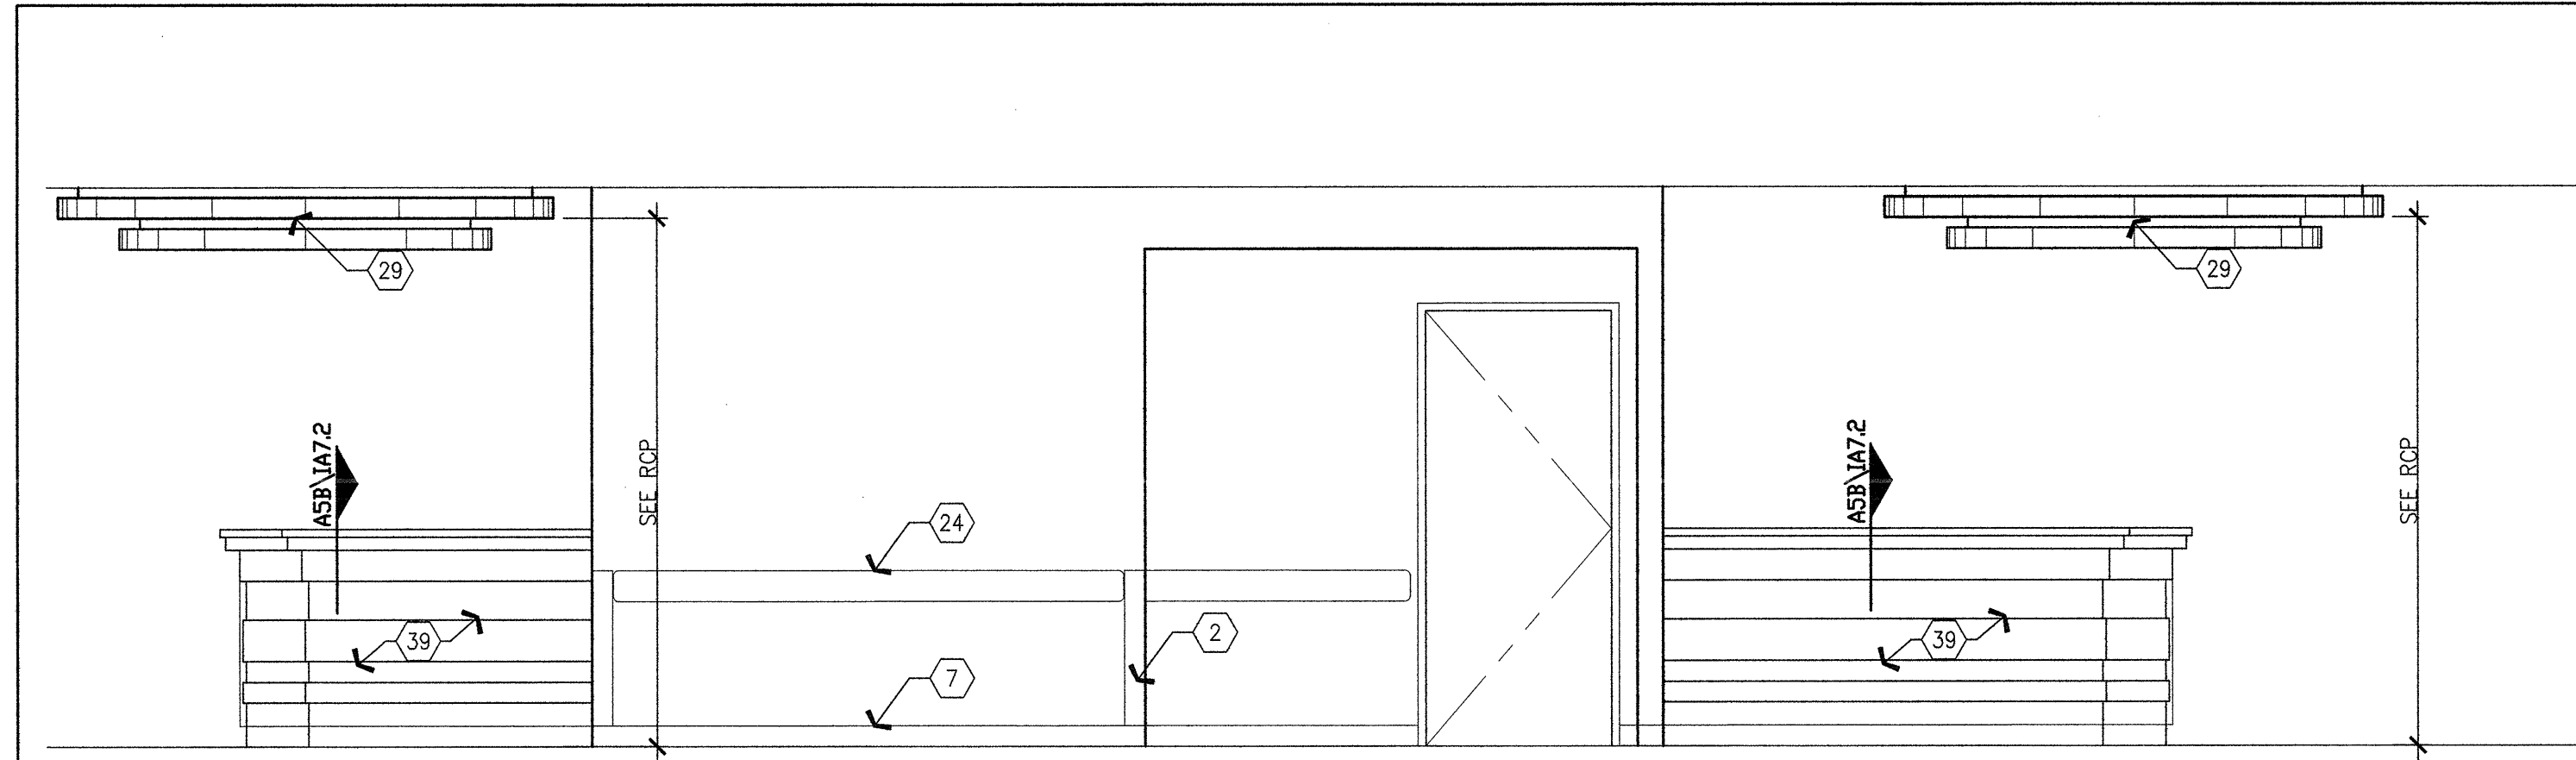


E6 NURSE STATION NORTH SIDE

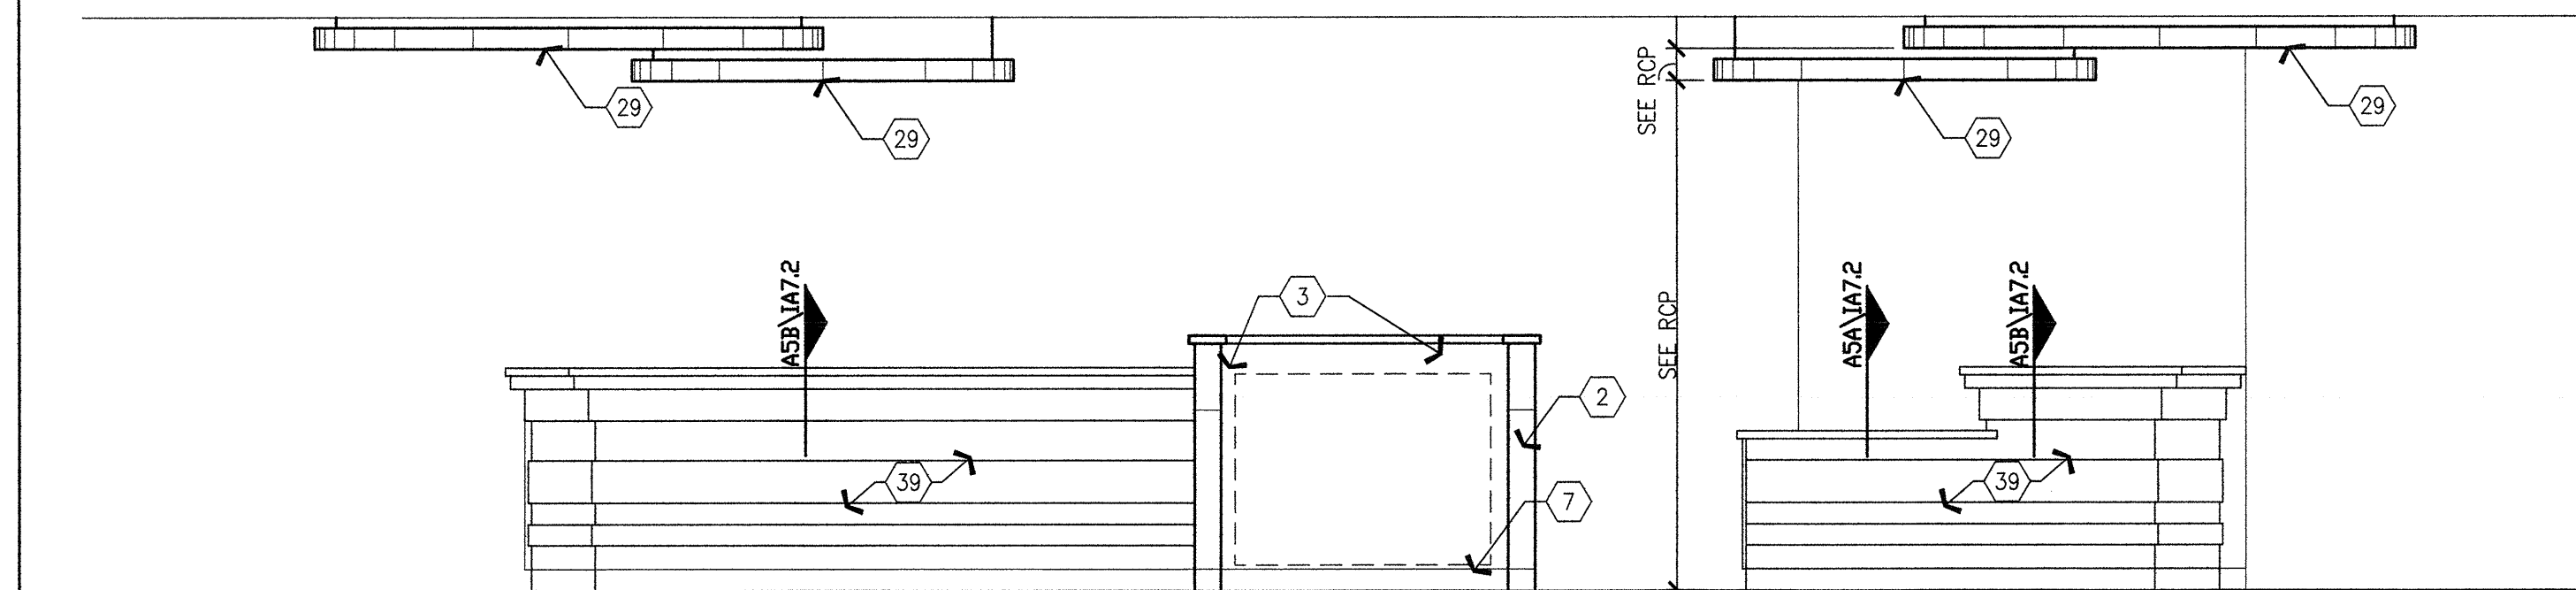


D6 NURSE STATION EAST SIDE

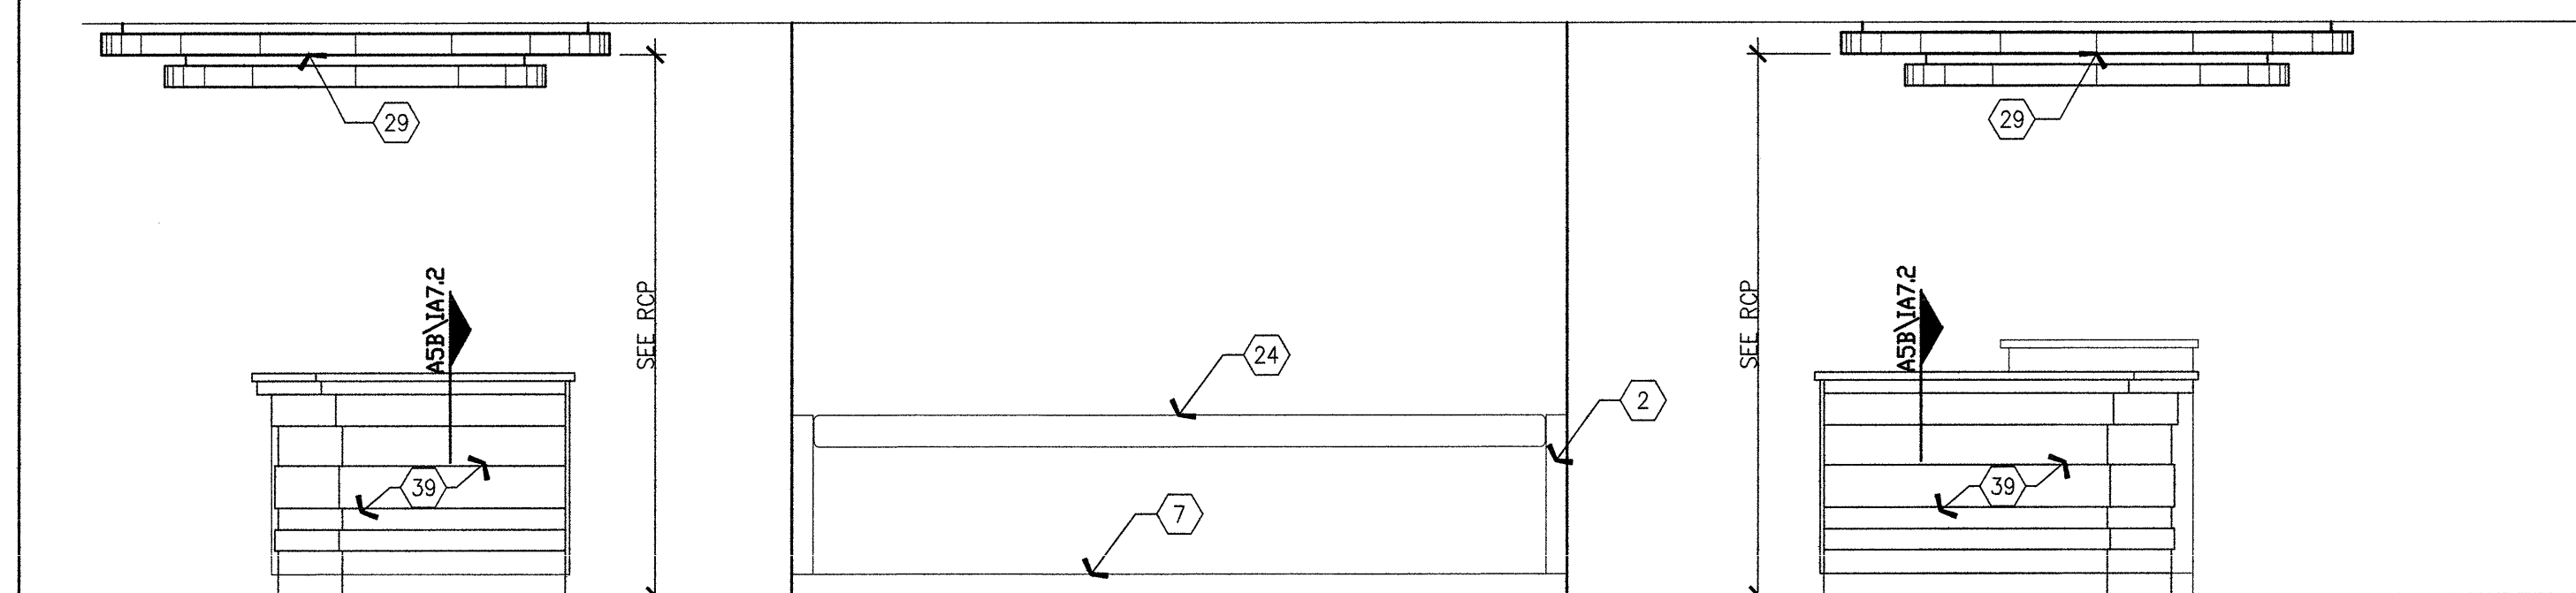

C6 NURSE STATION SOUTH SIDE

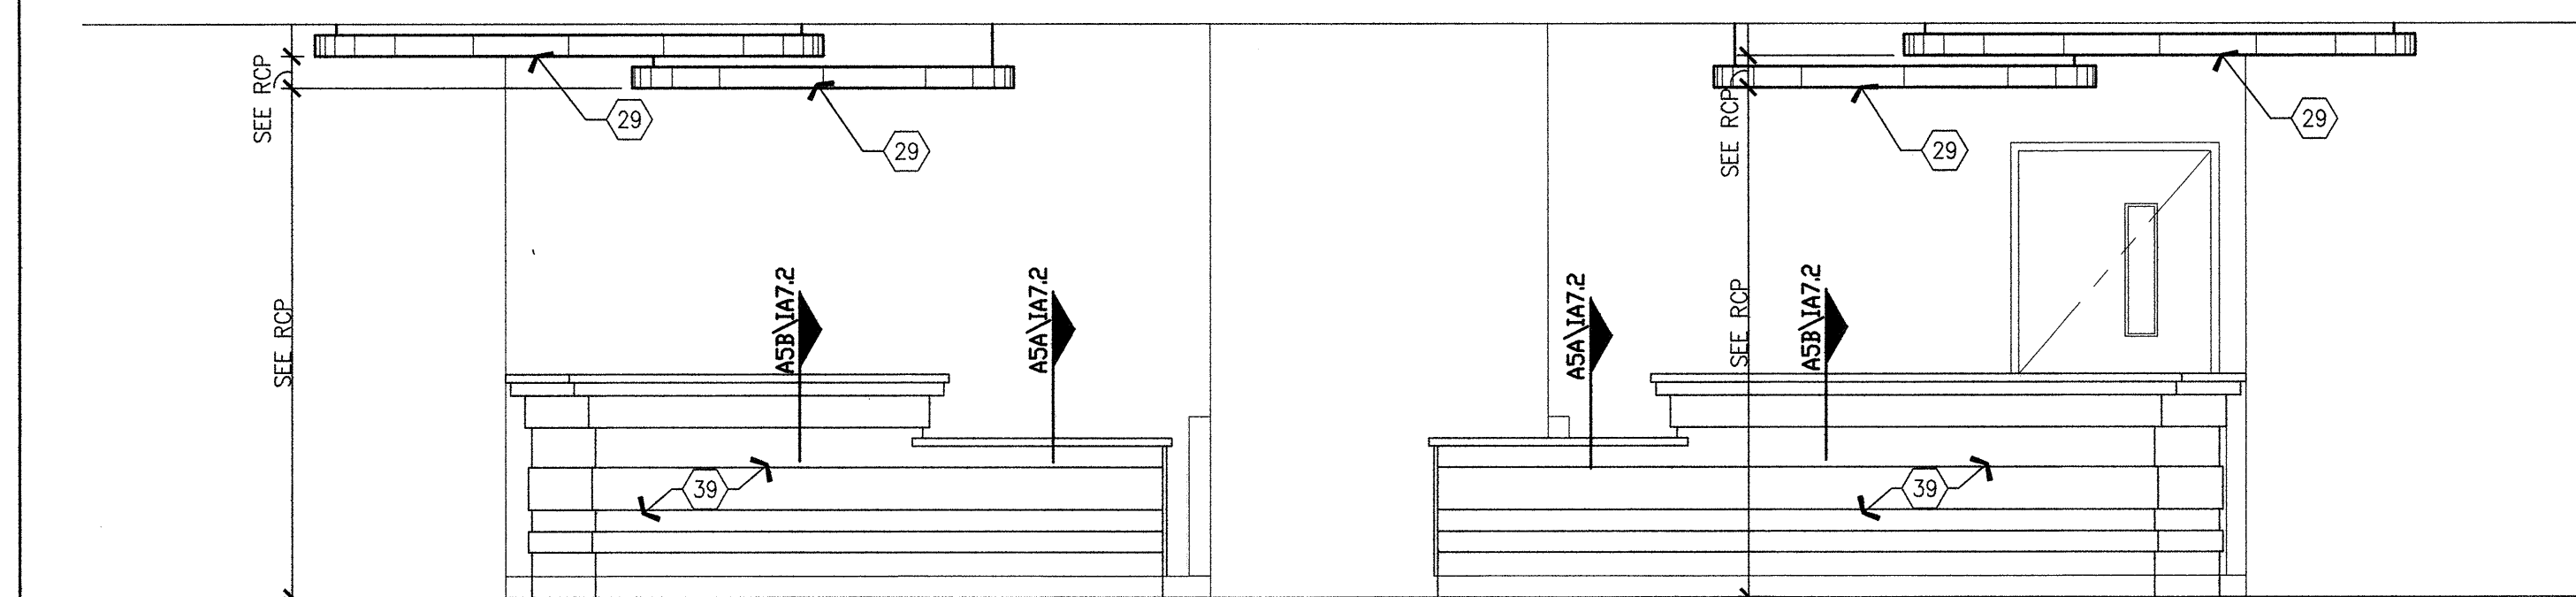


B6 NURSE STATION WEST SIDE

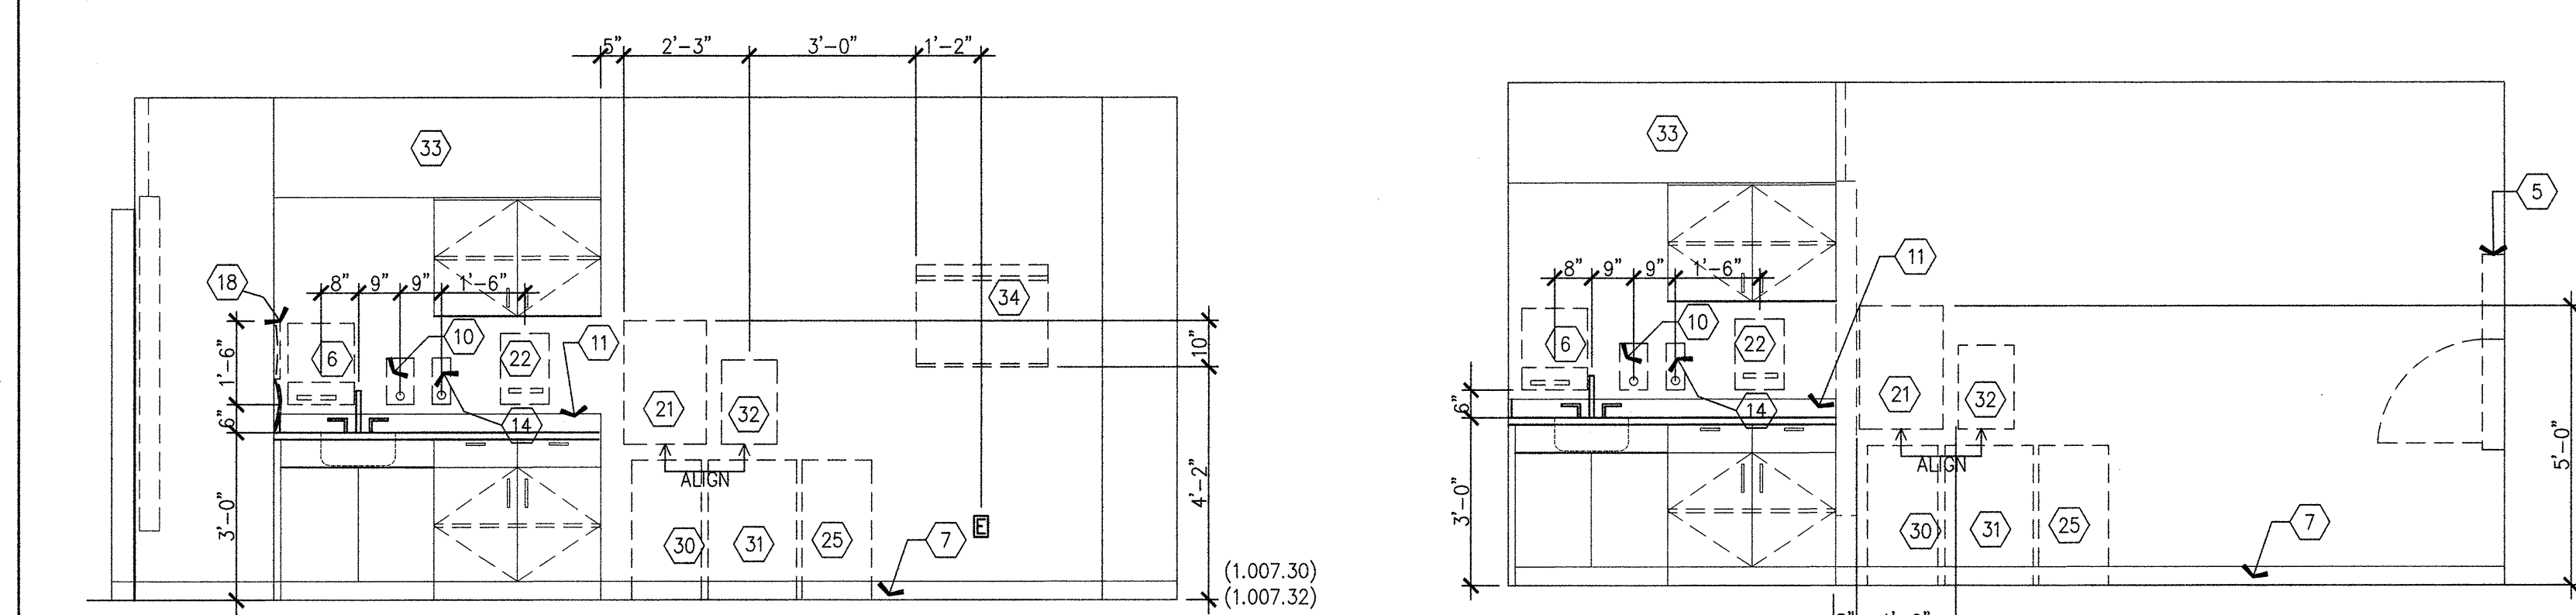


A6 TYPICAL TRAUMA ROOM (1.070.30) SIDE WALL


A5 TYPICAL EXAM ROOM (1.070.74) SIDEWALL

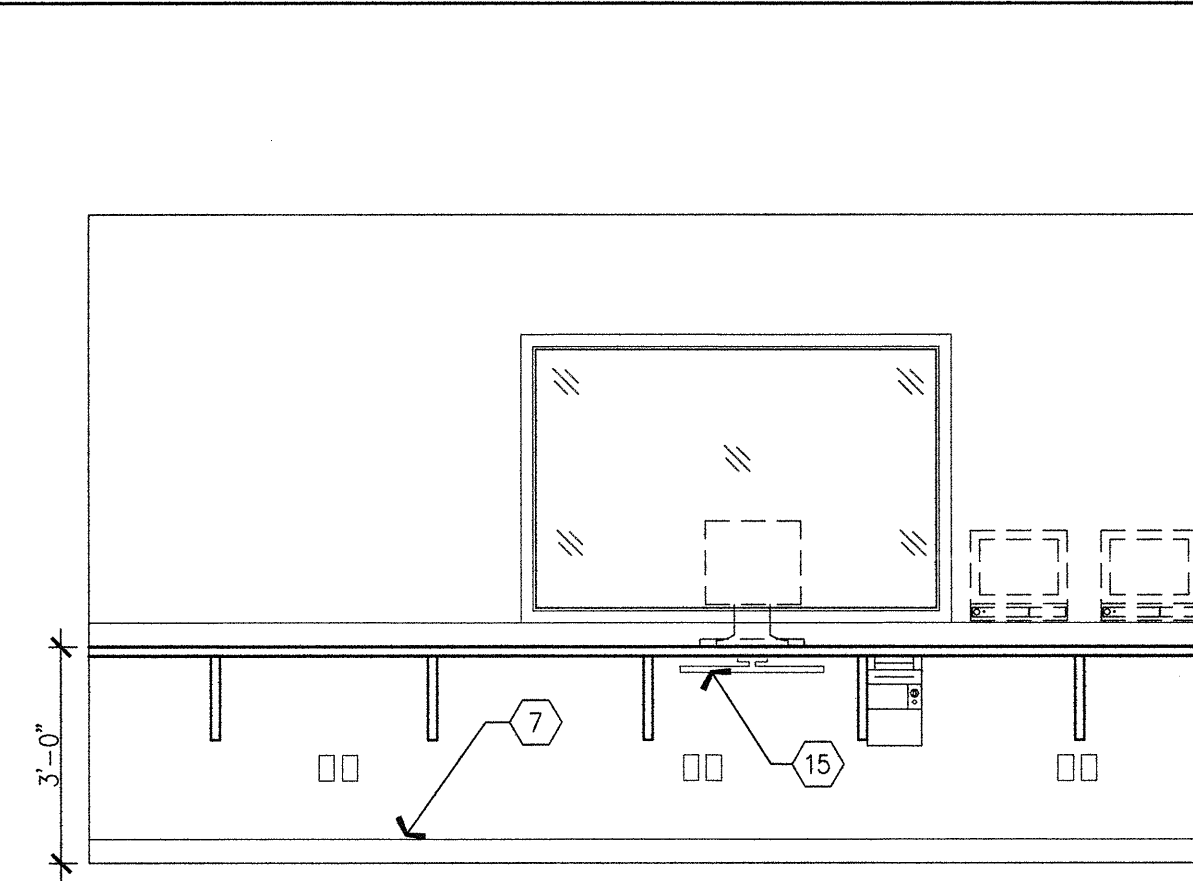


E3 MRI CONTROL (1.007.30) SOUTH WALL

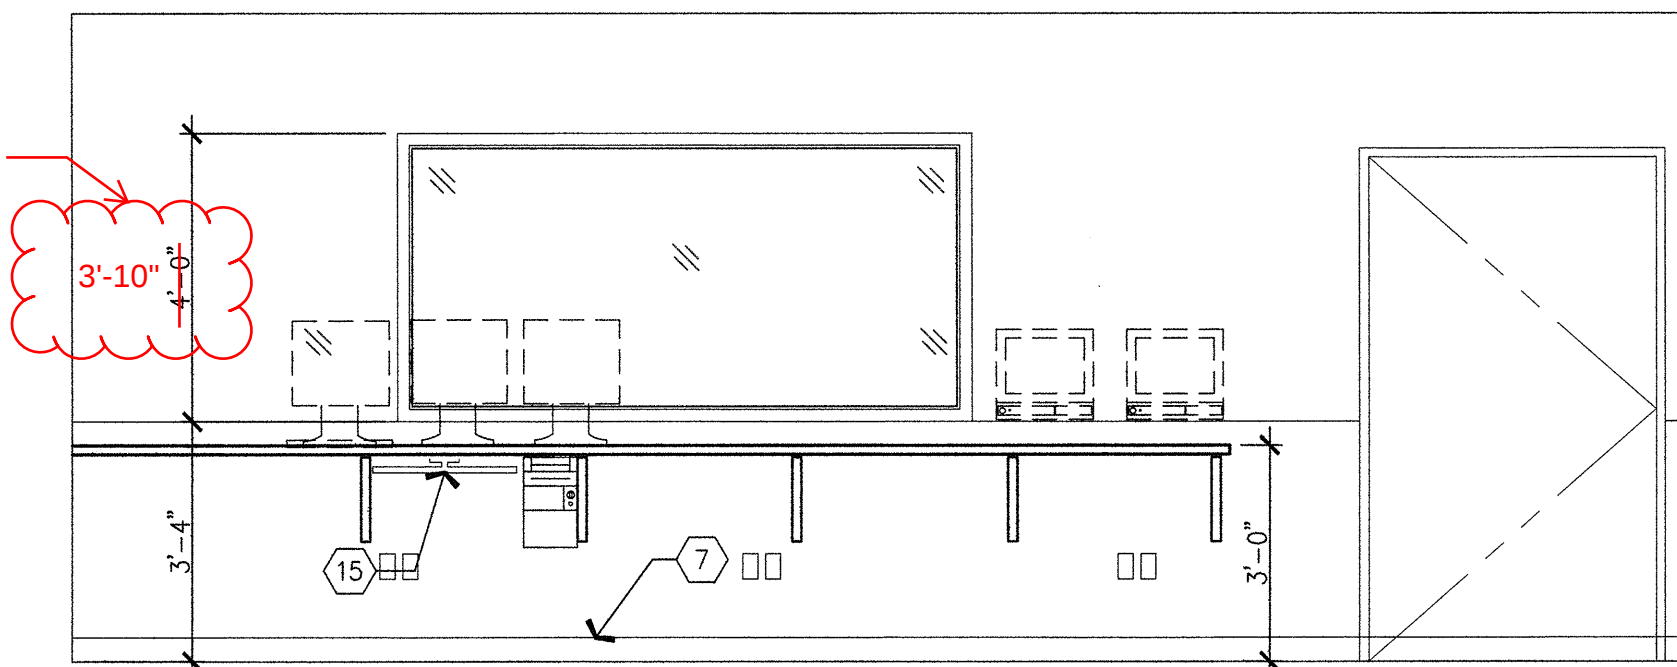


D3 CT CONTROL (1.007.31) EAST WALL

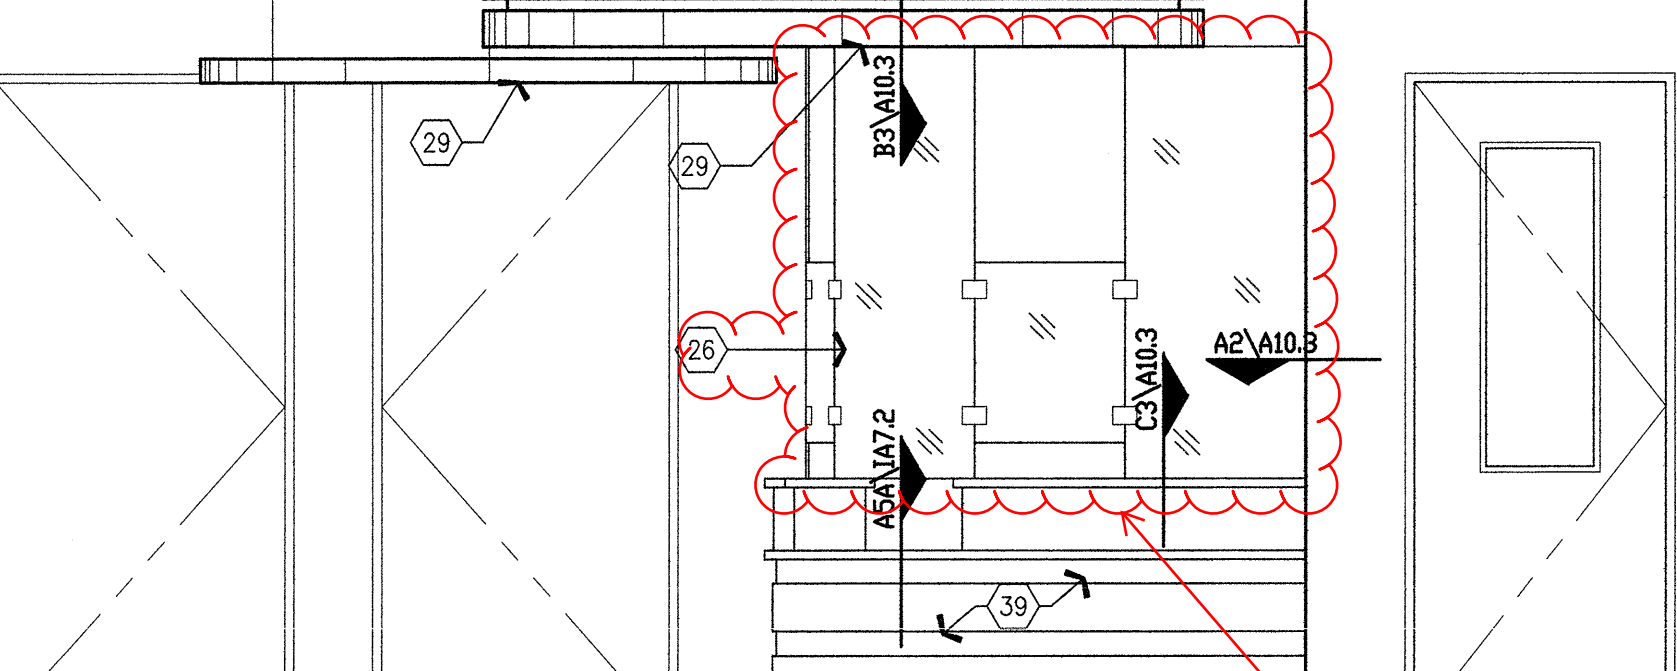


C3 RECEPTION (1.070.55.A) WEST WALL

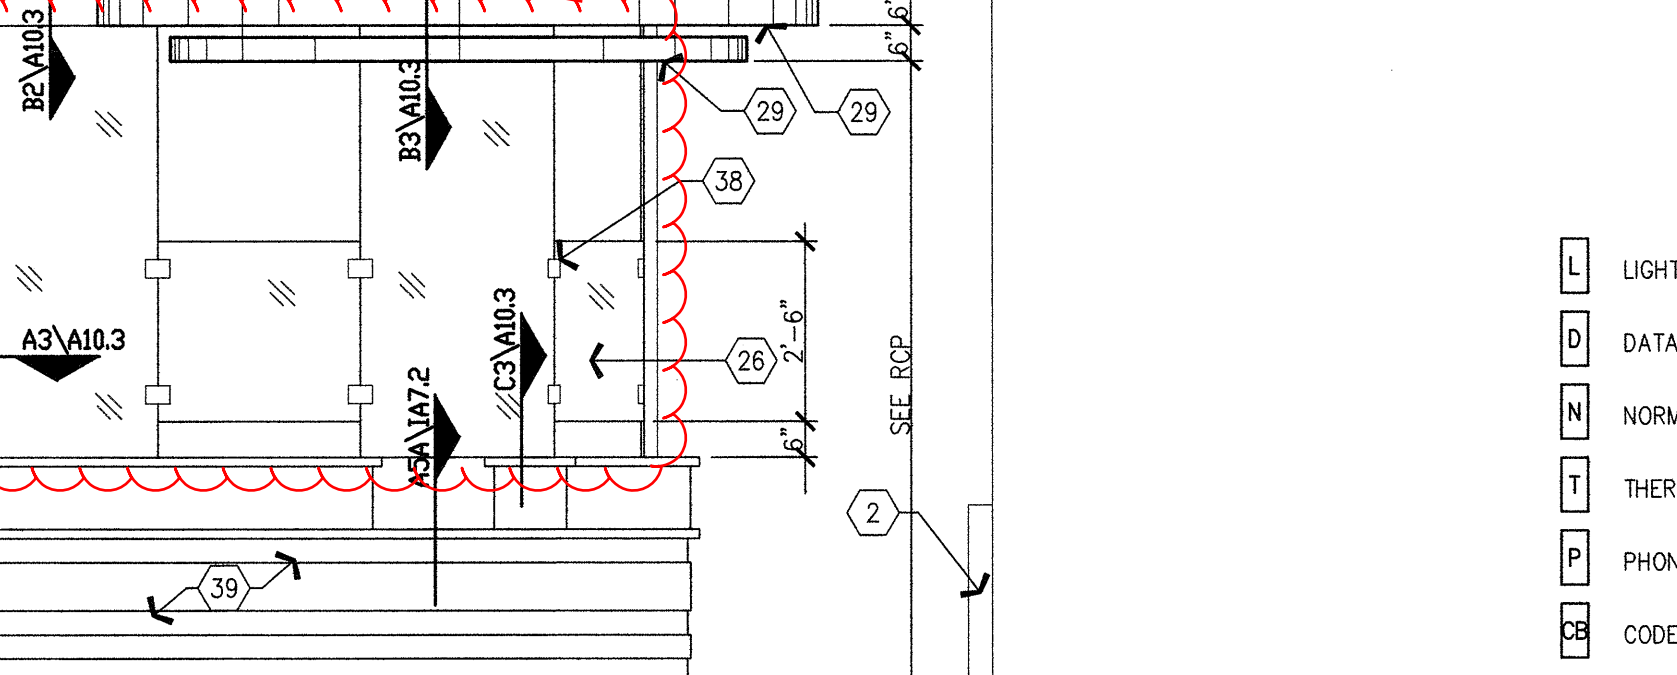


B3 RECEPTION (1.070.55.A) SOUTH SIDE

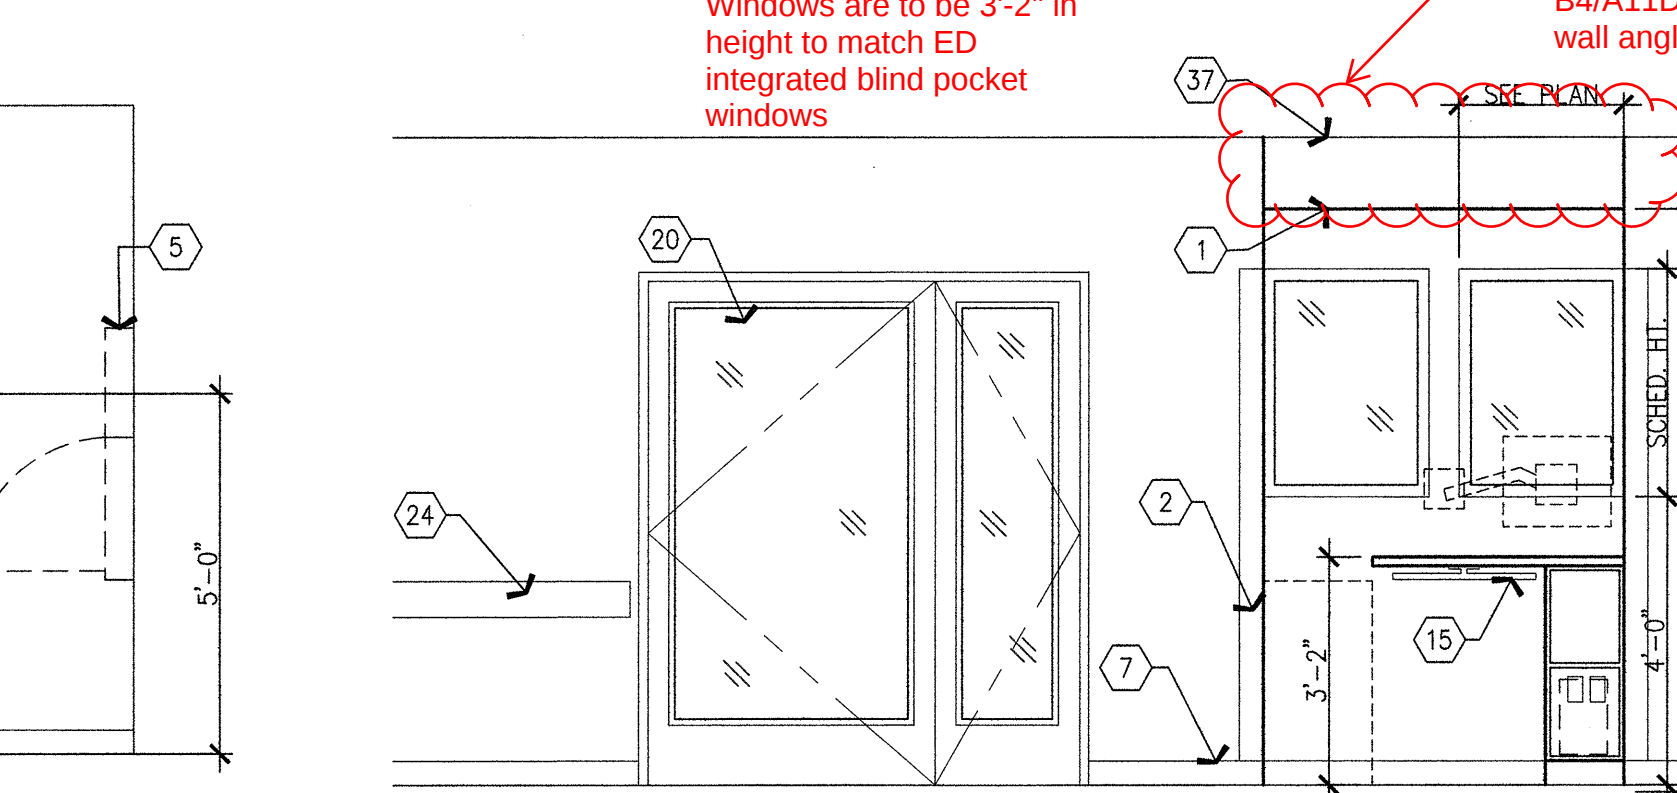


A3 BESIDE NURSE STATION (1.070.30.A) NORTH WALL

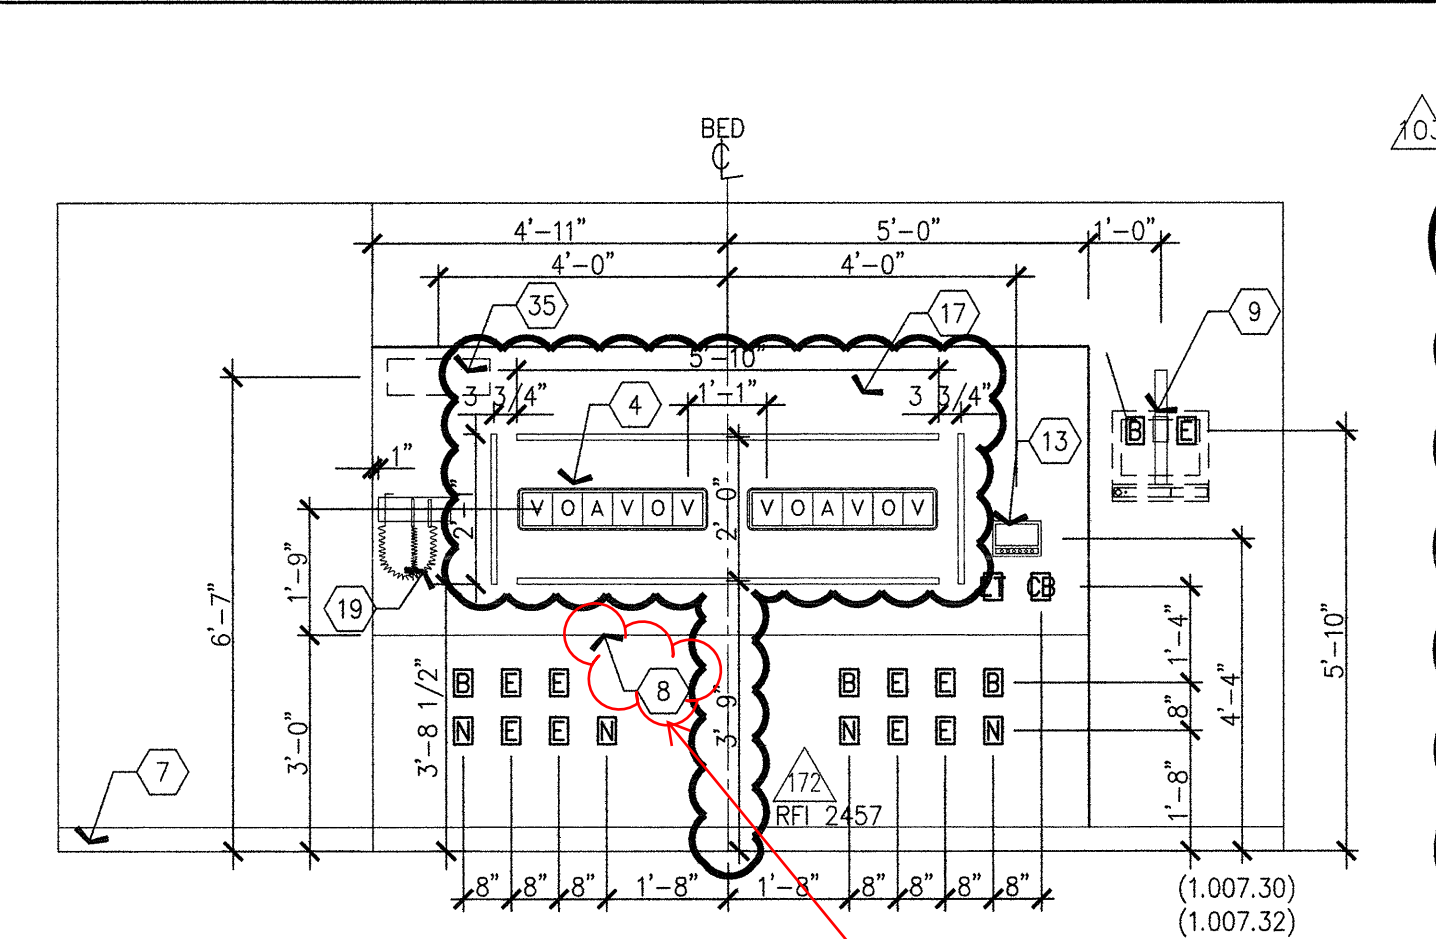


E2 TYP. TRAUMA RM (1.070.30) HEADWALL

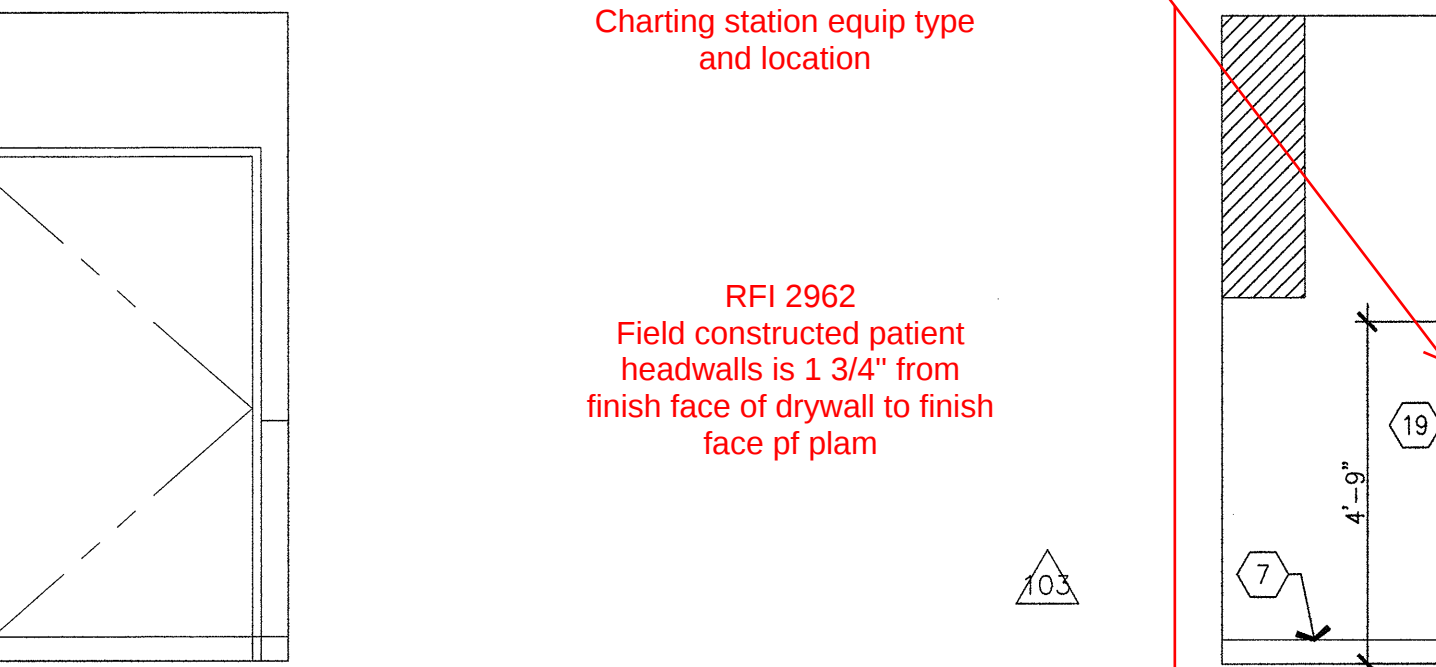


D2 TYP. TRAUMA RM (1.070.30) HEADWALL

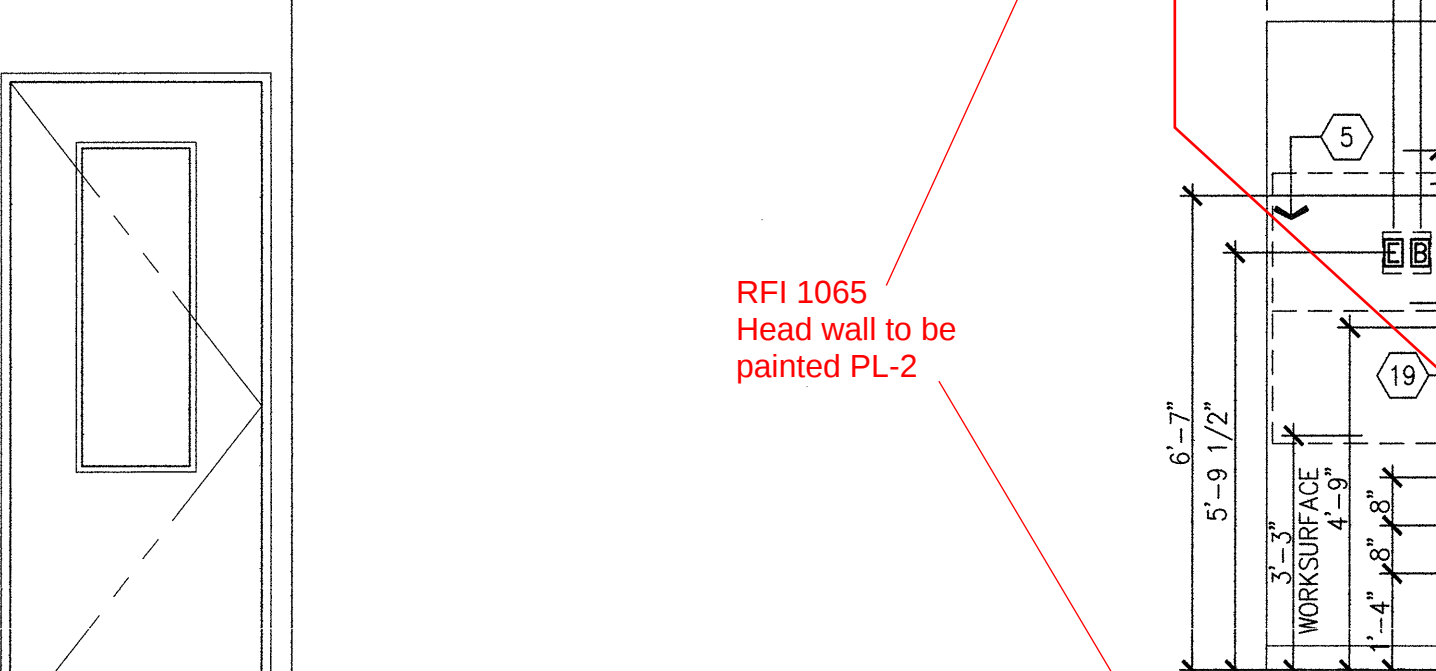


C2 TYP. TRAUMA RM (1.070.30) HEADWALL

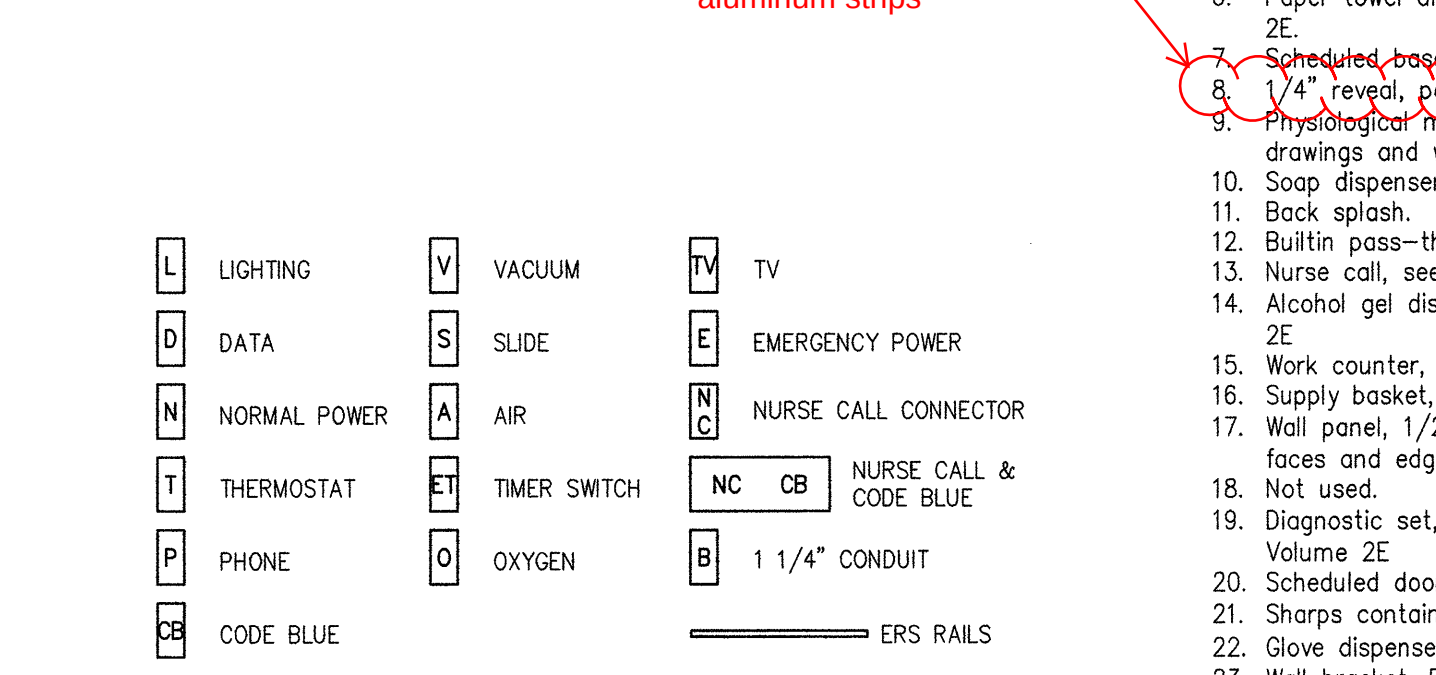


B2 LEGEND

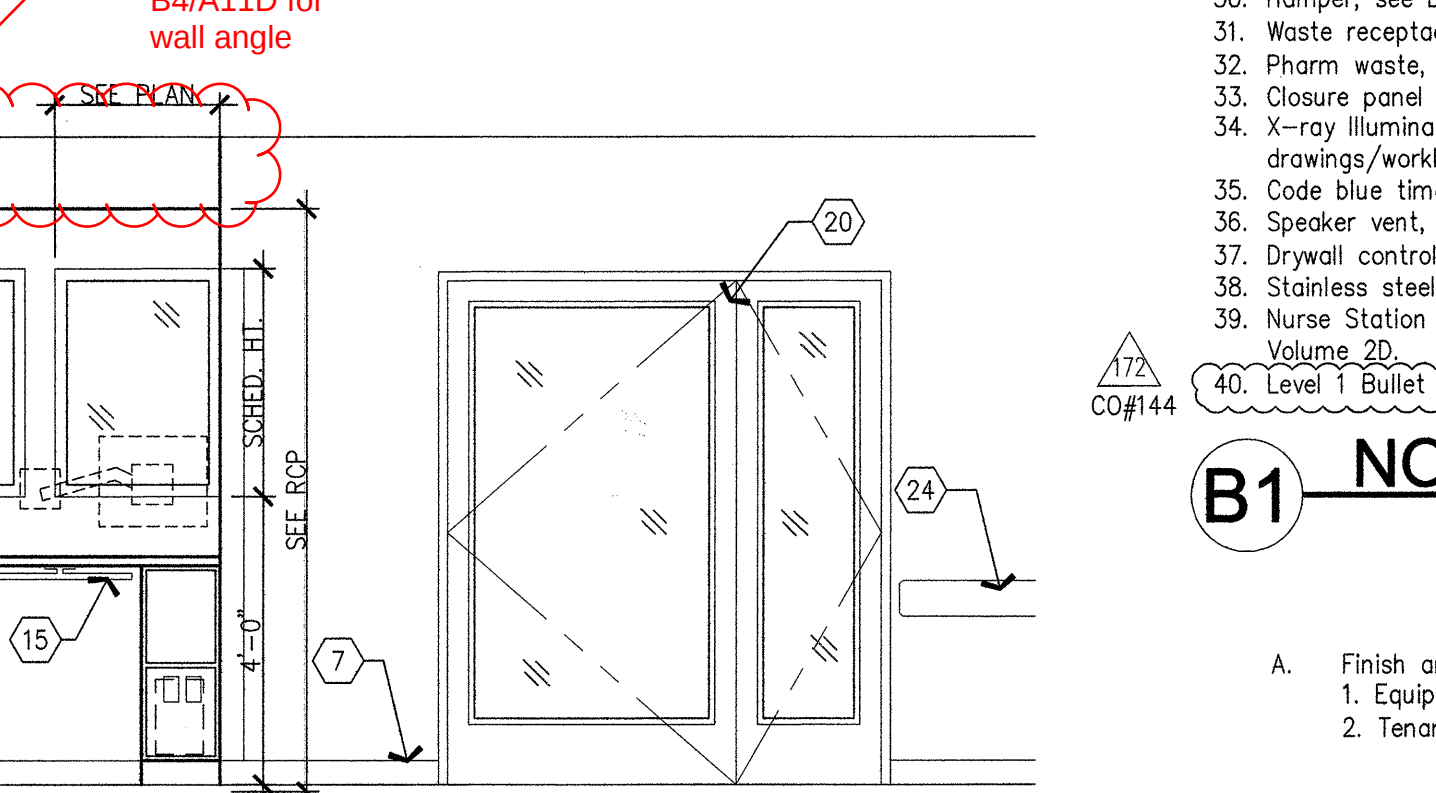


A3 BESIDE NURSE STATION (1.070.30.A) NORTH WALL

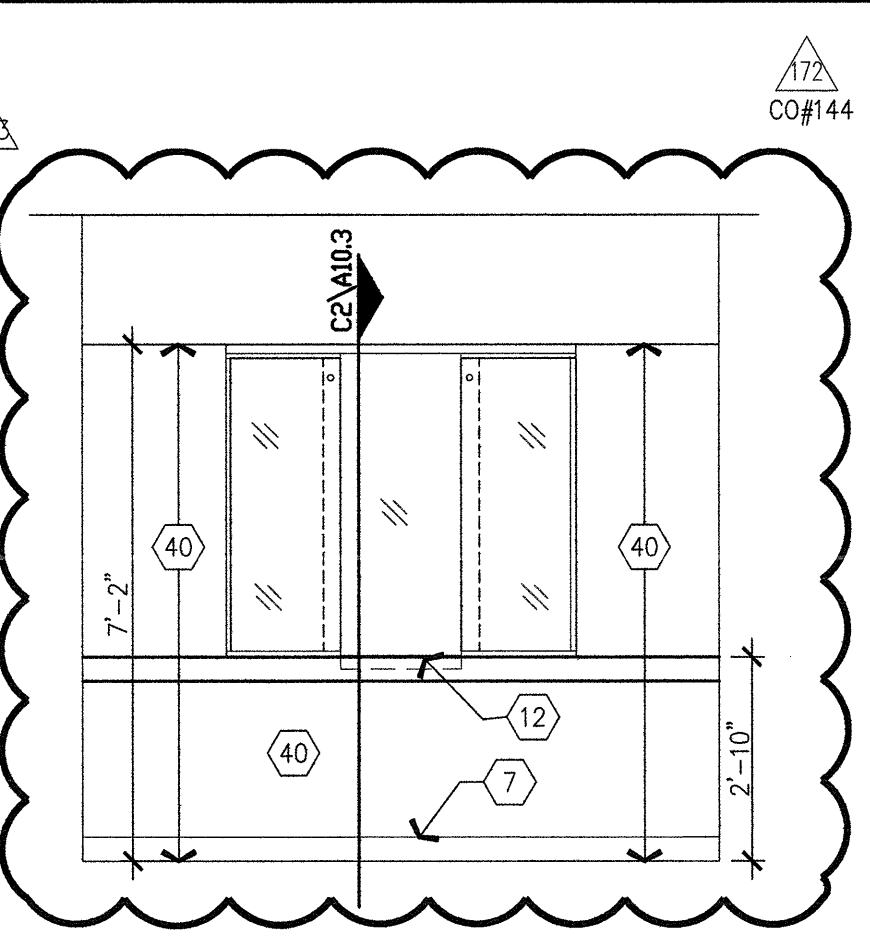


E1 TYPICAL CASHIER

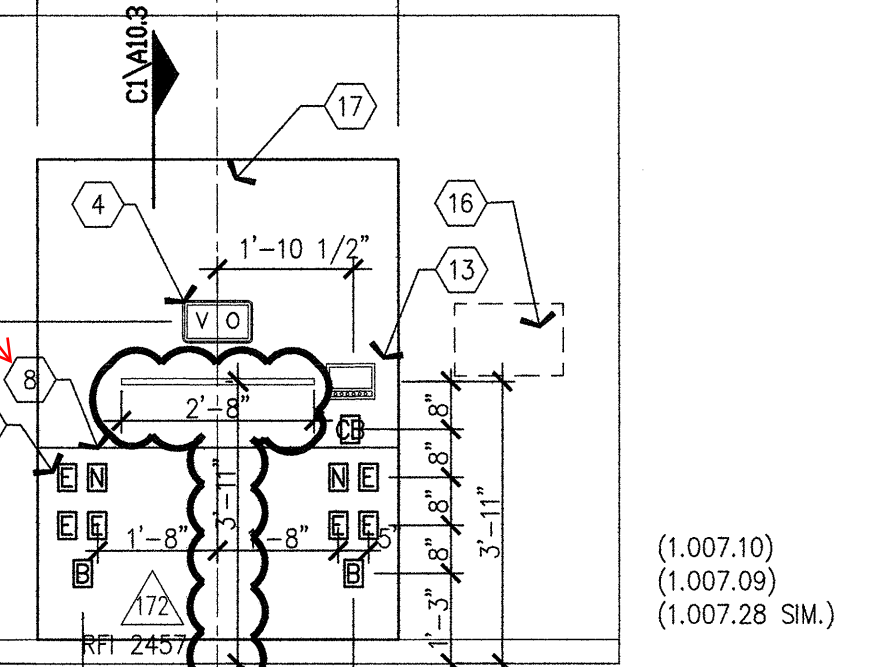


D1 TYPICAL US (1.007.09) HEADWALL

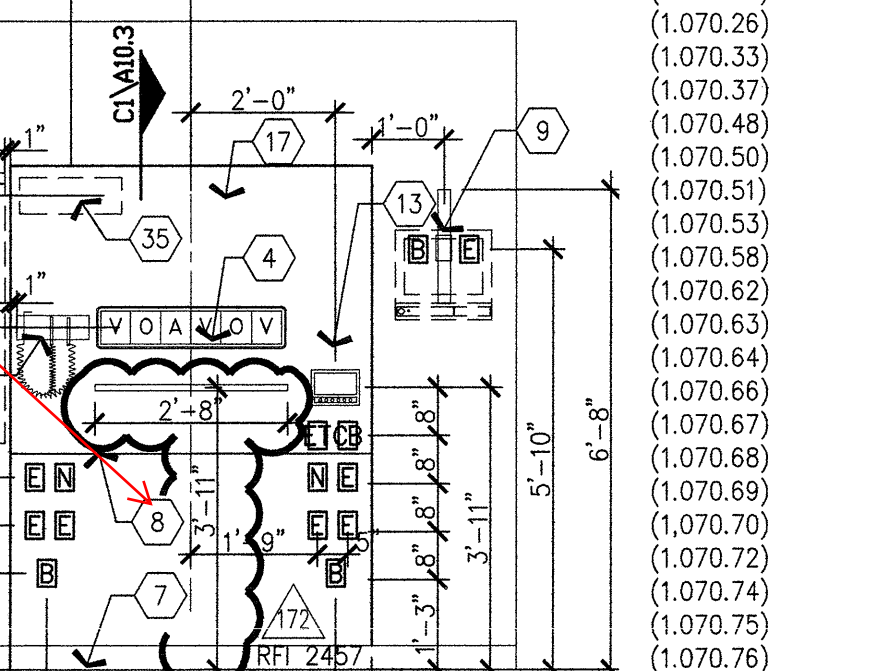

C1 TYPICAL EXAM HEADWALL

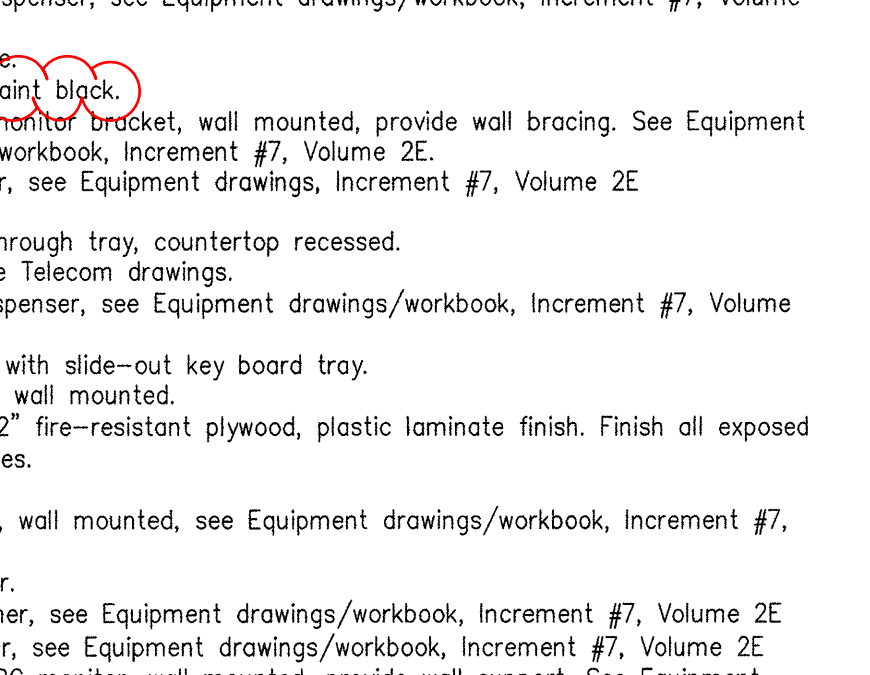

B1 NOTES TO SHEET

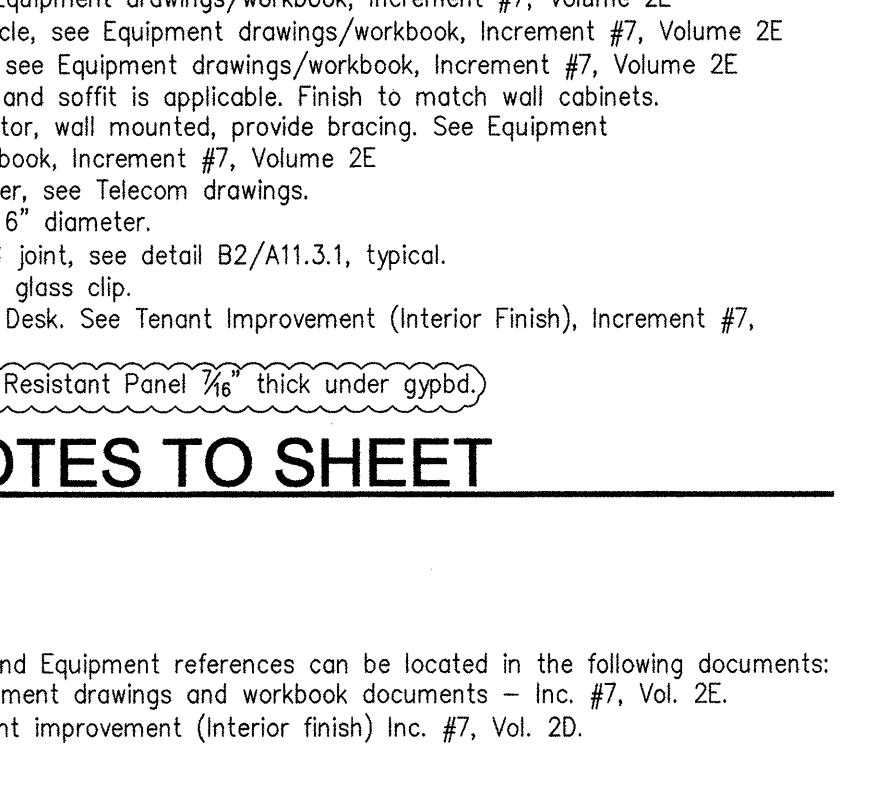

A1 GENERAL NOTES