

FKP Architects

ARCHITECT OF RECORD
Paul C. Gloriod




Changes on these drawings do not consist of
materially altered changes to approved drawings
and don't require a change order.
OSHPD review AGO _____
OSHPD review FLSO _____
OSHPD review DSE _____

REVISIONS

495 04/04/12 ASI #196

APPROVAL

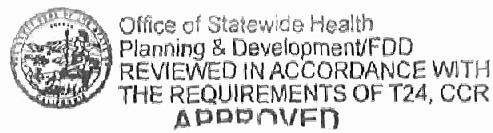

CHANGE ORDER# _____
INSTRUCTION BULLETIN# _____
DEFERRED APPROVAL# _____
(if required)

PROJECT NAME

CHILDREN'S HOSPITAL
OF ORANGE COUNTY

455 S. Main St.
Orange, CA 92668-3874

TOWER II



PROJECT NUMBER

12011.00
Increment #7

OSHPD - PROJECT NUMBER

IL 072072-30

ISSUE

OSHPD PERMIT

DATE

01/27/2010

SCALE

3/8" = 1'-0"

DRAWING TITLE

SECOND FLOOR INTERIOR
ELEVATIONS


DRAWING NUMBER

A9.2F




ASI 196

- 1 SCHEDULED BASE.
- 2 4" CHAIR RAIL, WOOD. SEE INTERIORS.
- 3 CHARTING STATION. SEE EQUIPMENT DRAWINGS AND WORKBOOK. SEE A1/S3.6.
- 4 HOLD FABRIC WRAPPED PANELS 2" FROM EDGE OF WALL DEVICES.
- 5 SECURITY CAMERA. SEE SECURITY AND ELECTRICAL DRAWINGS.
- 6 ELECTRICAL/ DATA OUTLET AND REMOTE CONTROL SYSTEM WALL DEVICES.
- 7 FABRIC WRAPPED WALL PANEL.
- 8 ELECTRICAL/ DATA OUTLET (FOR CHARTING STATION) AT 48" A.F.F.

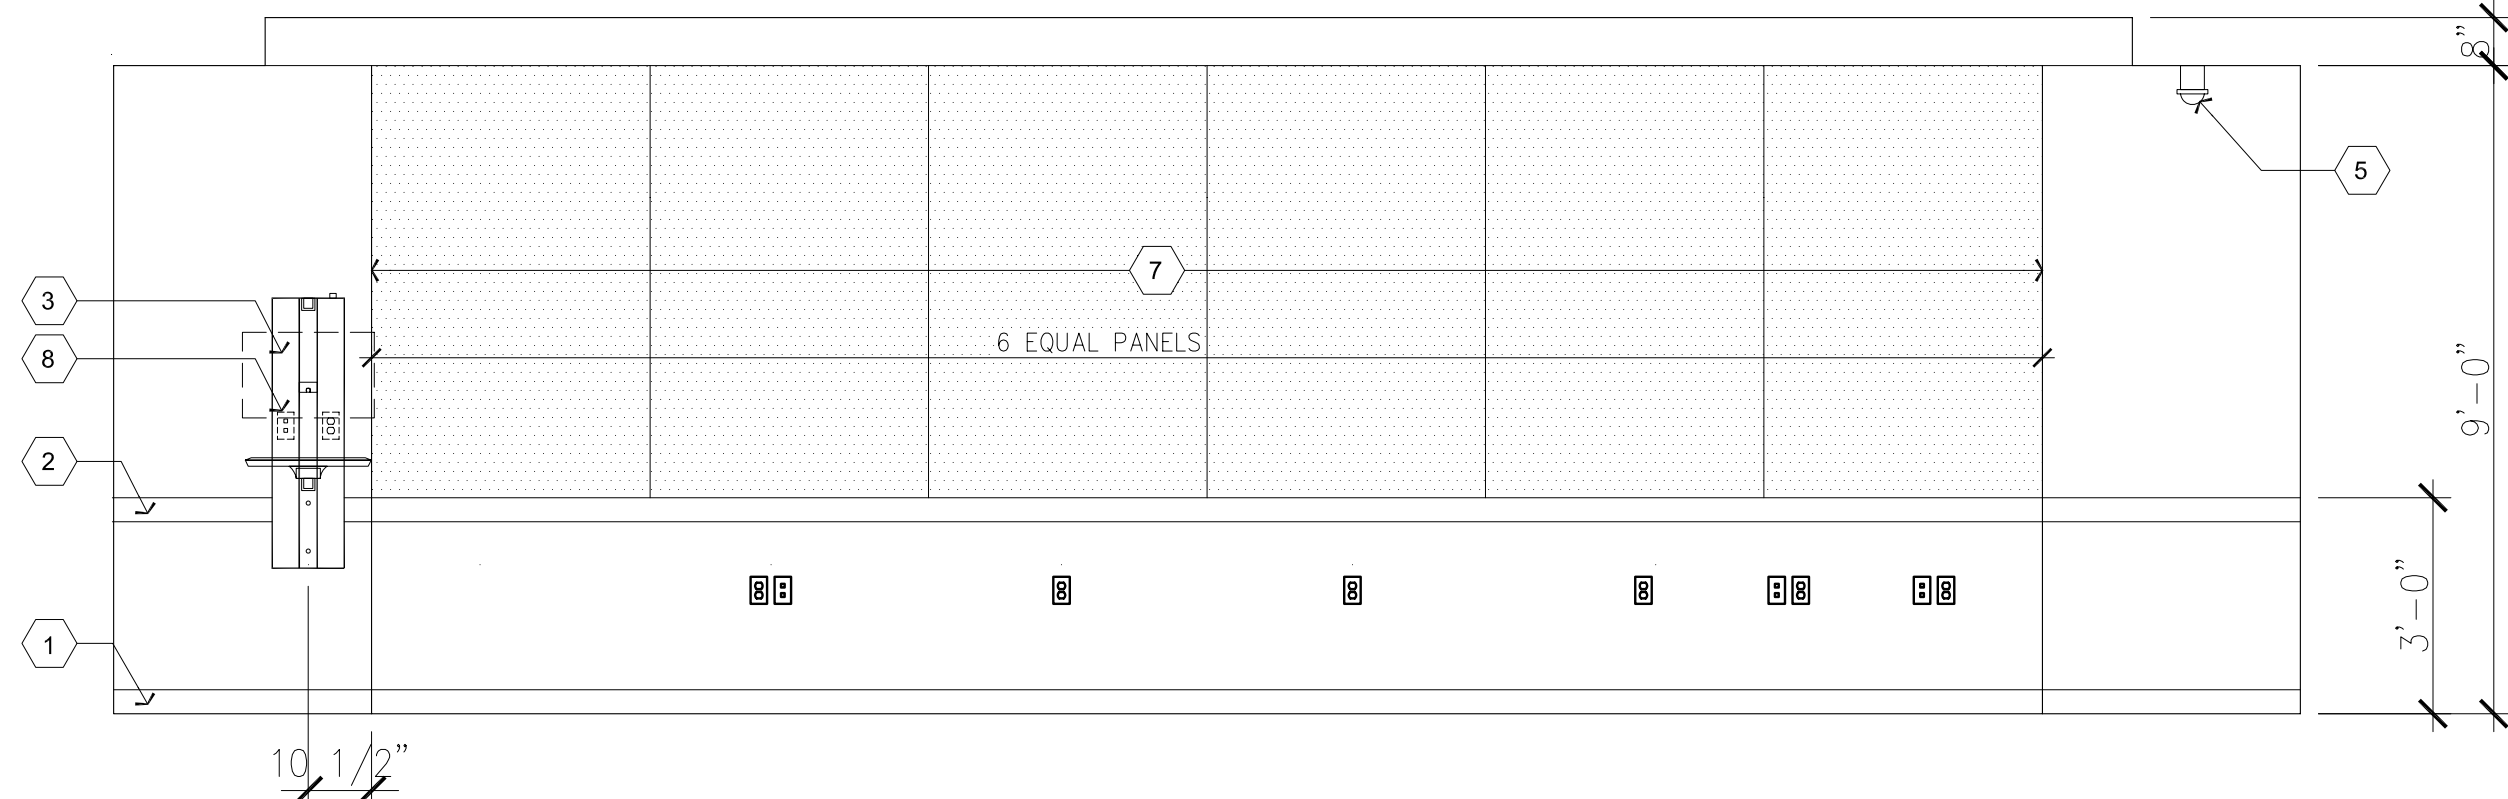

A6 CONFERENCE ROOM 2.028.11 - NORTH
3/8" = 1'-0"

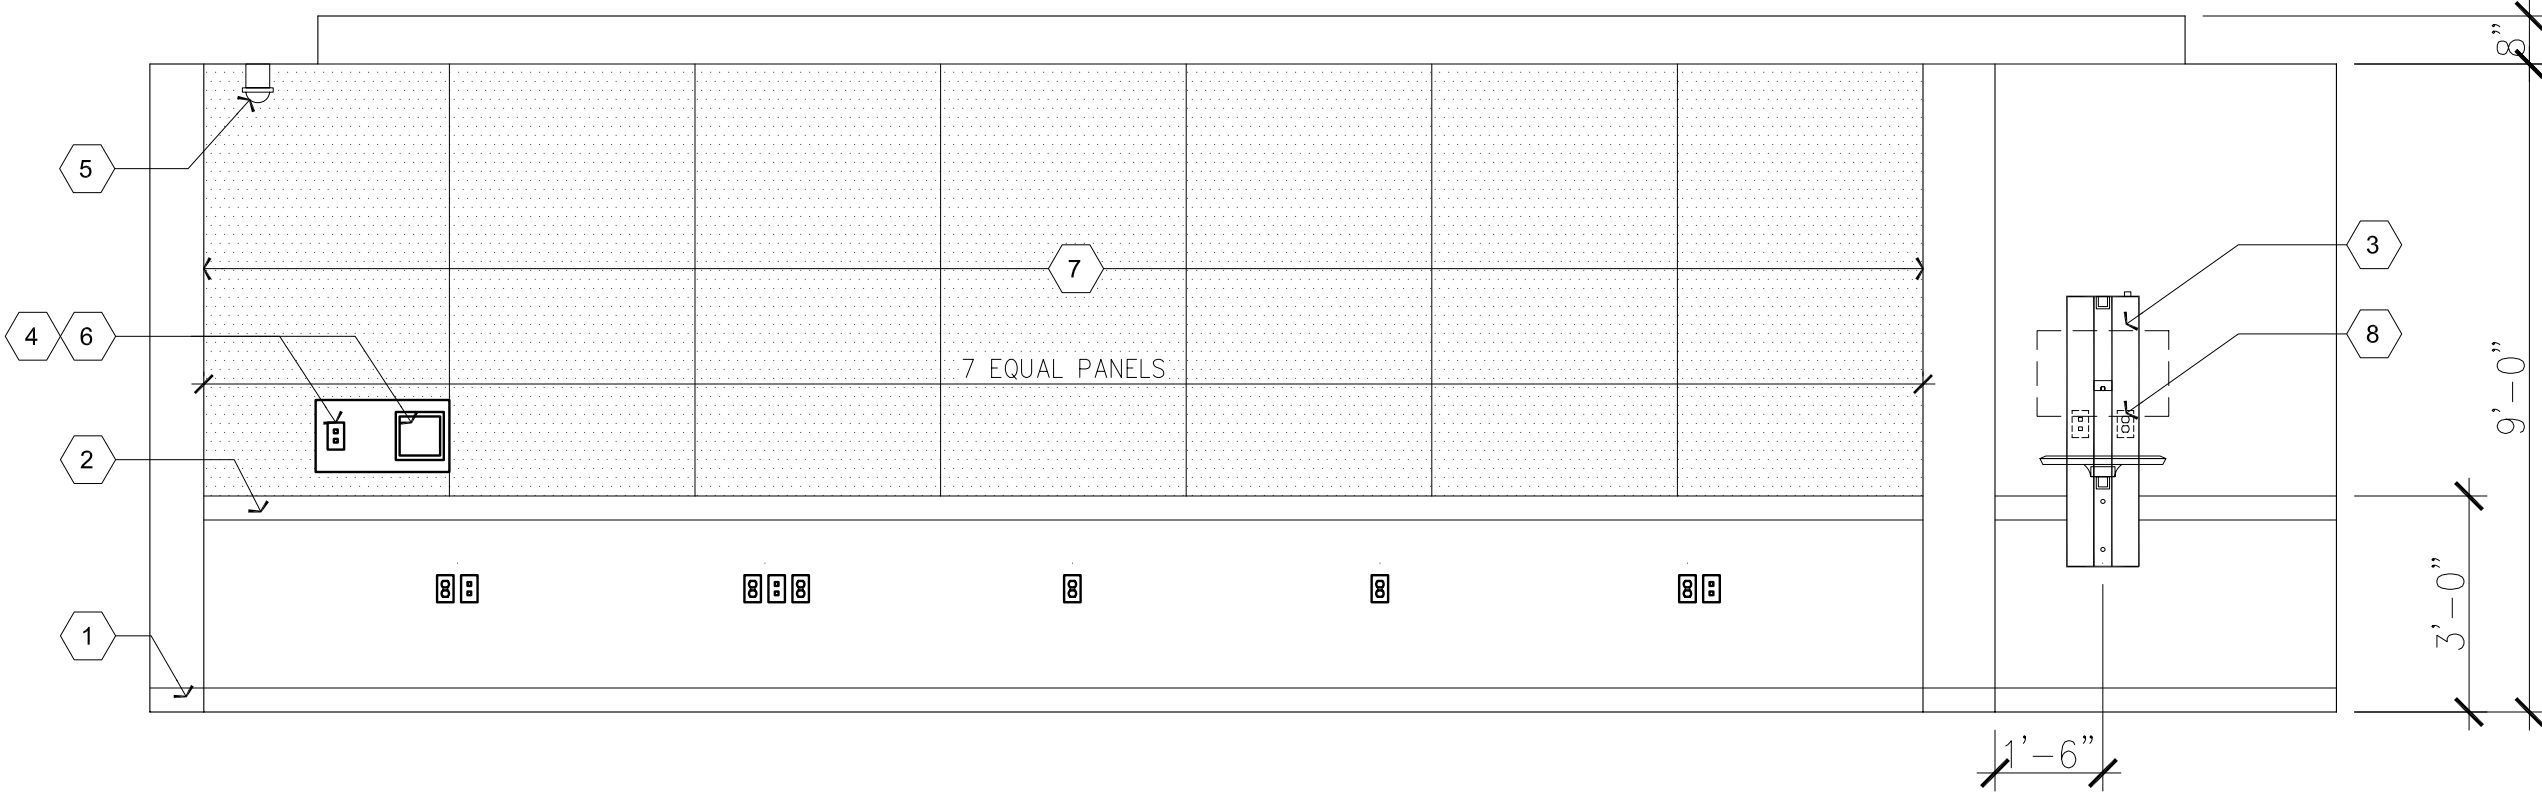

A2 CONFERENCE ROOM 2.028.11 - SOUTH
3/8" = 1'-0"

A1 KEYED NOTES TO SHEET