


FKP Architects

ARCHITECT OF RECORD
Paul C. Gloriot

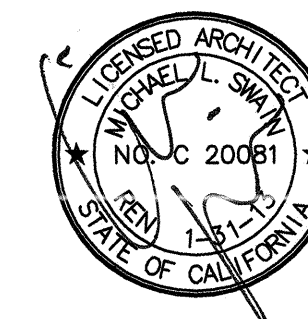

Changes on these drawings do not consist of materially altered changes to approved drawings and don't require a change order.
OSHDP review ACO
OSHDP review FLSO
OSHDP review DSE


REVISIONS

44	05/28/10	ASI #08
71	08/06/10	CO#82
103	10/25/10	CO #87
114	10/29/10	CO#83
219	05/26/11	CO #170
29	07/18/11	CO #226

RFI 2485
Charting station
equipment type
and location

RFI 2505
Headwall
coordination

APPROVAL

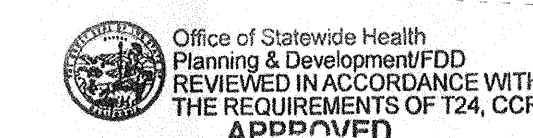

CHANGE ORDER: **CO#226**
INSTRUCTION BULLETIN
DEFERRED APPROVAL
INDEMNITY

PROJECT NAME

CHILDREN'S HOSPITAL
OF ORANGE COUNTY

455 S. Main St.
Orange, CA 92668-3874

RECEIVED
TOWER II August 08 2011
McCarthy



PROJECT NUMBER

12011.00
Increment #7

OSHDP - PROJECT NUMBER

IL 072072-30

ISSUE

OSHDP PERMIT

DATE

01/27/2010

SCALE

3/8" = 1' - 0"

DRAWING TITLE

THIRD FLOOR INTERIOR
ELEVATIONS

DRAWING NUMBER

12011.00

A9.3A

