


FKP Architects

ARCHITECT OF RECORD
Paul C. Gloriod

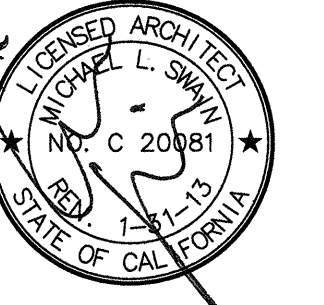


Changes on these drawings do not consist of
materially alter changes to approved drawings
and don't require a change order.
OSHPD review ACC
OSHPD review FLSO
OSHPD review DSE

REVISIONS

6A 08/08/11 CO #135

APPROVAL

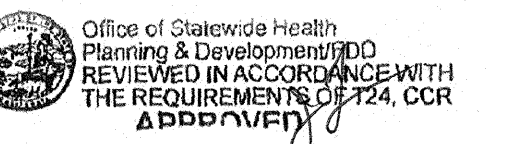

CHANGE ORDER 135
INSTRUCTION BULLETIN
DEFERRED APPROVAL
ADDENDUM

PROJECT NAME

CHILDREN'S HOSPITAL
OF ORANGE COUNTY

455 S. Main St.
Orange, CA 92668-3874

TOWER II RECEIVED
SEPT. 21 2011
McCARTHY



PROJECT NUMBER

12011.00
Increment #7

OSHPD - PROJECT NUMBER
IL 072072-30

ISSUE
OSHPD PERMIT


DATE
01/27/2010

SCALE
3/8" = 1'-0"


DRAWING TITLE
LEVEL 2-3-5 DEMO PLANS

DRAWING NUMBER


AD1.2

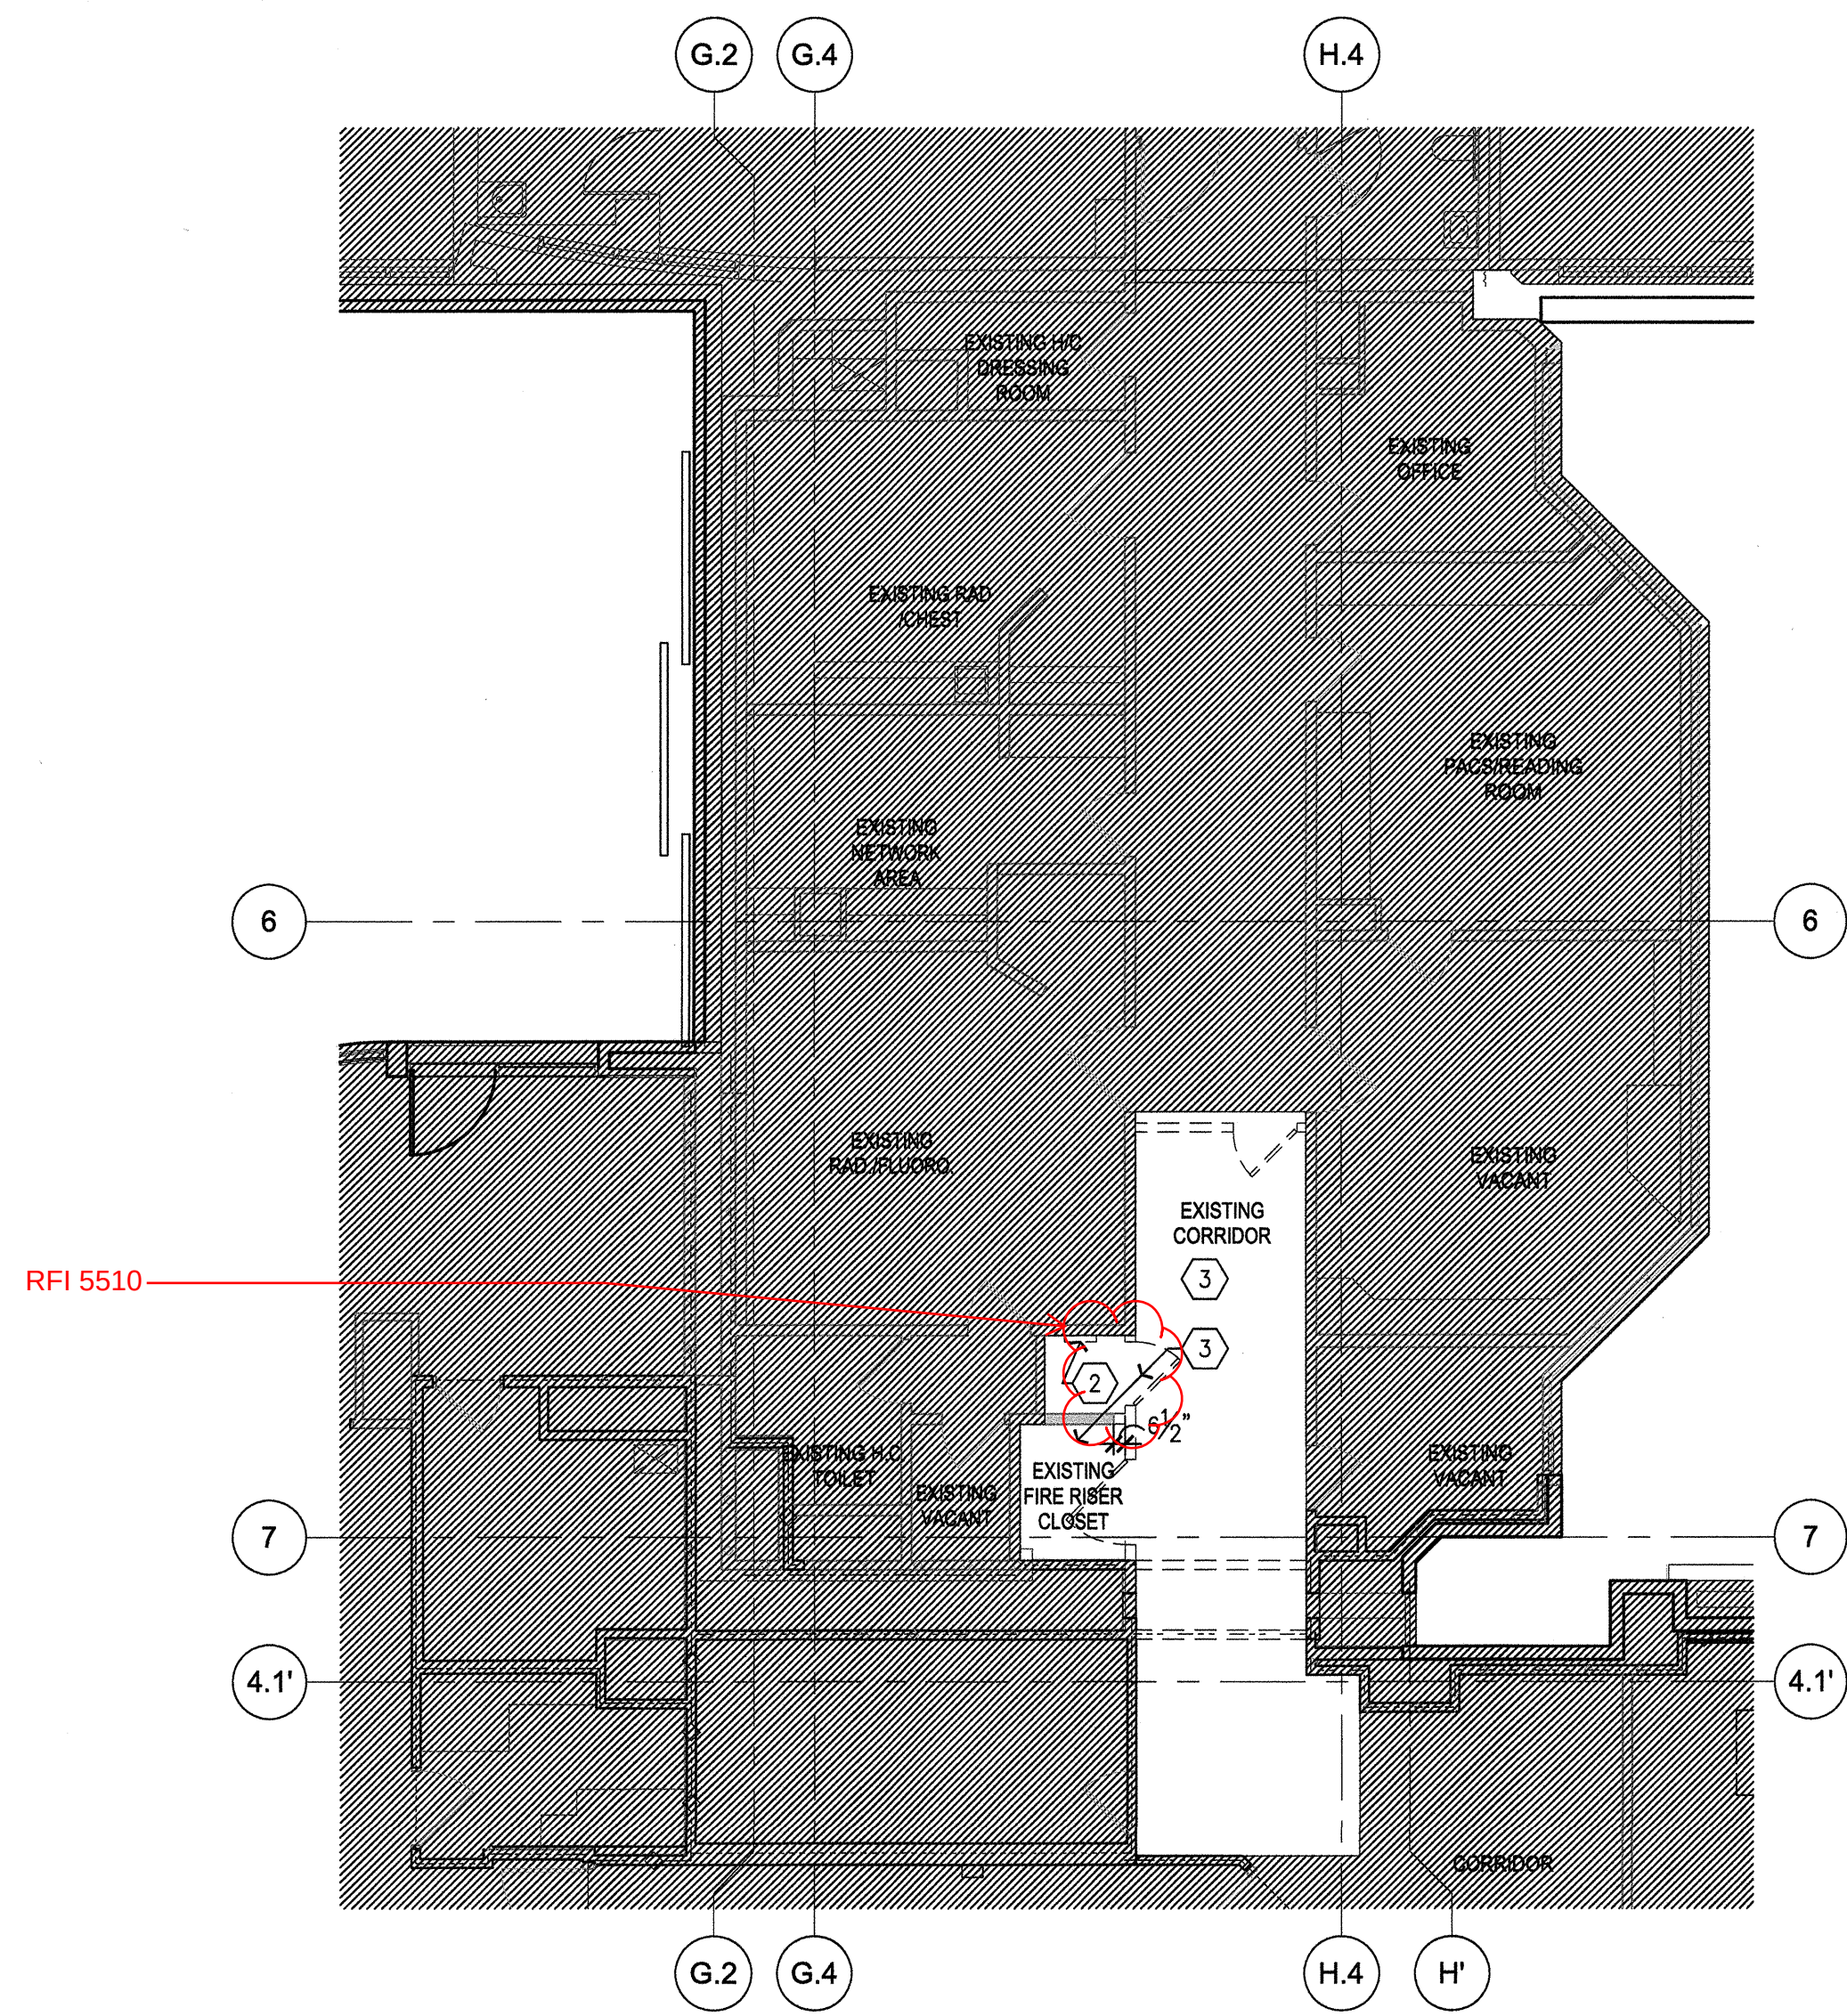


C5 DEMOLITION - LEVEL 2 - PHASE I
1/8" = 1'-0"

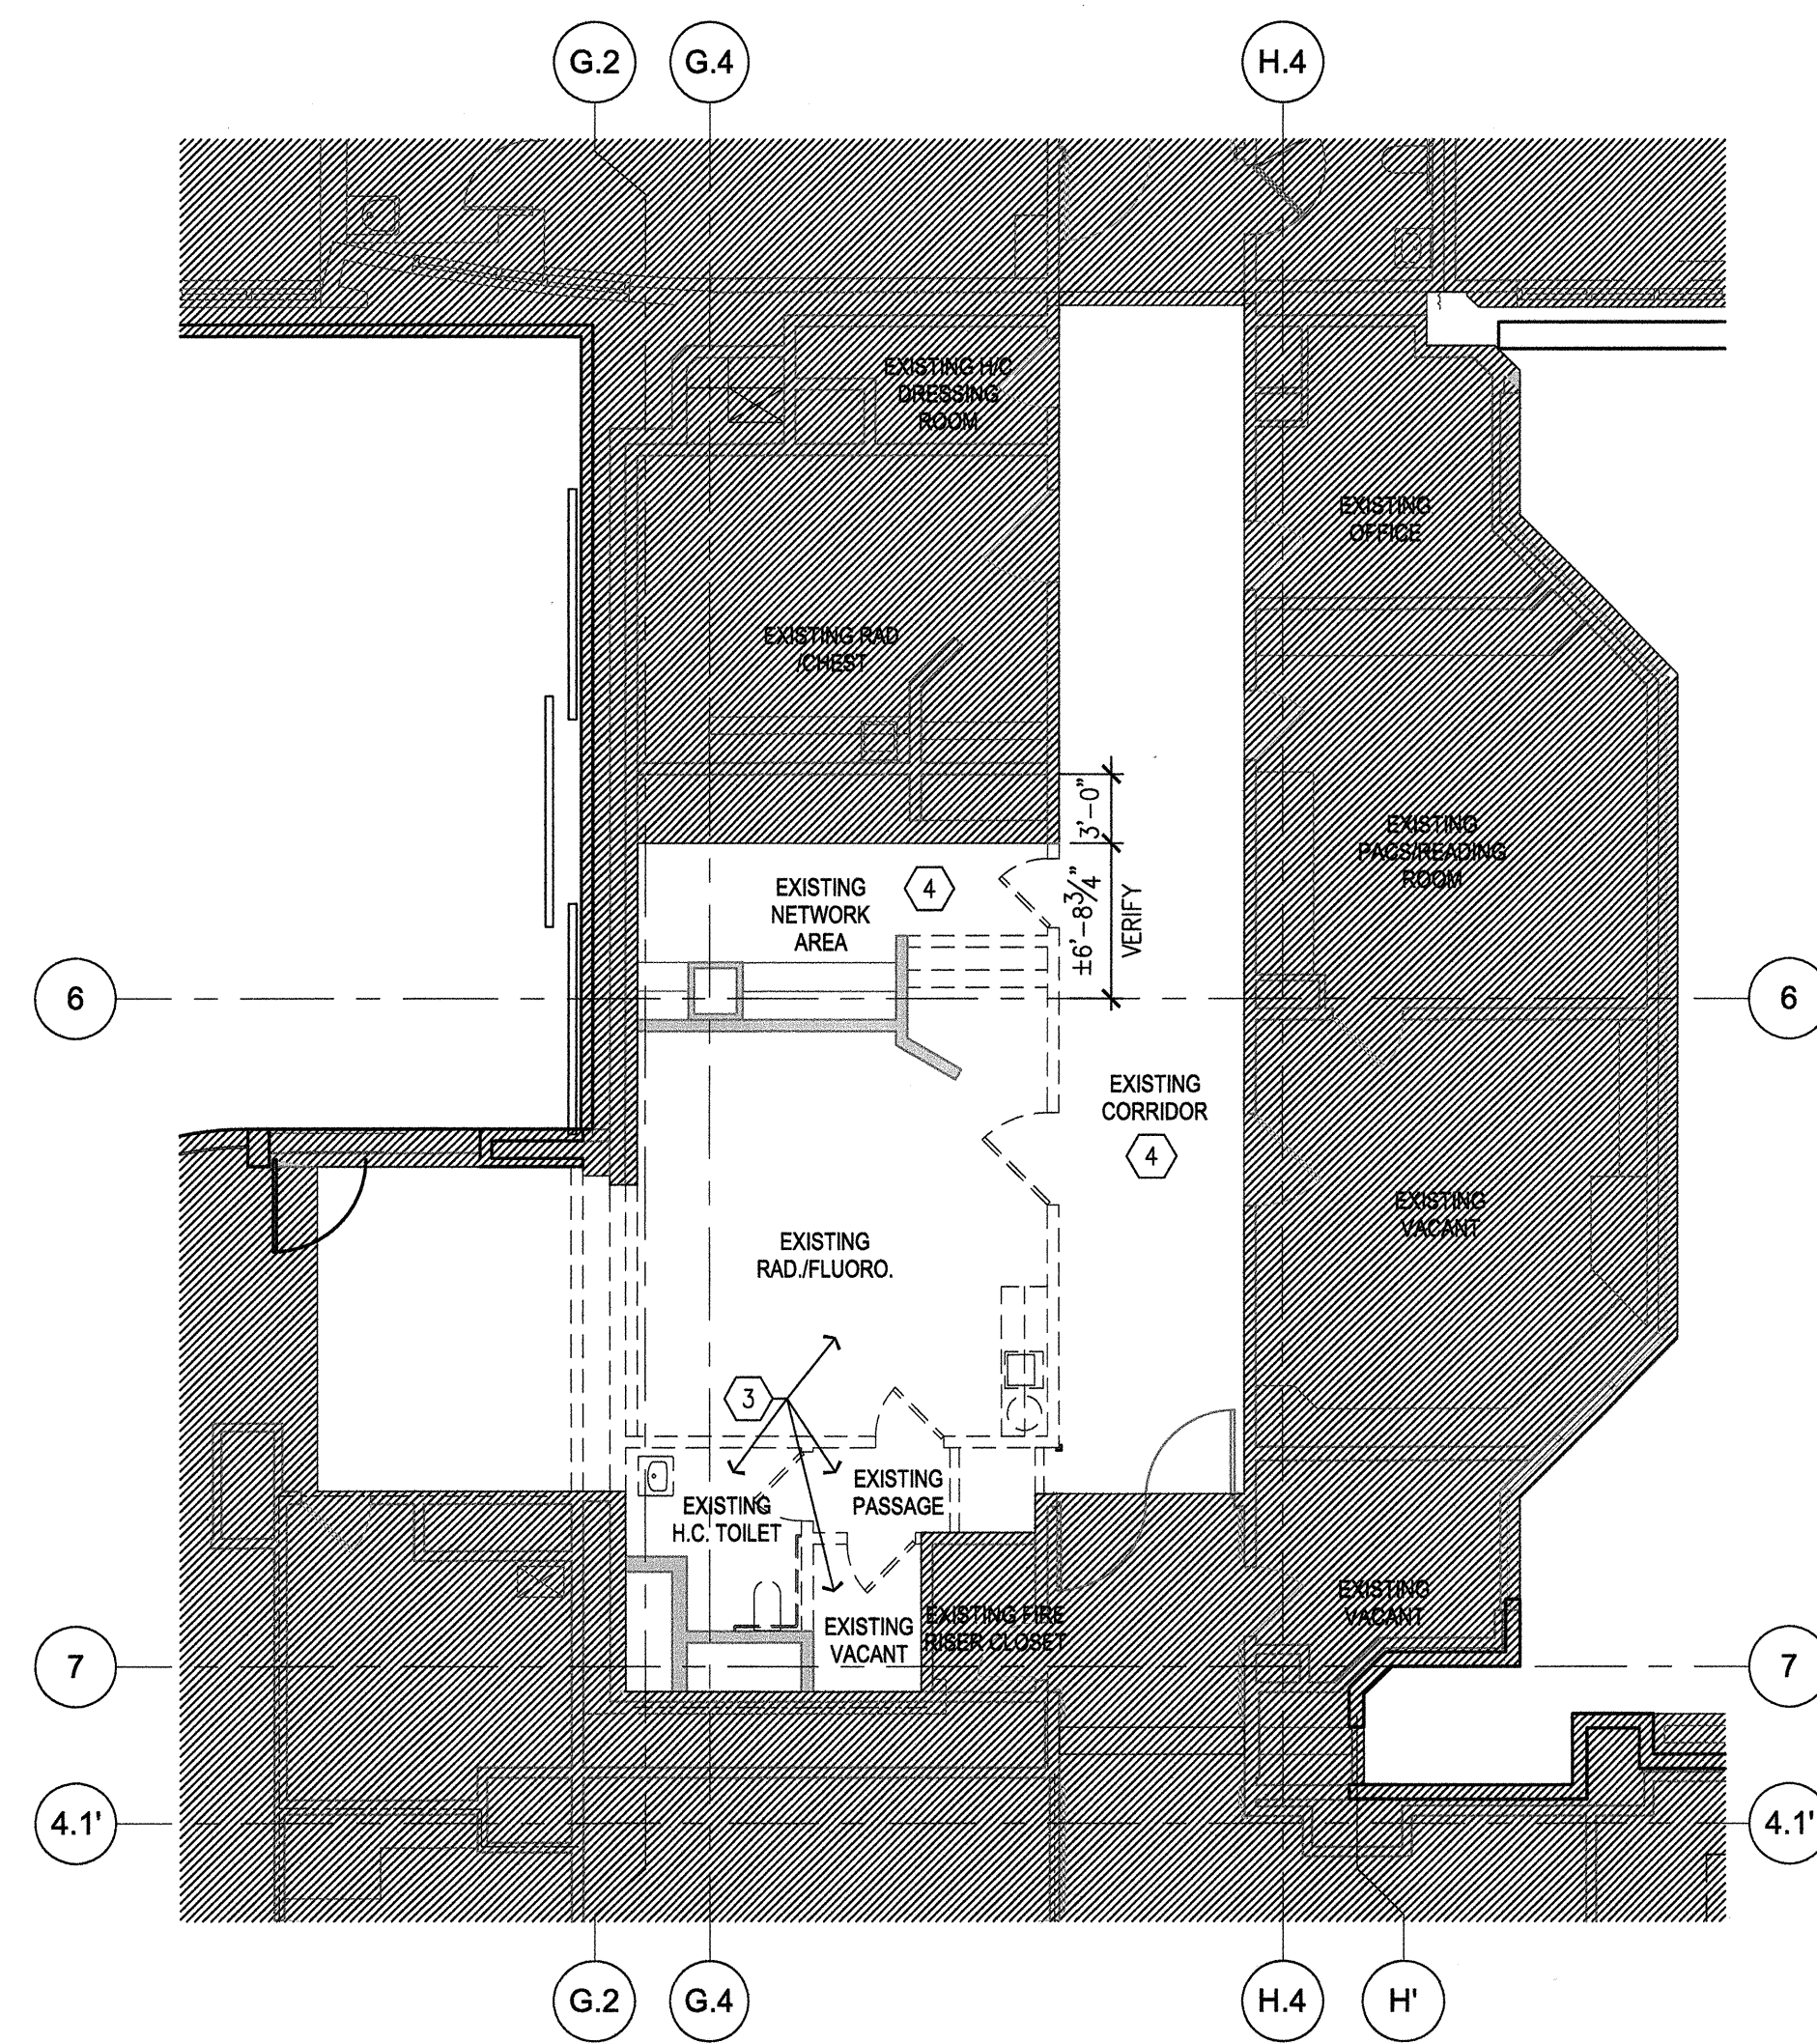

C3 DEMOLITION - LEVEL 2 - PHASE II
1/8" = 1'-0"

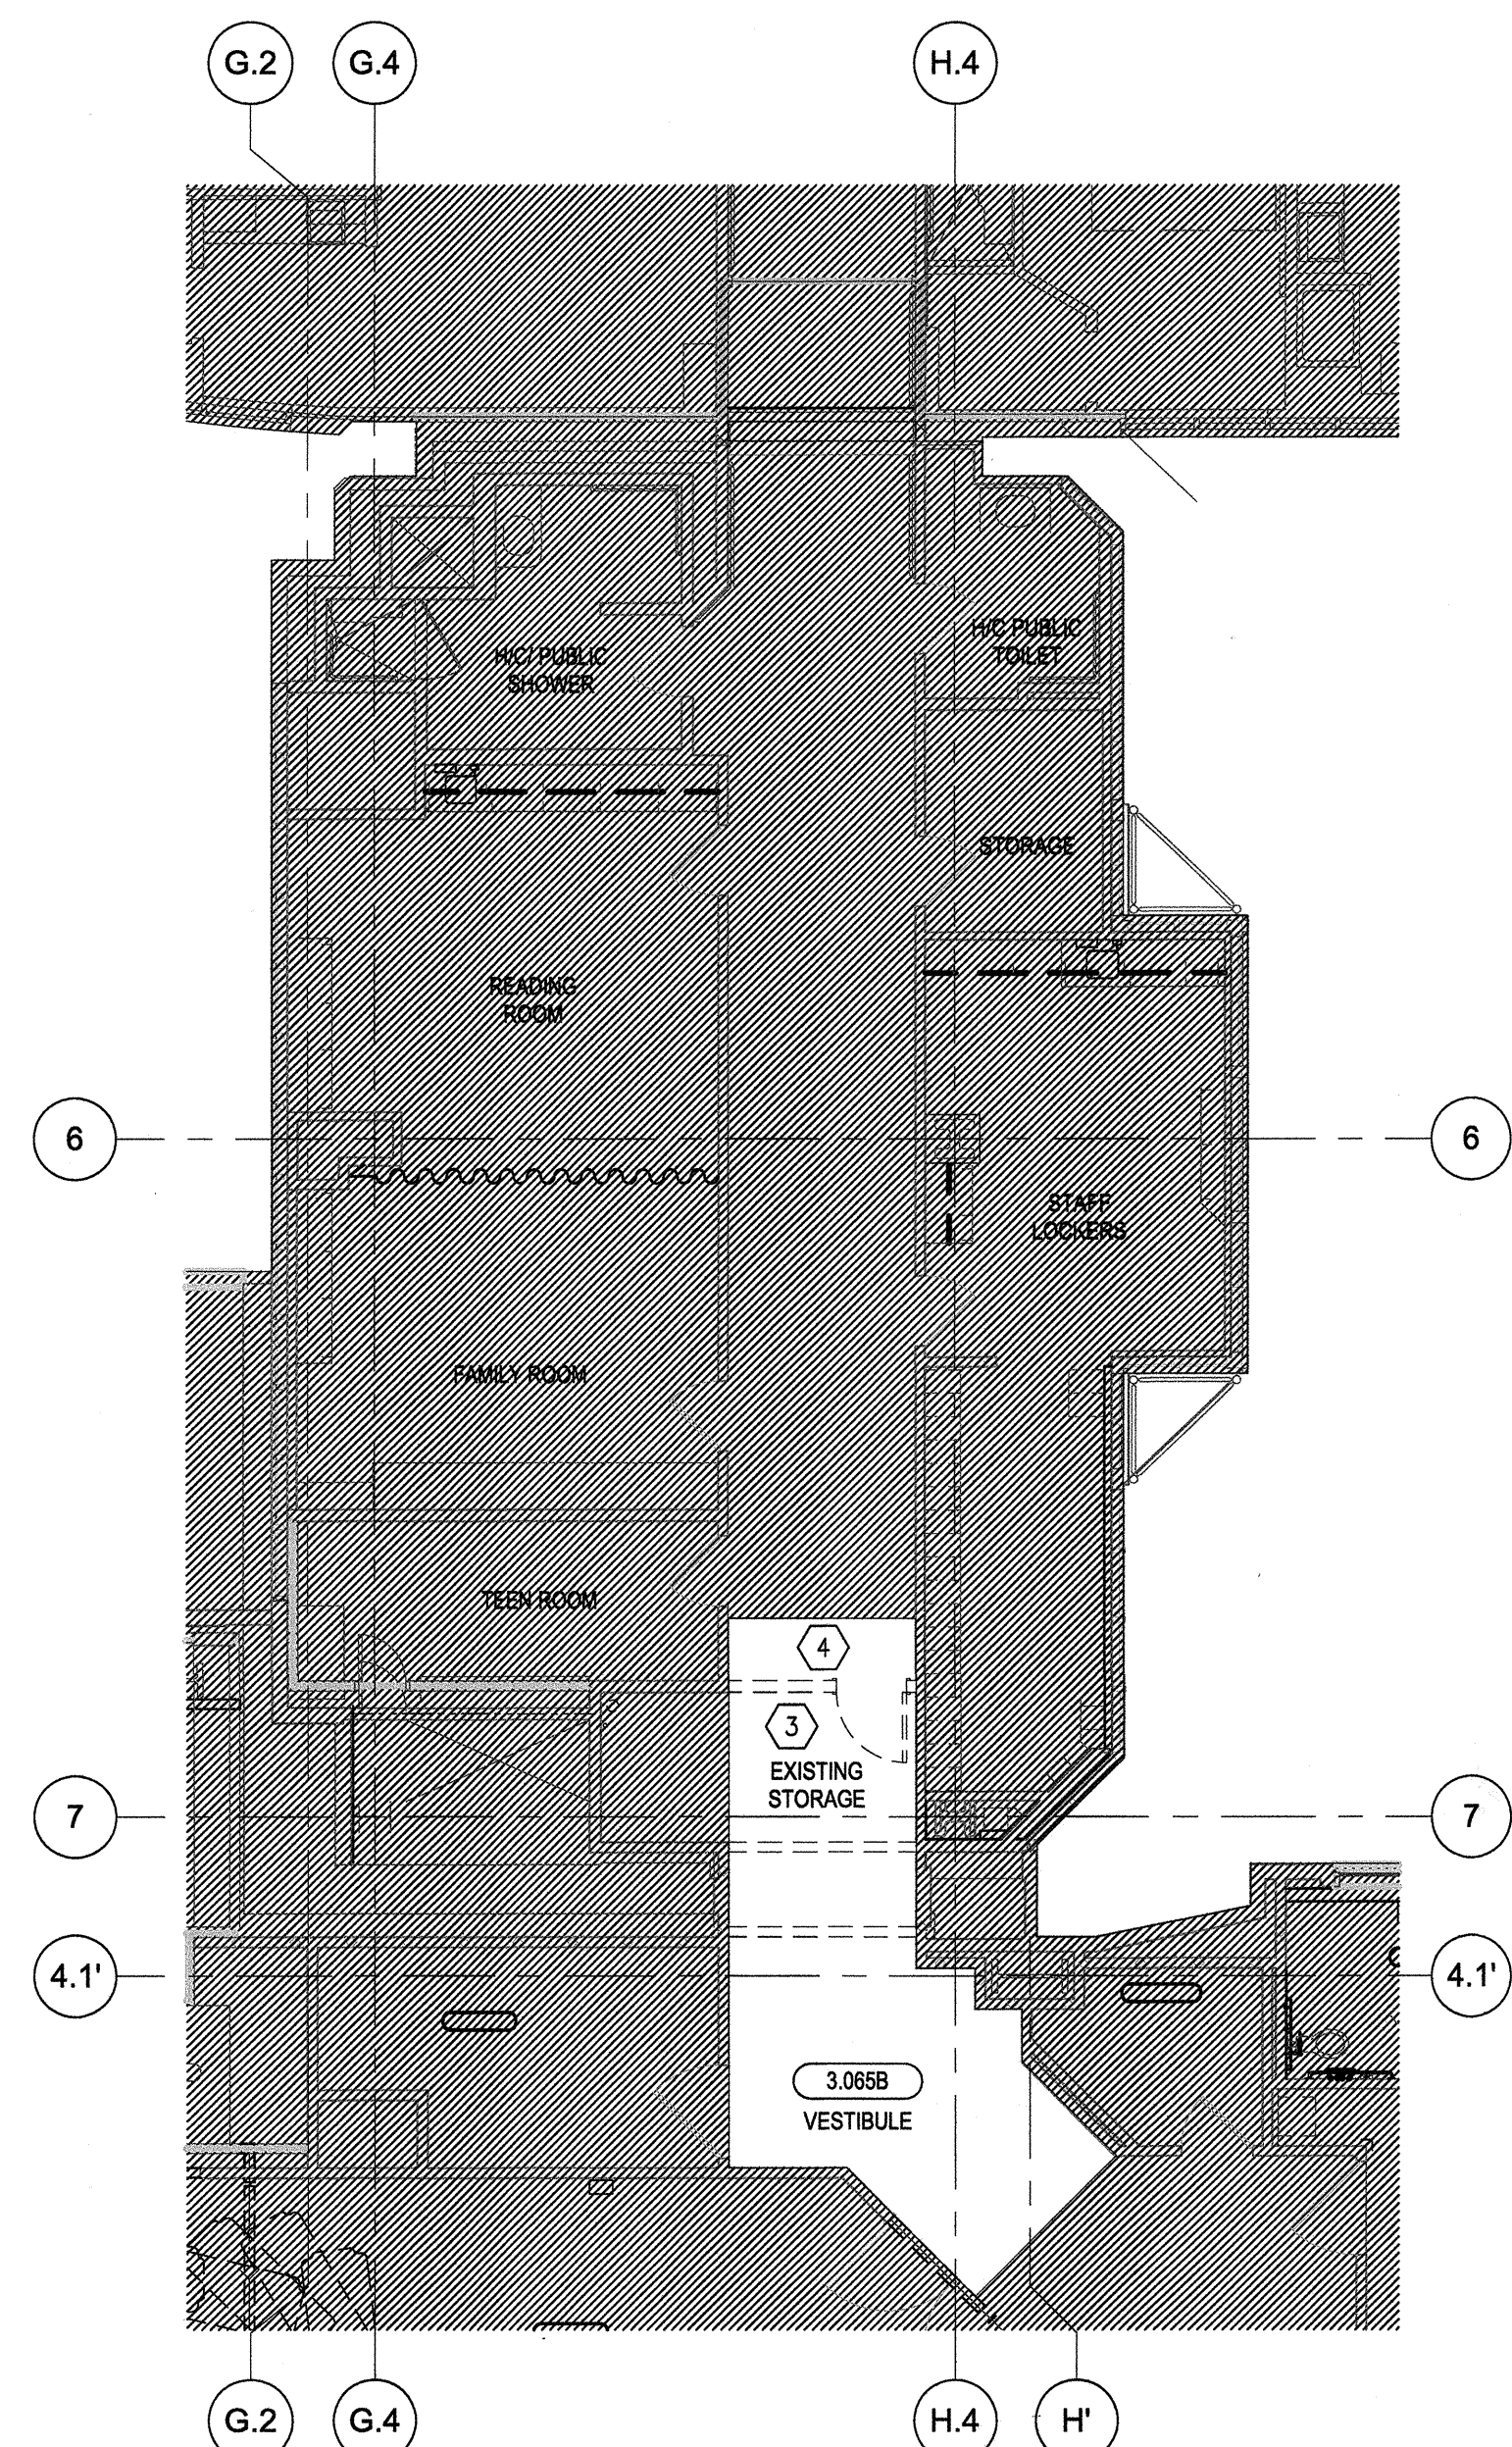

A5 DEMOLITION - LEVEL 3
1/8" = 1'-0"

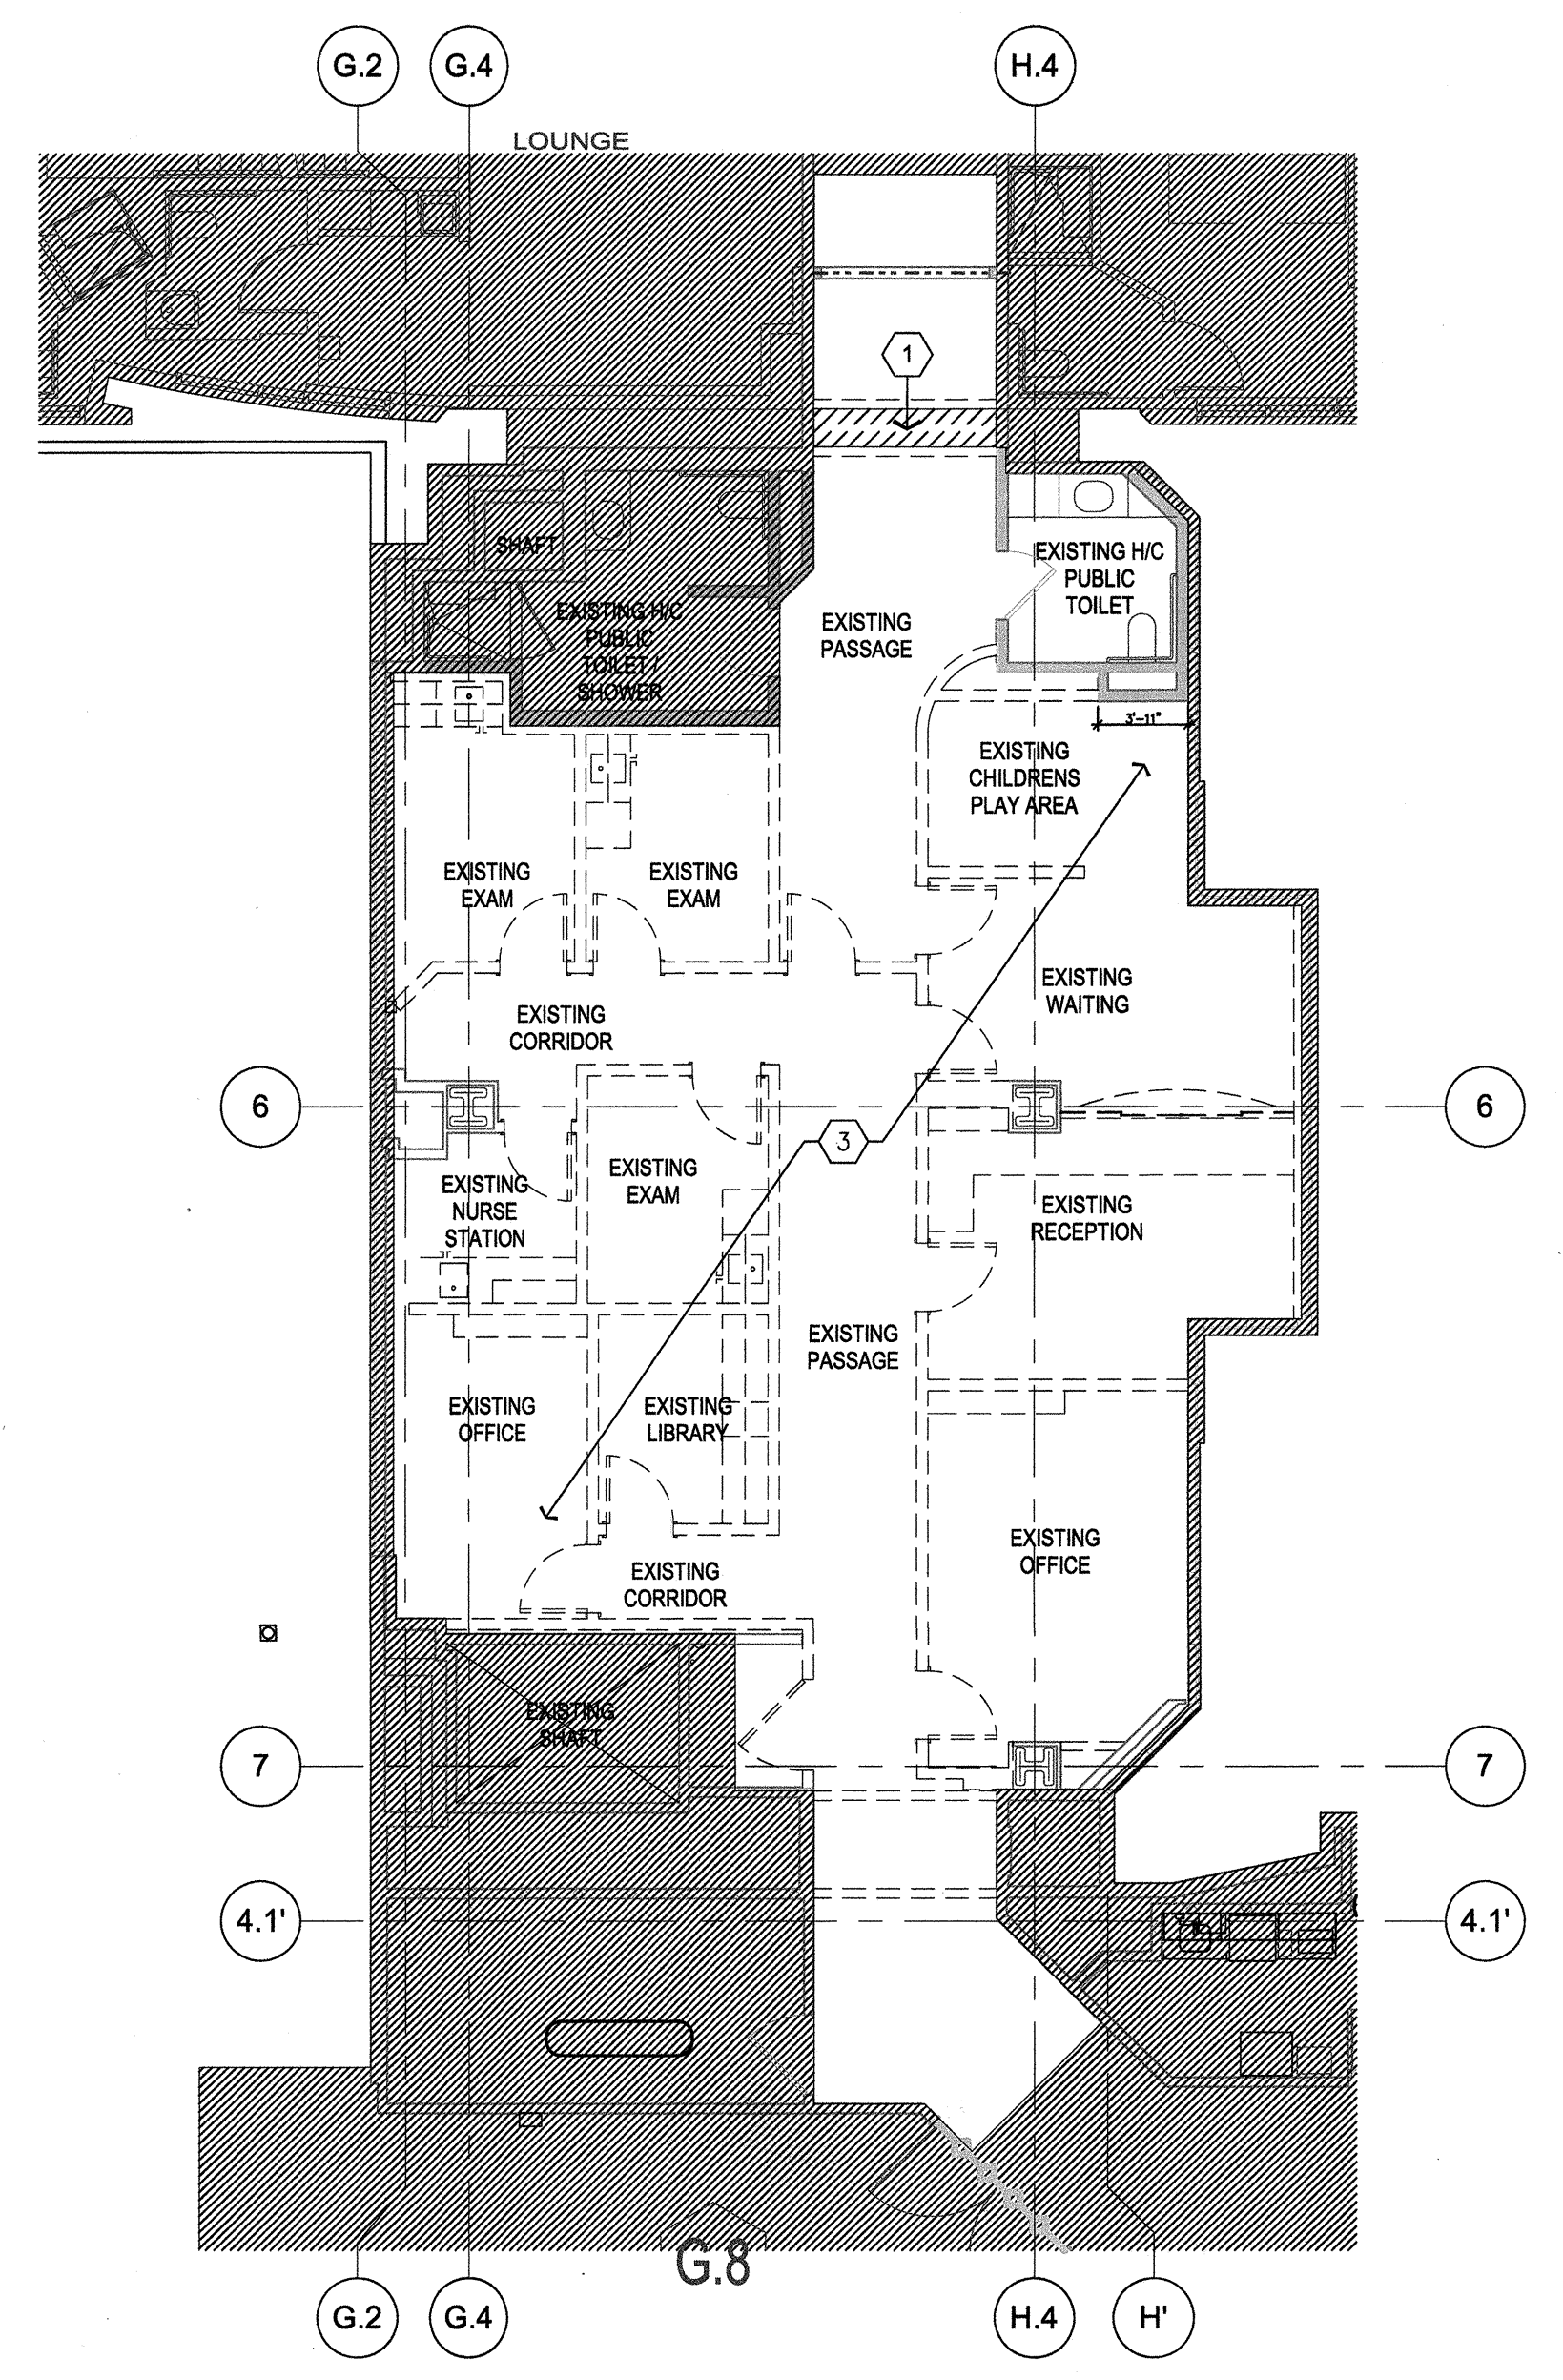


A3 DEMOLITION - LEVEL 5
1/8" = 1'-0"

1. EXISTING EXPANSION JOINT TO REMAIN
2. REMOVE EXISTING NURSE CALL PANEL
3. REMOVE EXISTING CEILING THIS ROOM/AREA
4. EXISTING CEILING TO REMAIN THIS ROOM/AREA. PATCH AND REPAIR AT AREAS OF NEW CONSTRUCTION

C1 NOTES TO SHEET

- EXISTING NOT IN CONTRACT
- EXISTING TO REMAIN
- DEMOLISH

B1 LEGEND

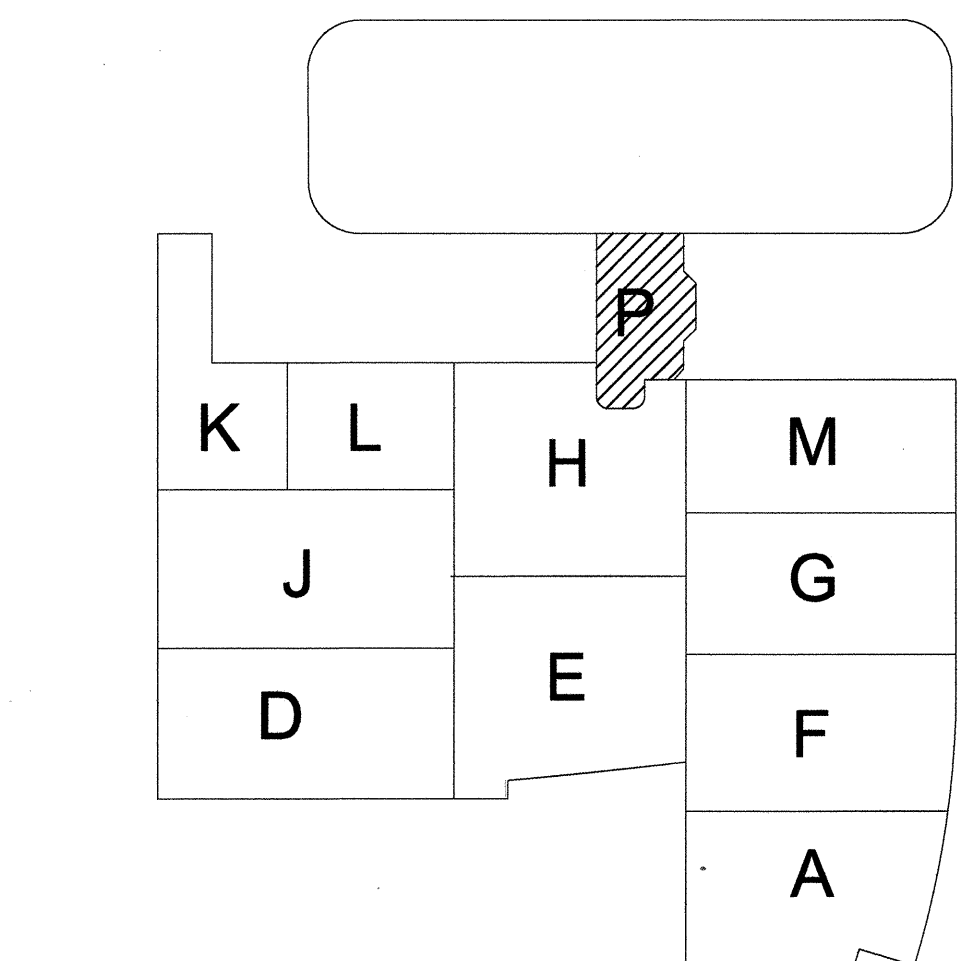

A1 KEY PLAN