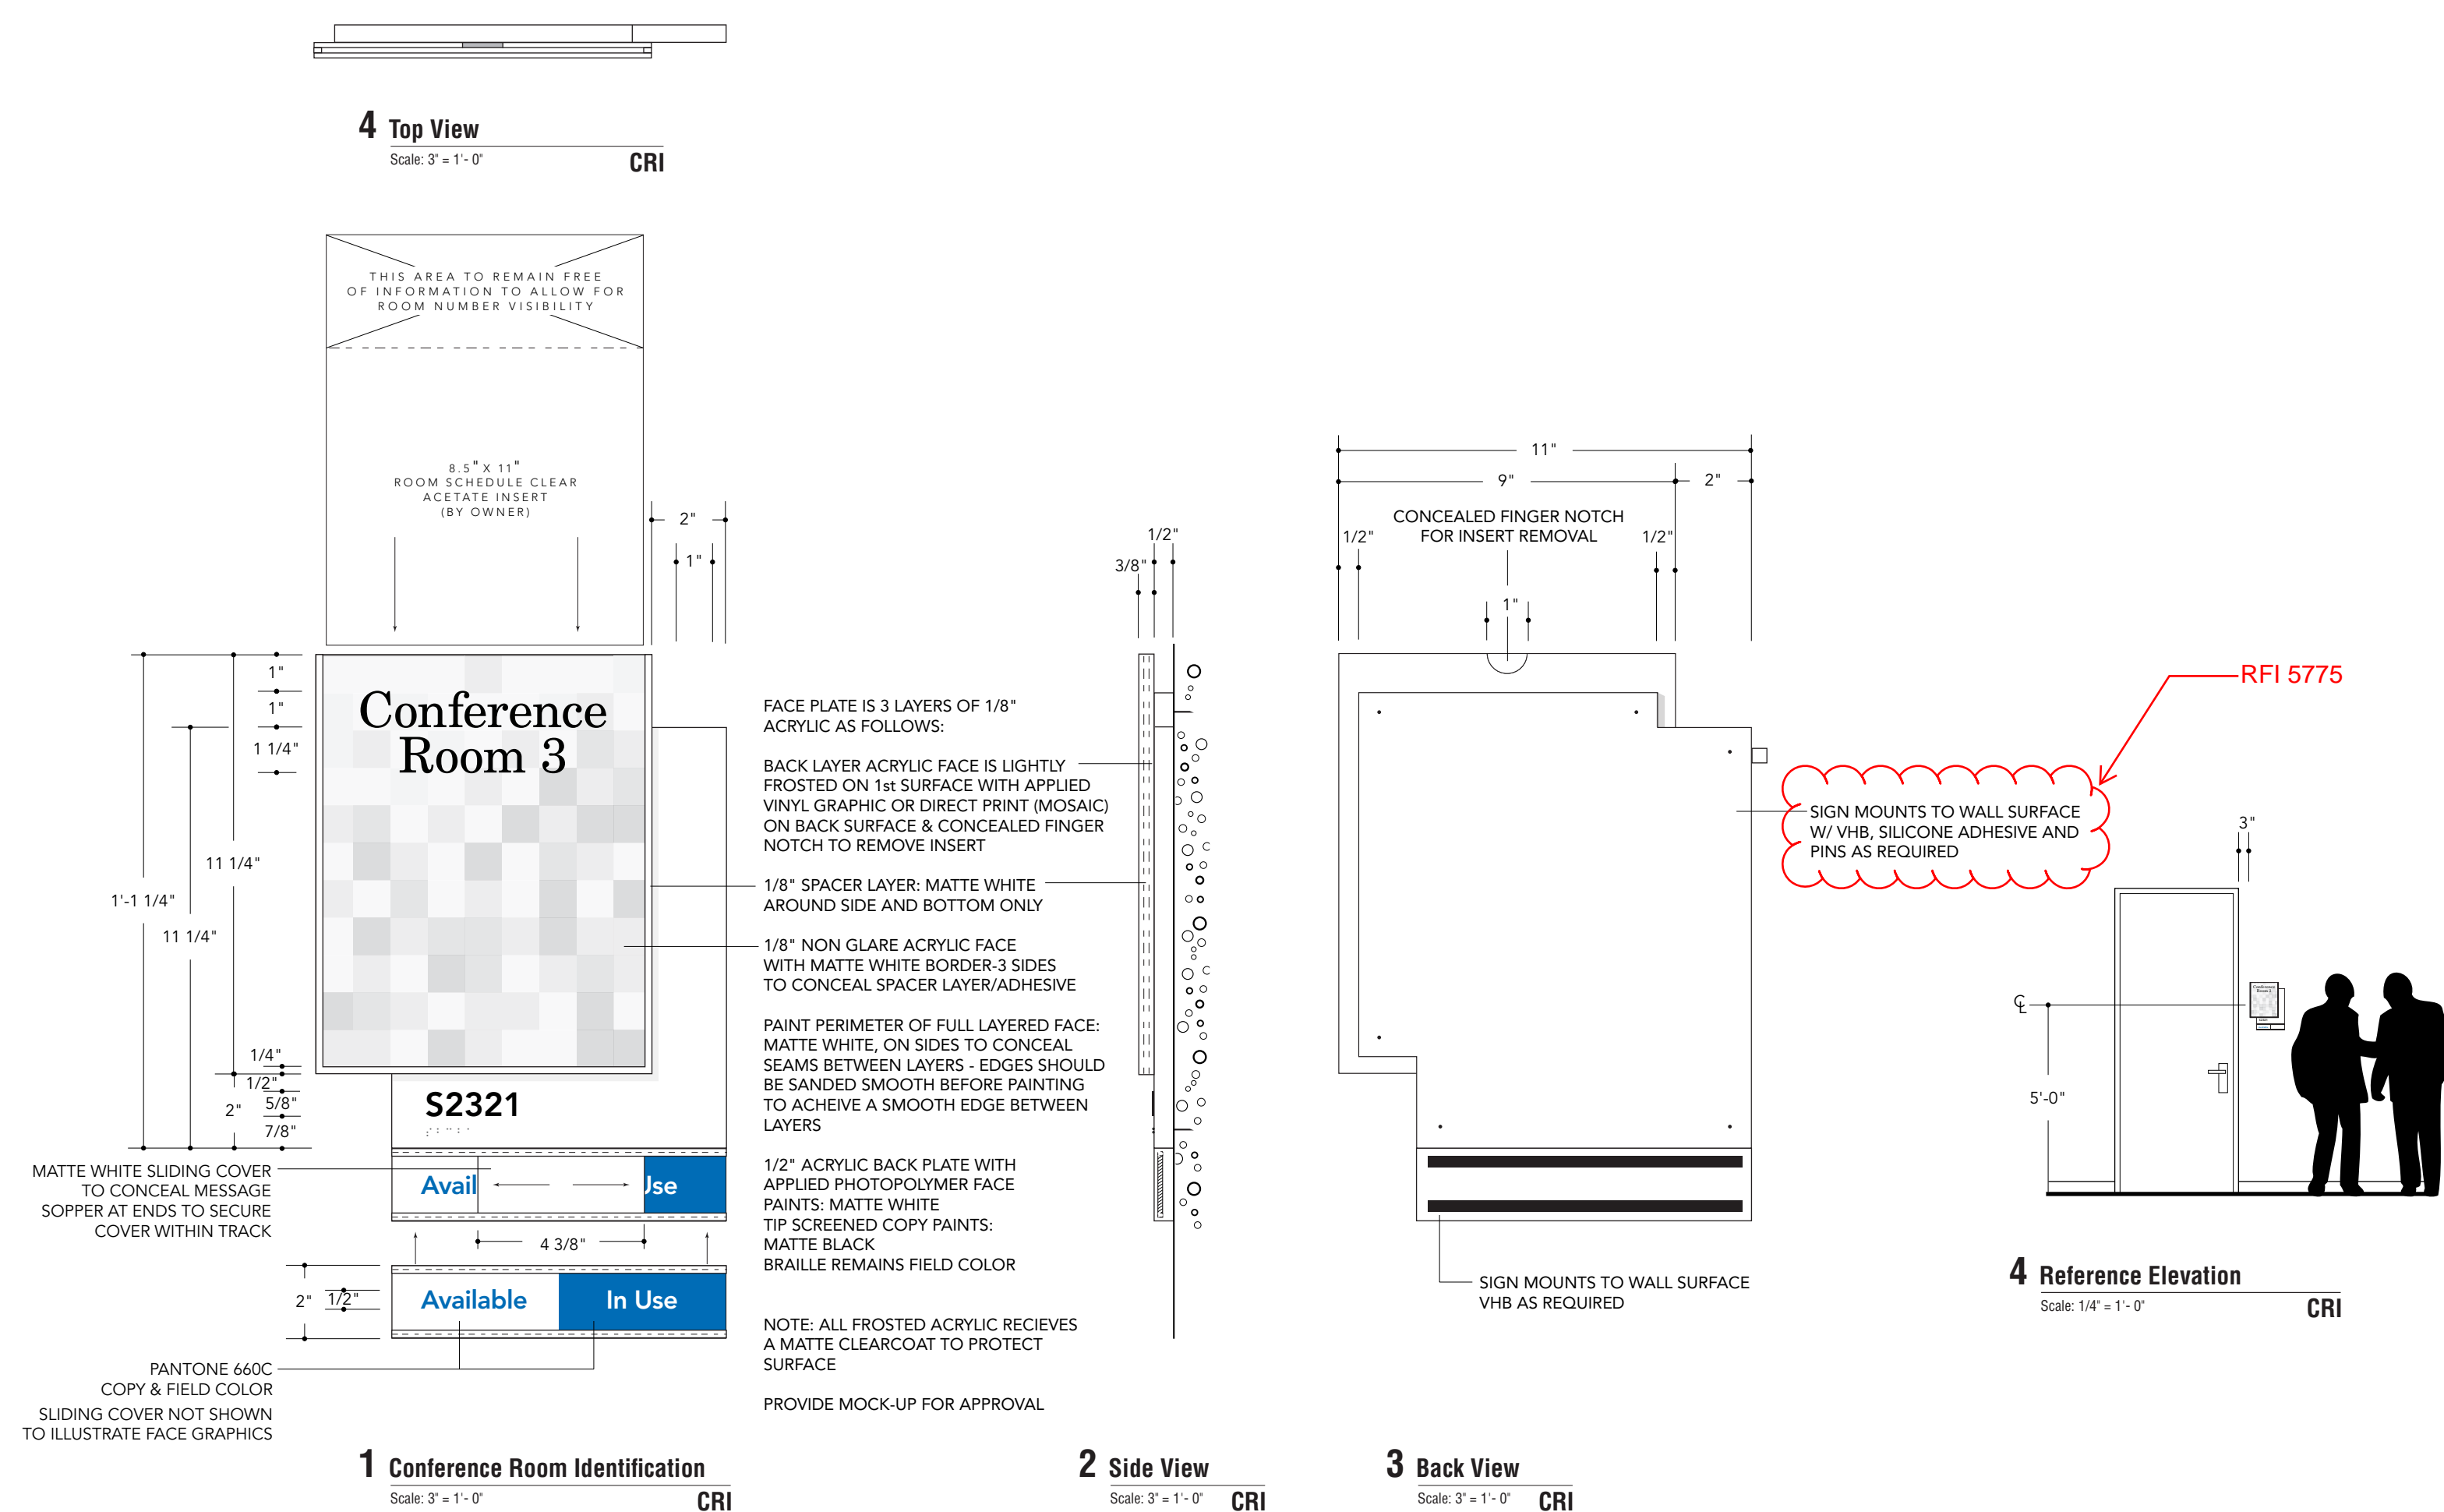
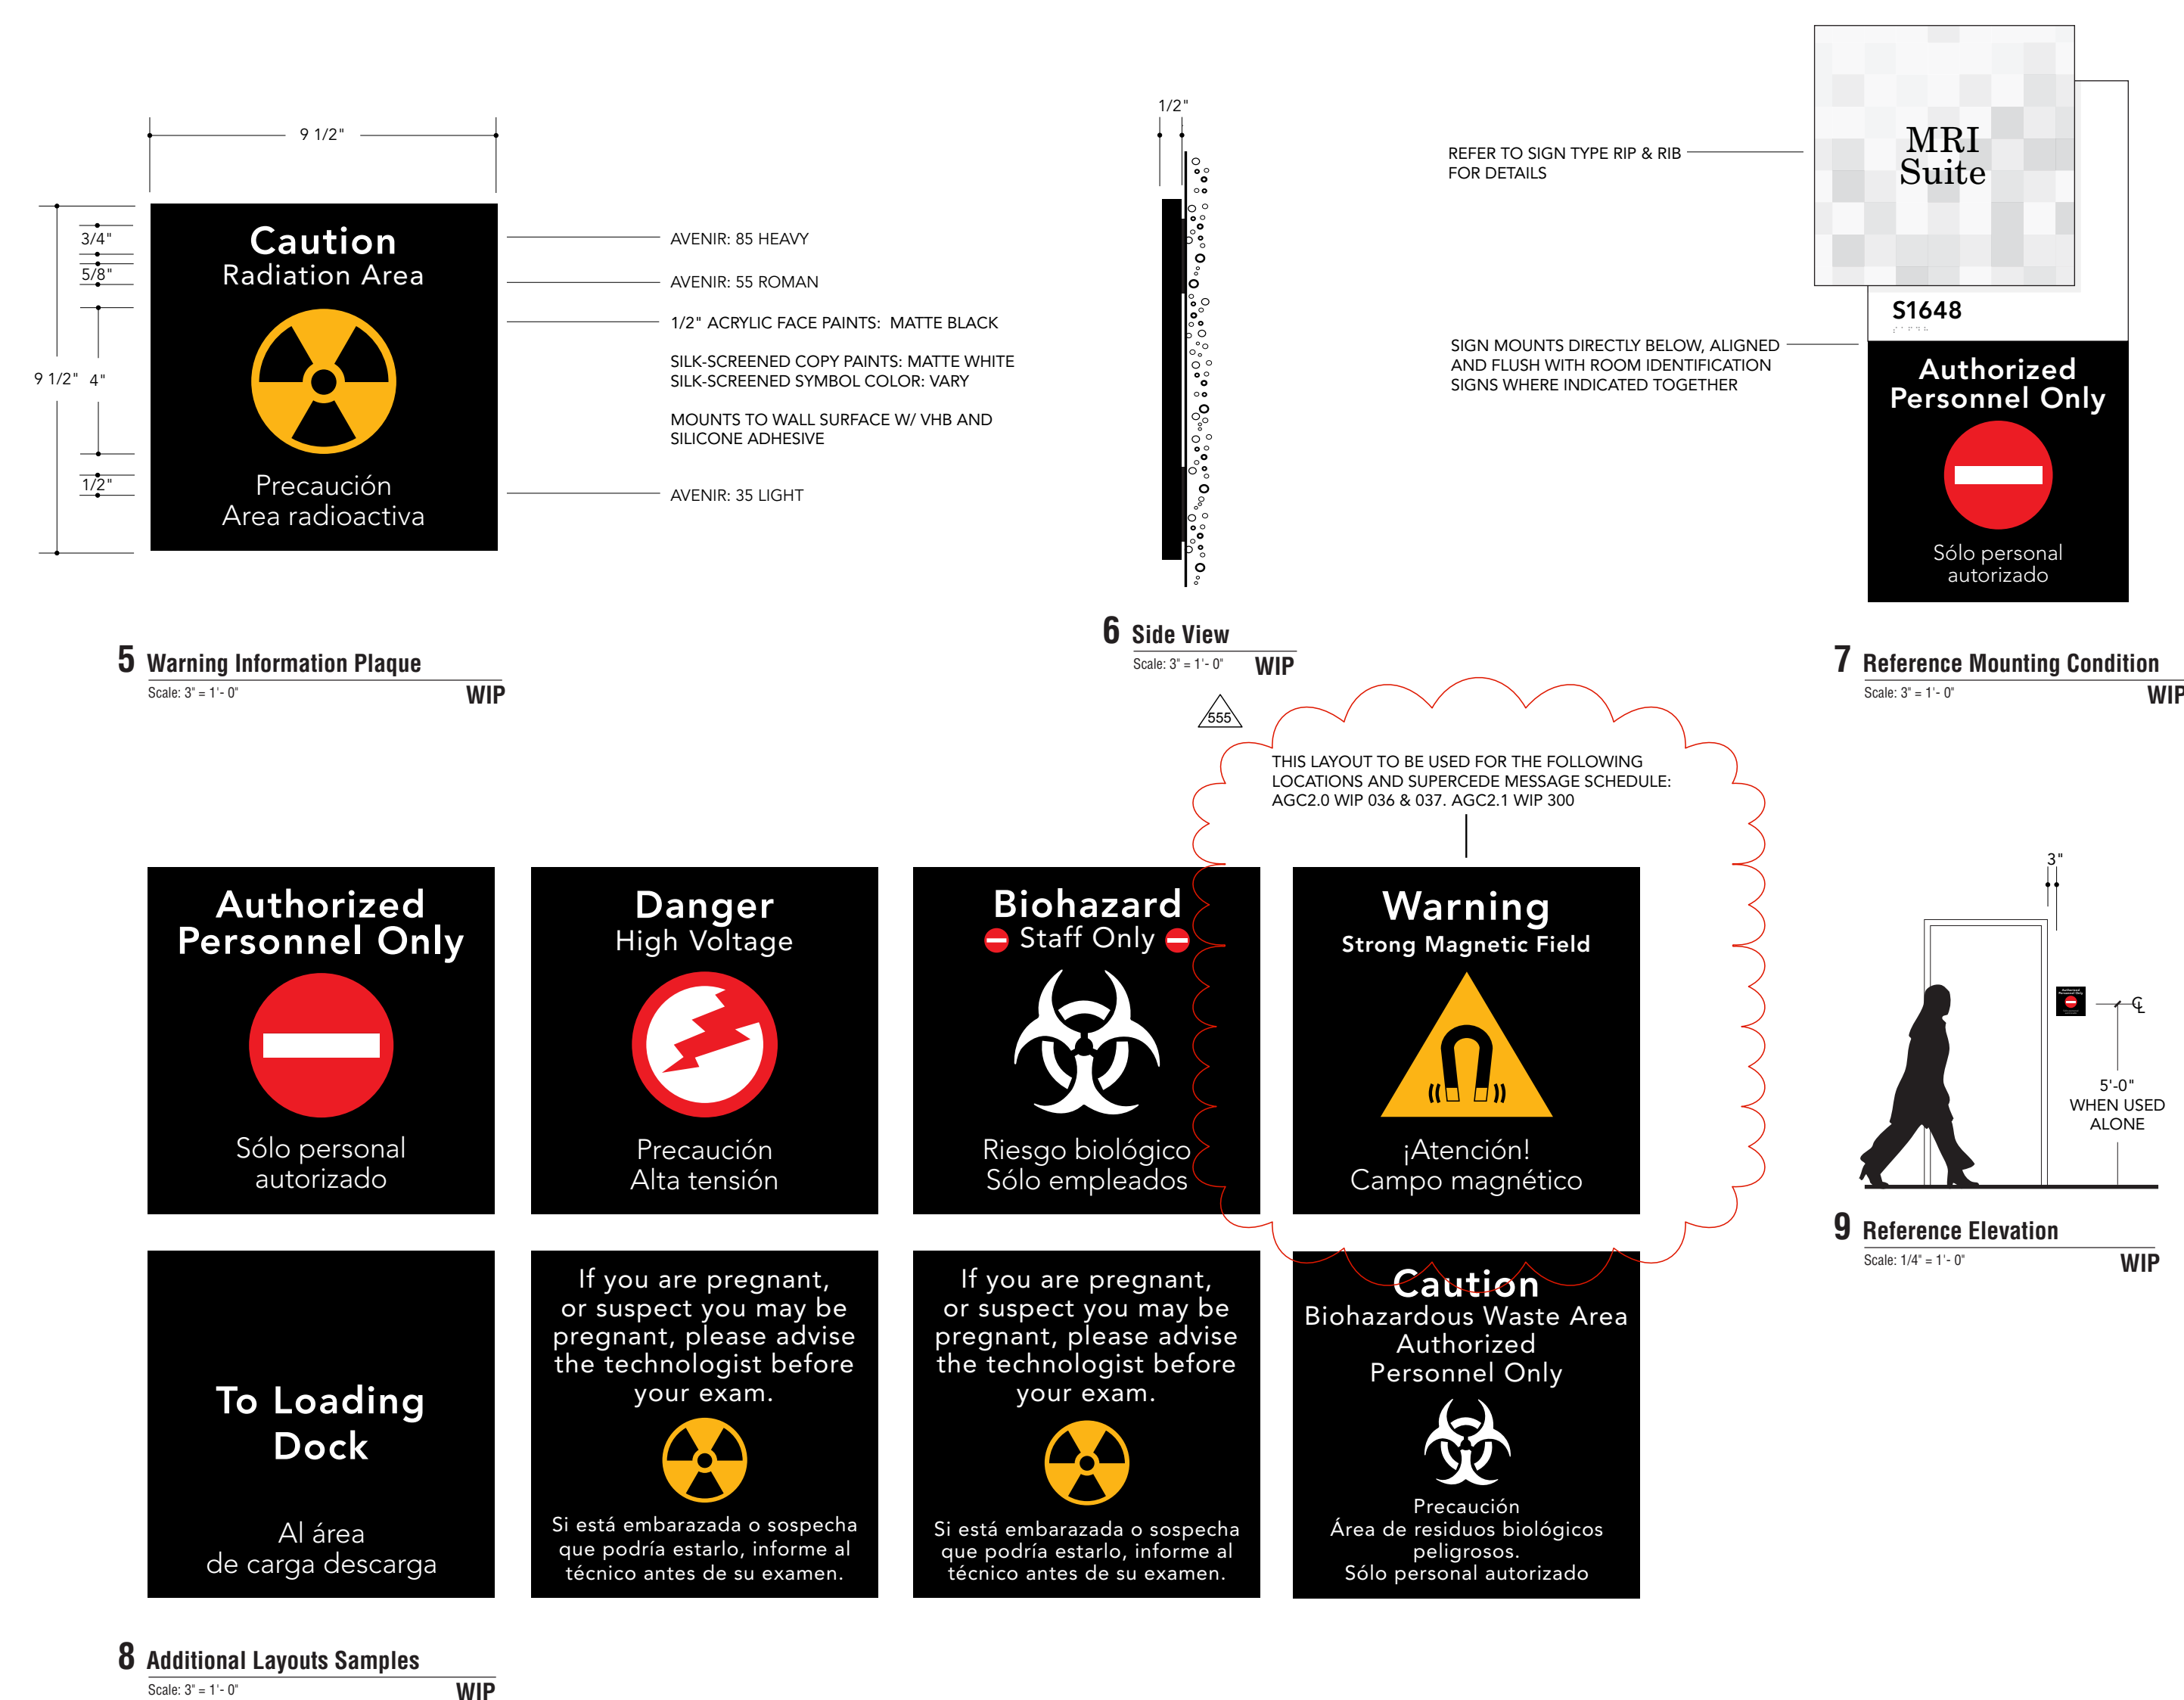
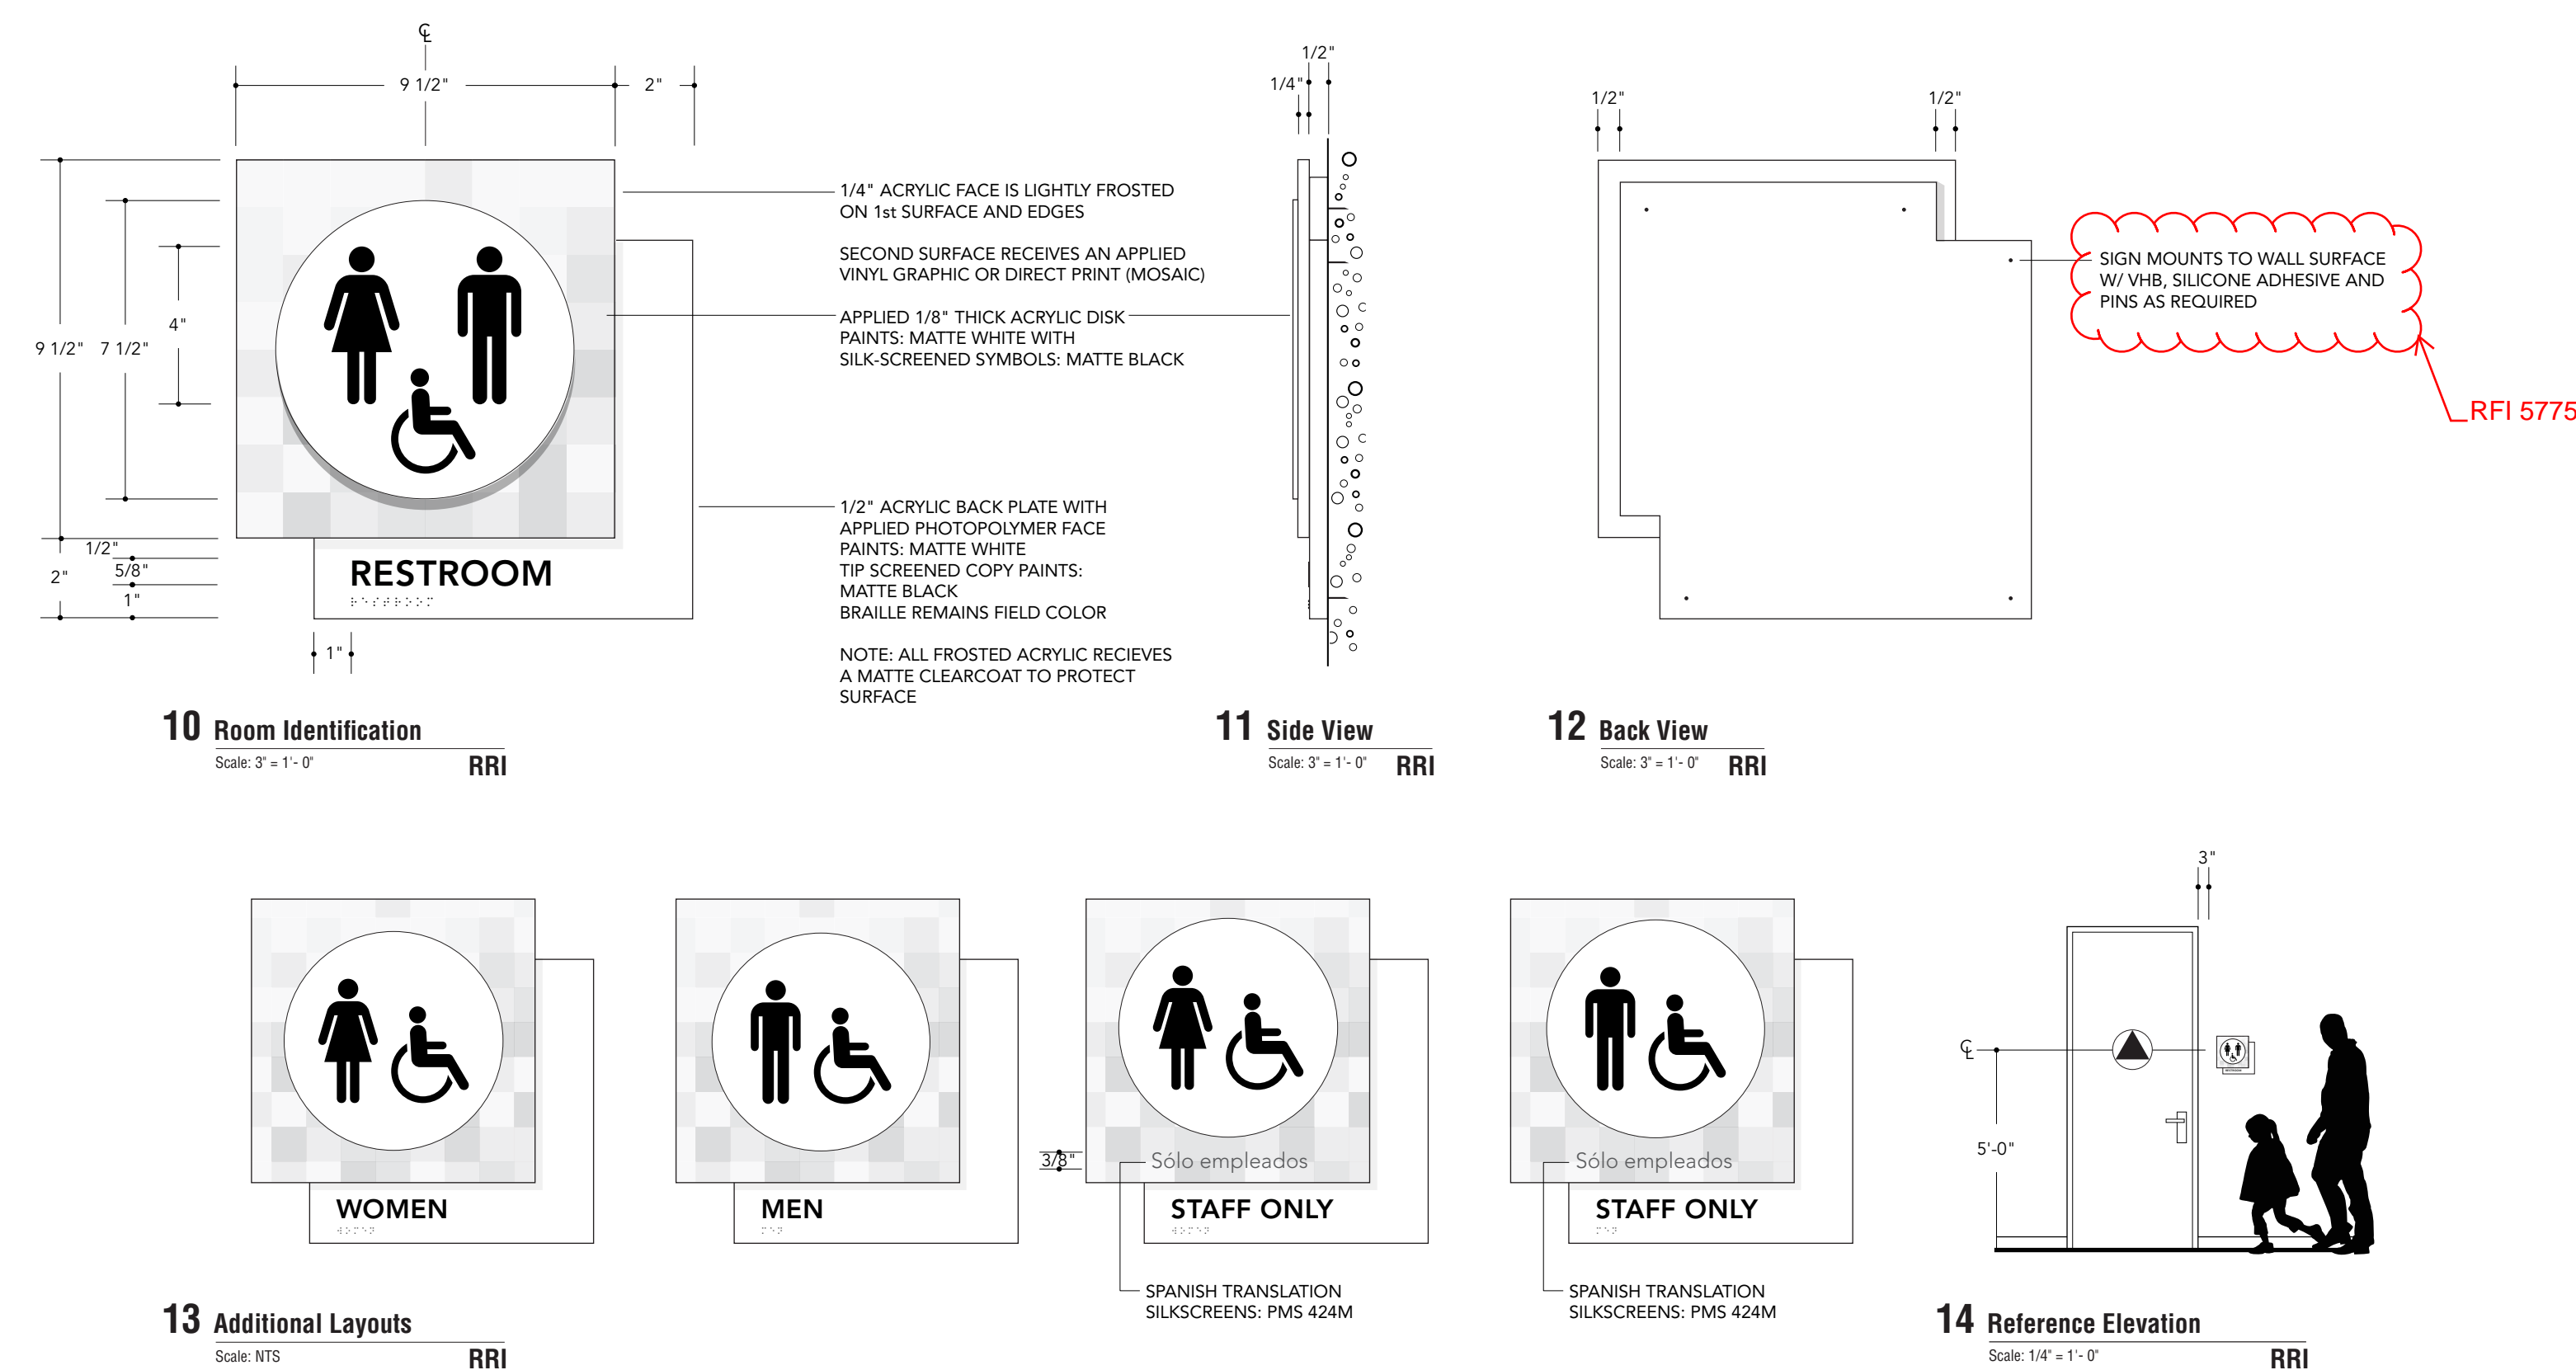
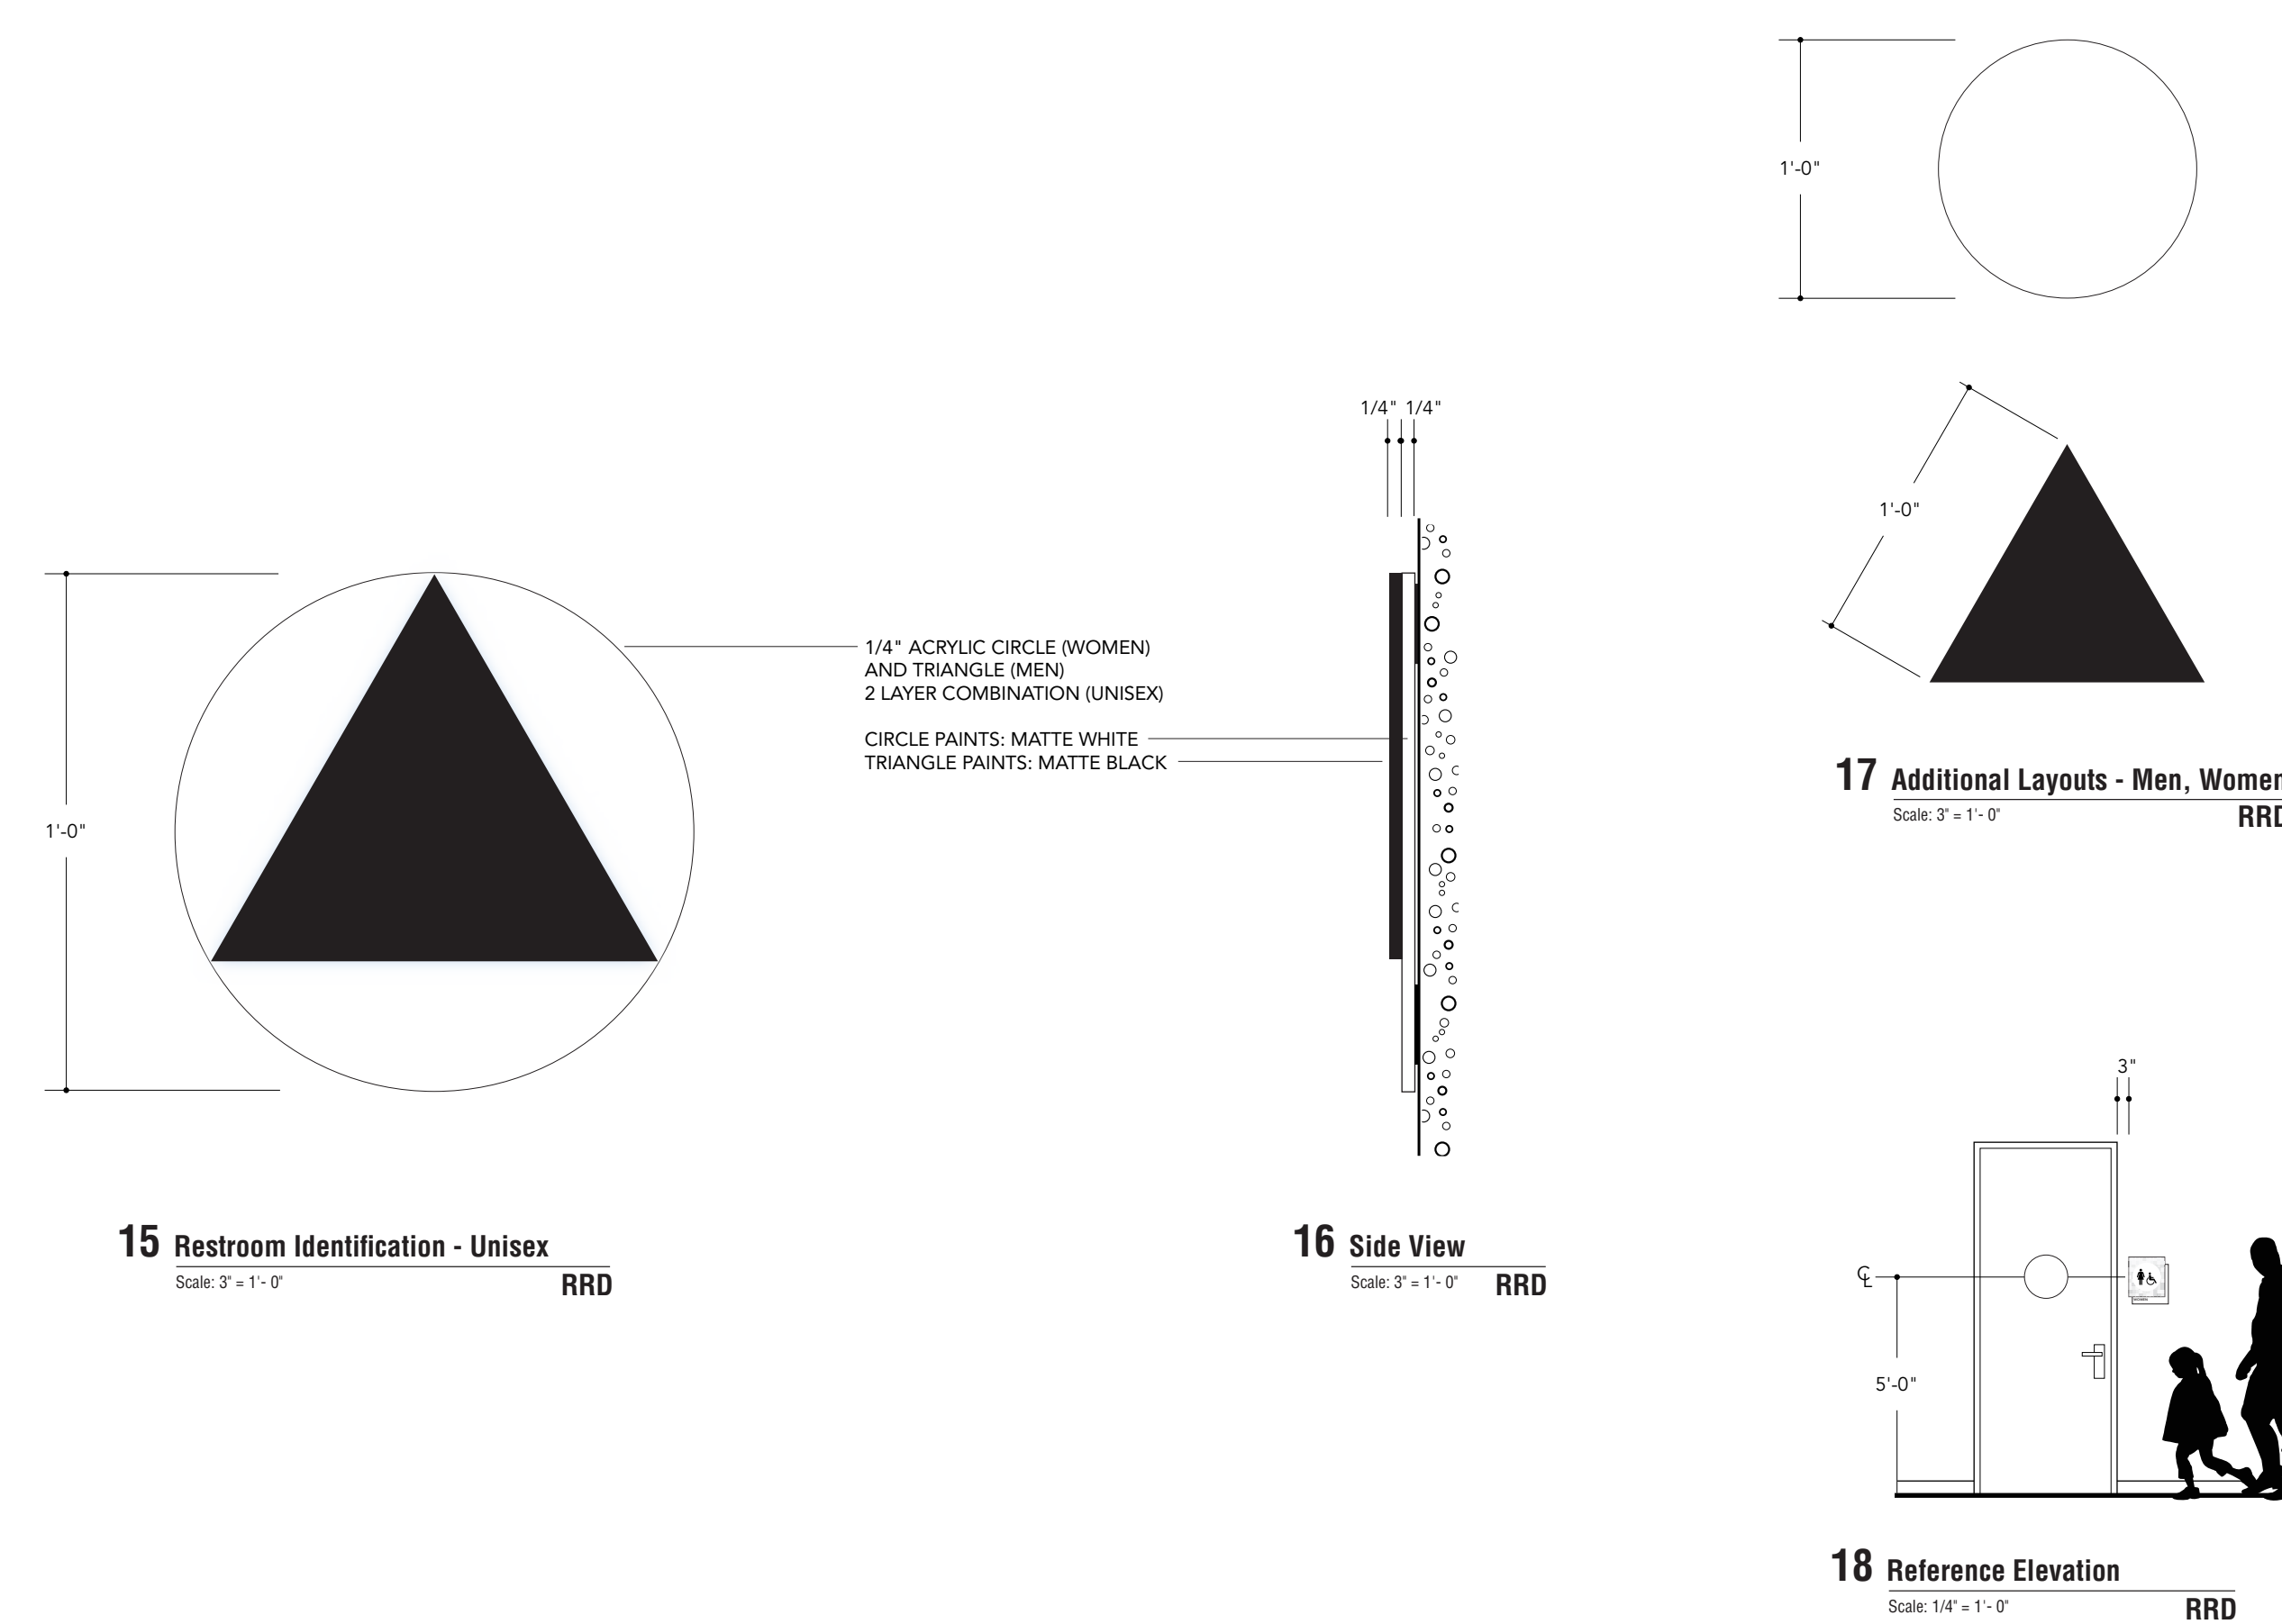


A

**CRI: Conference Room Identification**

WIP: Warning Information Plaque

**RRI: Restroom Identification**

RRD: Restroom Door Identification