




ML: Monolithic Letterforms

LI: Logo Identification

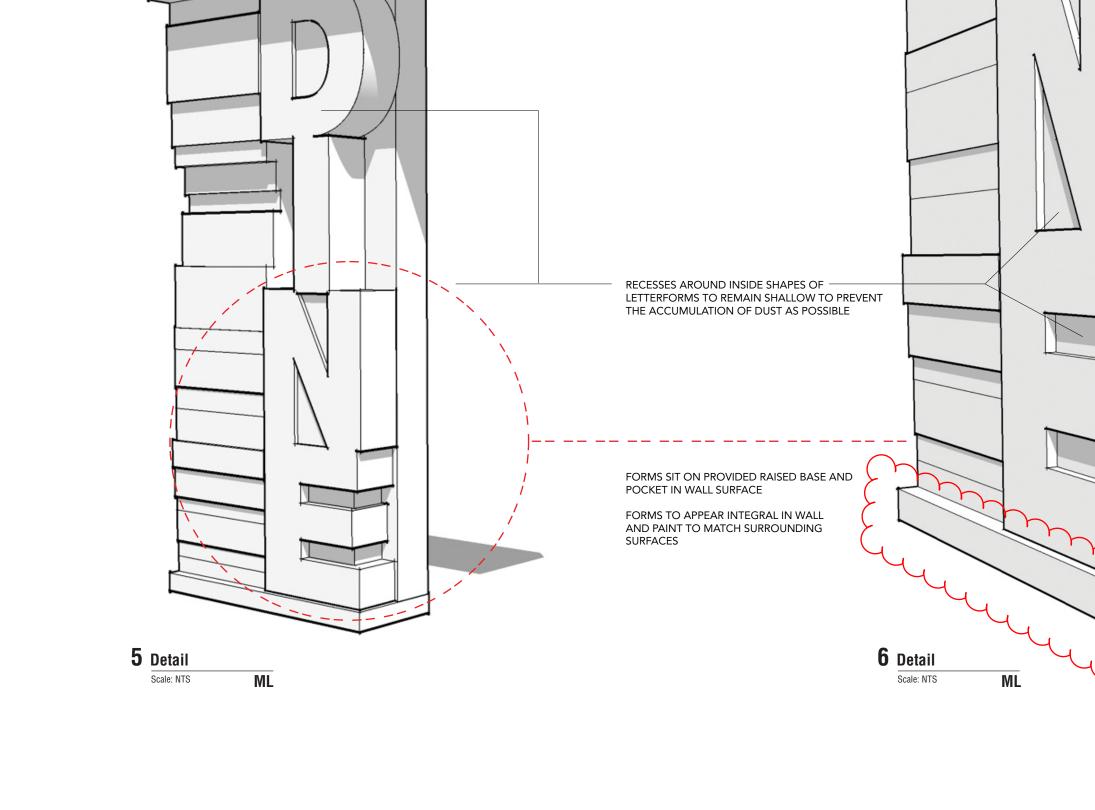

CHOC Children's

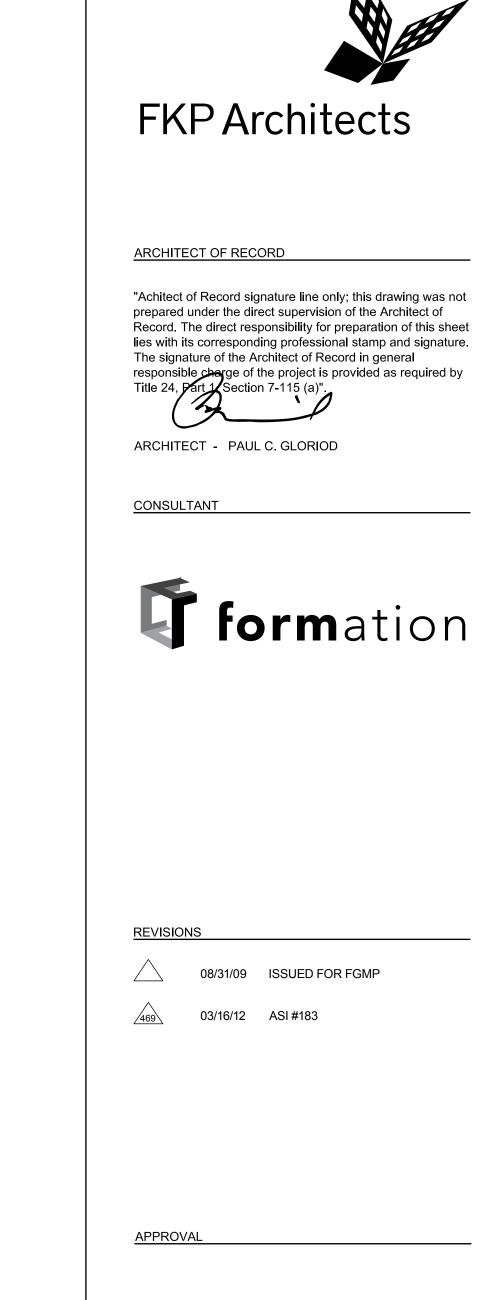

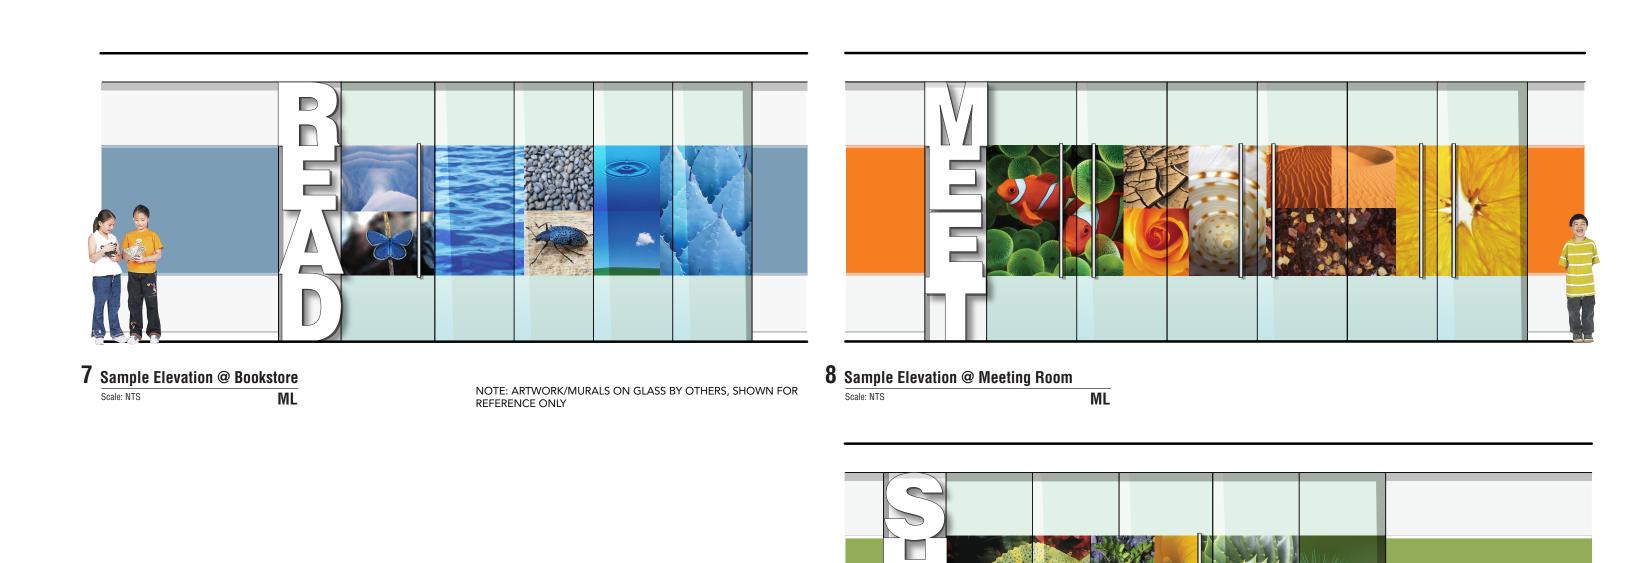


9 Sample Elevation @ Gift Shop
| Scale: NTS

4 Elevation @ Dining

ML: Monolithic Letterforms

ML: Monolithic Letterforms

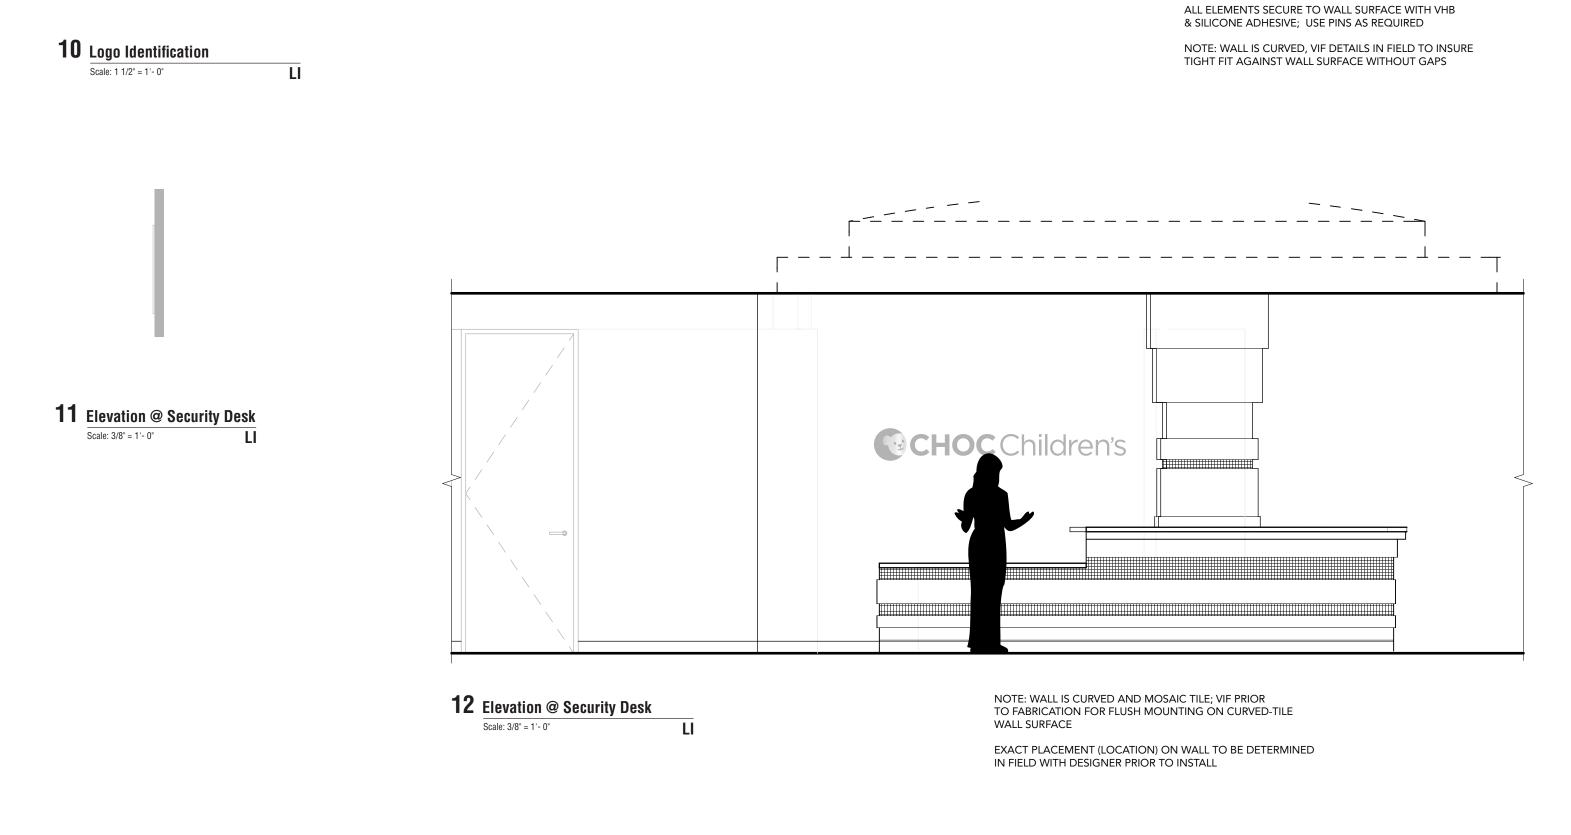

TOWER II HOSPITAL PROJECT NUMBER 12011.00 Increment #7 OSHPD - PROJECT NUMBER IL 072072-30 Issue for FGMP 08/31/2009 AS NOTED DRAWING TITLE WAYFINDING GRAPHICS

DRAWING NUMBER

455 S. Main St.

Orange, CA 92868-3874

CHILDREN'S HOSPITAL

OF ORANGE COUNTY

3/4" THICK # 4 BRUSHED STAINLESS STEEL FABRICATED DISK W/SATIN CLEAR COAT FINISH TO PROTECT - RETURNS/EDGES TO MATCH FACE WITH NO VISIBLE SEAMS

3/4" THICK # 4 BRUSHED STAINLESS STEEL FABRICATED LETTERFORMS W/SATIN CLEAR COAT FINISH TO PROTECT

- RETURNS, EDGES TO MATCH FACE

1/4"APPLIED POLISHED STAINLESS STEEL BEAR FACE, EYES, NOSE & MOUTH DETAILS ARE # 4 BRUSHED (SAME PIECE OF MATERIAL) NOT APPLIED