

E

Welcome to Tower 2

1 Letterforms - Large
Scale: 3" = 1'-0"


ILL

1/4" THICK # 4 BRUSHED STAINLESS STEEL LETTERFORMS W/ SATIN CLEAR COAT FINISH TO PROTECT - RETURNS, EDGES TO MATCH FACE
ALL ELEMENTS SECURE TO WALL SURFACE WITH VHB & SILICONE ADHESIVE; USE PINS AS REQUIRED

Access to Tower 1

2 Letterforms - Large (Additional Layout)
Scale: 3" = 1'-0"

ILL

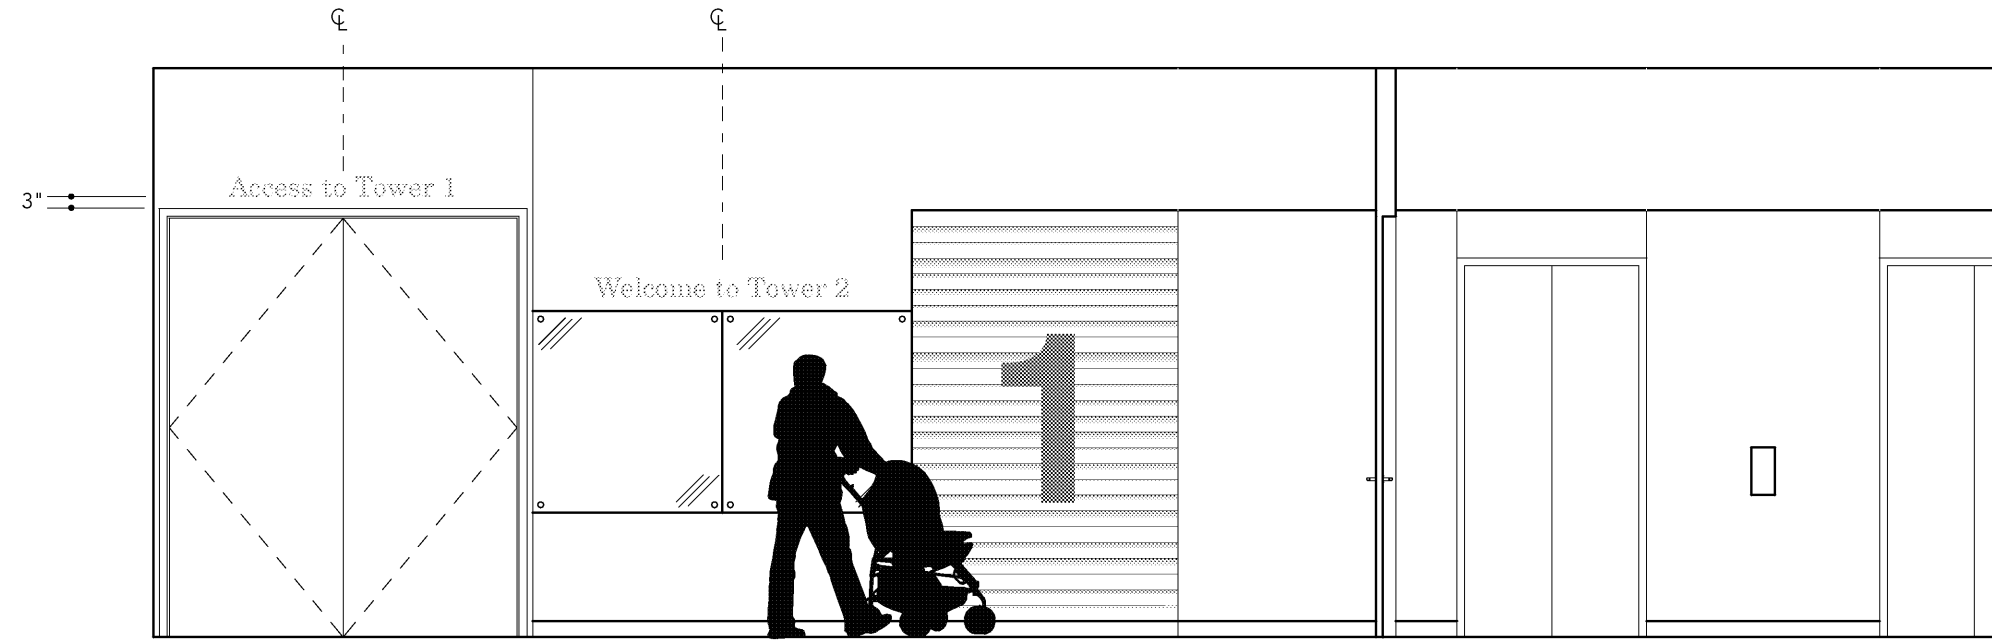

3 Sample Elevation
Scale: 1/4" = 1'-0"

ILL

ILL: Identification Letterforms (Large)

C

Access to Tower 1

8 Letterforms - Small
Scale: 3" = 1'-0"

ILS

Emergency

9 Letterforms - Small
Scale: 3" = 1'-0"

ILS

Admissions

10 Letterforms - Small
Scale: 3" = 1'-0"


ILS

11 Side View
Scale: 3" = 1'-0"

ILS

1/4" THICK # 4 BRUSHED STAINLESS STEEL LETTERFORMS W/ SATIN CLEAR COAT FINISH TO PROTECT - RETURNS, EDGES TO MATCH FACE

1/4" THICK # 4 BRUSHED STAINLESS STEEL DISK WATER-JET CUT ARROW FULLY OUT OF DISK
ALL ELEMENTS SECURE TO WALL SURFACE WITH VHB & SILICONE ADHESIVE; USE PINS AS REQUIRED

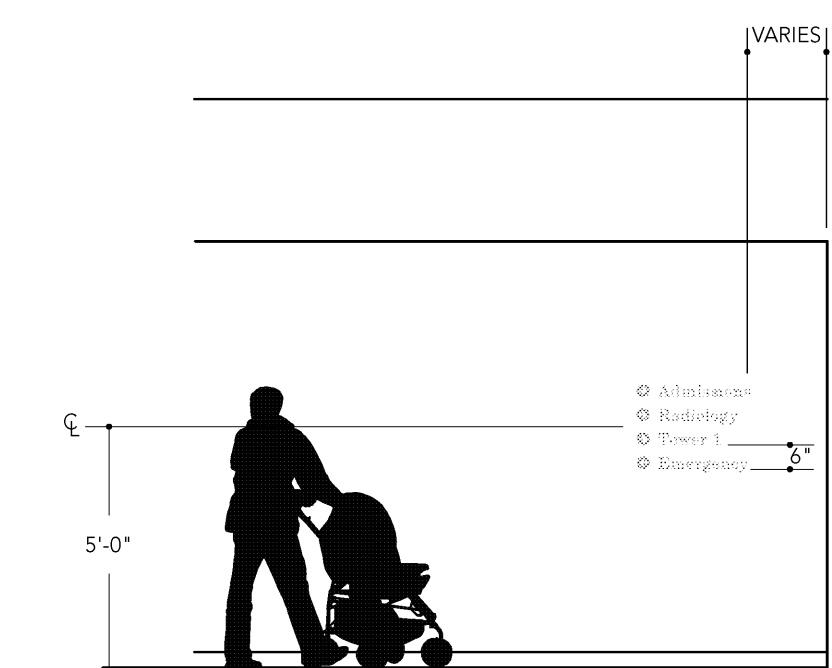


12 Sample Elevation
Scale: 1/4" = 1'-0"

ILS

ILS: Identification Letterforms (Small)

A

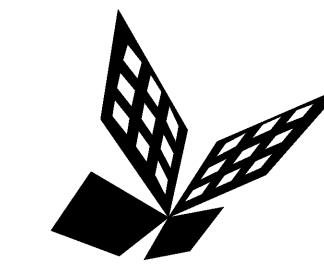

FKP Architects

ARCHITECT OF RECORD

*Architect of Record signature line only; this drawing was not prepared under the direct supervision of the Architect of Record. The direct responsibility for preparation of this sheet lies with its corresponding professional stamp and signature. The signature of the Architect of Record in general responsible charge of the project is provided as required by Title 24, Part 1, Section 7-115 (a).

ARCHITECT - PAUL C. GLORIOD

CONSULTANT



REVISIONS

08/31/09 ISSUED FOR FGMP

APPROVAL

PROJECT NAME

CHILDREN'S HOSPITAL OF ORANGE COUNTY

455 S. Main St.
Orange, CA 92668-3874

TOWER II



PROJECT NUMBER

12011.00
Increment #7

OSHPD - PROJECT NUMBER
IL 072072-30

ISSUE

Issue for FGMP

DATE

08/31/2009

SCALE

AS NOTED

DRAWING TITLE

WAYFINDING GRAPHICS

DRAWING NUMBER

AGC16.0

Volunteers


4 Letterforms - Large (Single Line Layout)
Scale: 1 1/2" = 1'-0"

ILL

Laboratory Administration


5 Letterforms - Large (2-Line Layout)
Scale: 1 1/2" = 1'-0"

ILL

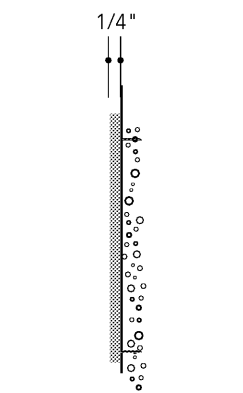

6 Side View
Scale: 3" = 1'-0"


ILL

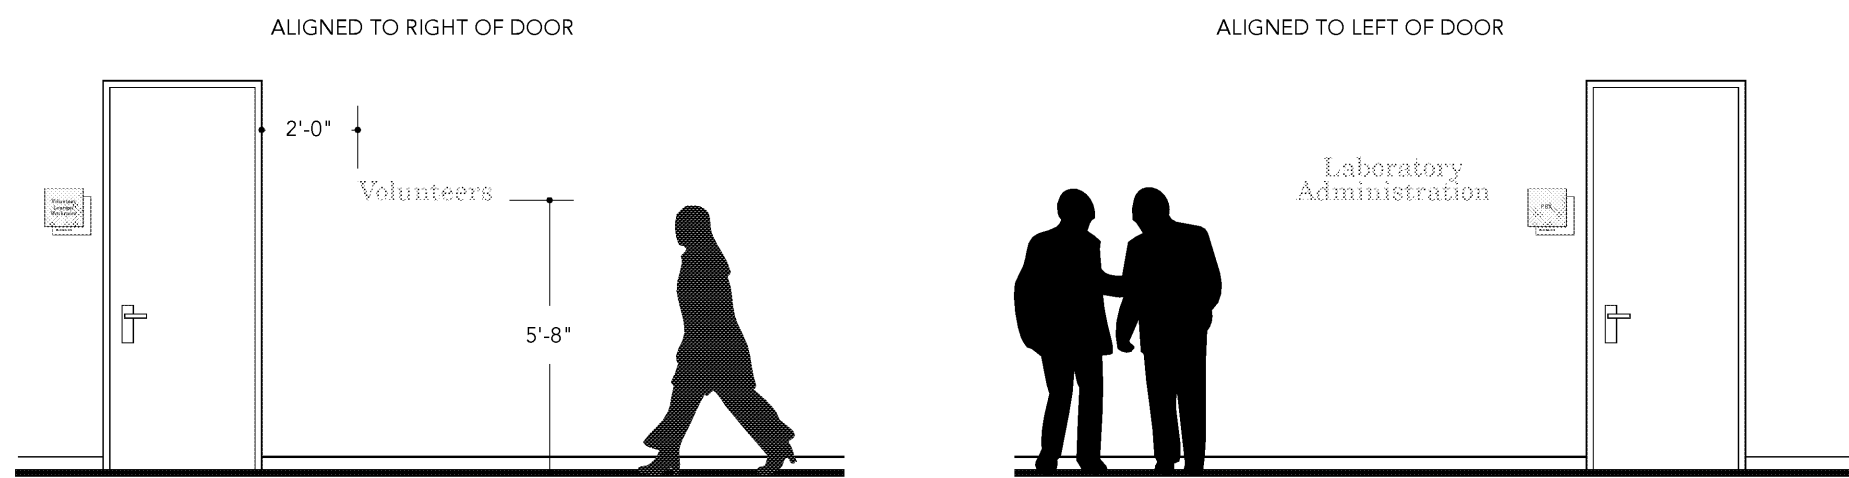

7 Reference Elevations
Scale: 1/4" = 1'-0"

ILL

ILL: Identification Letterforms (Large)

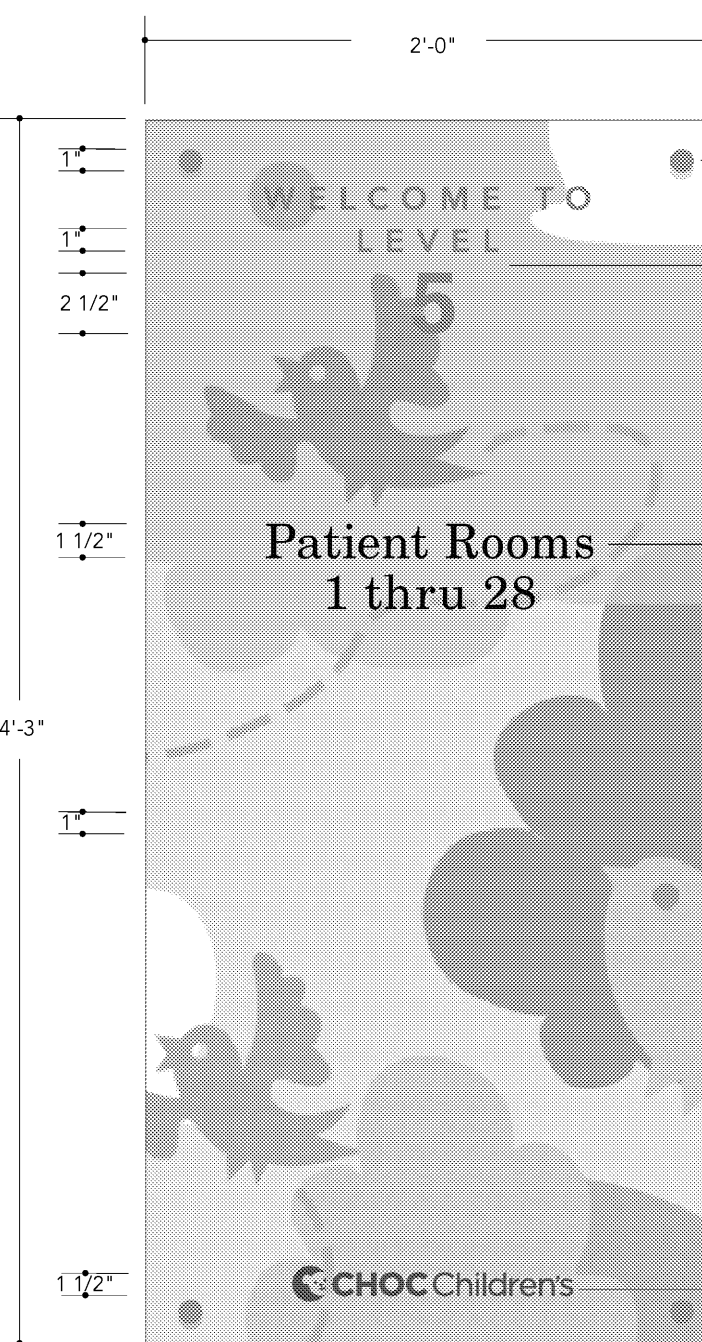


13 Level Directory
Scale: 1 1/2" = 1'-0"

LD



14 Side View
Scale: 1 1/2" = 1'-0"

LD

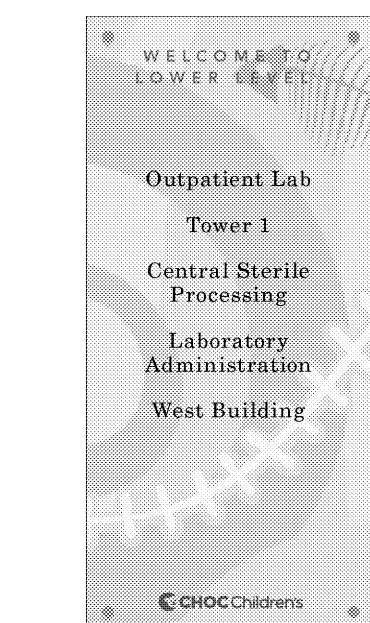

15 Additional Layouts (For Reference)
Scale: 3/8" = 1'-0"

LD

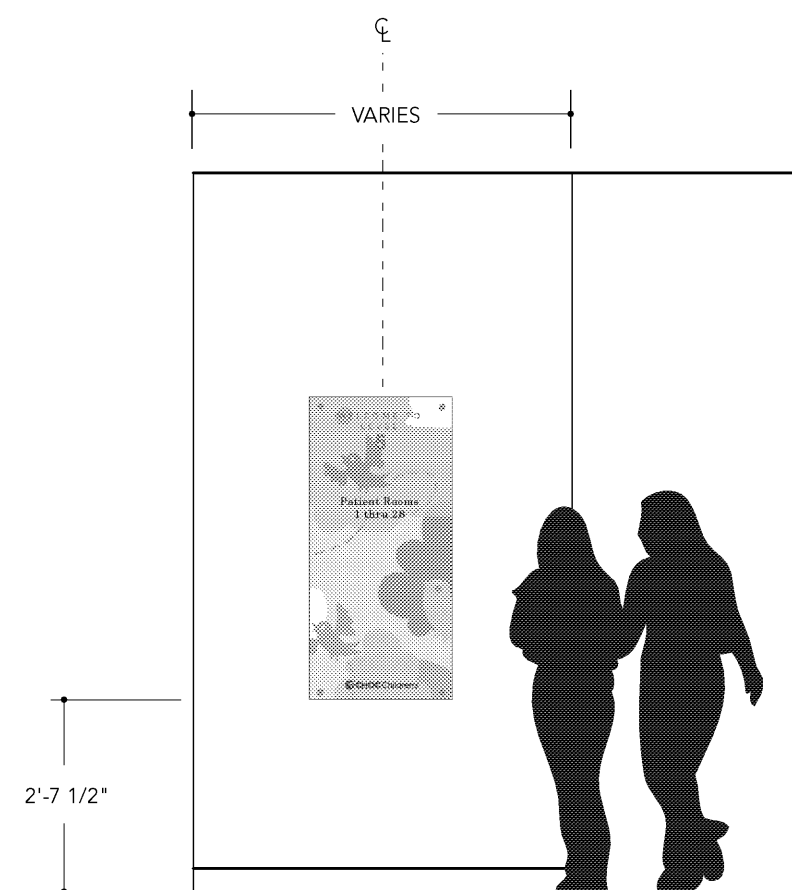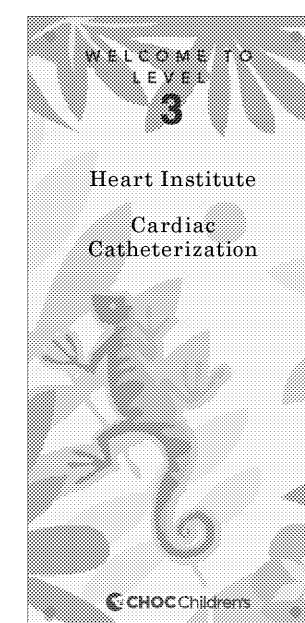

16 Sample Elevation
Scale: 3/8" = 1'-0"

LD

RFI 3607

RFI 3607.1 Provide 6"wide x 16 ga x 5ft long strap backing in general location shown at heights so backing centered on signage supports noted in signage details

LD: Level Directory

3

2

1