


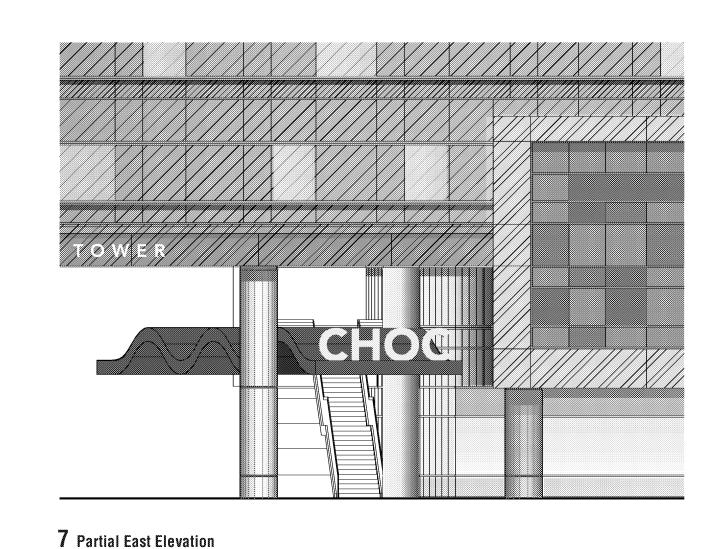



SBI: Secondary Building Identification







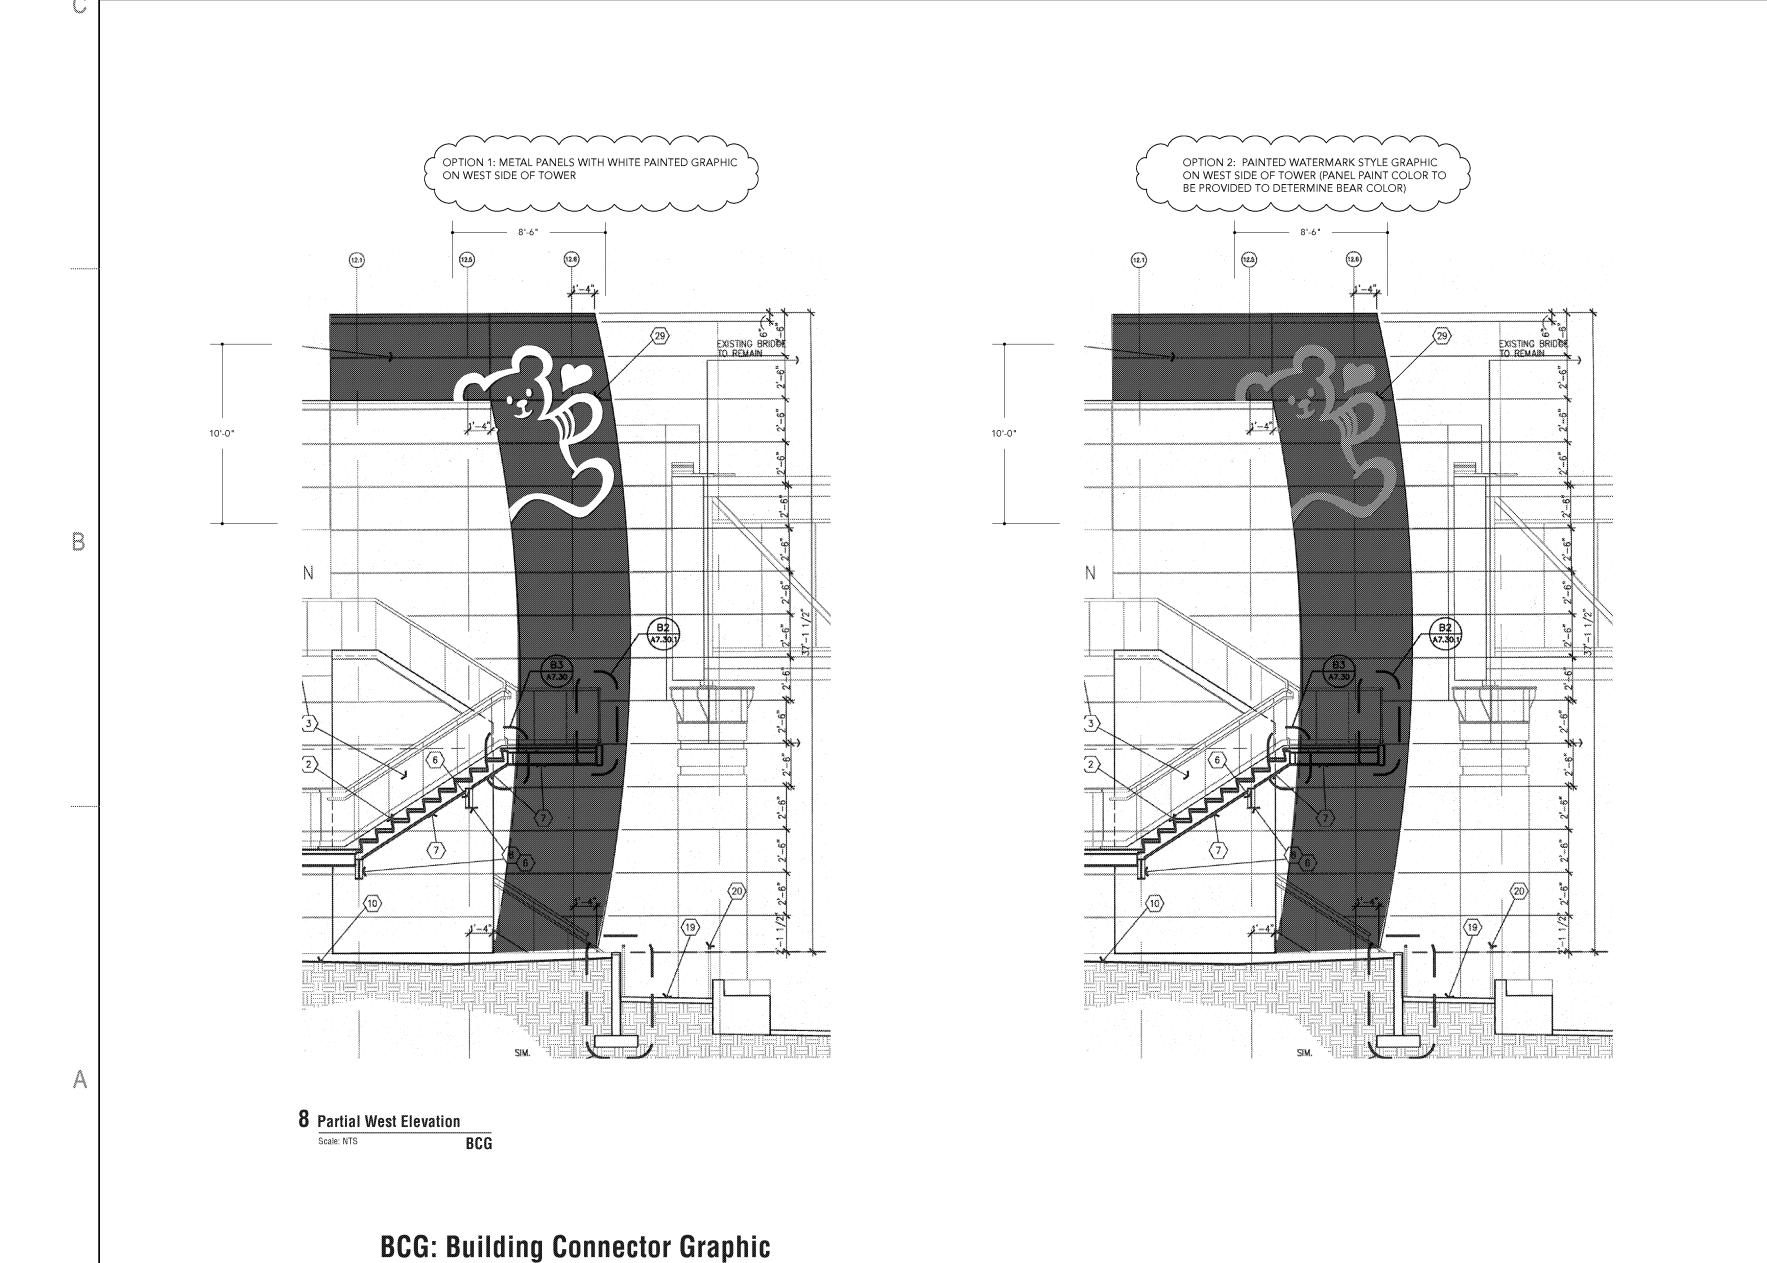

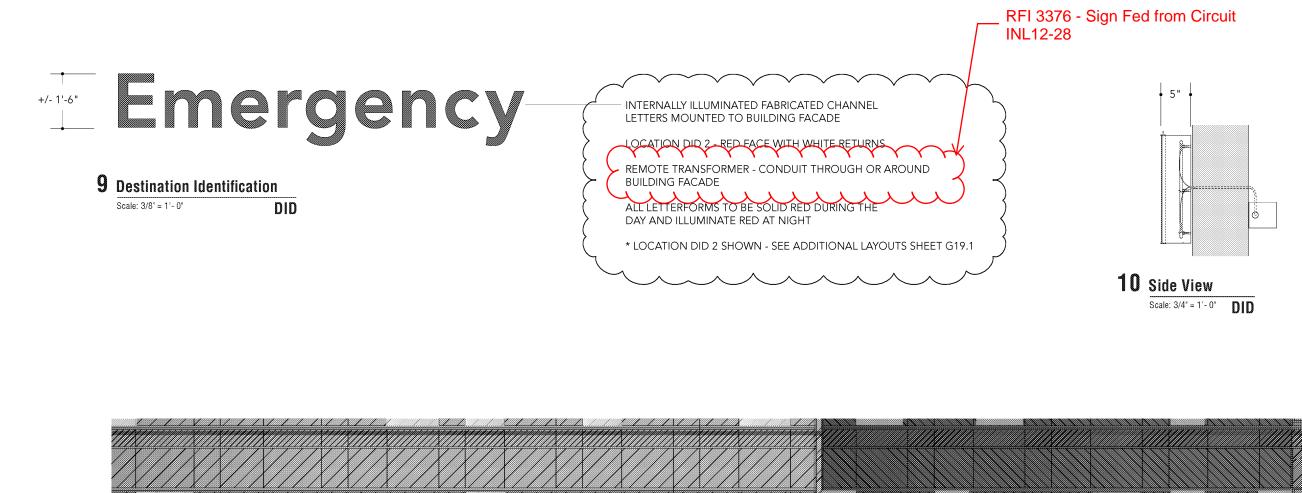



DID: Destination Identification (East Elevation)

11 Partial East Elevation
Scale: NTS DID



ARCHITECT OF RECORD

"Achitect of Record signature line only; this drawing was not prepared under the direct supervision of the Architect of Record. The direct responsibility for preparation of this sheet lies with its corresponding professional stamp and signature. The signature of the Architect of Record in general responsible charge of the project is provided as required by Title 24, Part 1 Section 7-115 (a)".

ARCHITECT - PAUL C. GLORIOD

CONSULTANT



REVISIONS

08/31/09 ISSUED FOR FGMP

10/15/10 ASI NO. 34

ADDDOVAL

PROJECT NAME

CHILDREN'S HOSPITAL
OF ORANGE COUNTY
455 S. Main St.

Orange, CA 92868-3874

TOWER II



COSECT NOMBER

12011.00 Increment #7

OSHPD - PROJECT NUMBER

IL 072072-30

Issue for FGMP

08/31/2009

ALE

AS NOTED

EXTERIOR GRAPHICS

AGC19.0

5