

FKP Architects

ARCHITECT OF RECORD

*Architect of Record signature line only; this drawing was not prepared under the direct supervision of the Architect of Record. The direct responsibility for preparation of this sheet lies with its corresponding professional stamp and signature. The signature of the Architect of Record in general responsible change of the project is provided as required by Title 24, Section 7-115 (a).

ARCHITECT - PAUL C. GLORIO

CONSULTANT



REVISIONS

34A	CO #272
46A	03/16/12 ASI #183
50A	04/19/12 ASI #204

APPROVAL

PROJECT NAME

CHILDREN'S HOSPITAL
OF ORANGE COUNTY

455 S. Main St.
Orange, CA 92668-3874

TOWER II



PROJECT NUMBER

12011.00
Increment #7

OSHPP - PROJECT NUMBER
IL 072072-30

ISSUE

Issue for FGMP

DATE

2/11/2011

SCALE


AS NOTED

DRAWING TITLE

LEVEL 1 - MRI #2
CODE SIGNS

DRAWING NUMBER

AGC2.1

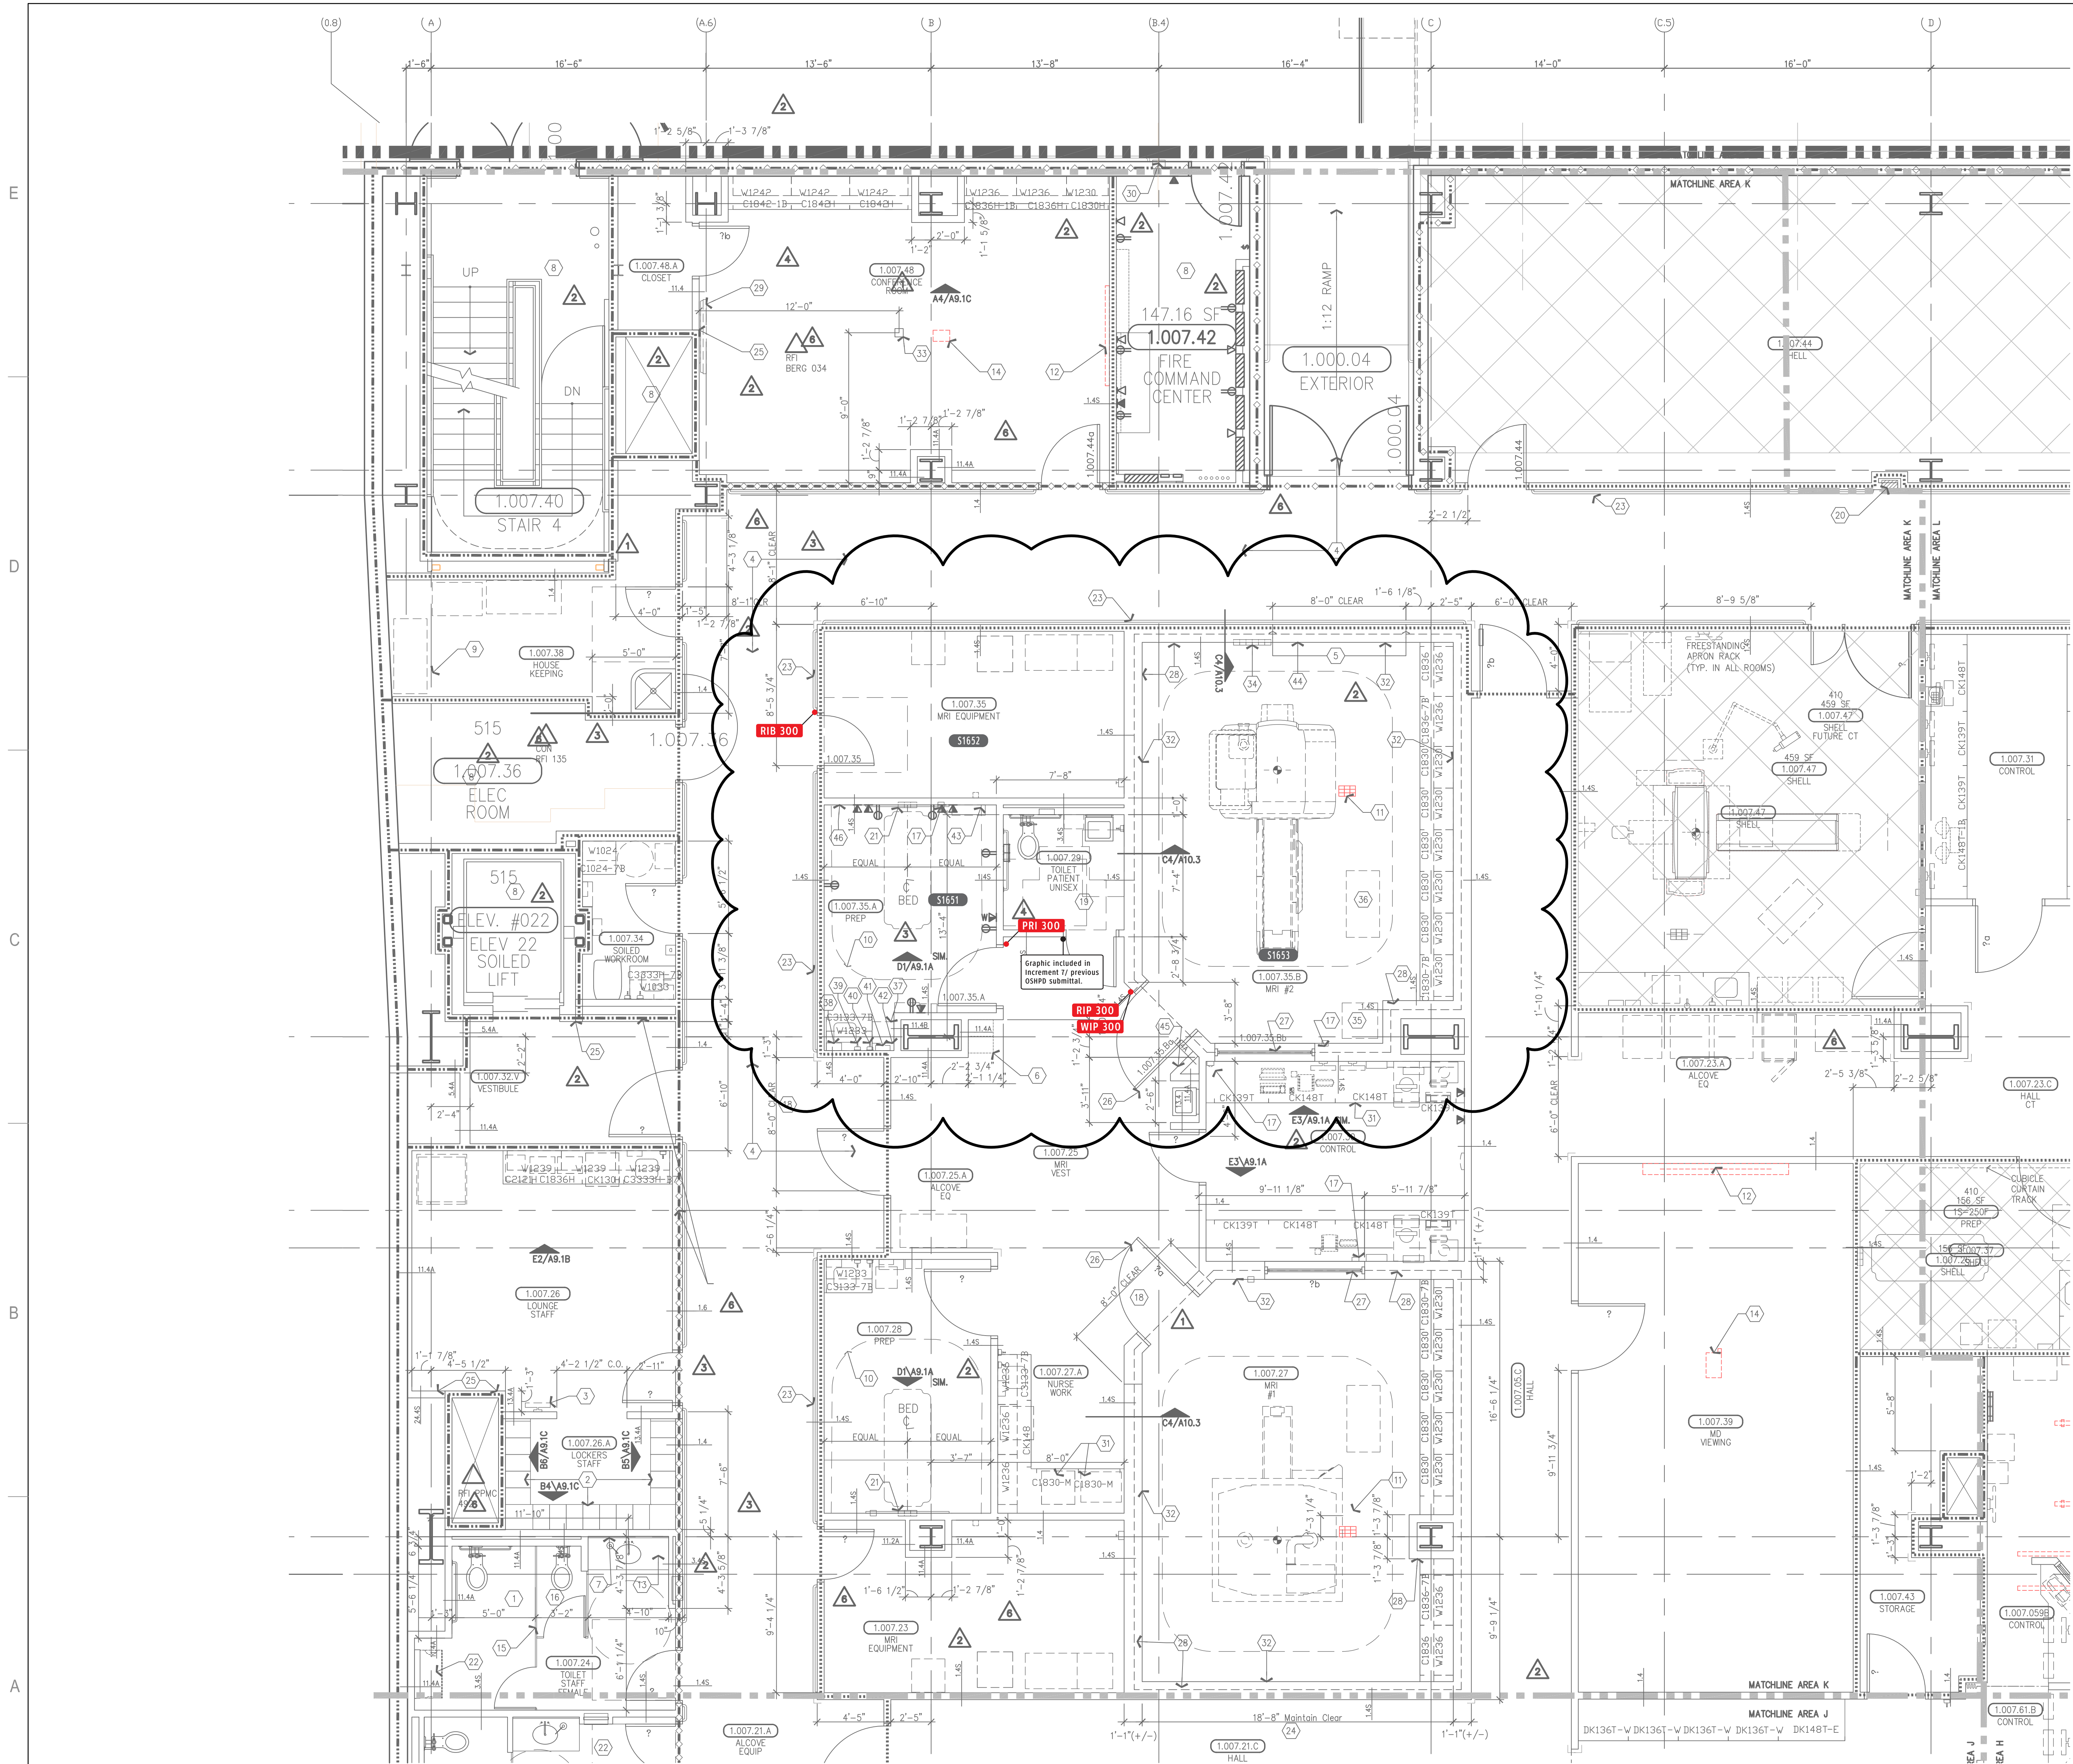

A6 AREA K
1/4" = 1' - 0"