


E

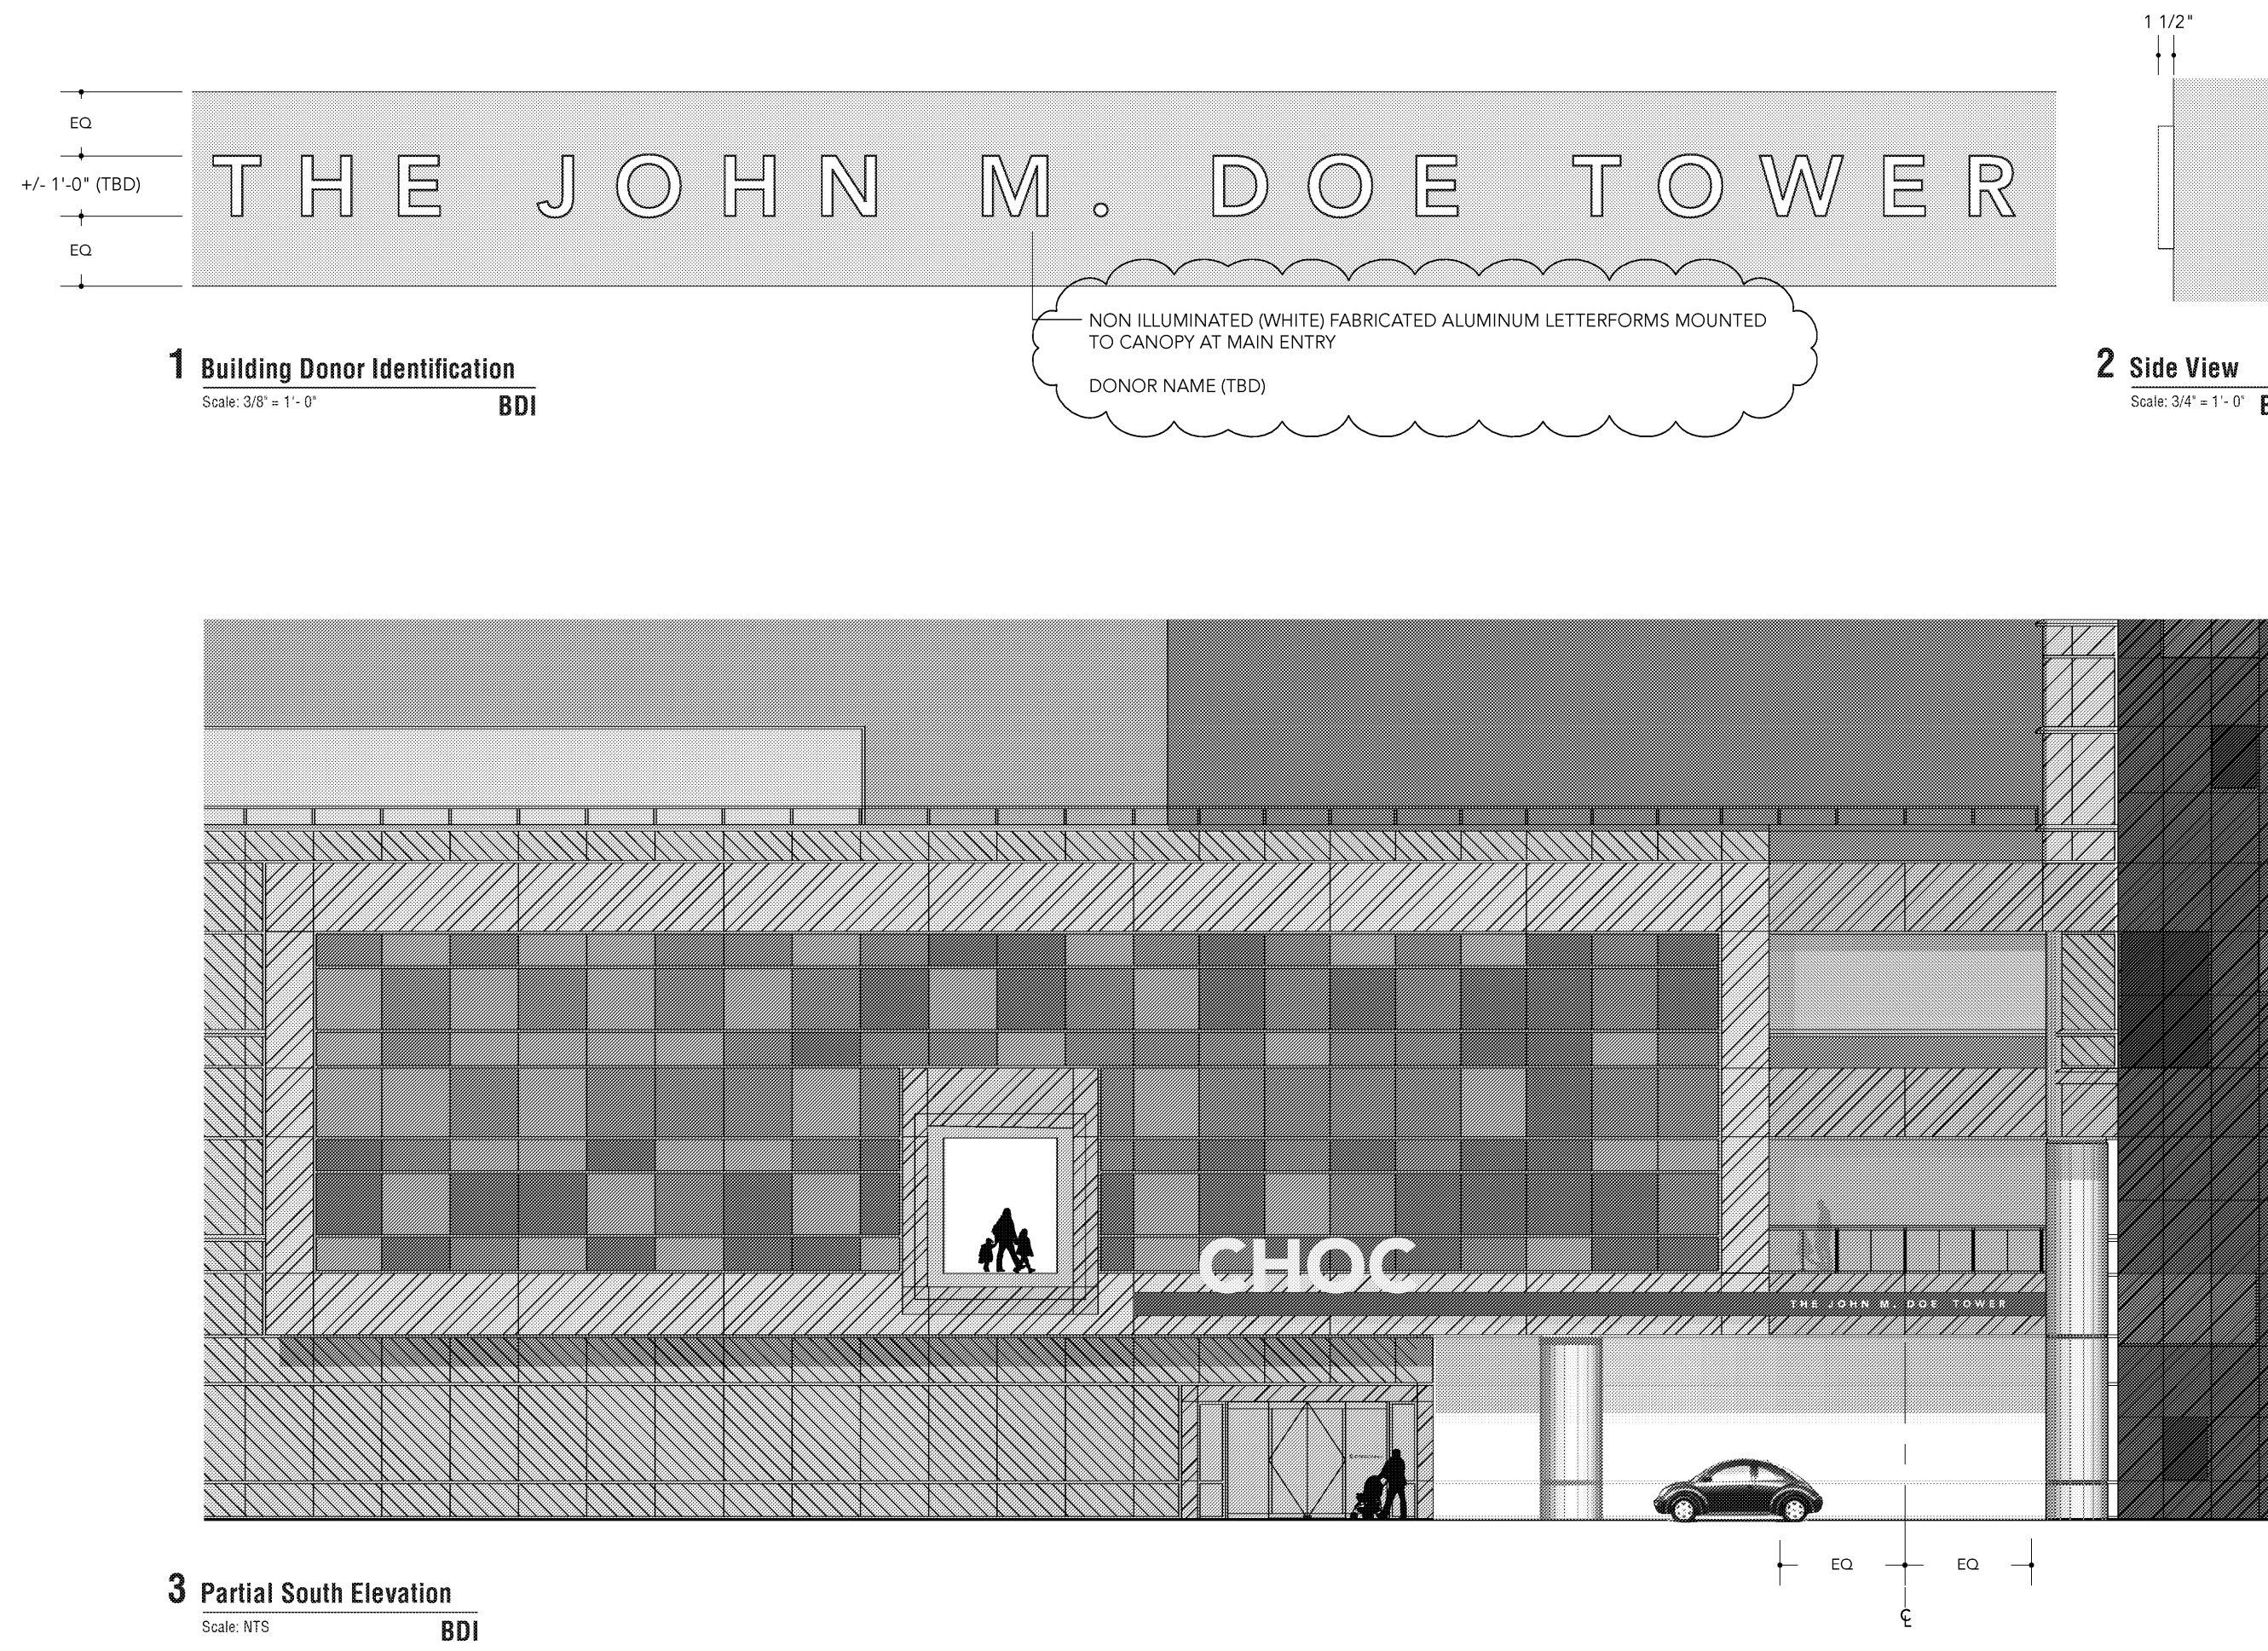


BDI: Building Donor Identification (South Elevation)


C

B

A

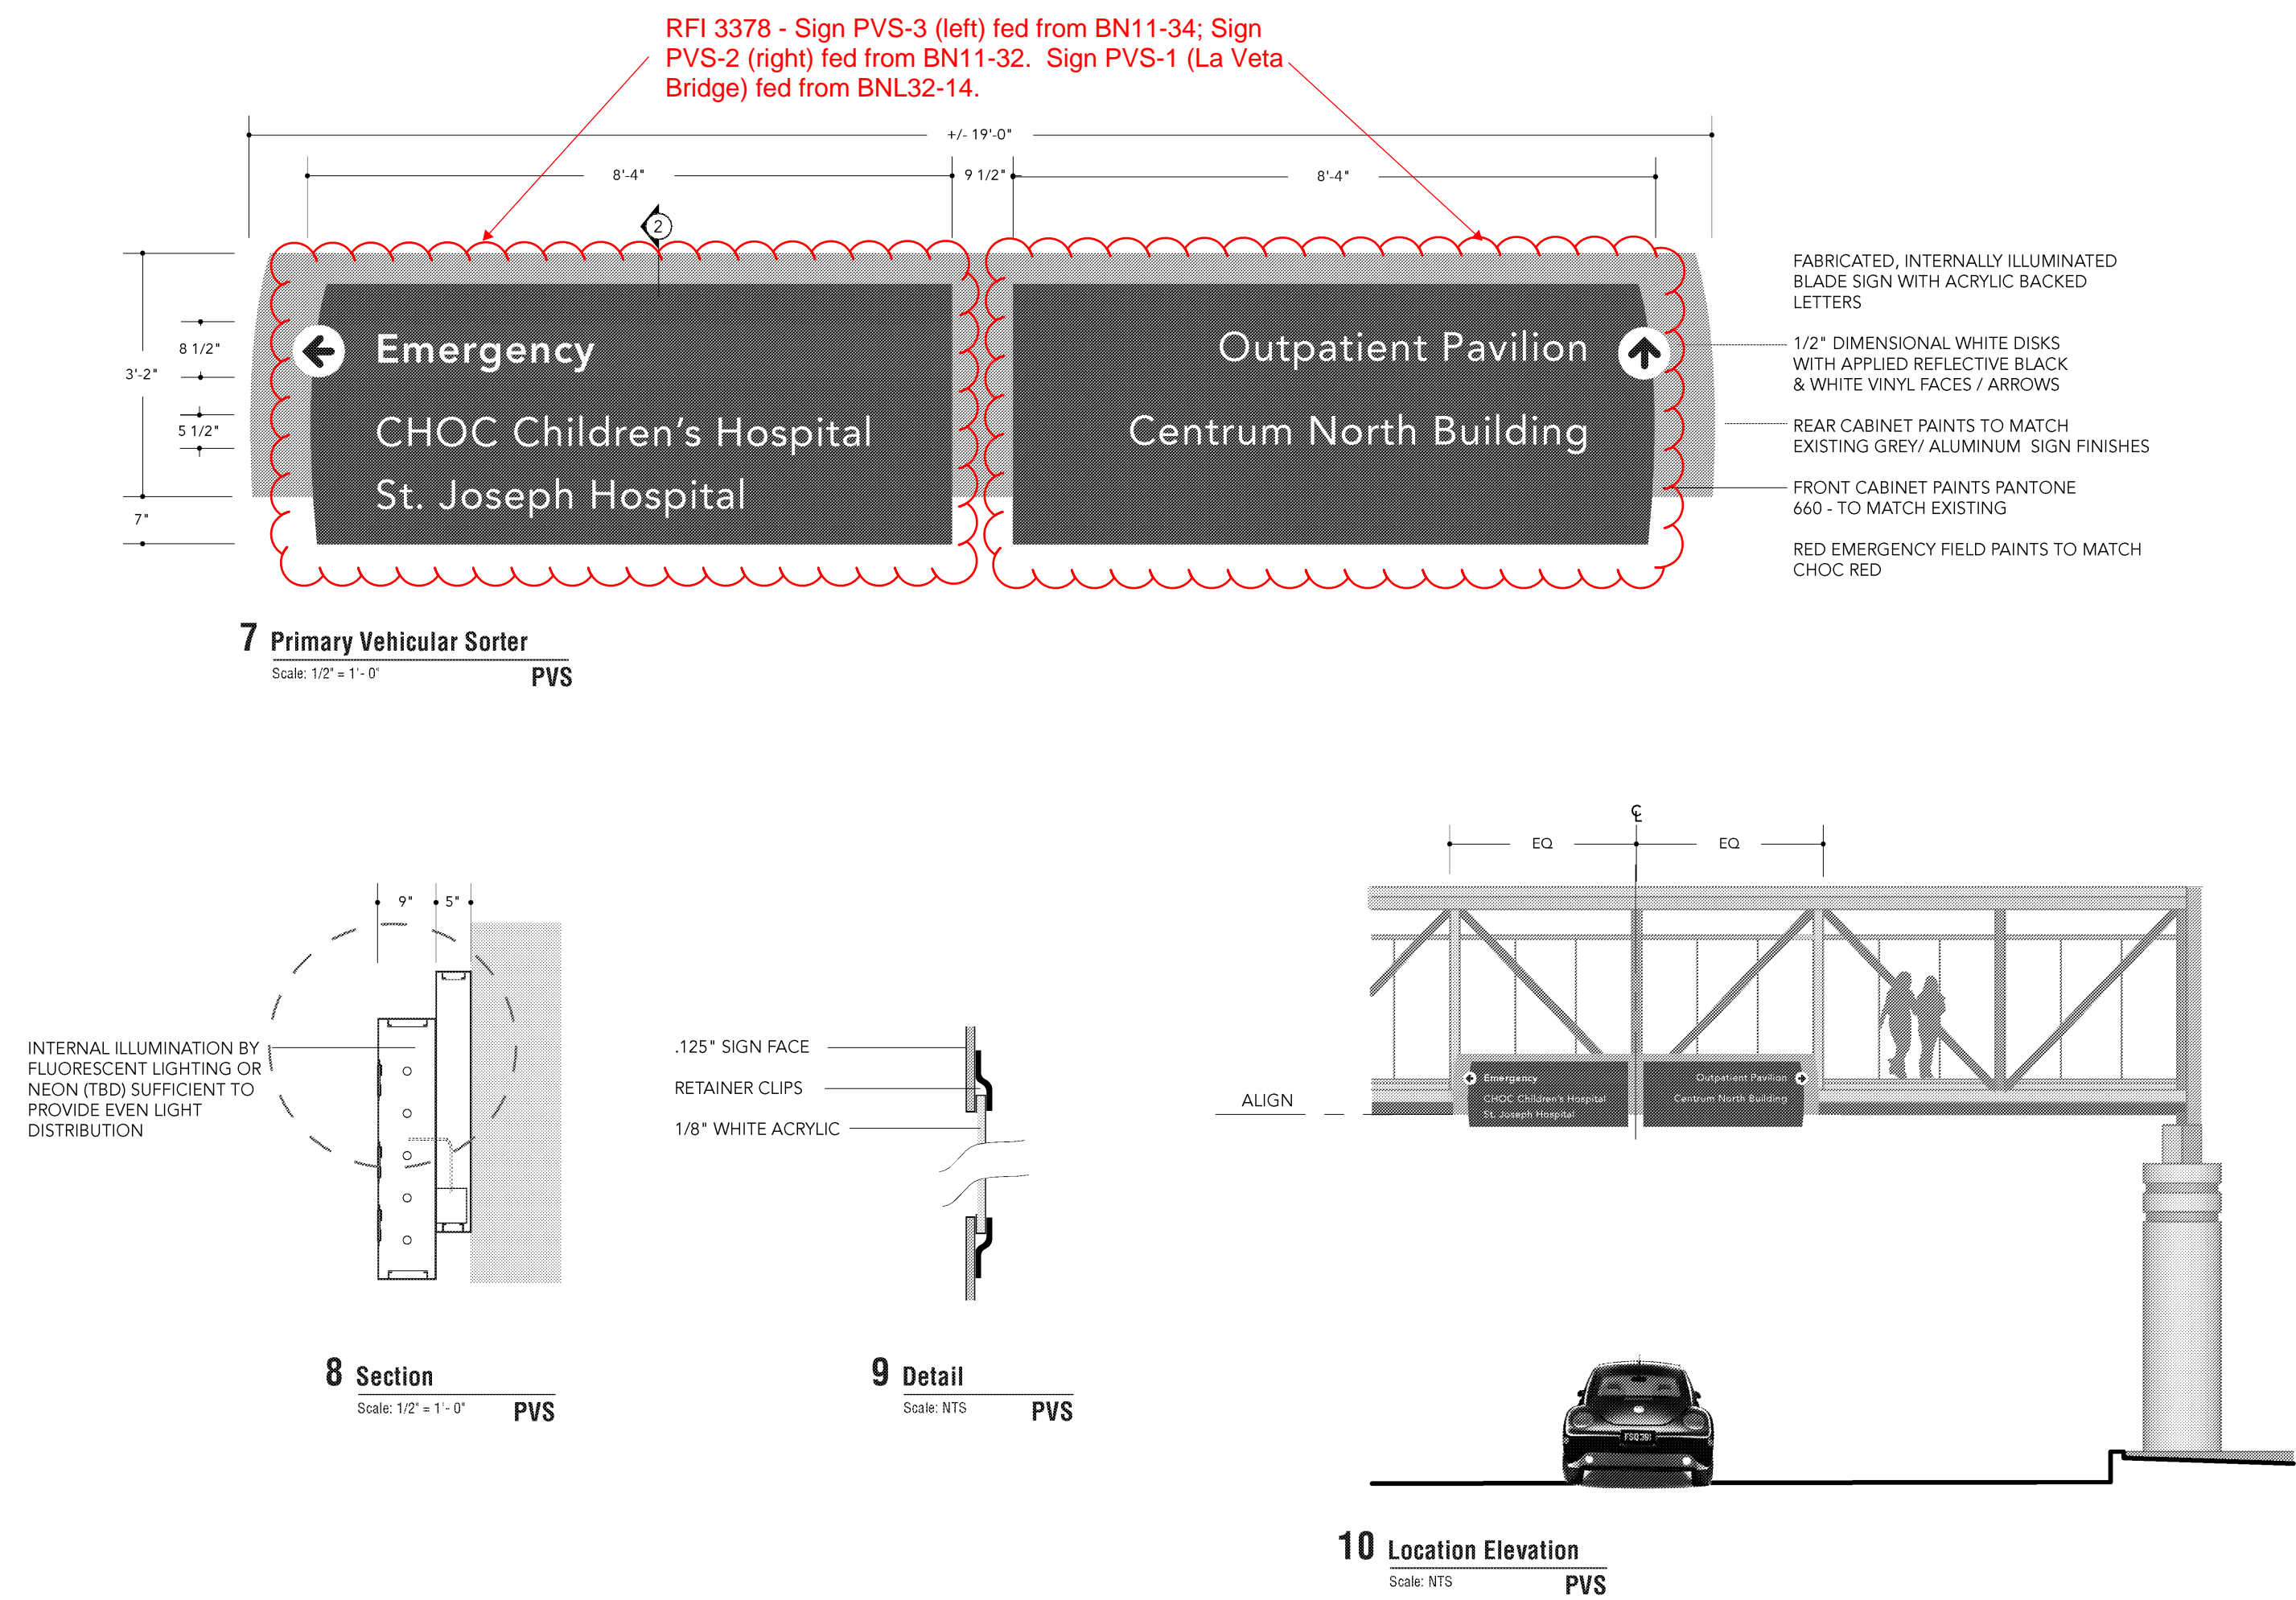


PVS: Primary Vehicle Sorter

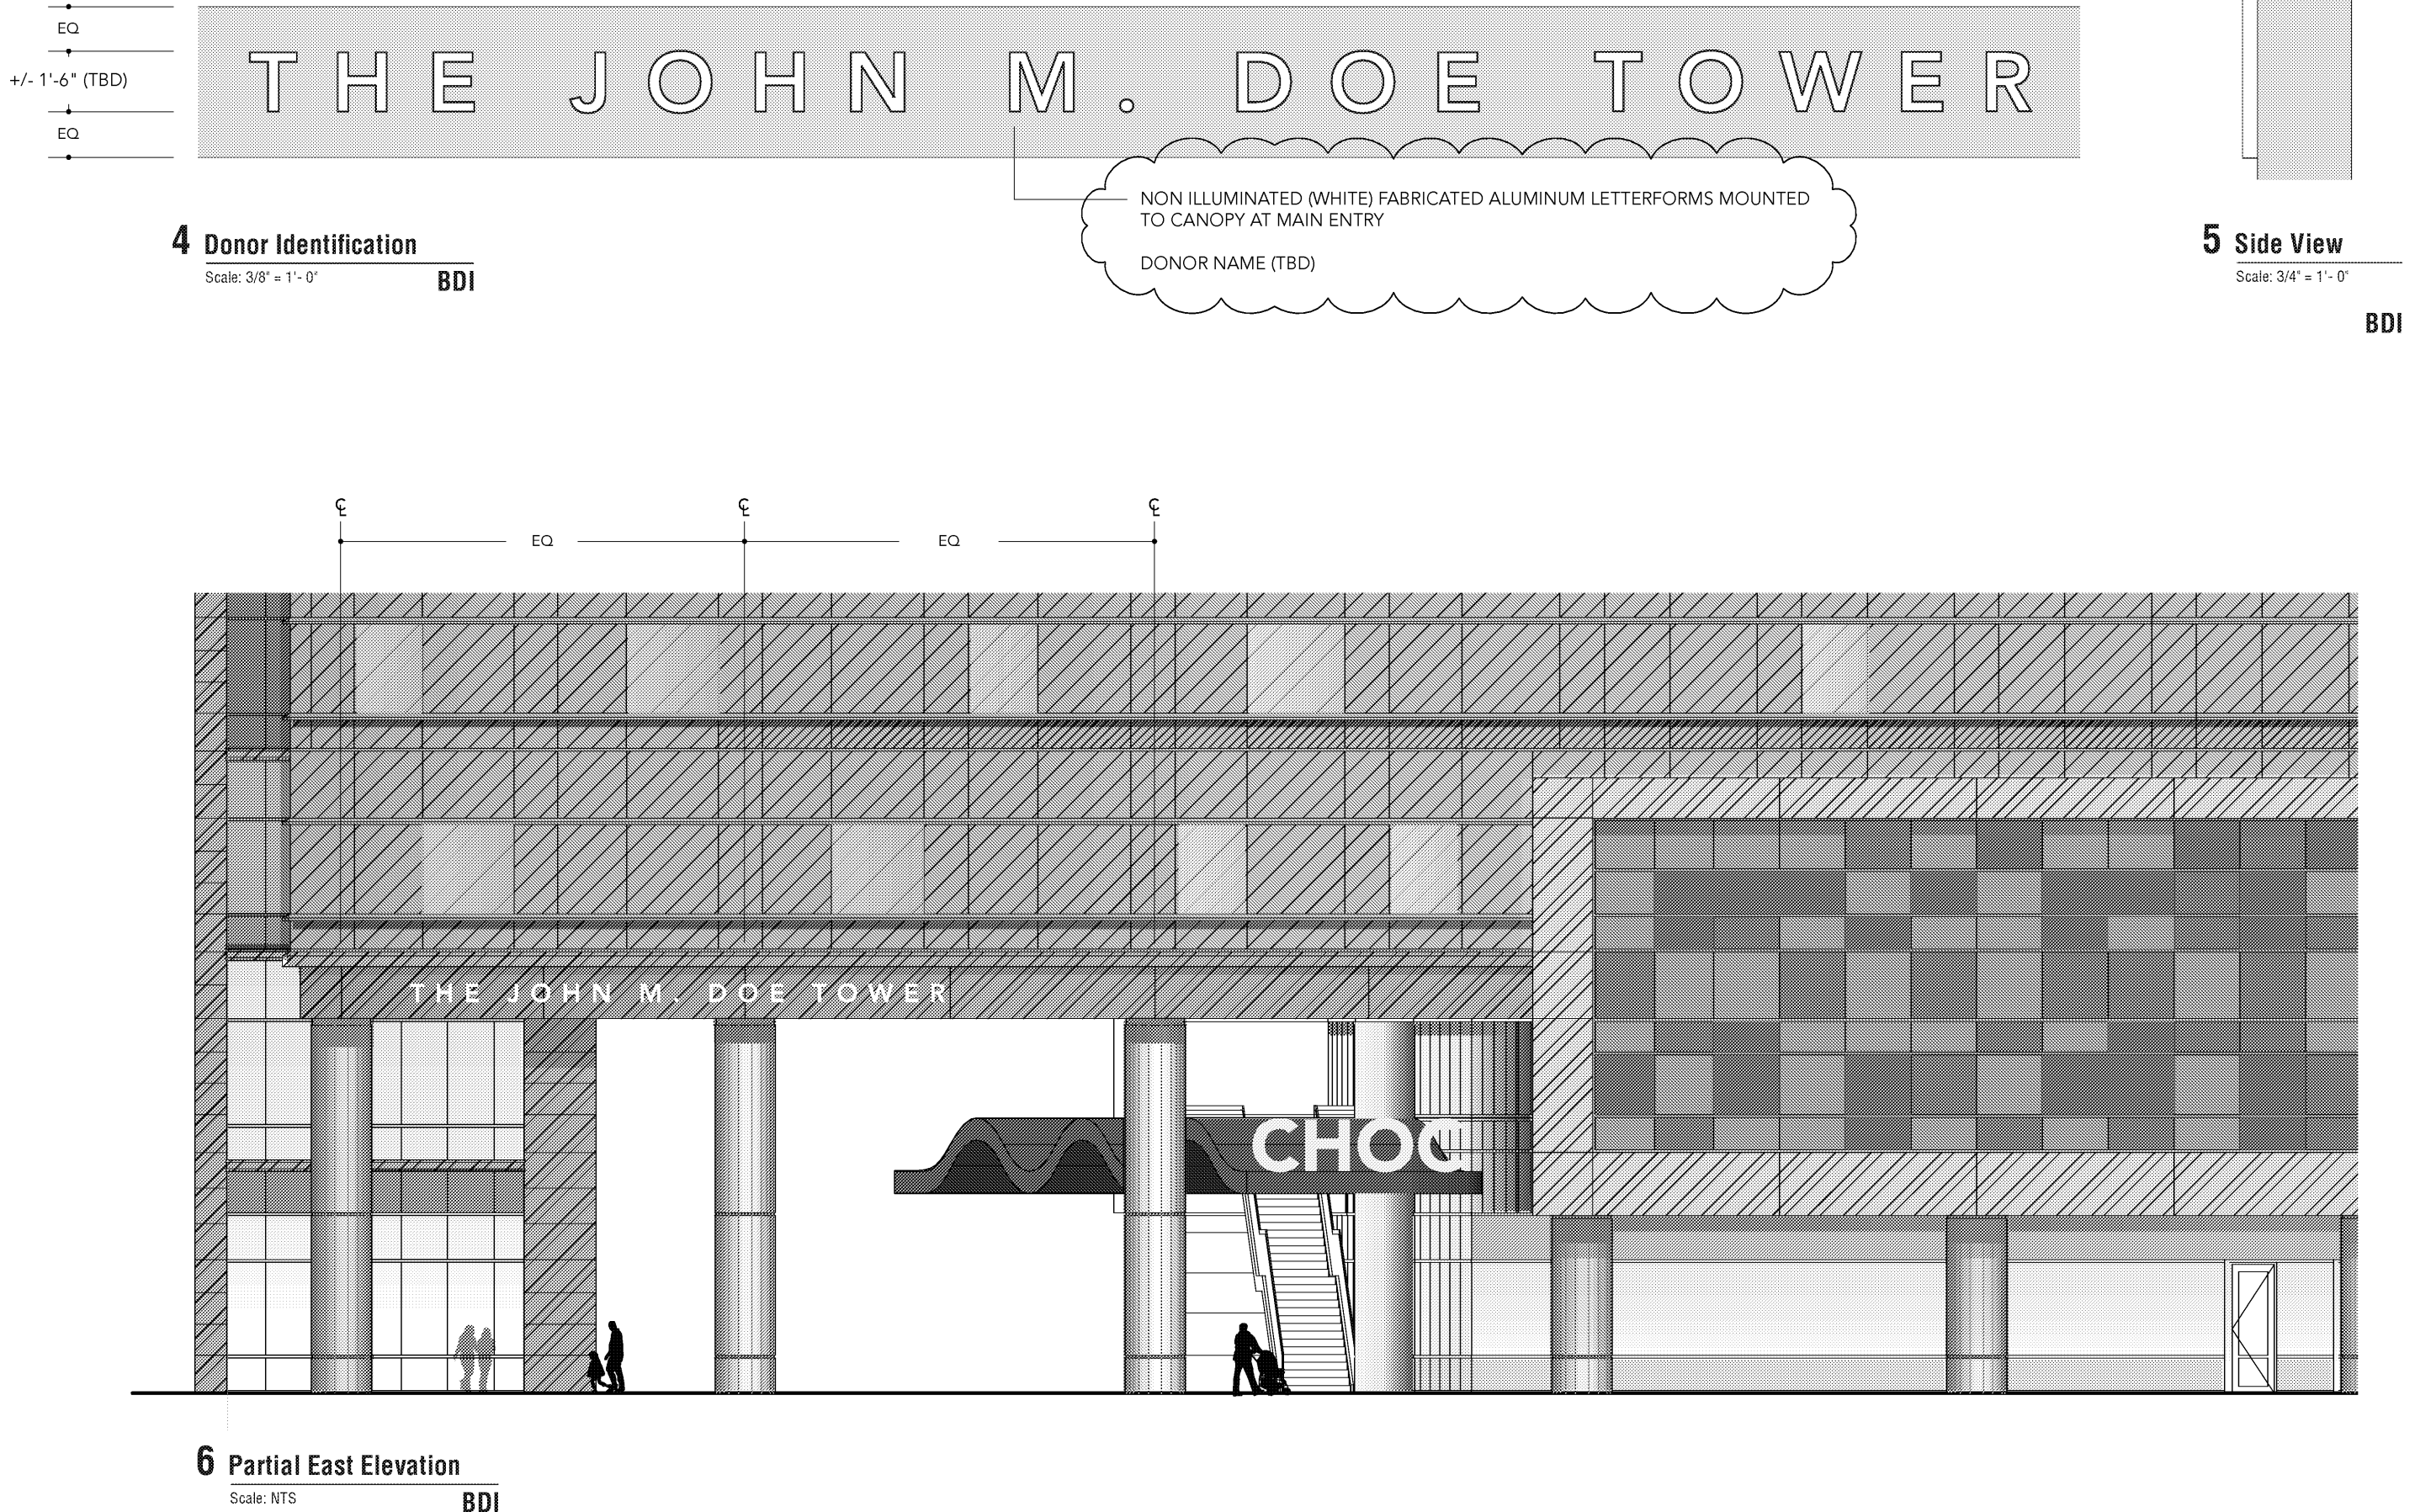


BDI: Building Donor Identification (East Elevation)

RFI 5356

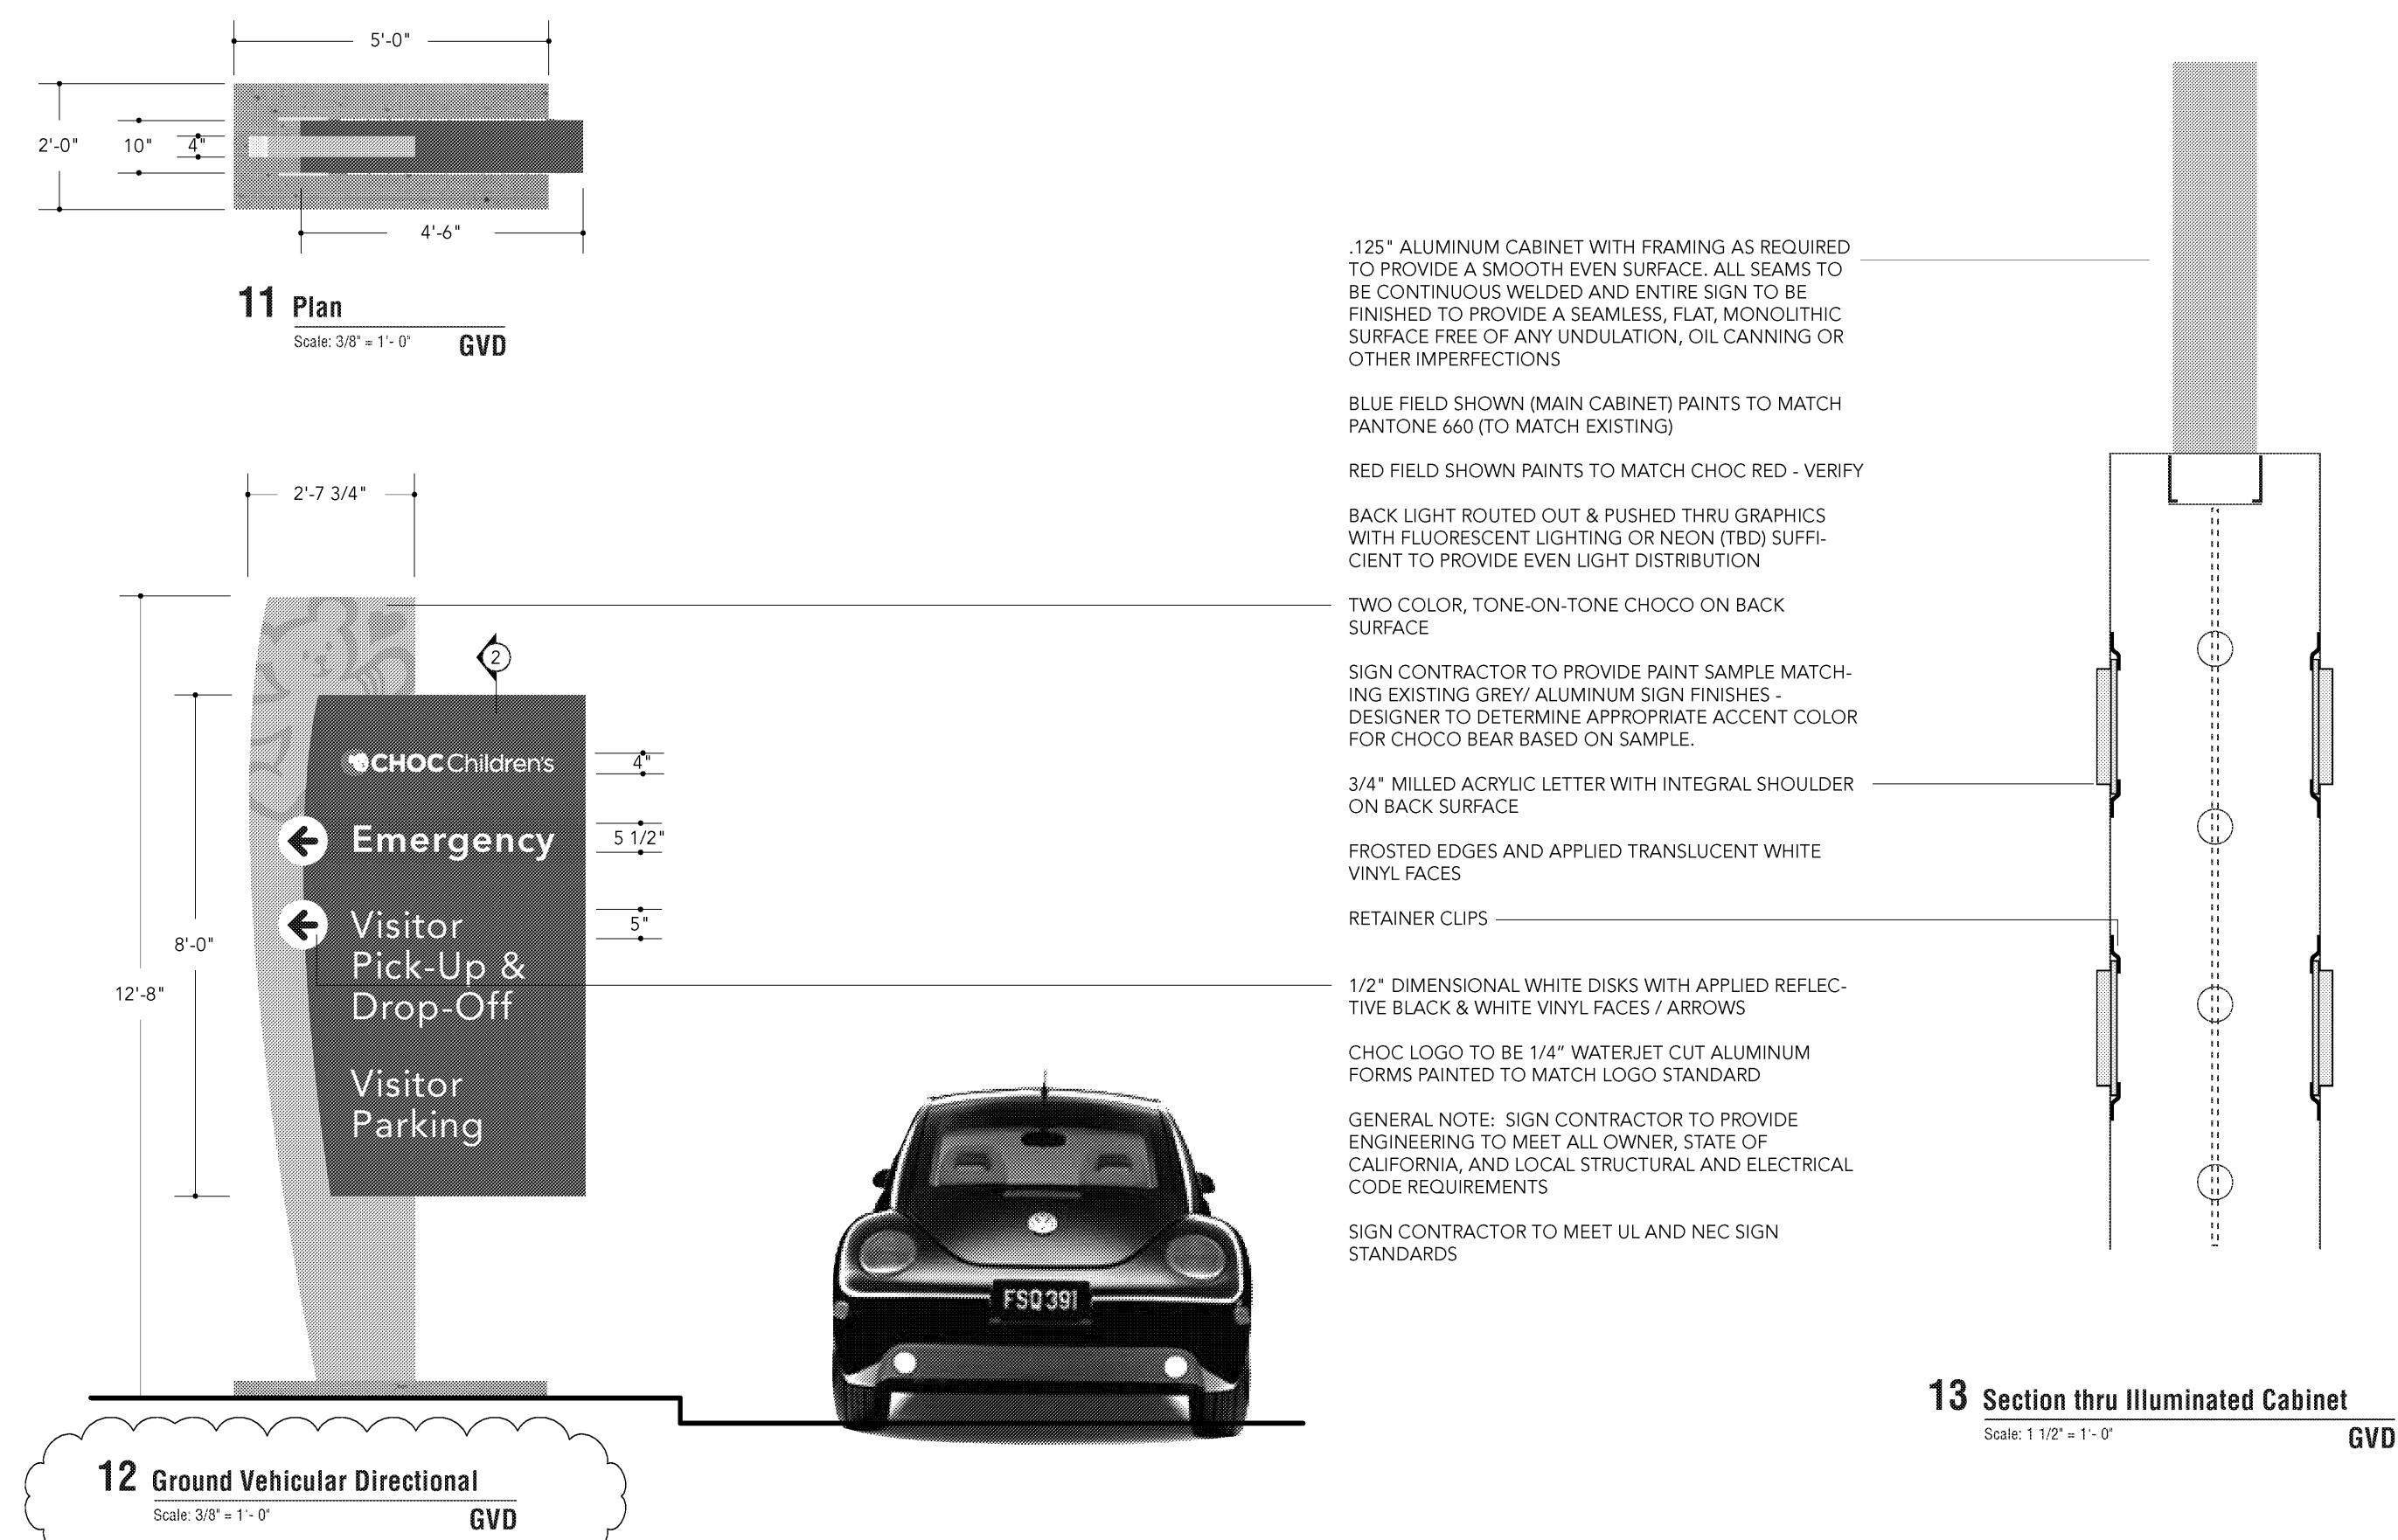

GVD: Ground Vehicular Directional

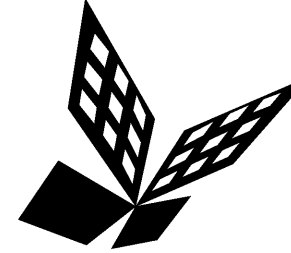

FKP Architects

ARCHITECT OF RECORD

*Architect of Record signature line only; this drawing was not prepared under the direct supervision of the Architect of Record. The direct responsibility for preparation of this sheet lies with its corresponding professional stamp and signature. The signature of the Architect of Record in general responsible charge of the project is provided as required by Title 24, Part 1, Section 7-115 (a).

ARCHITECT - PAUL C. GLORIOD

CONSULTANT



REVISIONS

△ 08/31/09 ISSUED FOR FGMP

△ 10/15/10 ASI NO. 34

APPROVAL

PROJECT NAME

CHILDREN'S HOSPITAL
OF ORANGE COUNTY

455 S. Main St.
Orange, CA 92868-3874

TOWER II



PROJECT NUMBER

12011.00
Increment #7

OSHPD - PROJECT NUMBER
IL 072072-30

ISSUE

Issue for FGMP

DATE

08/31/2009

SCALE

AS NOTED

DRAWING TITLE

EXTERIOR GRAPHICS

DRAWING NUMBER

AGC20.0