

FKP Architects

ARCHITECT OF RECORD

*Architect of Record signature line only; this drawing was not prepared under the direct supervision of the Architect of Record. The direct responsibility for preparation of this sheet lies with its corresponding professional stamp and signature. The signature of the Architect of Record in general responsible charge of the project is provided as required by Title 24, Part 1, Section 7-115 (a).

ARCHITECT - PAUL C. GLORIOD


CONSULTANT



REVISIONS

△	08/31/09	ISSUED FOR FGMP
△	10/15/10	ASI NO. 34
△	03/16/12	ASI #183
△	04/9/12	CO #355

APPROVAL

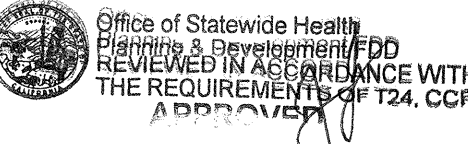

2012 04 2012

CHANGE ORDER: 355
INSTRUCTION BULLETIN
DEFERRED APPROVAL #
'(DEMENT)'

PROJECT NAME: PAD 2012 - 05371

CHILDREN'S HOSPITAL
OF ORANGE COUNTY

455 S. Main St.
Orange, CA 92868-3874

TOWER II



PROJECT NUMBER

12011.00
Increment #7

OSHPD - PROJECT NUMBER
IL 072072-30

ISSUE

Issue for FGMP

DATE

08/31/2009

SCALE

AS NOTED

DRAWING TITLE

EXTERIOR GRAPHICS

DRAWING NUMBER

AGC21.0