



E

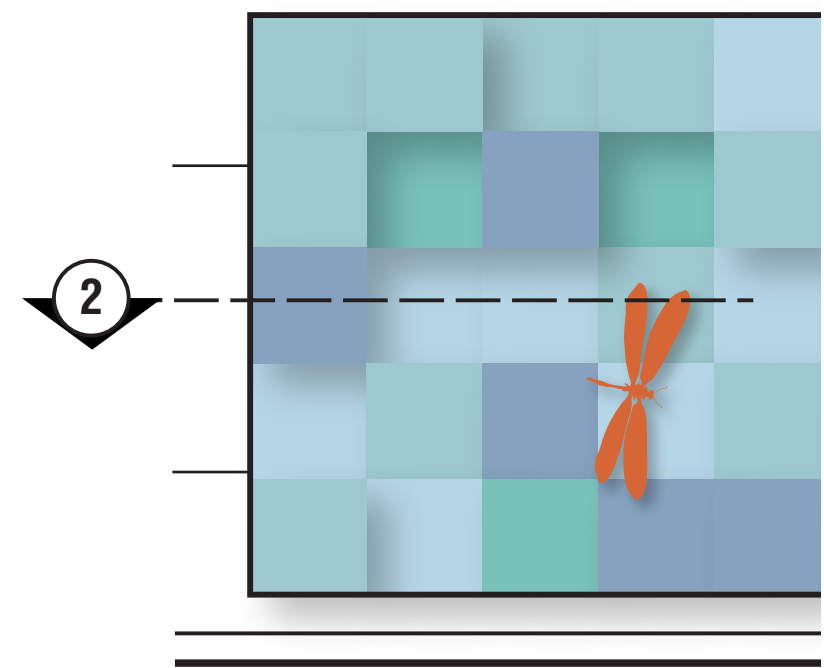

**1 Partial Elevation**  
Scale: 3/8" = 1'-0"

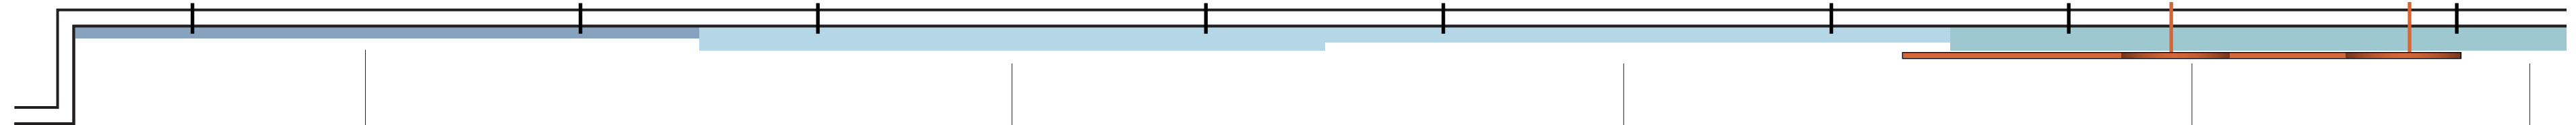

**2 Plan Section**  
Scale: 3" = 1'-0"

3/8" RESIN PLAQUES SECURED TO THE WALL WITH CLEAR PINS & SILICON ADHESIVE


3/4" RESIN PLAQUES SECURED TO THE WALL WITH CLEAR PINS & SILICON ADHESIVE

1/2" RESIN PLAQUES SECURED TO THE WALL WITH CLEAR PINS & SILICON ADHESIVE

3/16" PAINTED ALUMINUM FORMS  
FORMS HAVE METAL PINS WELDED TO BACK SIDE OF PANEL TO MOUNT TO WALL THROUGH RESIN WITH SILICONE ADHESIVE

3/4" RESIN PLAQUES SECURED TO THE WALL WITH CLEAR PINS & SILICON ADHESIVE

D

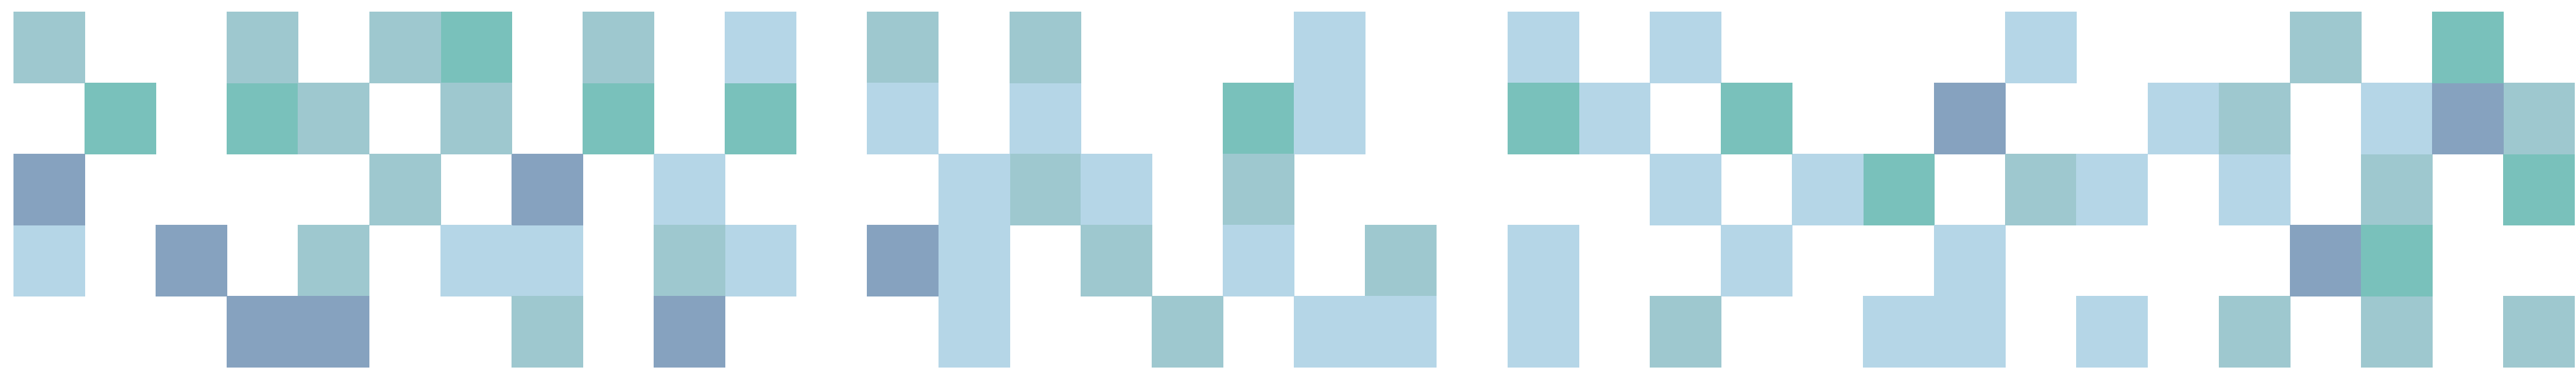

3/8" RESIN PLAQUES  
WALL RADIUS: 890'-4"

**Layer #1: 3/8" Resin Plaques**



1/2" RESIN PLAQUES

**Layer #2: 1/2" Resin Plaques**



3/4" RESIN PLAQUES

**Layer #3: 3/4" Resin Plaques**

B



3/16" PAINTED ALUMINUM FORMS

RFI 5942

**Layer #4: 3/16" Painted Aluminum**

A

**3 Build Up of Donor Feature**  
Scale: 3/8" = 1'-0"

6


5

4

3

2

1

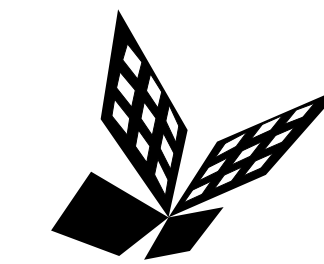

FKP Architects

ARCHITECT OF RECORD

\*Architect of Record signature line only; this drawing was not prepared under the direct supervision of the Architect of Record. The direct responsibility for preparation of this sheet lies with its corresponding professional stamp and signature. The signature of the Architect of Record in general responsible change of the project is provided as required by Title 24, Part 1, Section 7-115 (a).

ARCHITECT - PAUL C. GLORIOT

CONSULTANT



REVISIONS

2/02/12 ASI NO. 162

APPROVAL

PROJECT NAME

CHILDREN'S HOSPITAL  
OF ORANGE COUNTY

455 S. Main St.  
Orange, CA 92668-3874

TOWER II



PROJECT NUMBER

12011.00  
Increment #7

OSHPD - PROJECT NUMBER  
IL 072072-30

ISSUE

DATE

8/23/2011

SCALE

AS NOTED

DRAWING TITLE

South Wall Brick  
Replacement Recognition

DRAWING NUMBER

AGC38.1