


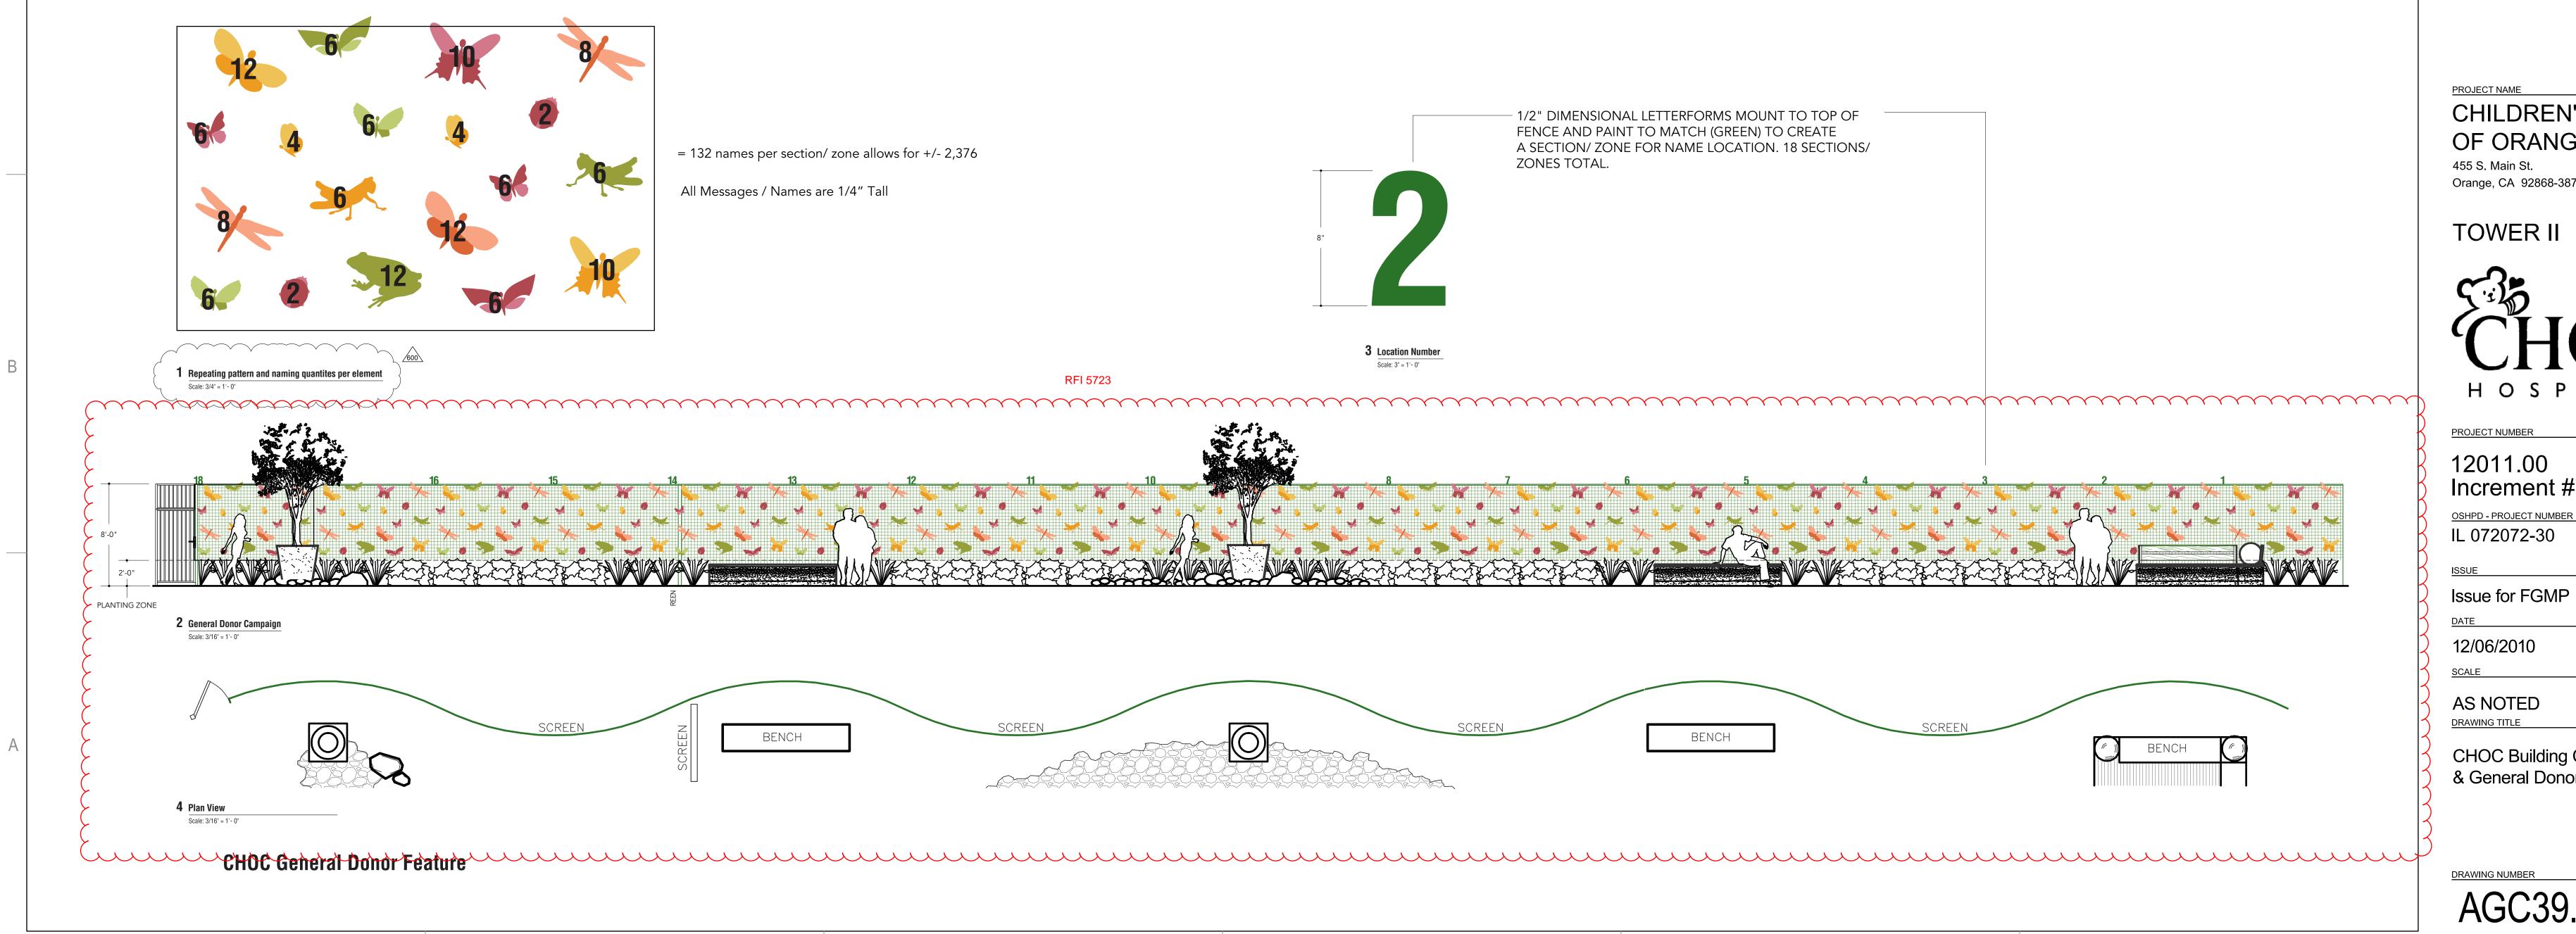

(C) 2007 FKP Architects, Inc. All rights reserved. No part of this document may be reproduced or utilized in any form without prior written authorization of FKP Architects, Inc.





ARCHITECT OF RECORD

"Achitect of Record signature line only; this drawing was not prepared under the direct supervision of the Architect of Record. The direct responsibility for preparation of this sheet lies with its corresponding professional stamp and signature. The signature of the Architect of Record in general responsible charge of the project is provided as required by Title 24, Part 1 Section 7-115 (a)".

ARCHITECT - PAUL C. GLORIOD



CHILDREN'S HOSPITAL OF ORANGE COUNTY 455 S. Main St.

Orange, CA 92868-3874

TOWER II



12011.00 Increment #7

IL 072072-30

Issue for FGMP

12/06/2010

AS NOTED DRAWING TITLE

CHOC Building Campaign Feature & General Donor Feature